




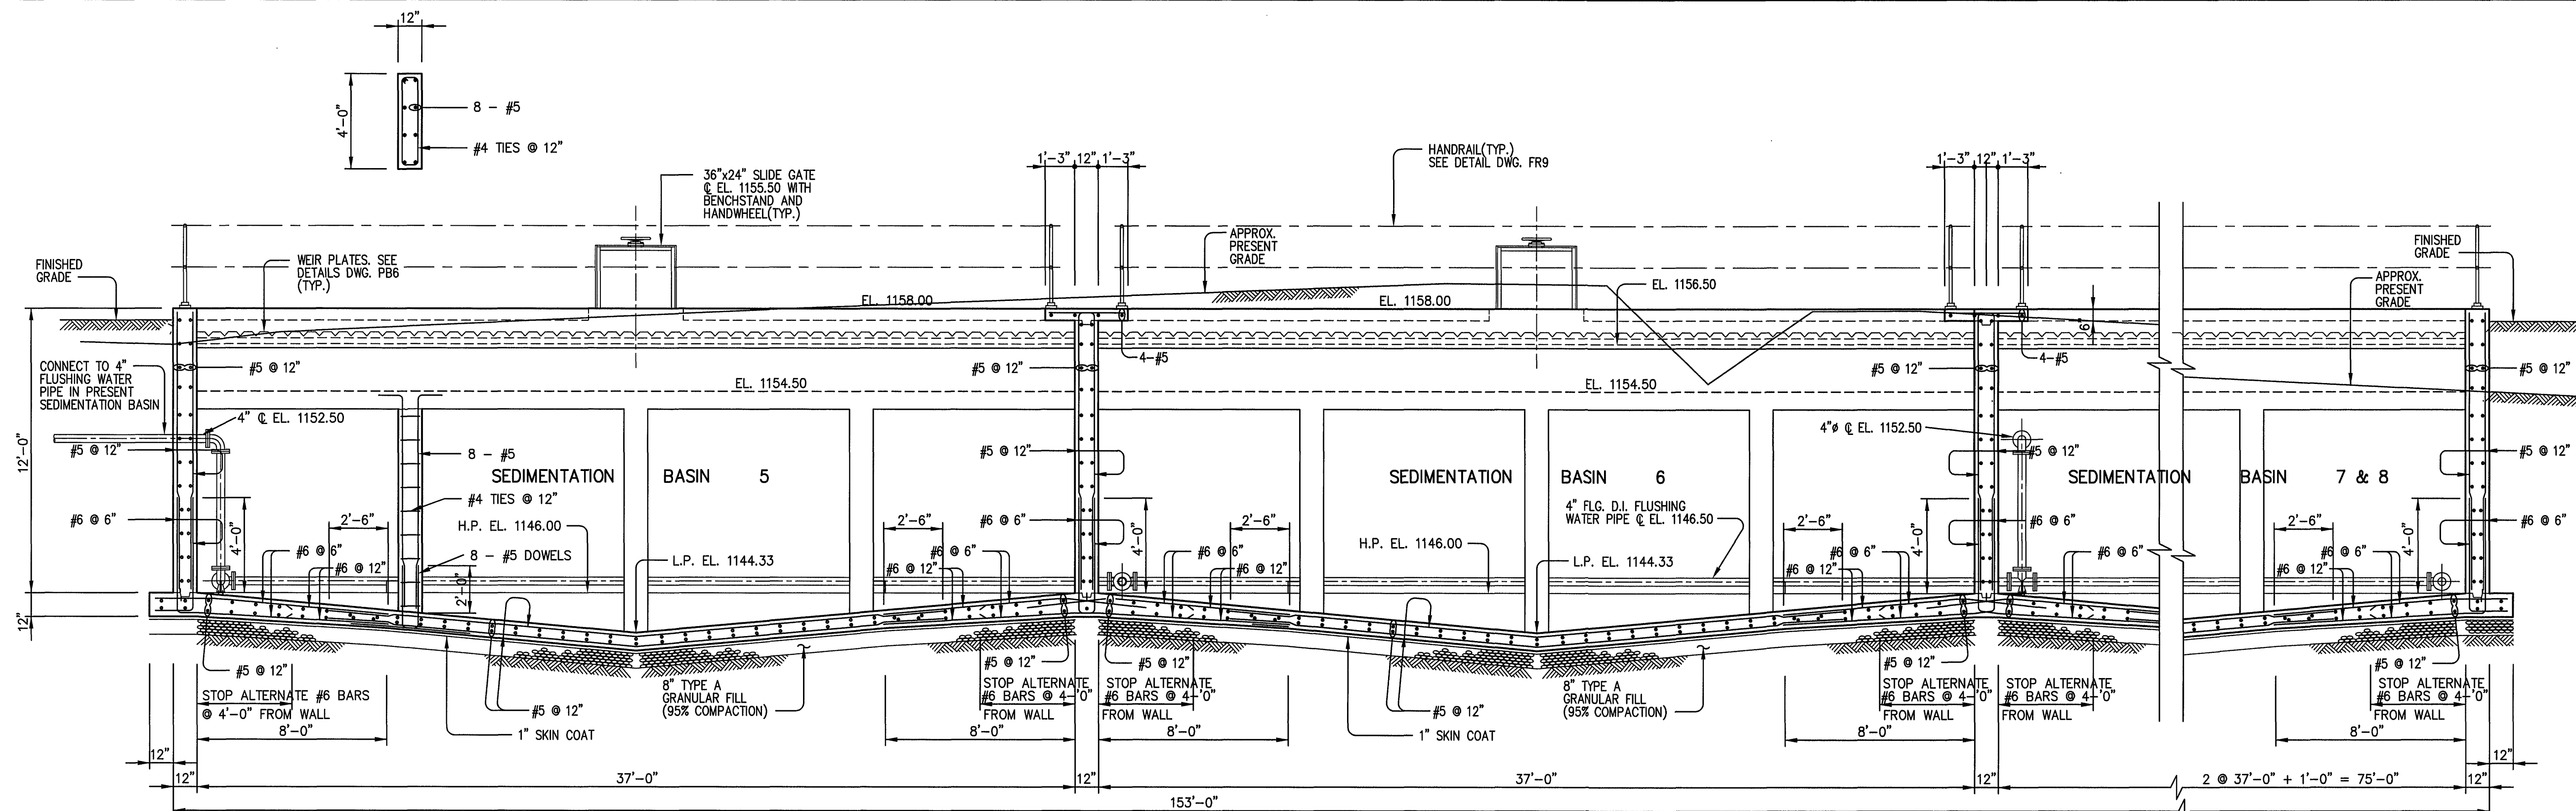


SECTION **PB1**
SCALE: 1/4" = 1'-0"

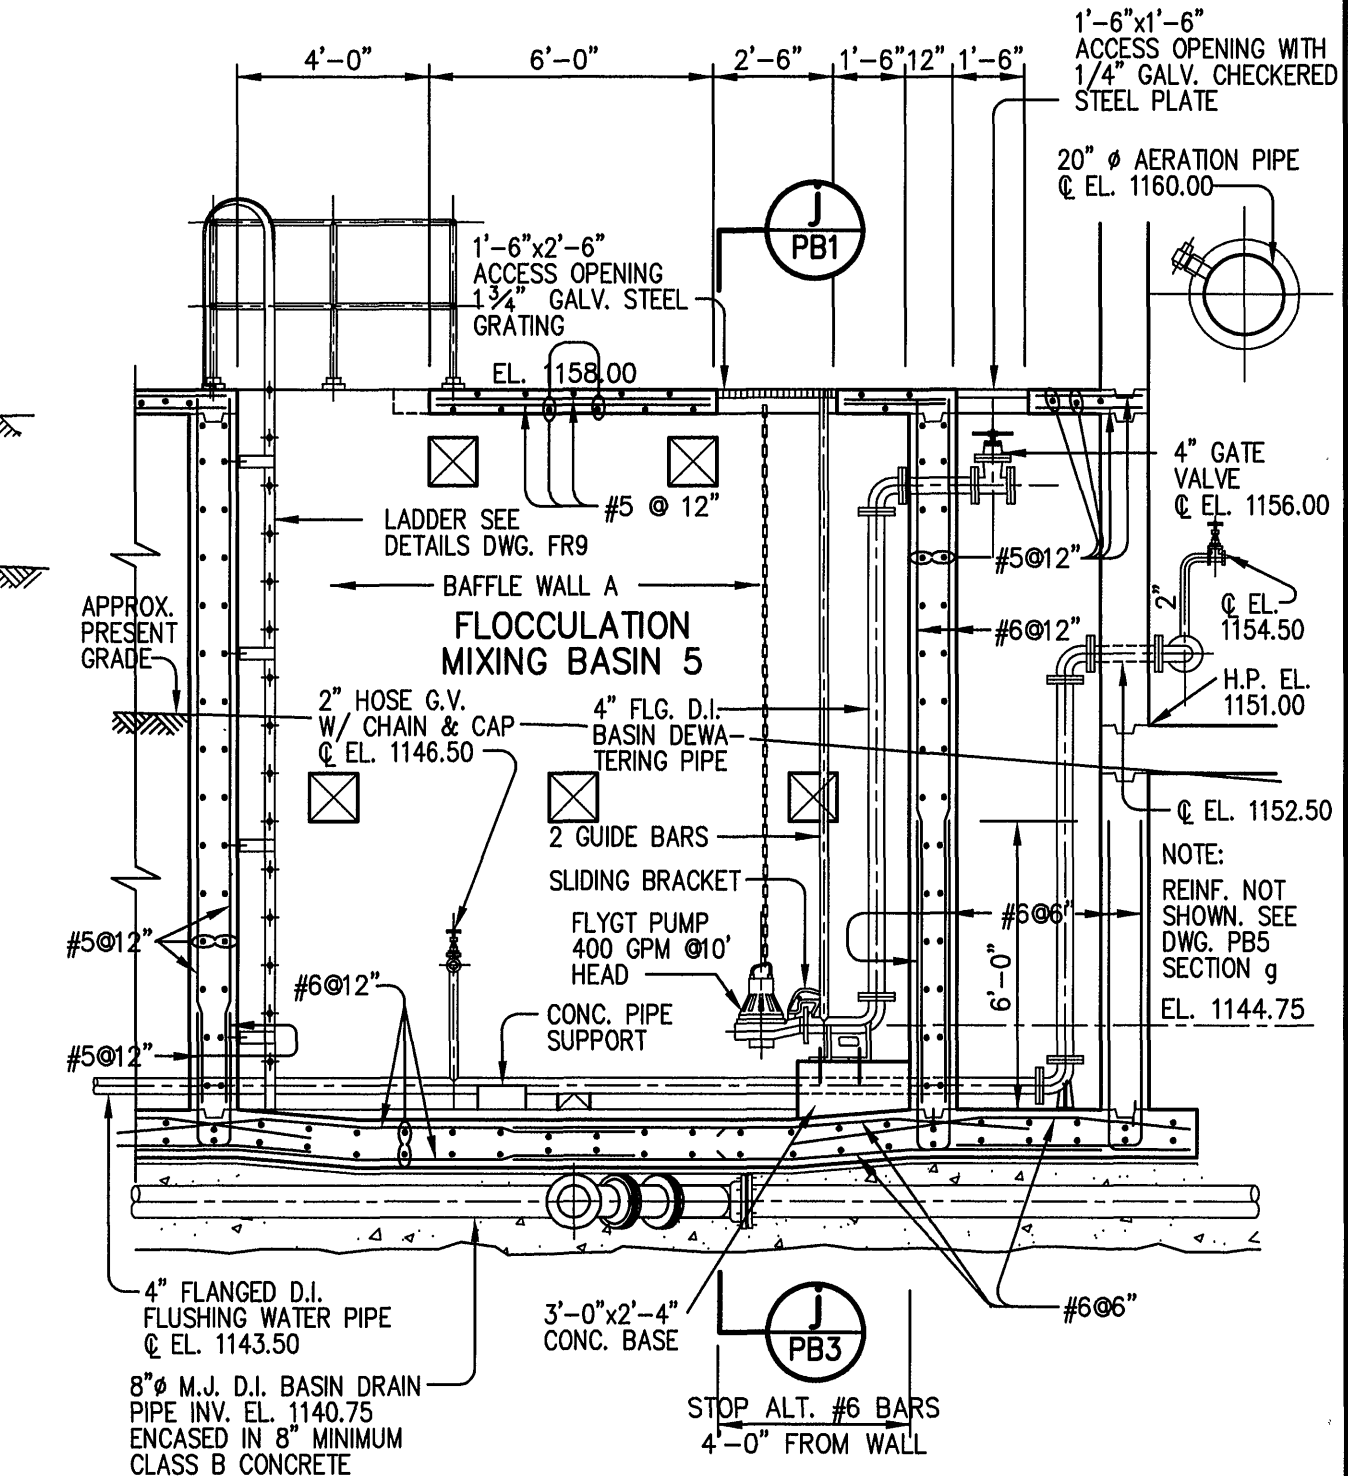


SECTION **PB1**
SCALE: 1/4" = 1'-0"

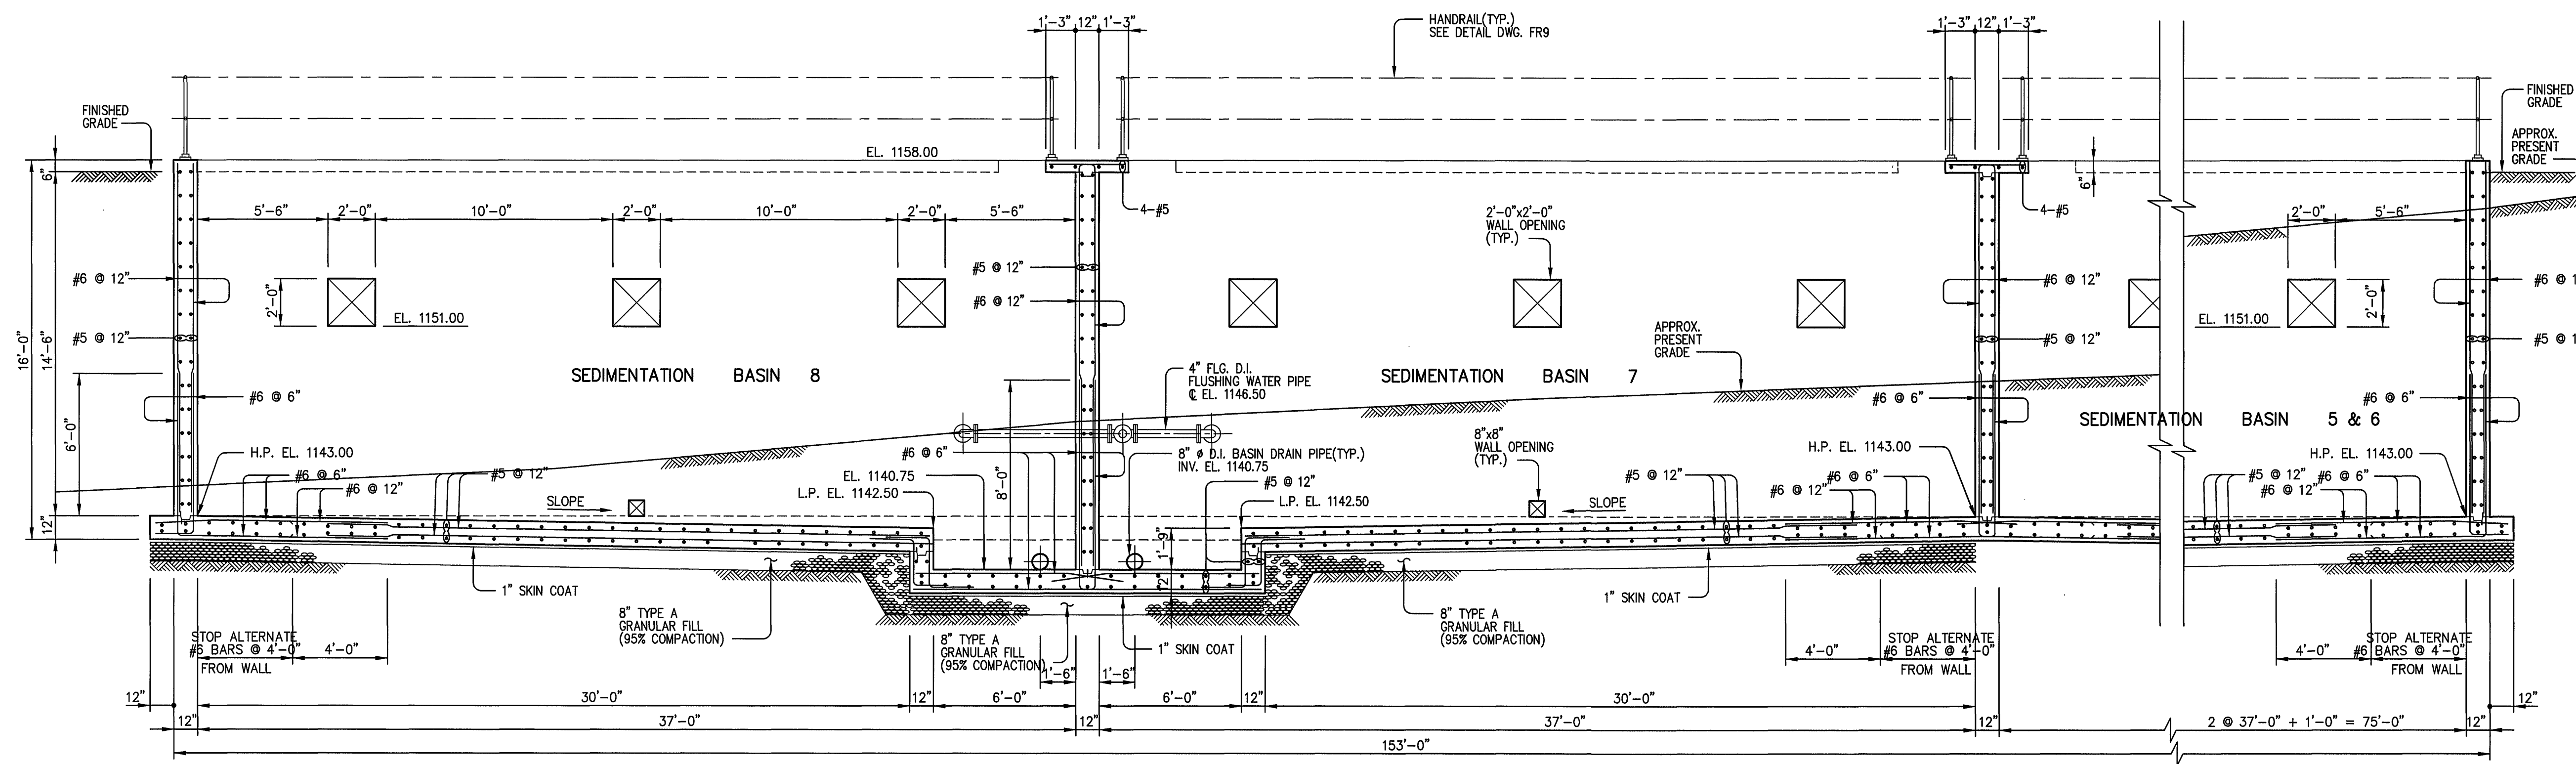

SECTION **PB2**
SCALE: 1/4" = 1'-0"

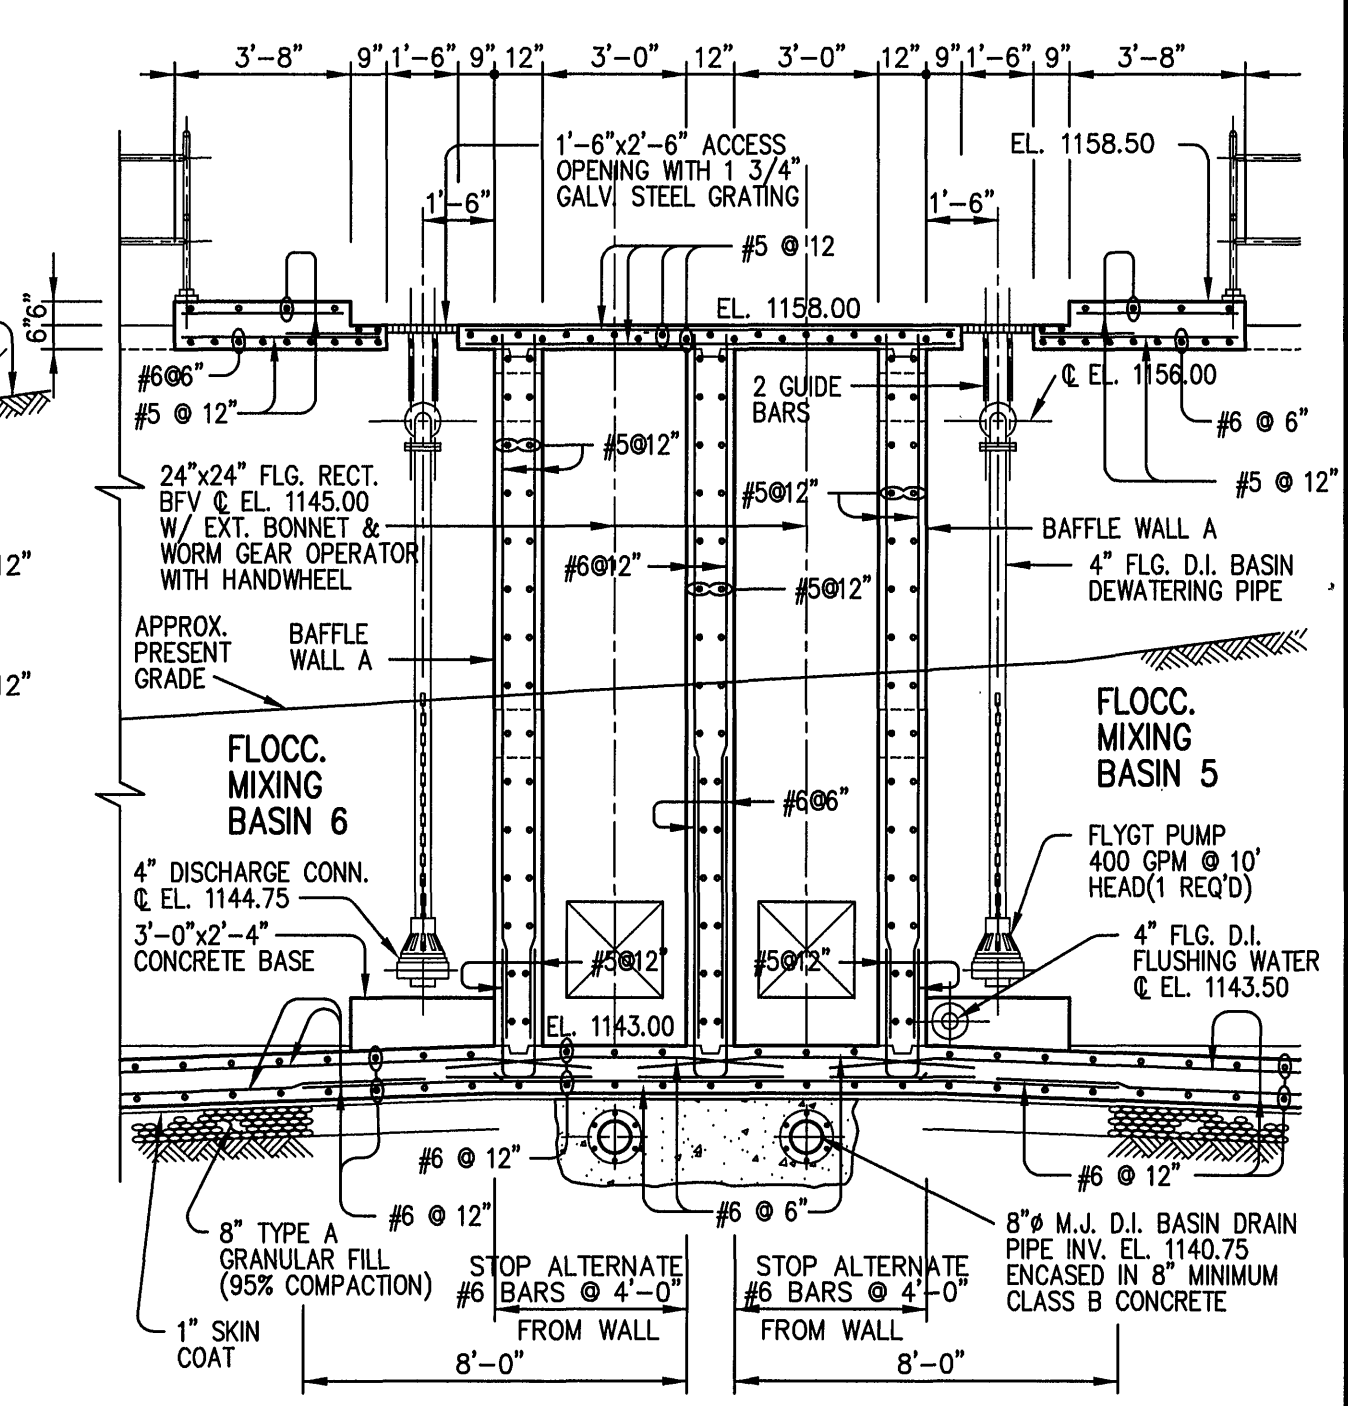

SECTION **PB3**
SCALE: 1/4" = 1'-0"

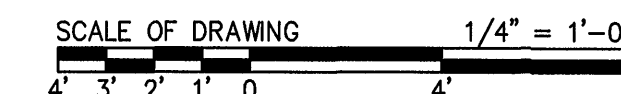

GENERAL NOTES:
1. FOR GENERAL STRUCTURAL DETAILS SEE DWG. FR9.
2. PRIOR TO INSTALLING COMPACTED GRANULAR FILL REMOVE TOP 2'-0" MINIMUM OF SOIL, 9" MINIMUM BELOW BOTTOM OF SLAB AND TO UNDISTURBED SOIL.

DRAWING OF RECORD
DATE: SEP 30 1997

MATTERN & CRAIG CONSULTING ENGINEERS • SURVEYORS ROANOKE VIRGINIA	DESIGNED:		REV.	DATE	DESCRIPTION	BY	APP.	CARVINS COVE FILTER PLANT IMPROVEMENTS – PHASE I ROANOKE, VIRGINIA	DATE APRIL 1992	
	DRAWN: HFF									COMM. NO. 9130
	CHECKED:									SHEET PB3
ALVORD, BURDICK & HOWSON ENGINEERS CHICAGO								12 MGD PRETREATMENT BASINS – SECTIONS		