



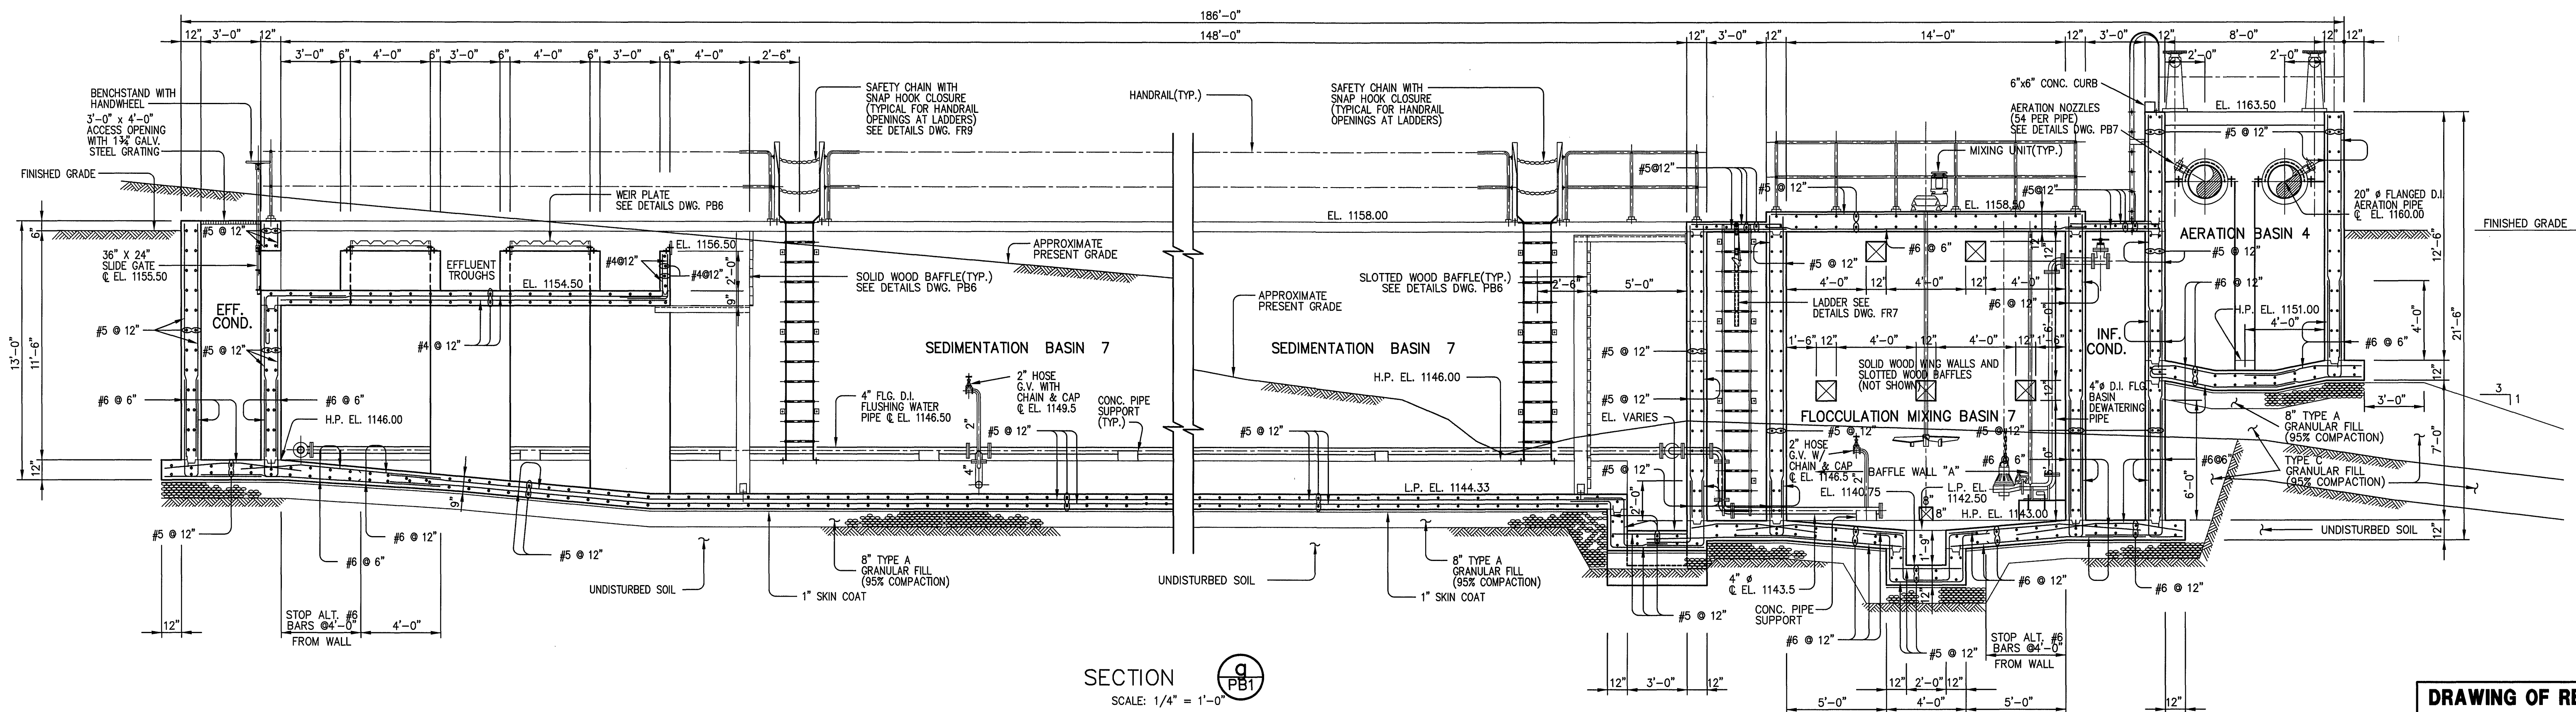

DRAWING OF RECORD
DATE: SEP 30 1997

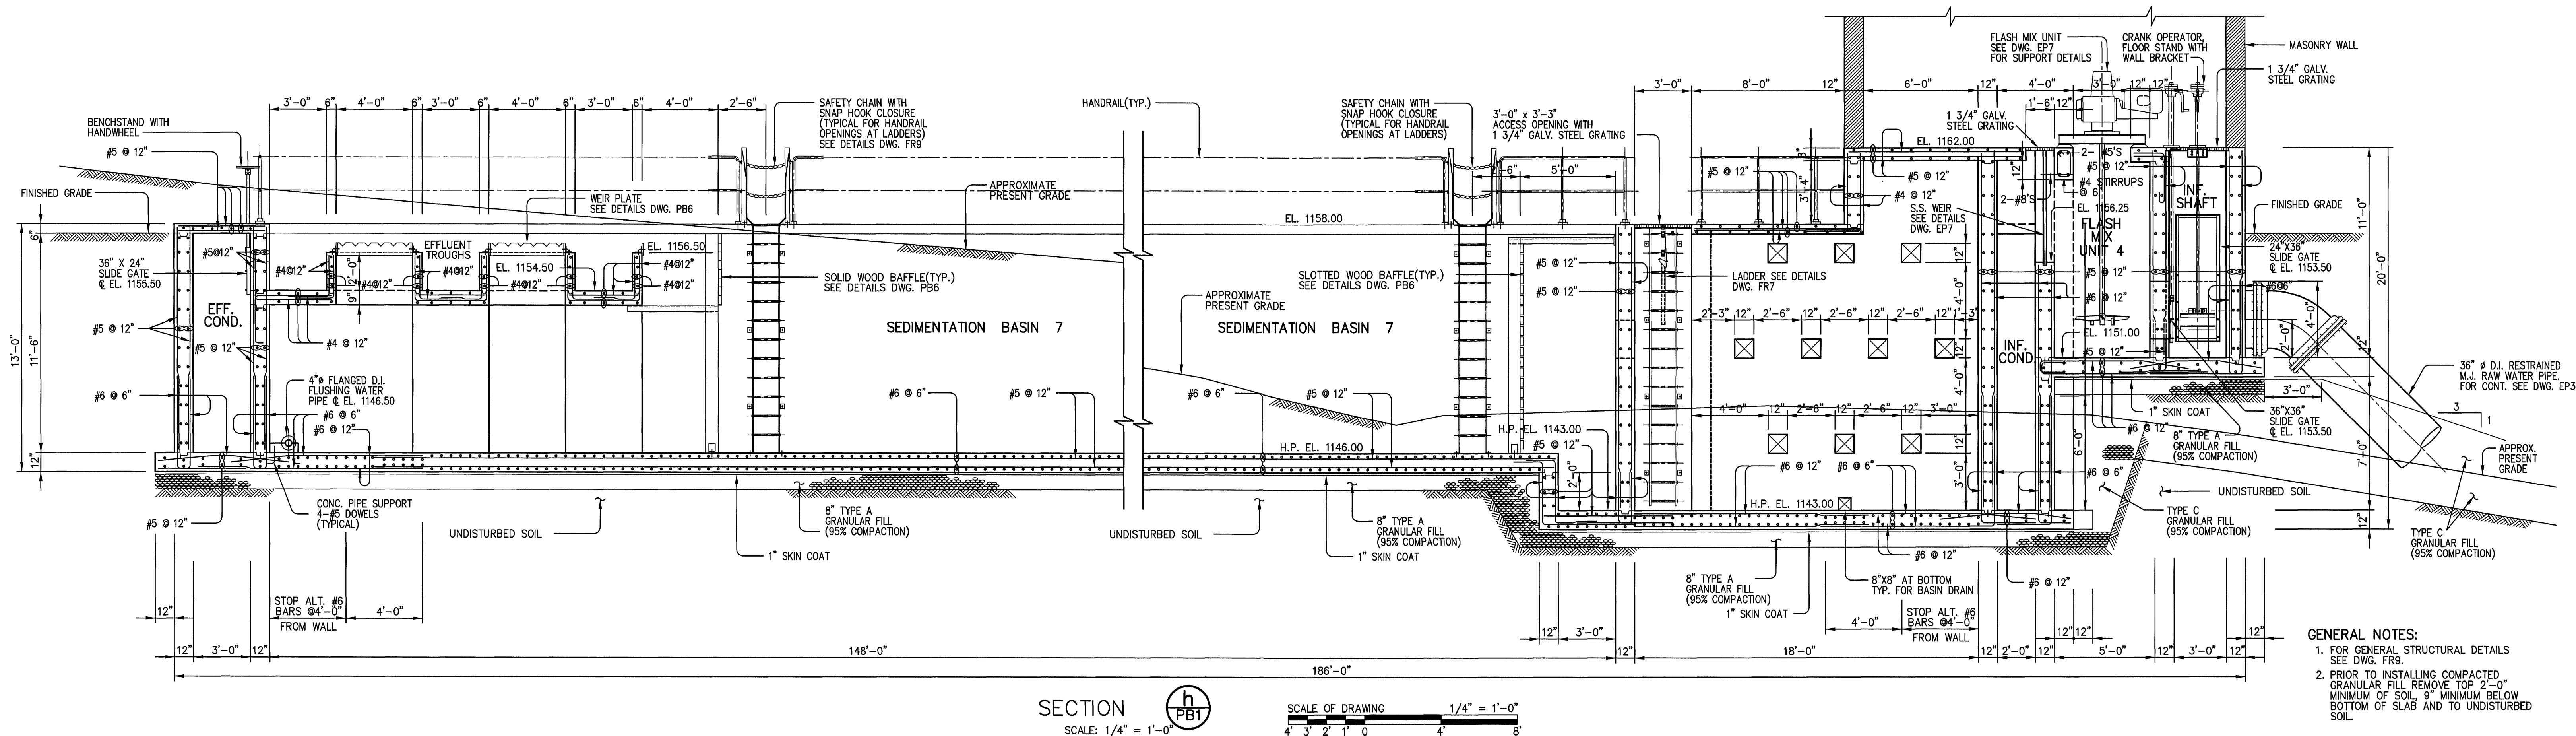

- GENERAL NOTES:**
1. FOR GENERAL STRUCTURAL DETAILS SEE DWG. FR9
 2. PRIOR TO INSTALLING COMPACTED GRANULAR FILL REMOVE TOP 2'-0" MINIMUM OF SOIL, 9" MINIMUM BELOW BOTTOM OF SLAB AND TO UNDISTURBED SOIL.

MATTERN & CRAIG
CONSULTING ENGINEERS • SURVEYORS
ROANOKE VIRGINIA

ALVORD, BURDICK & HOWSON
ENGINEERS CHICAGO

DESIGNED:

DRAWN: HFF

CHECKED:



REV.	DATE	DESCRIPTION	BY	APP.

CARVINS COVE FILTER PLANT IMPROVEMENTS – PHASE I
ROANOKE, VIRGINIA

12 MGD PRETREATMENT BASINS – SECTIONS

DATE
APRIL 1992
COMM. NO.
9130
SHEET
PB5