
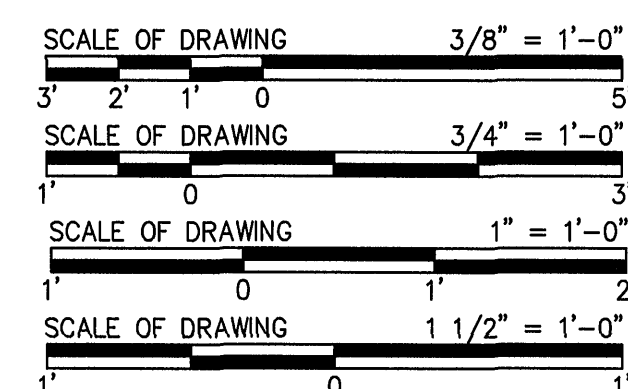
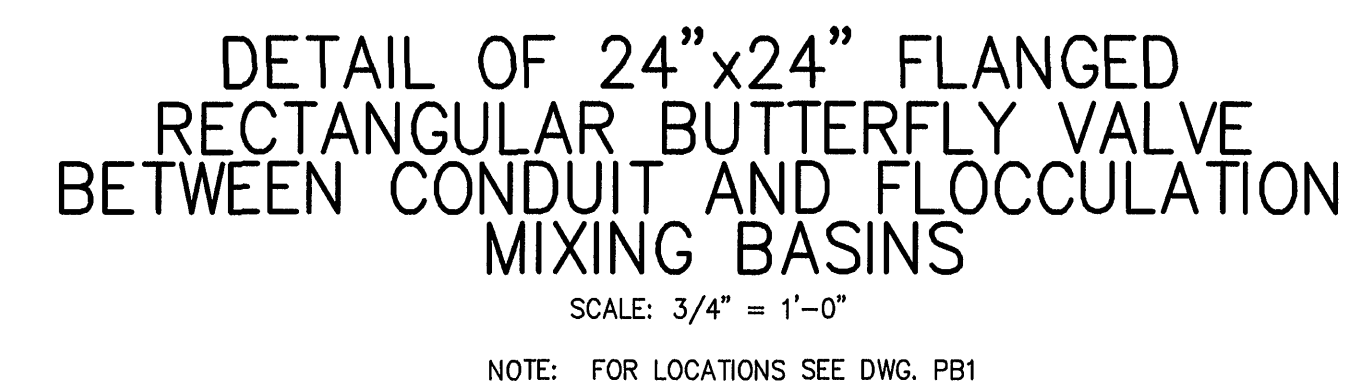
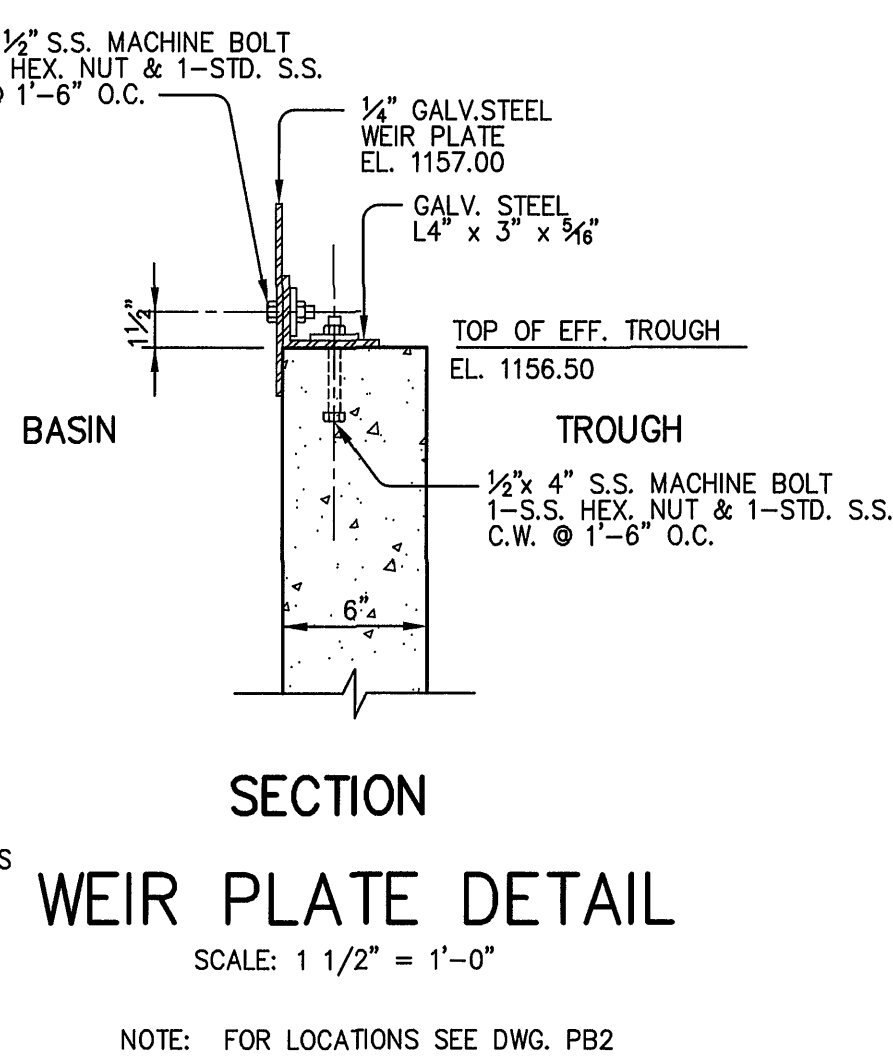
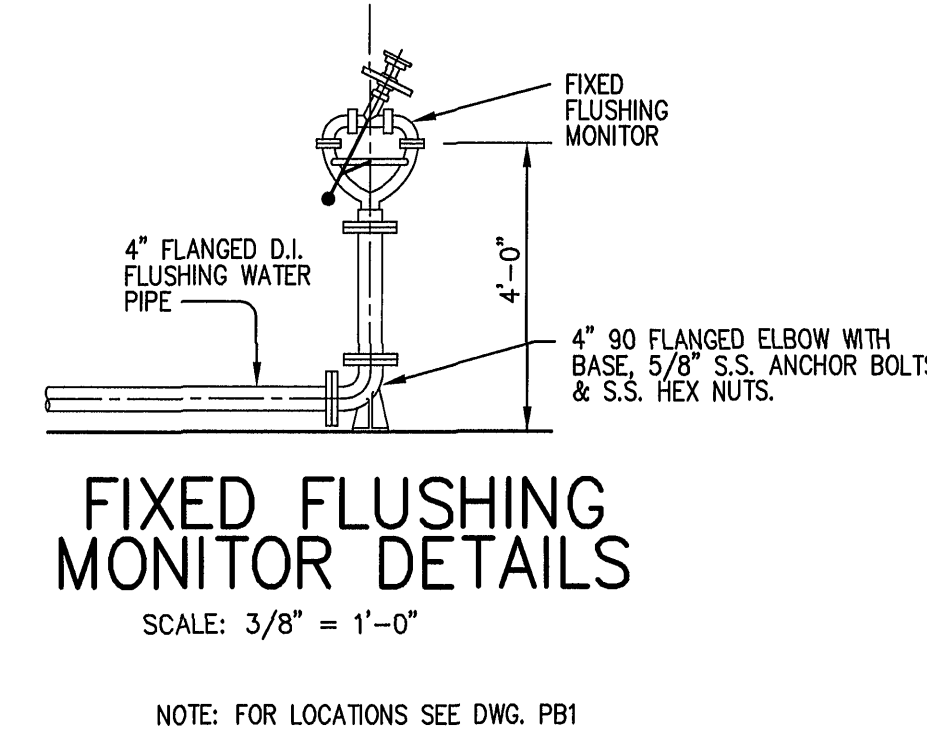
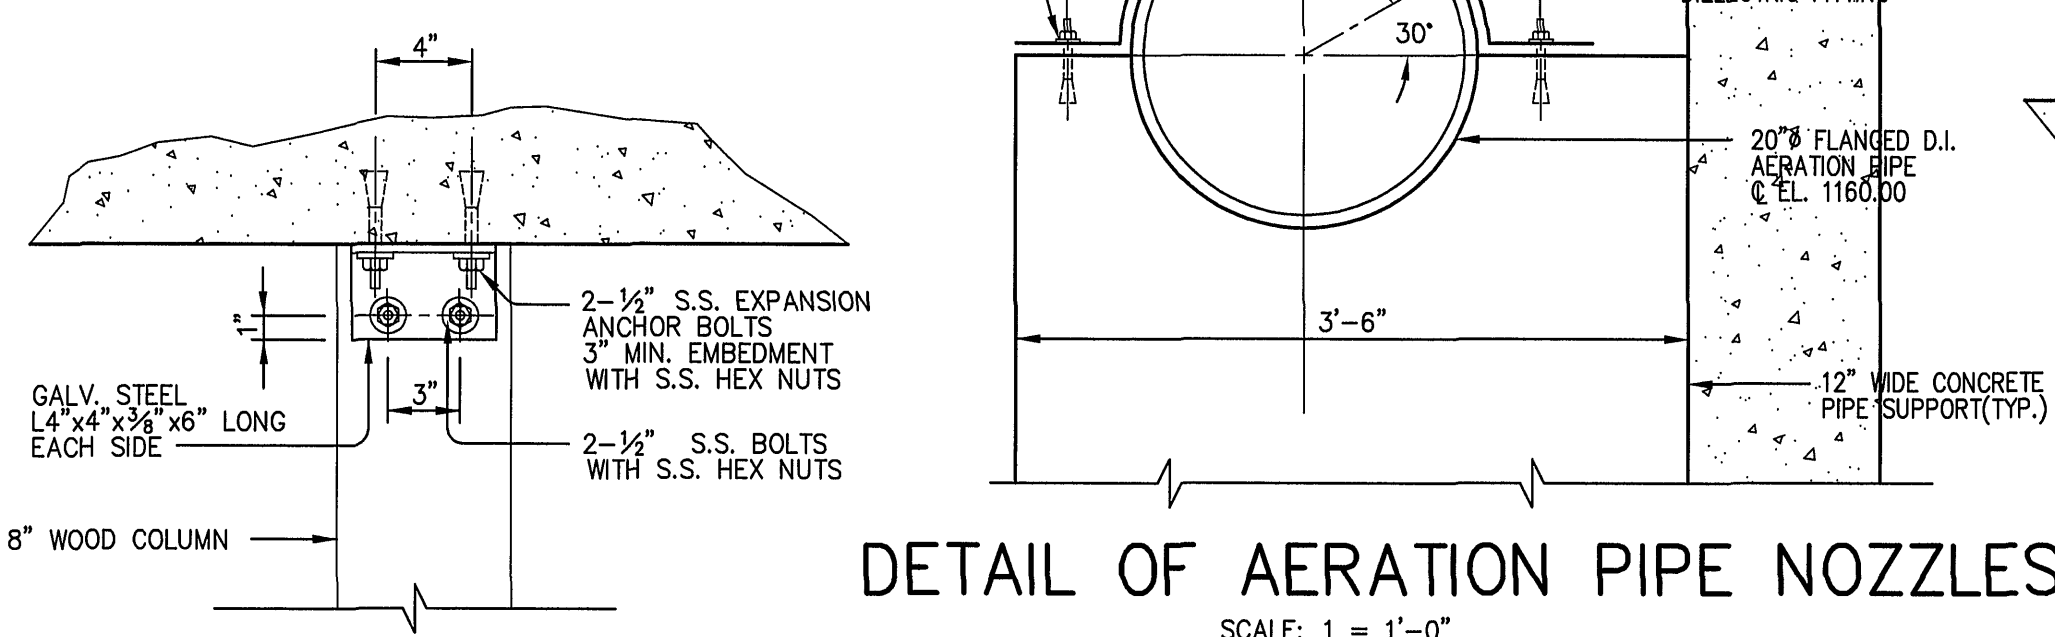
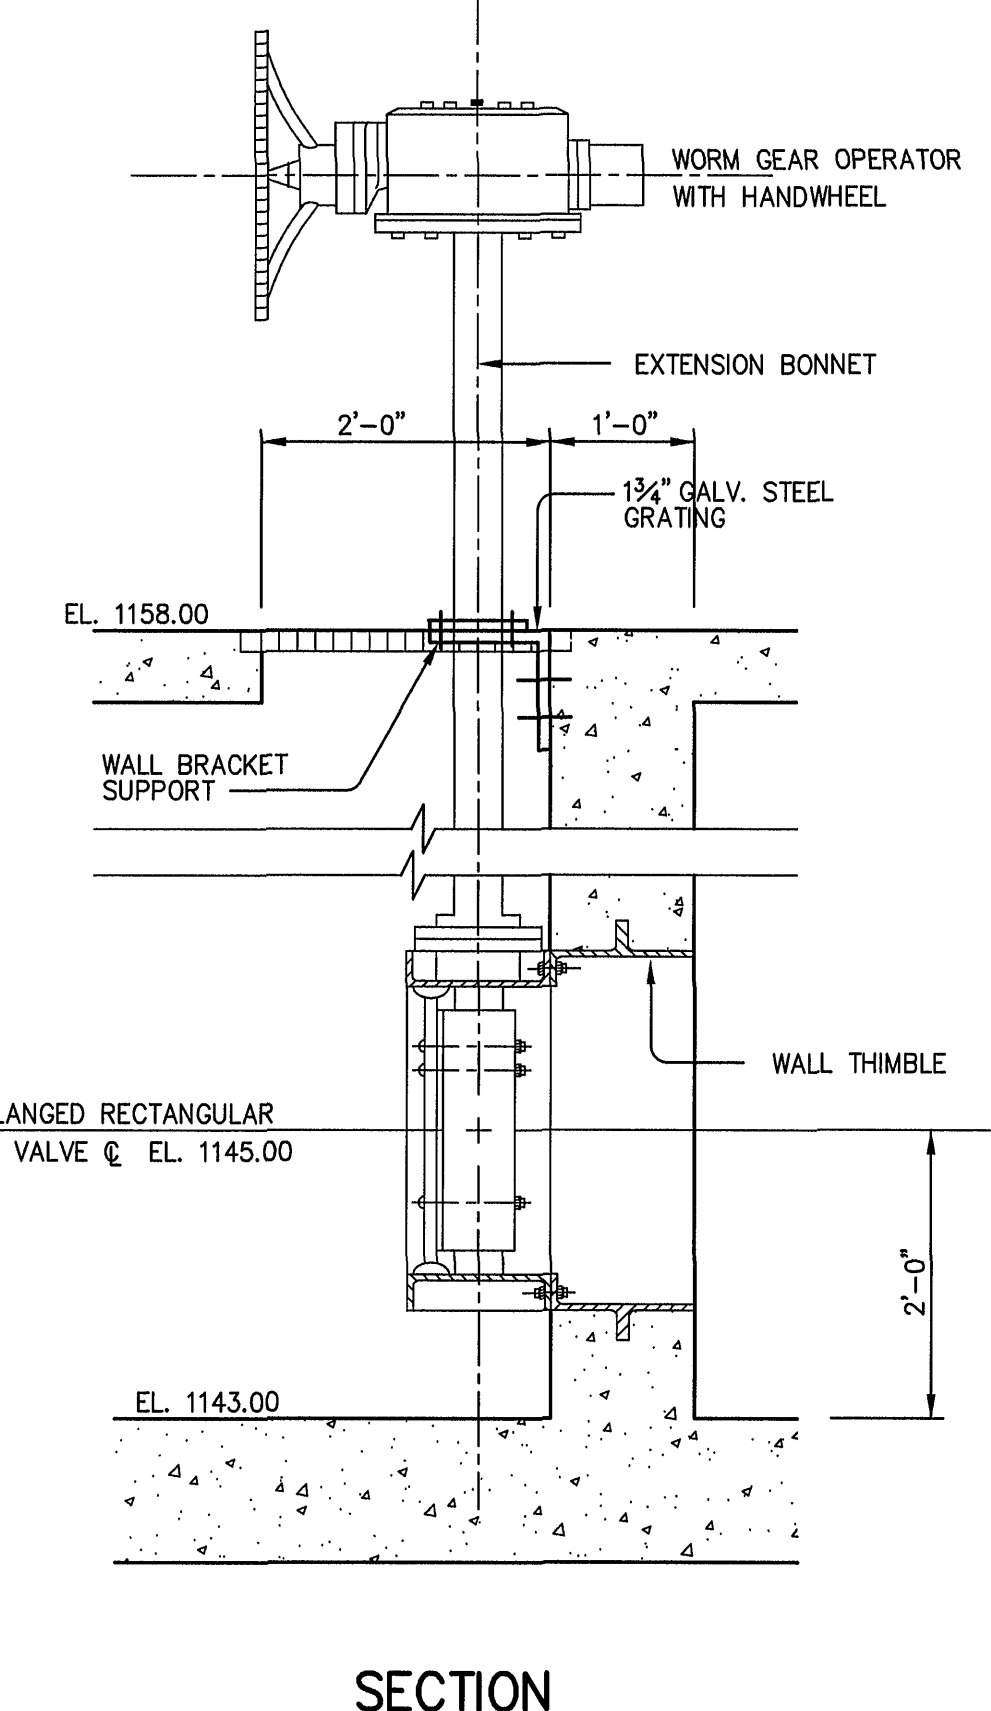
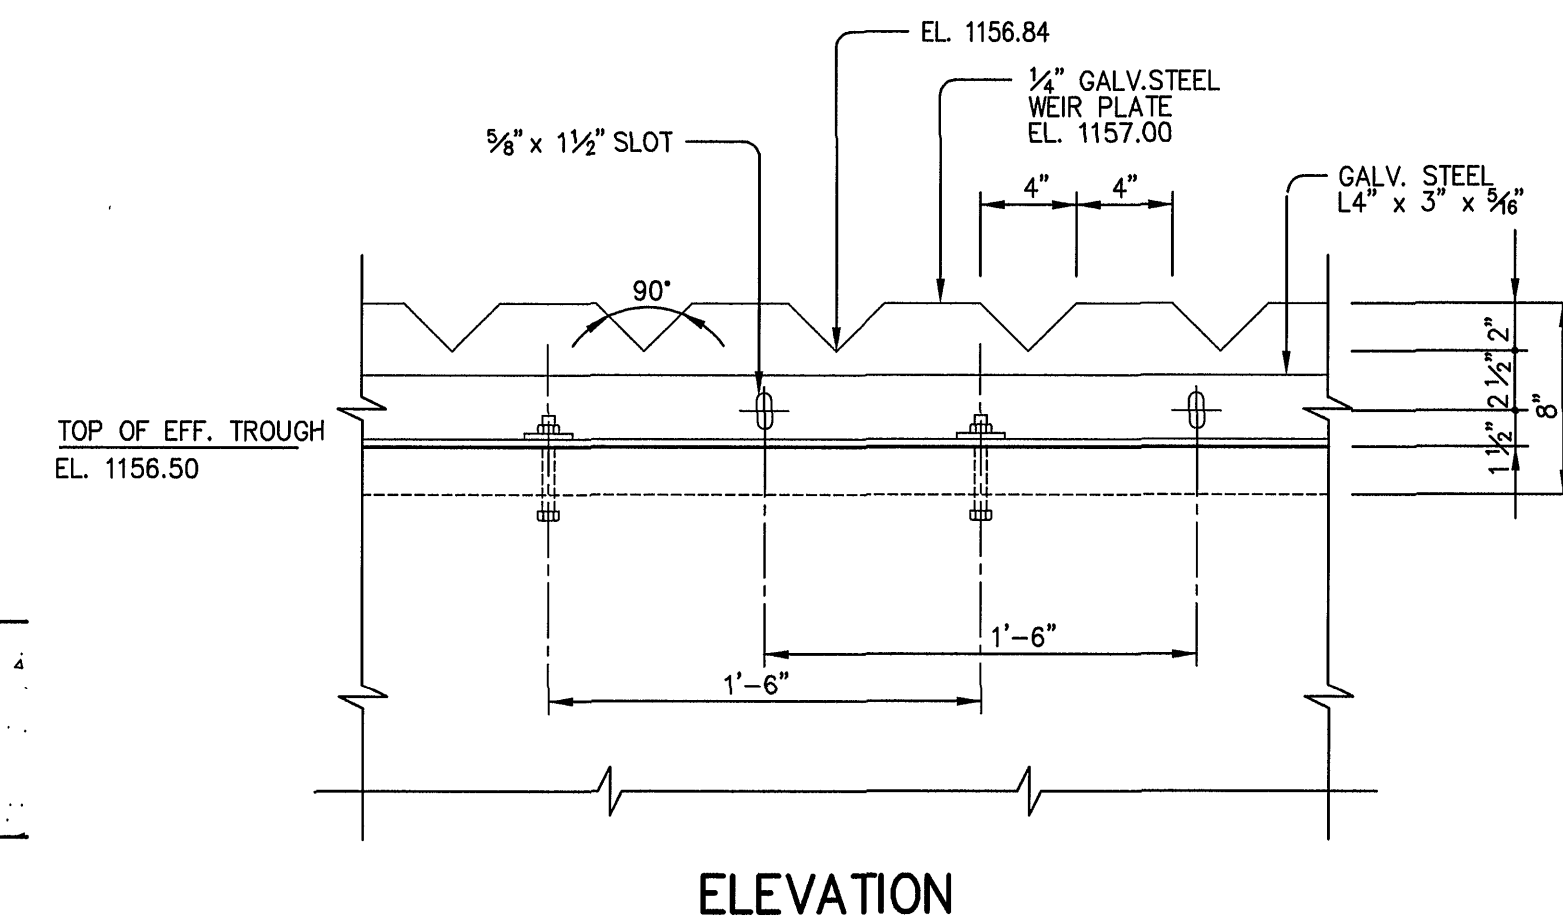
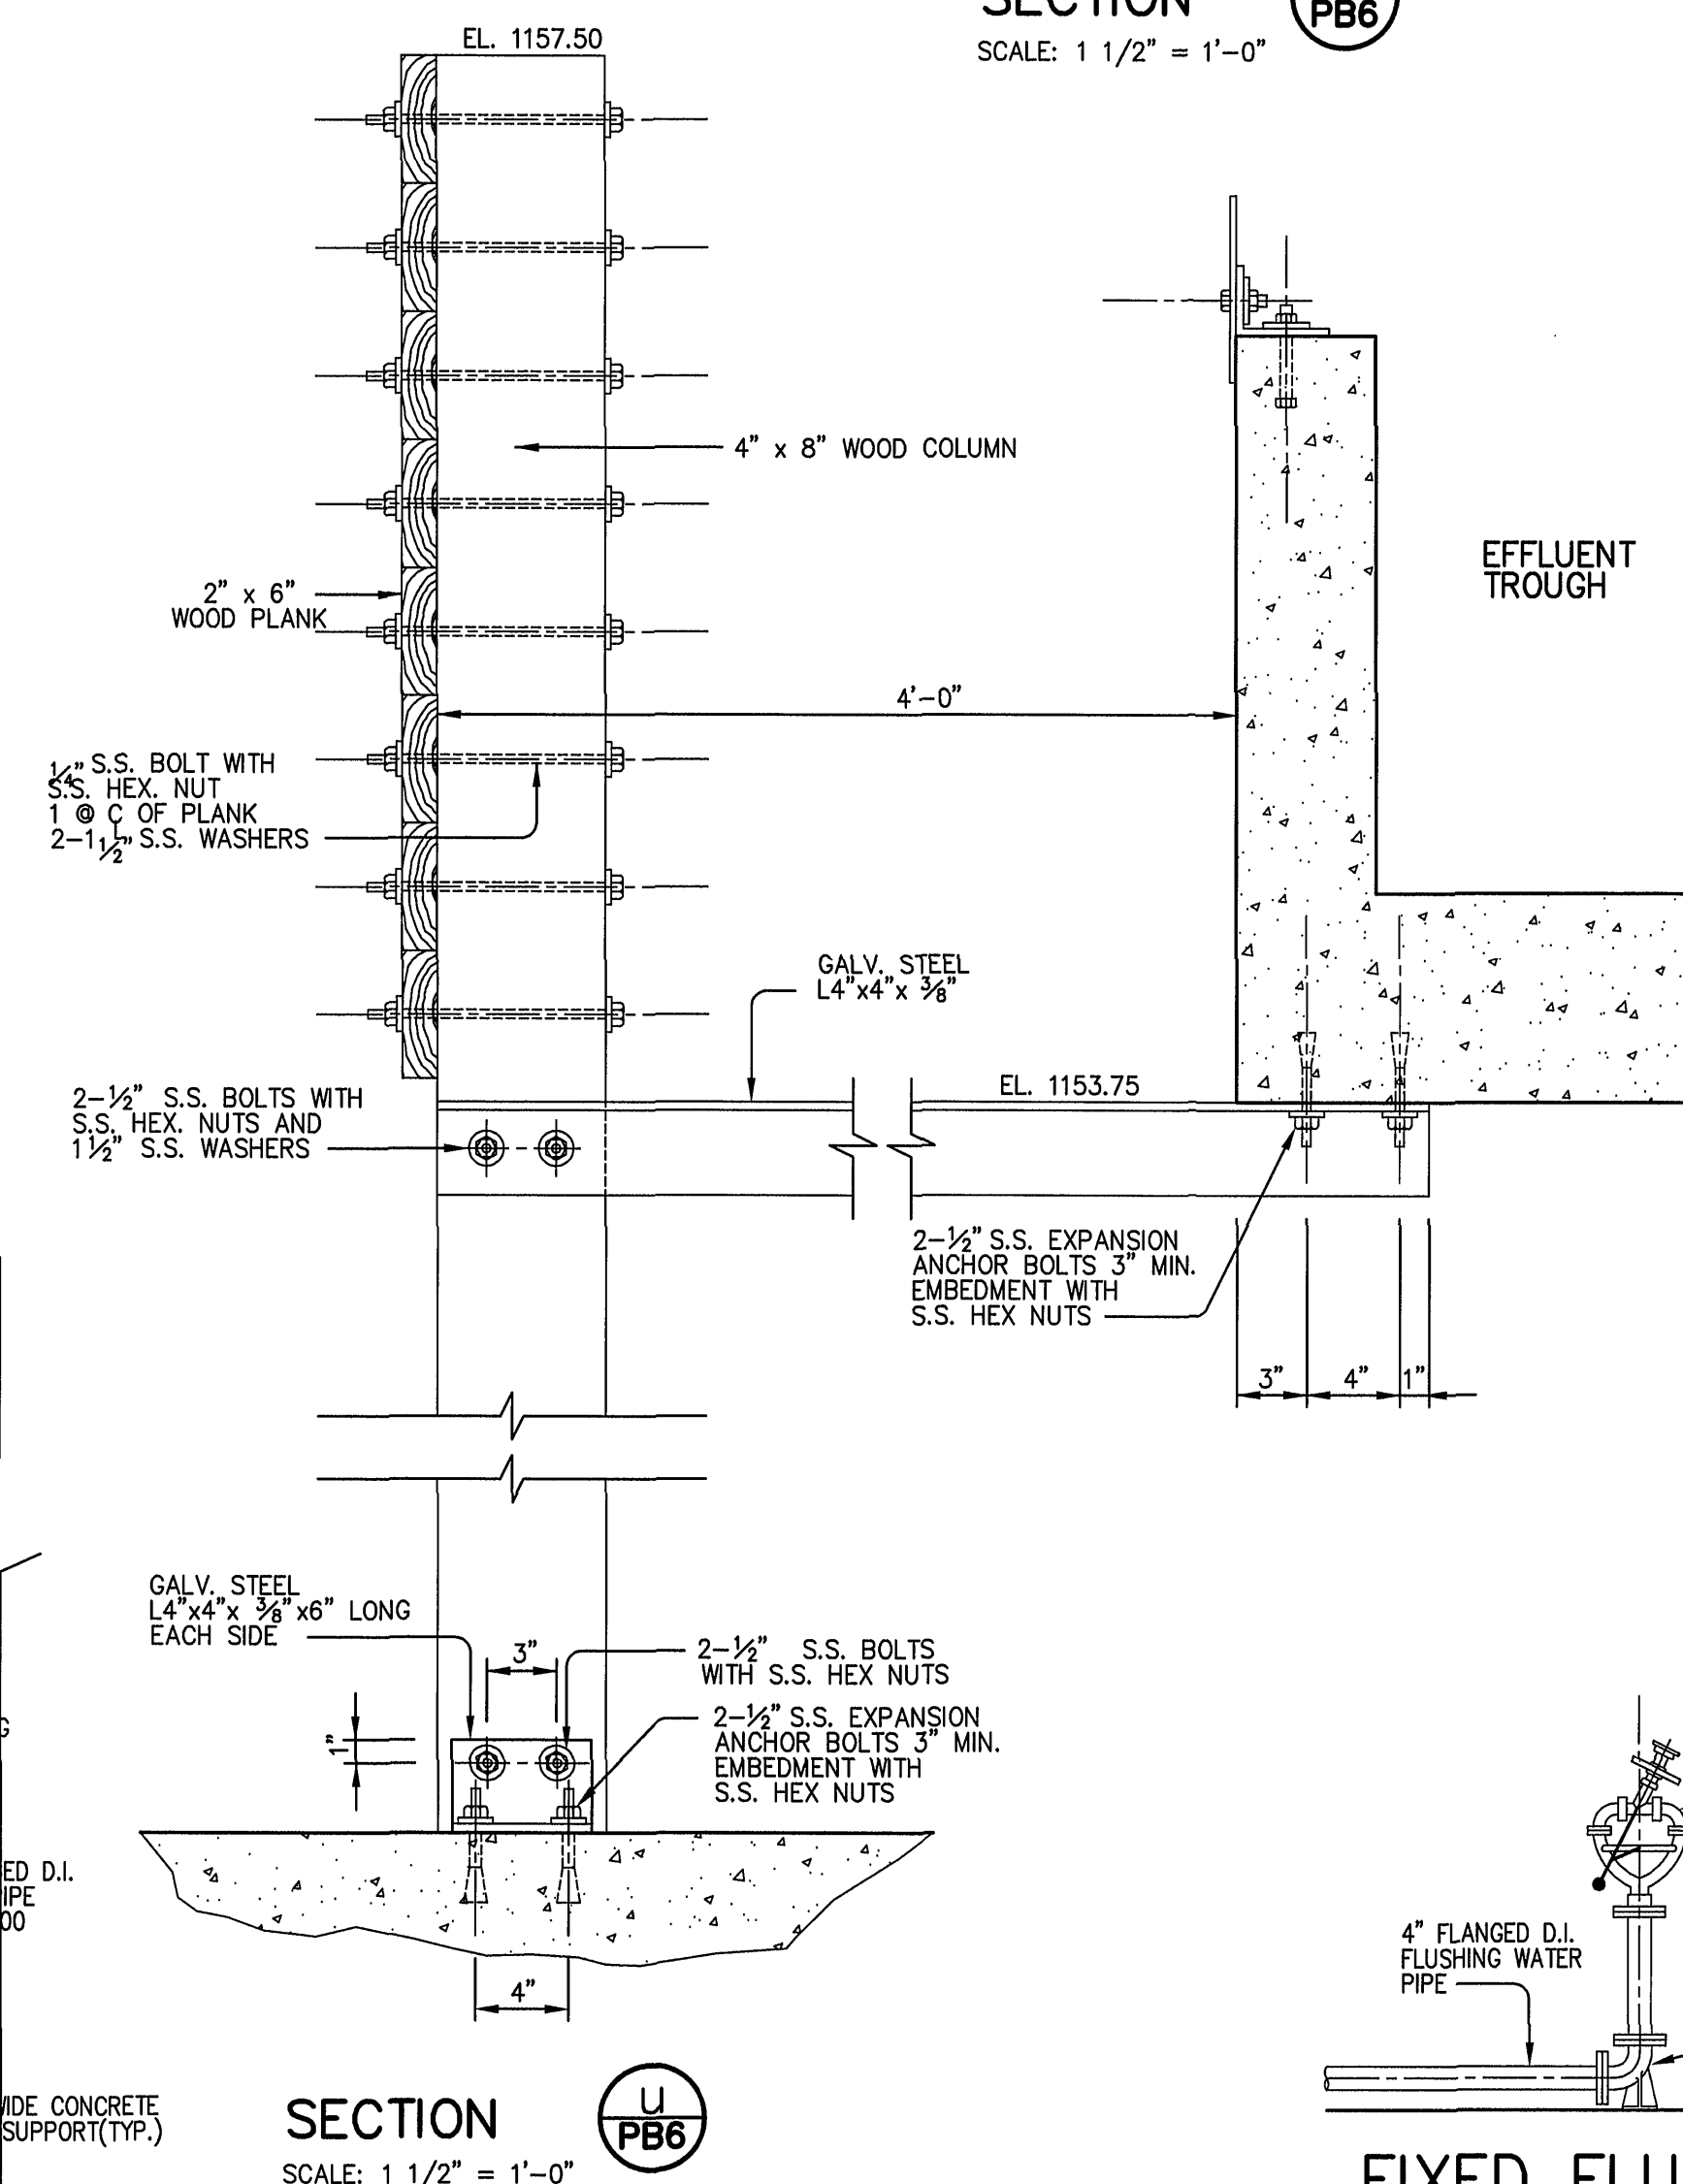
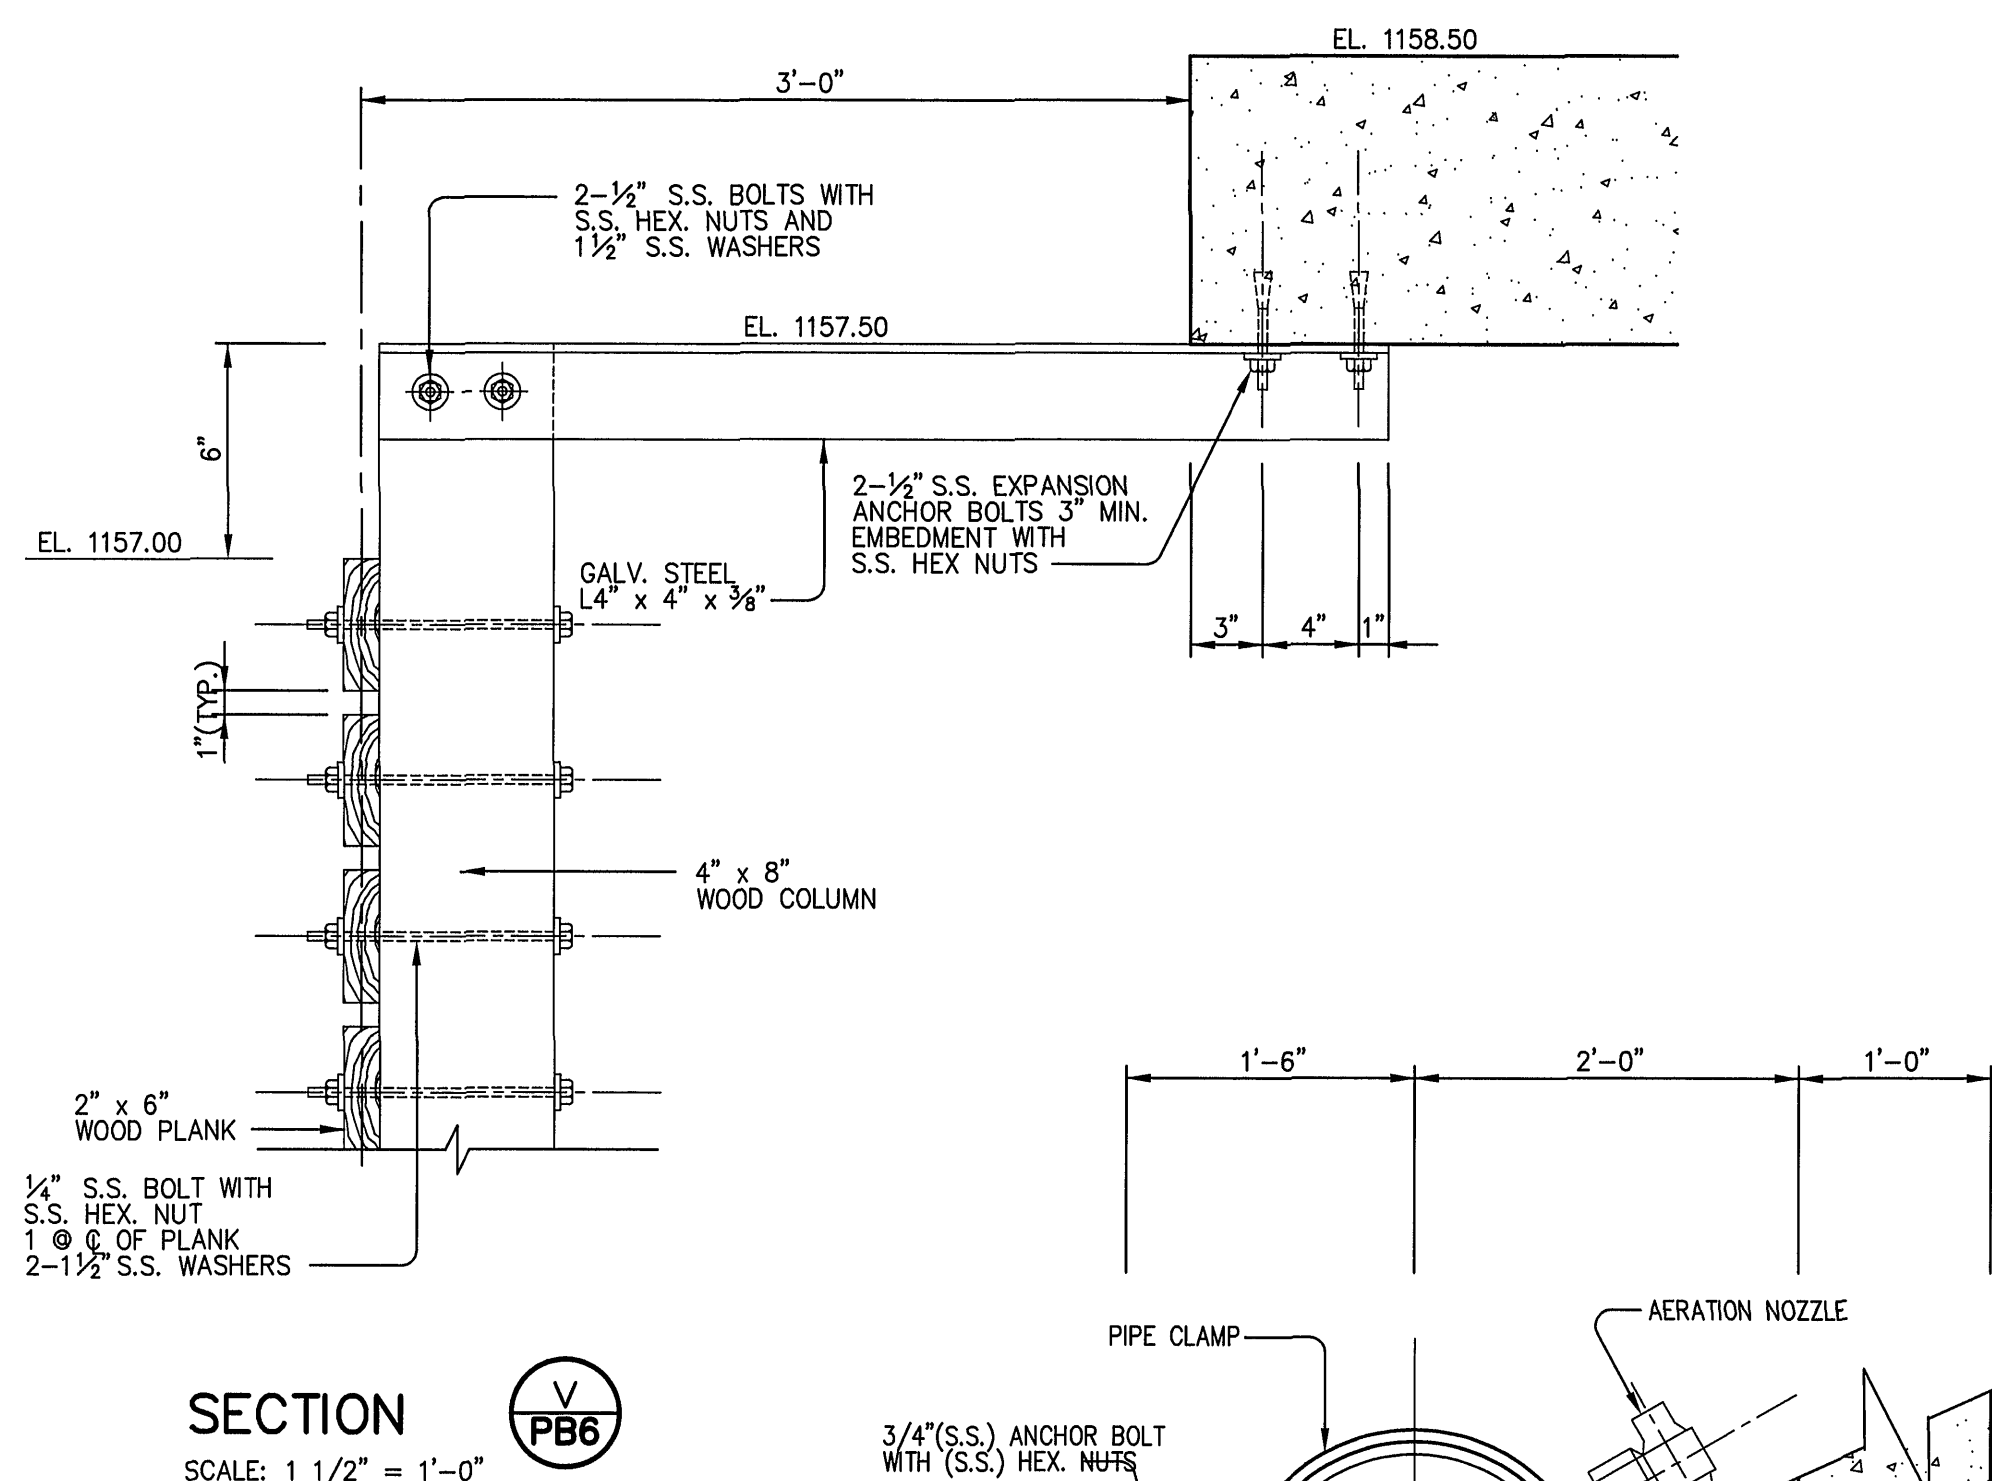
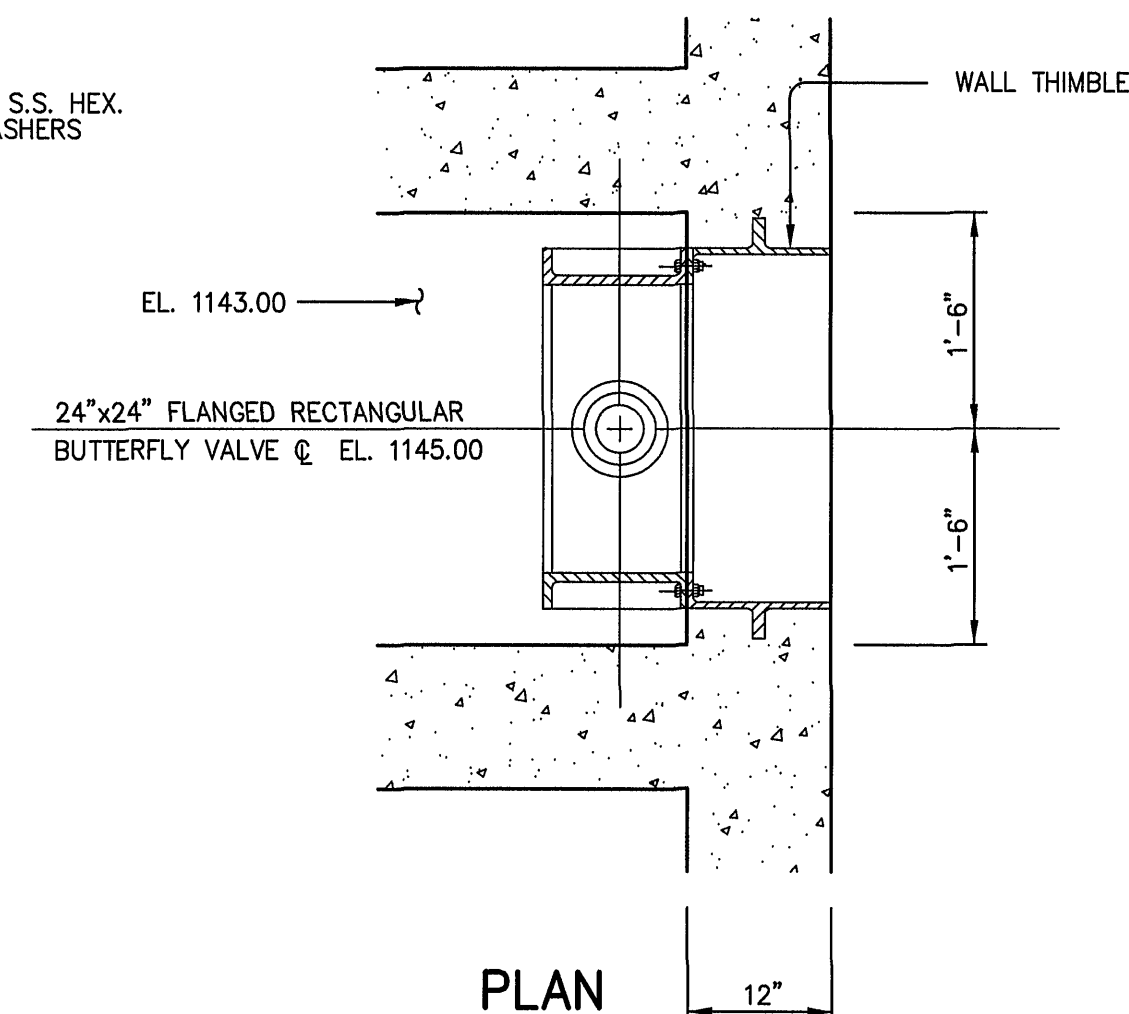
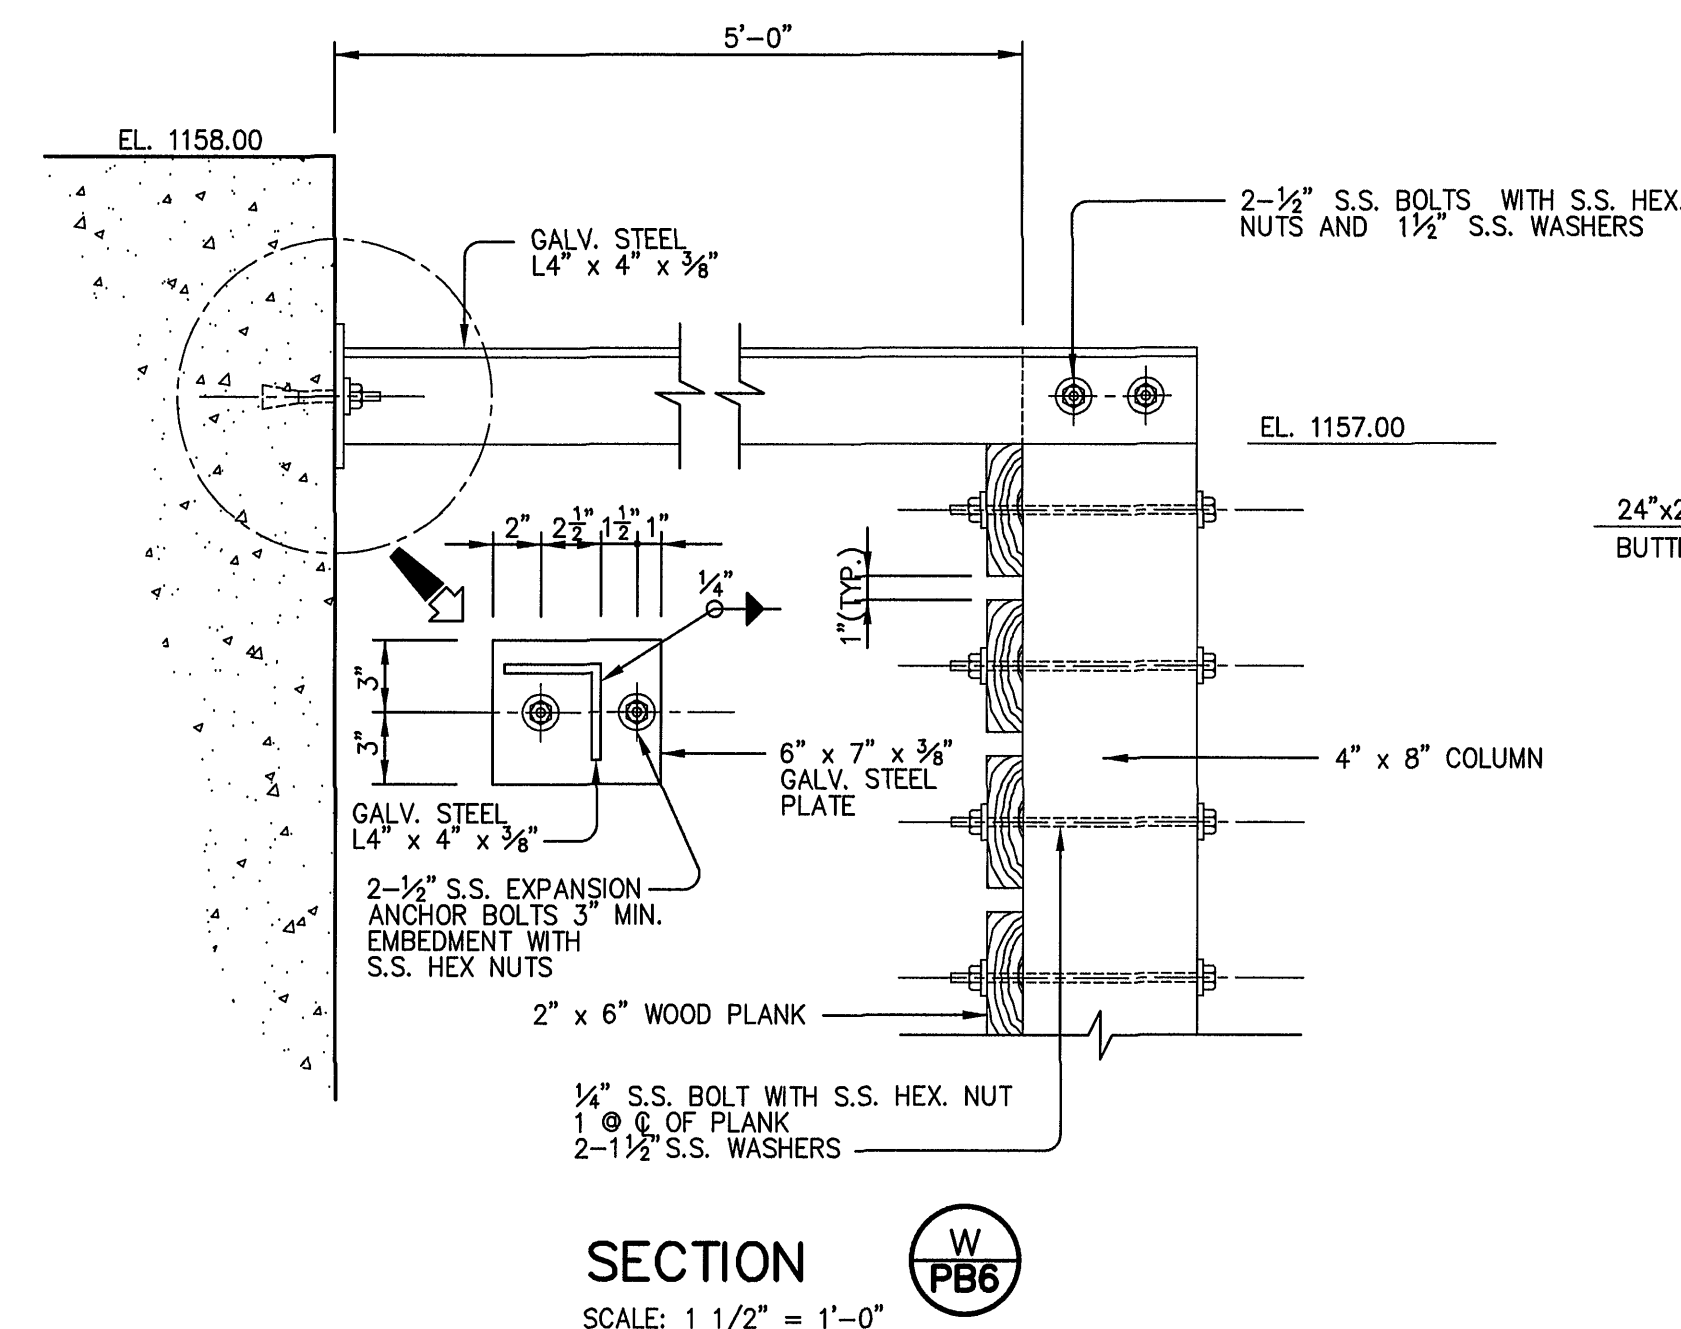
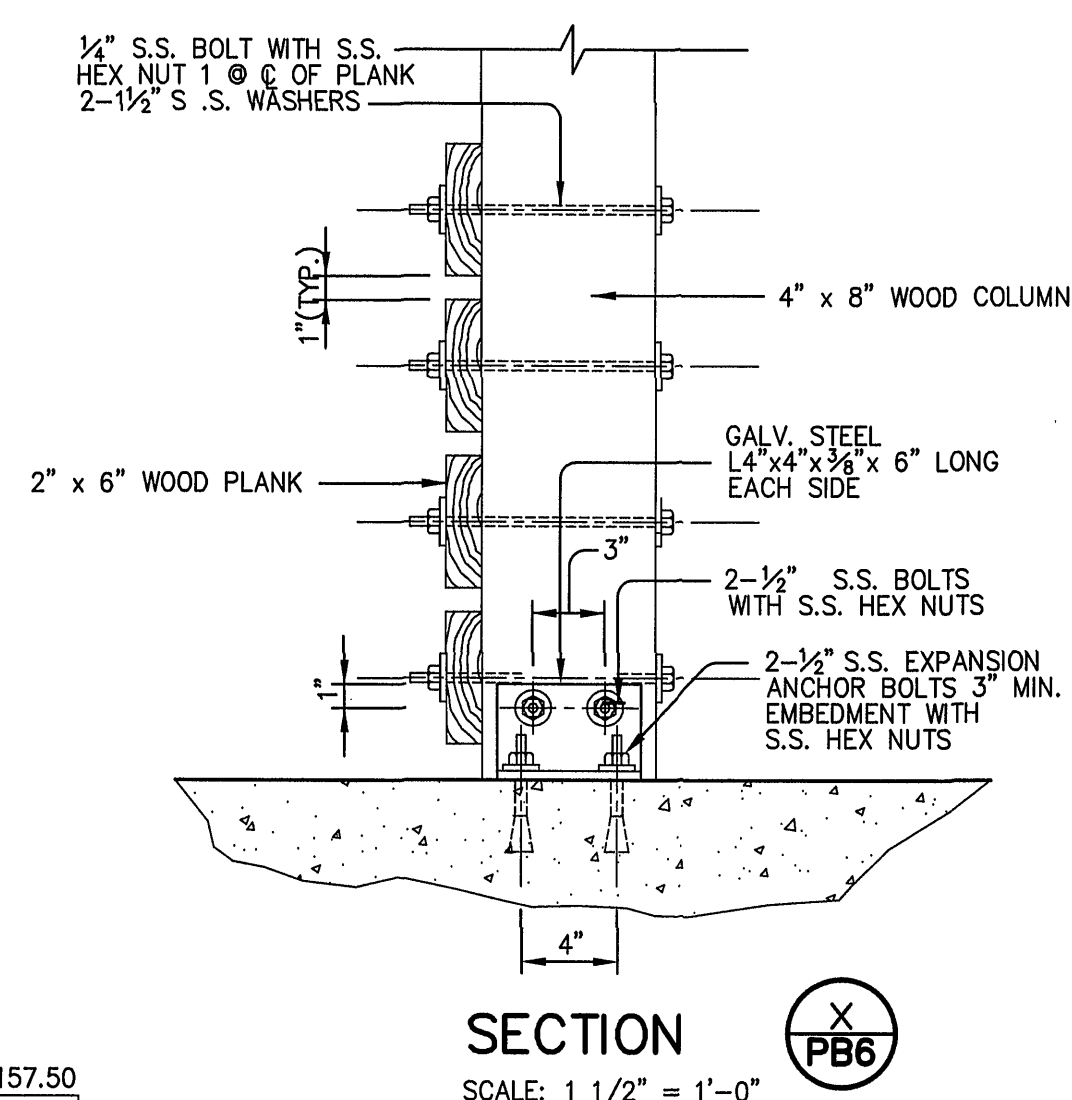
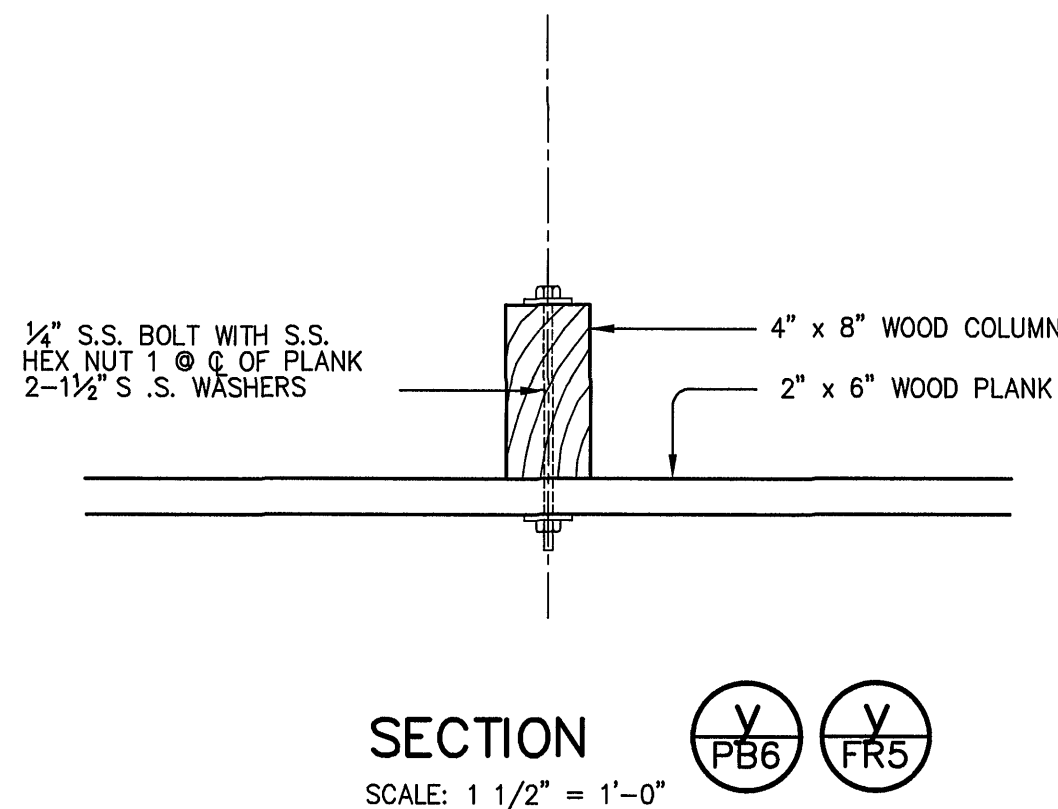
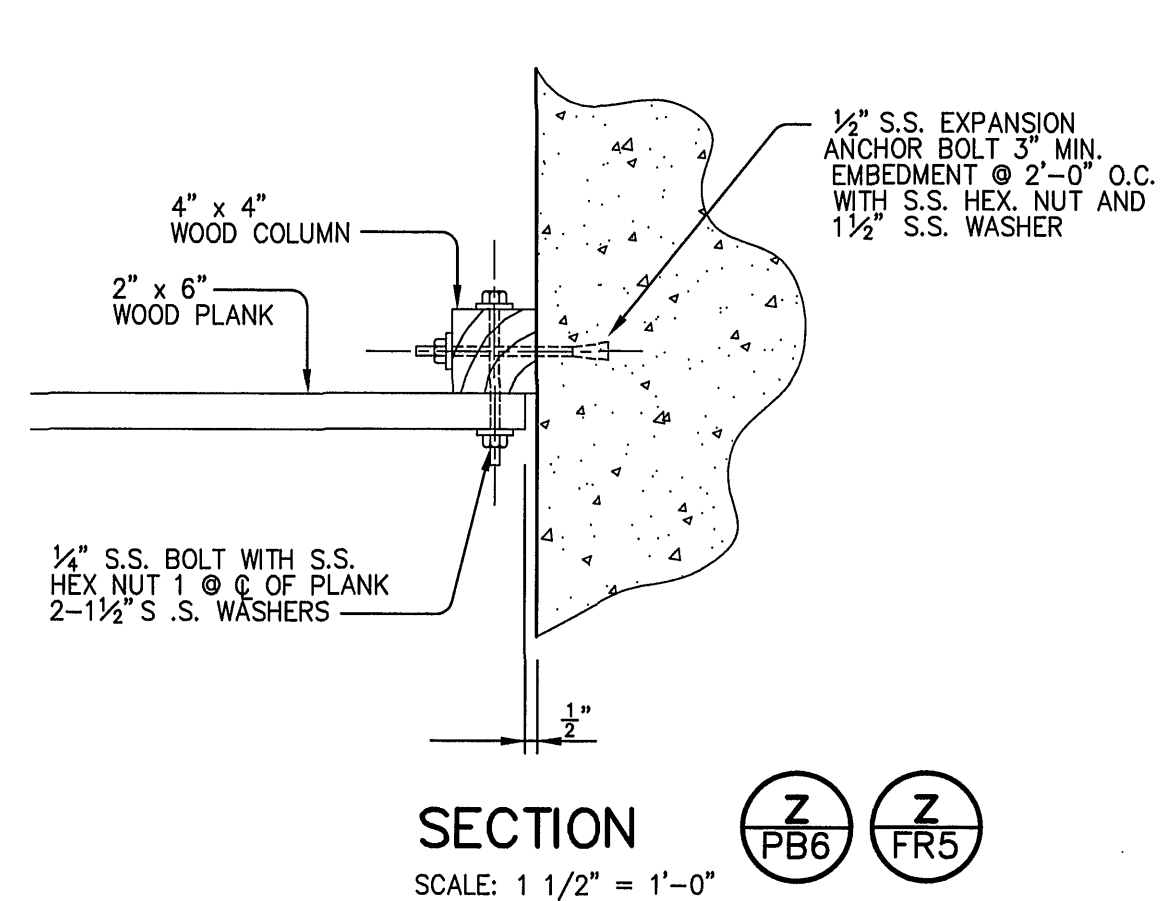


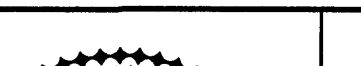

DRAWING OF RECORD
DATE: SEP 30 1997

MATTERN & CRAIG CONSULTING ENGINEERS • SURVEYORS ROANOKE VIRGINIA	DESIGNED:		REV.	DATE	DESCRIPTION	BY	APP.	CARVINS COVE FILTER PLANT IMPROVEMENTS – PHASE I ROANOKE, VIRGINIA	DATE APRIL 1992	
	DRAWN: H. FERRERA									COMM. NO. 9130
	CHECKED:									SHEET PB7
ALVORD, BURDICK & HOWSON ENGINEERS CHICAGO								12 MGD PRETREATMENT BASINS – BAFFLE DETAILS		