


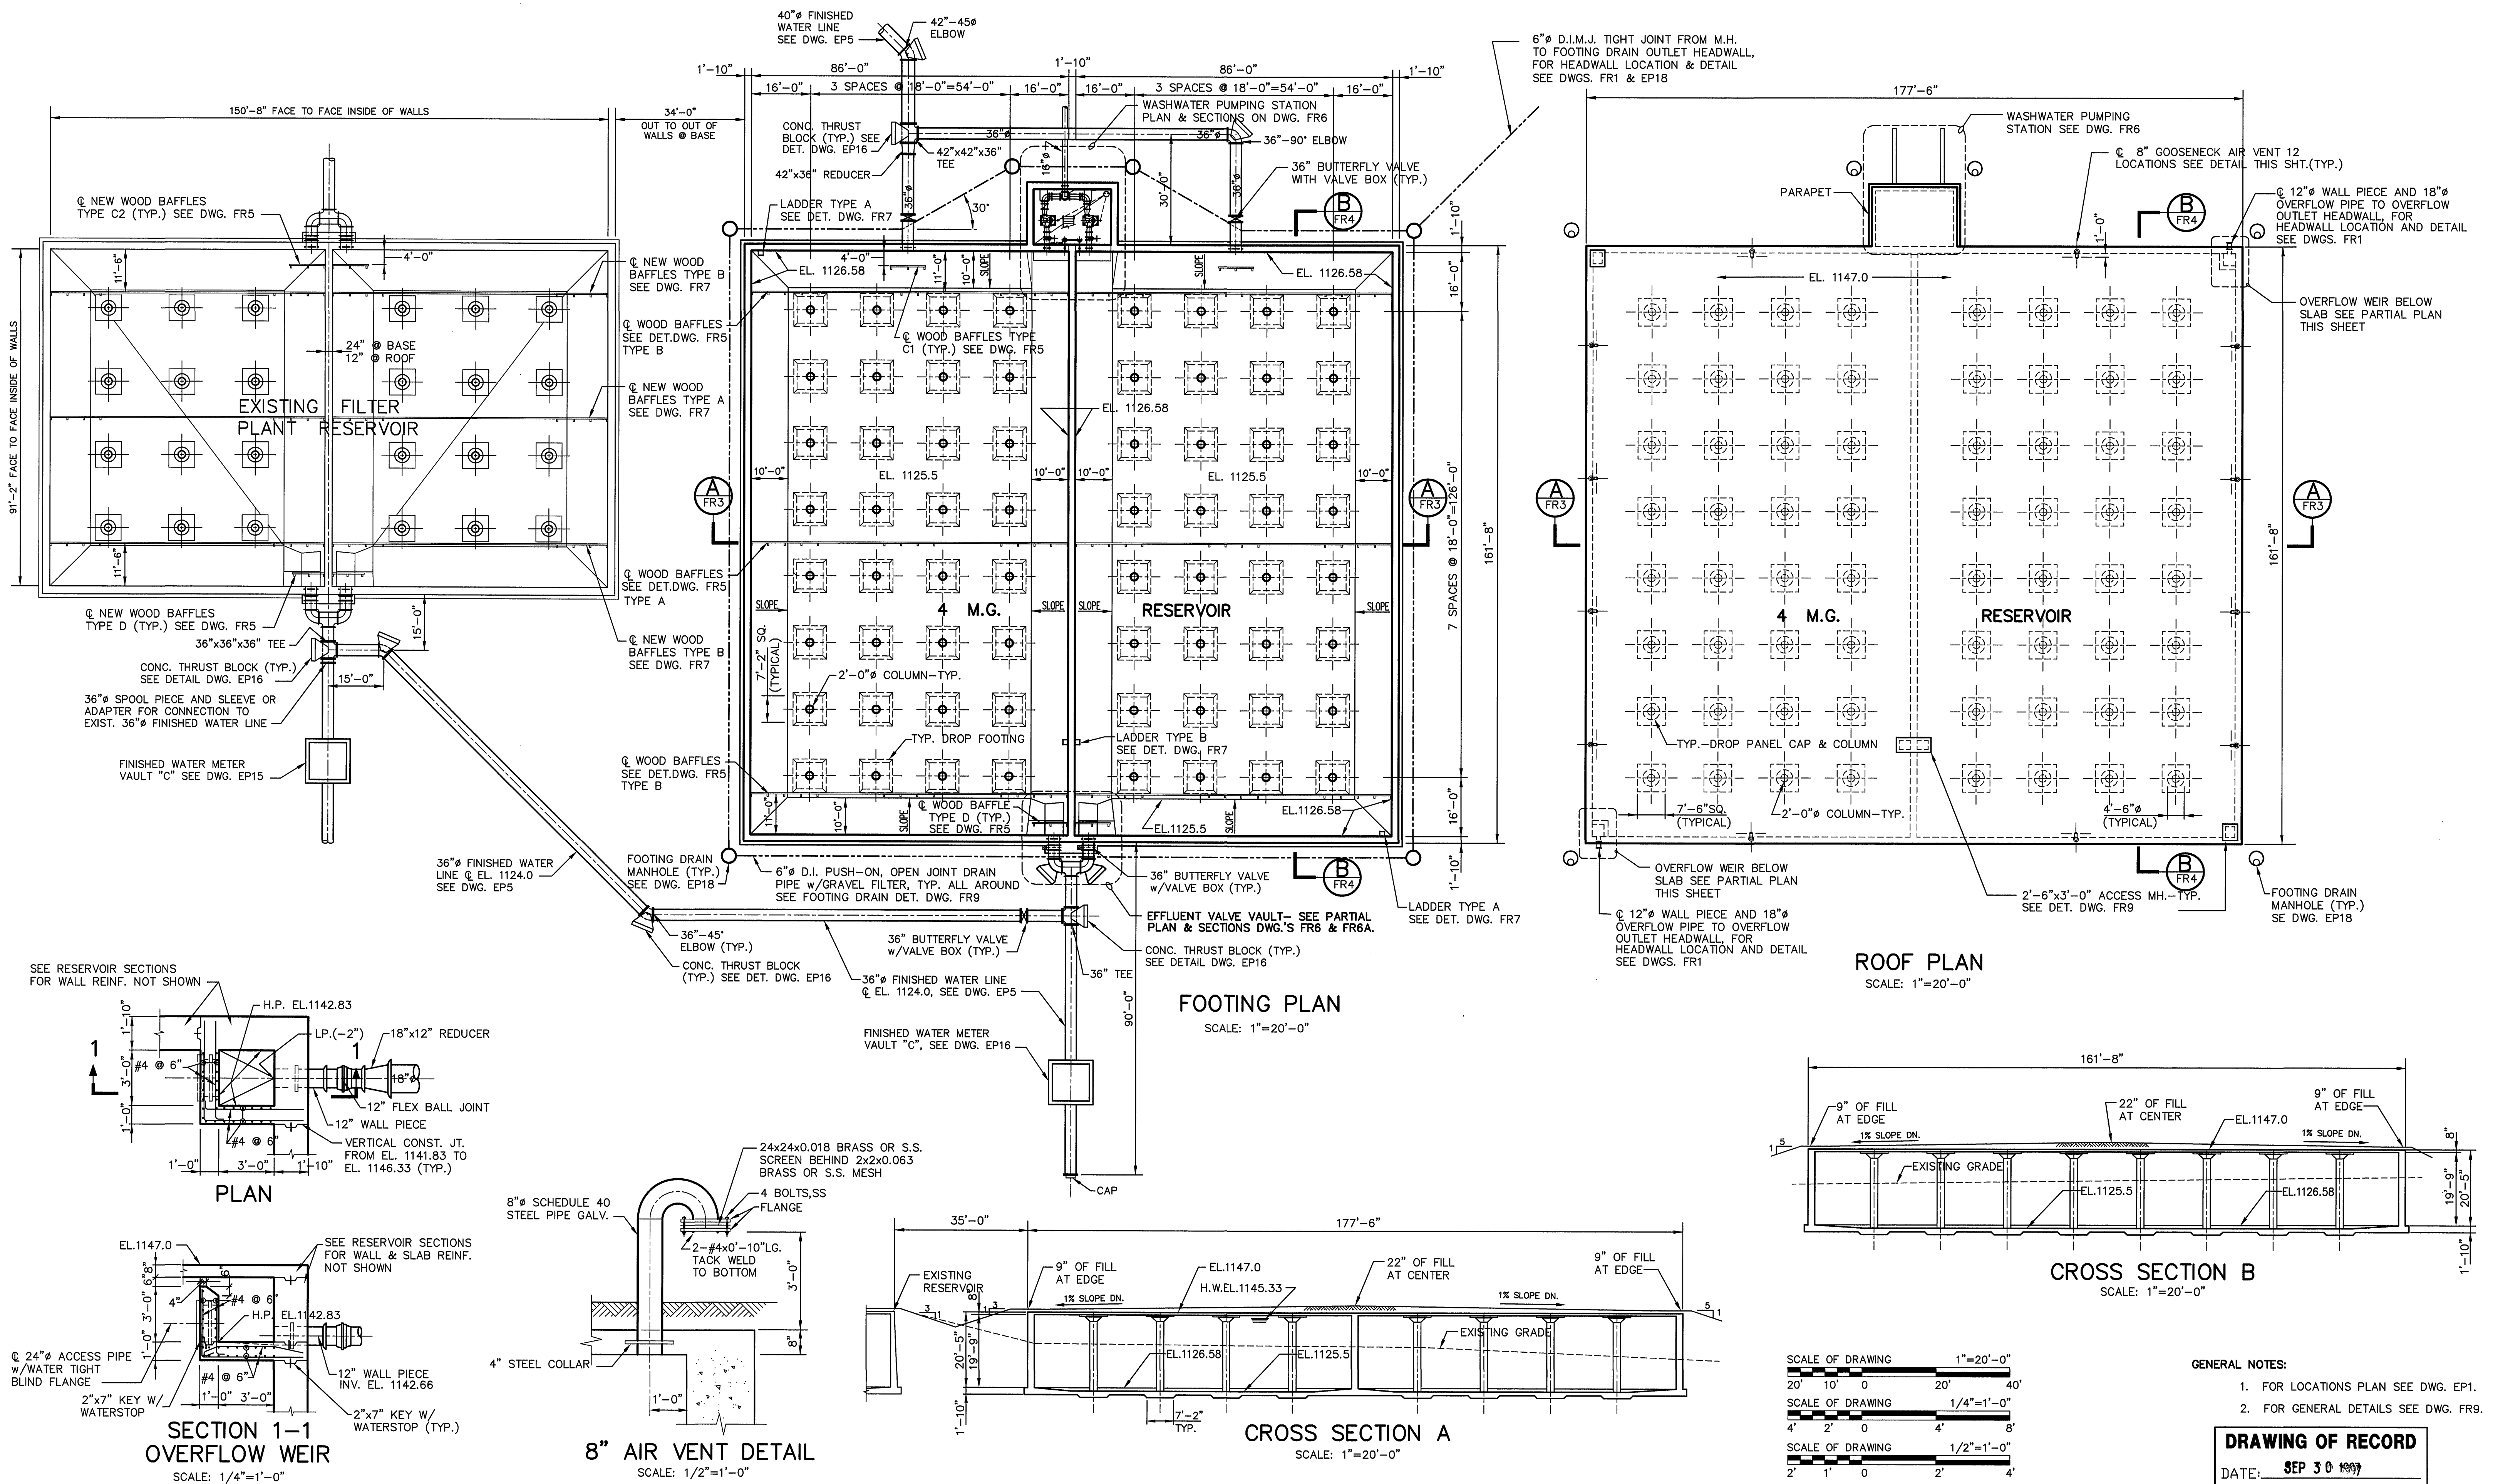


MATTERN & CRAIG
CONSULTING ENGINEERS • SURVEYORS
ROANOKE VIRGINIA

ALVORD, BURDICK & HOWSON
ENGINEERS CHICAGO

DESIGNED: S.C.P.

DRAWN: C.T.M.
R.E.T.

CHECKED: Y.T.L.

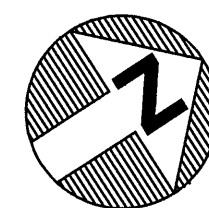

REV.	DATE	DESCRIPTION	BY	APP.

CARVINS COVE FILTER PLANT IMPROVEMENTS – PHASE I
ROANOKE, VIRGINIA

4 MG FINISHED WATER RESERVOIR
PLAN, SECTION, DETAILS

DATE
APRIL 1992
COMM. NO.
9130
SHEET
FR2