
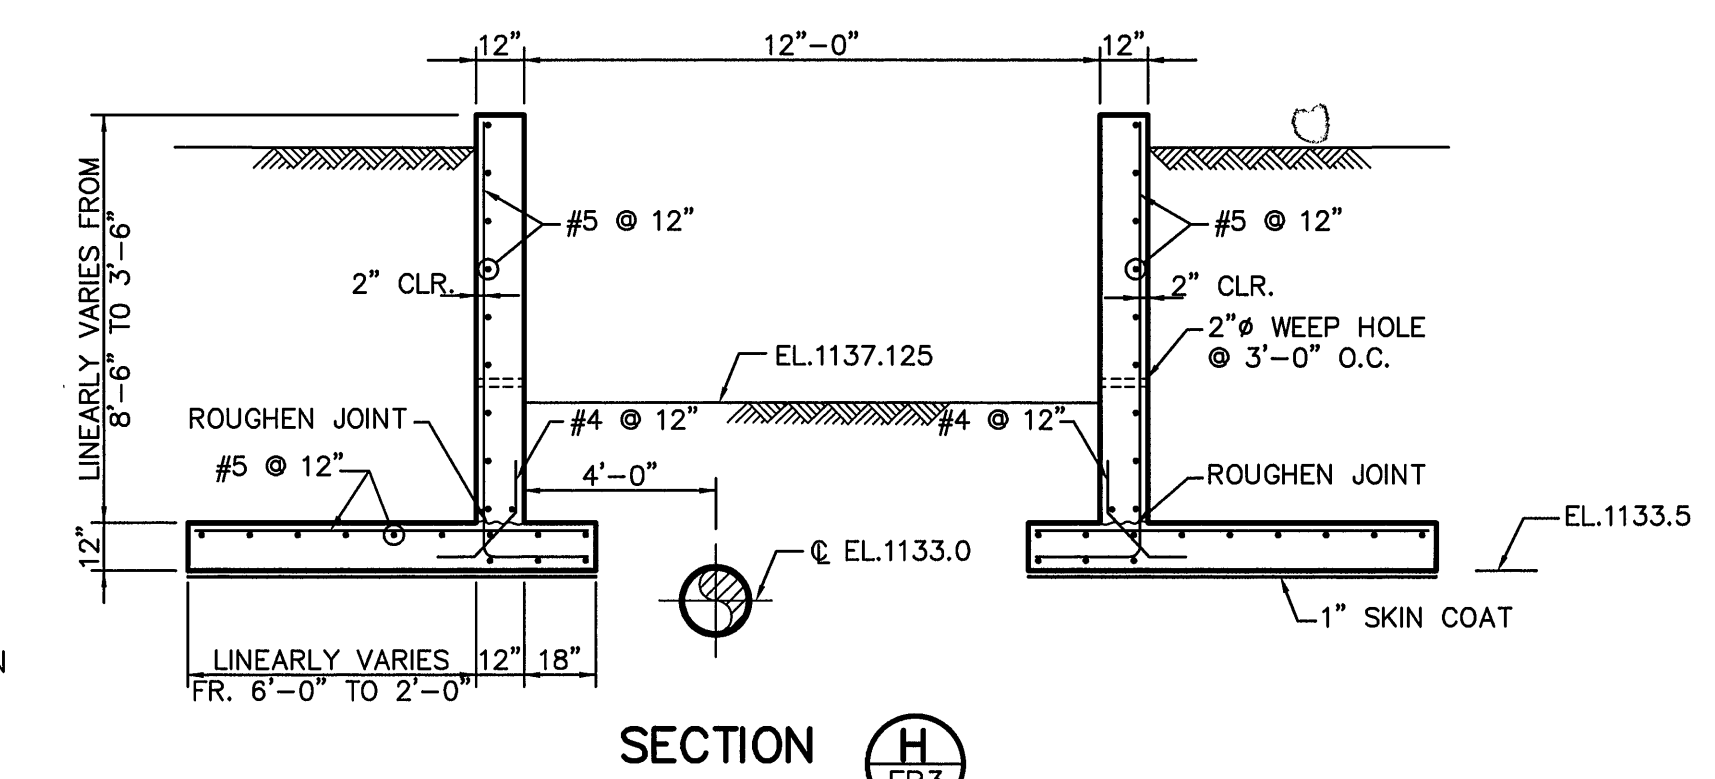
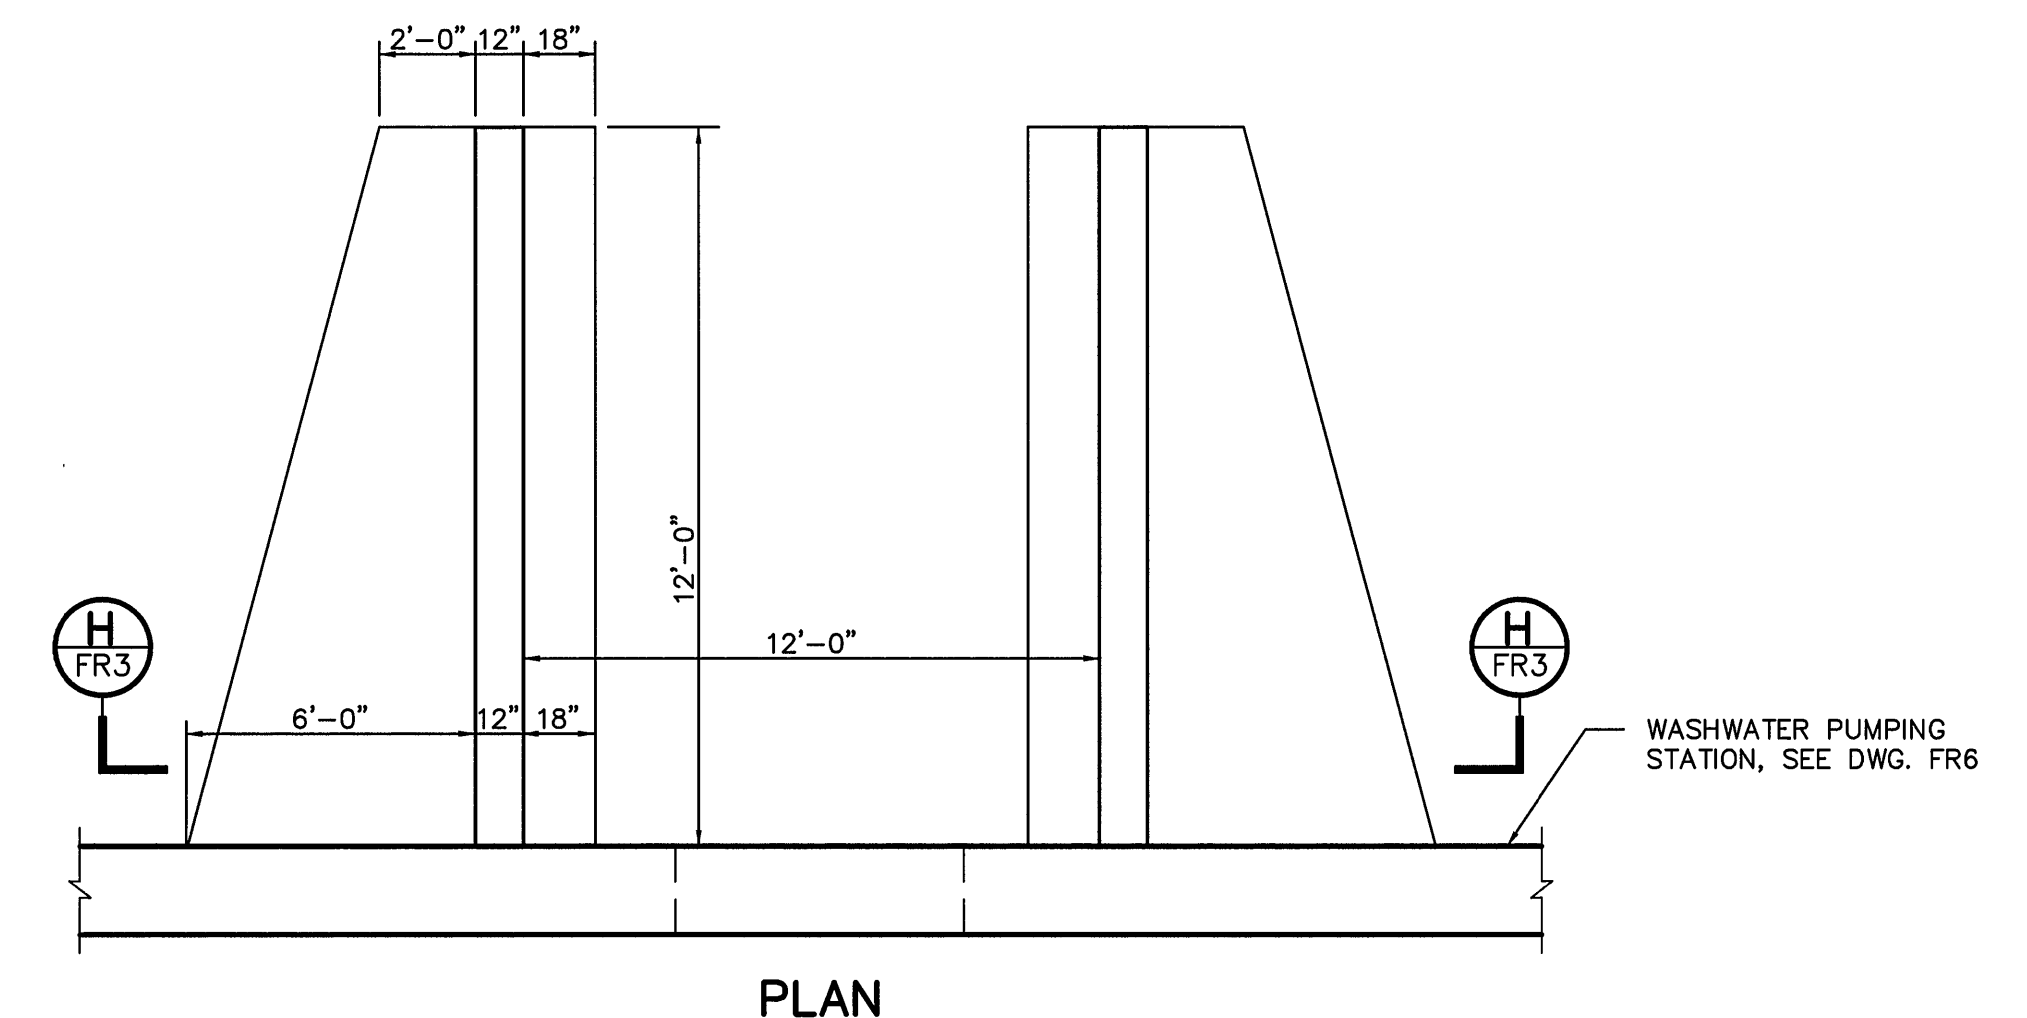
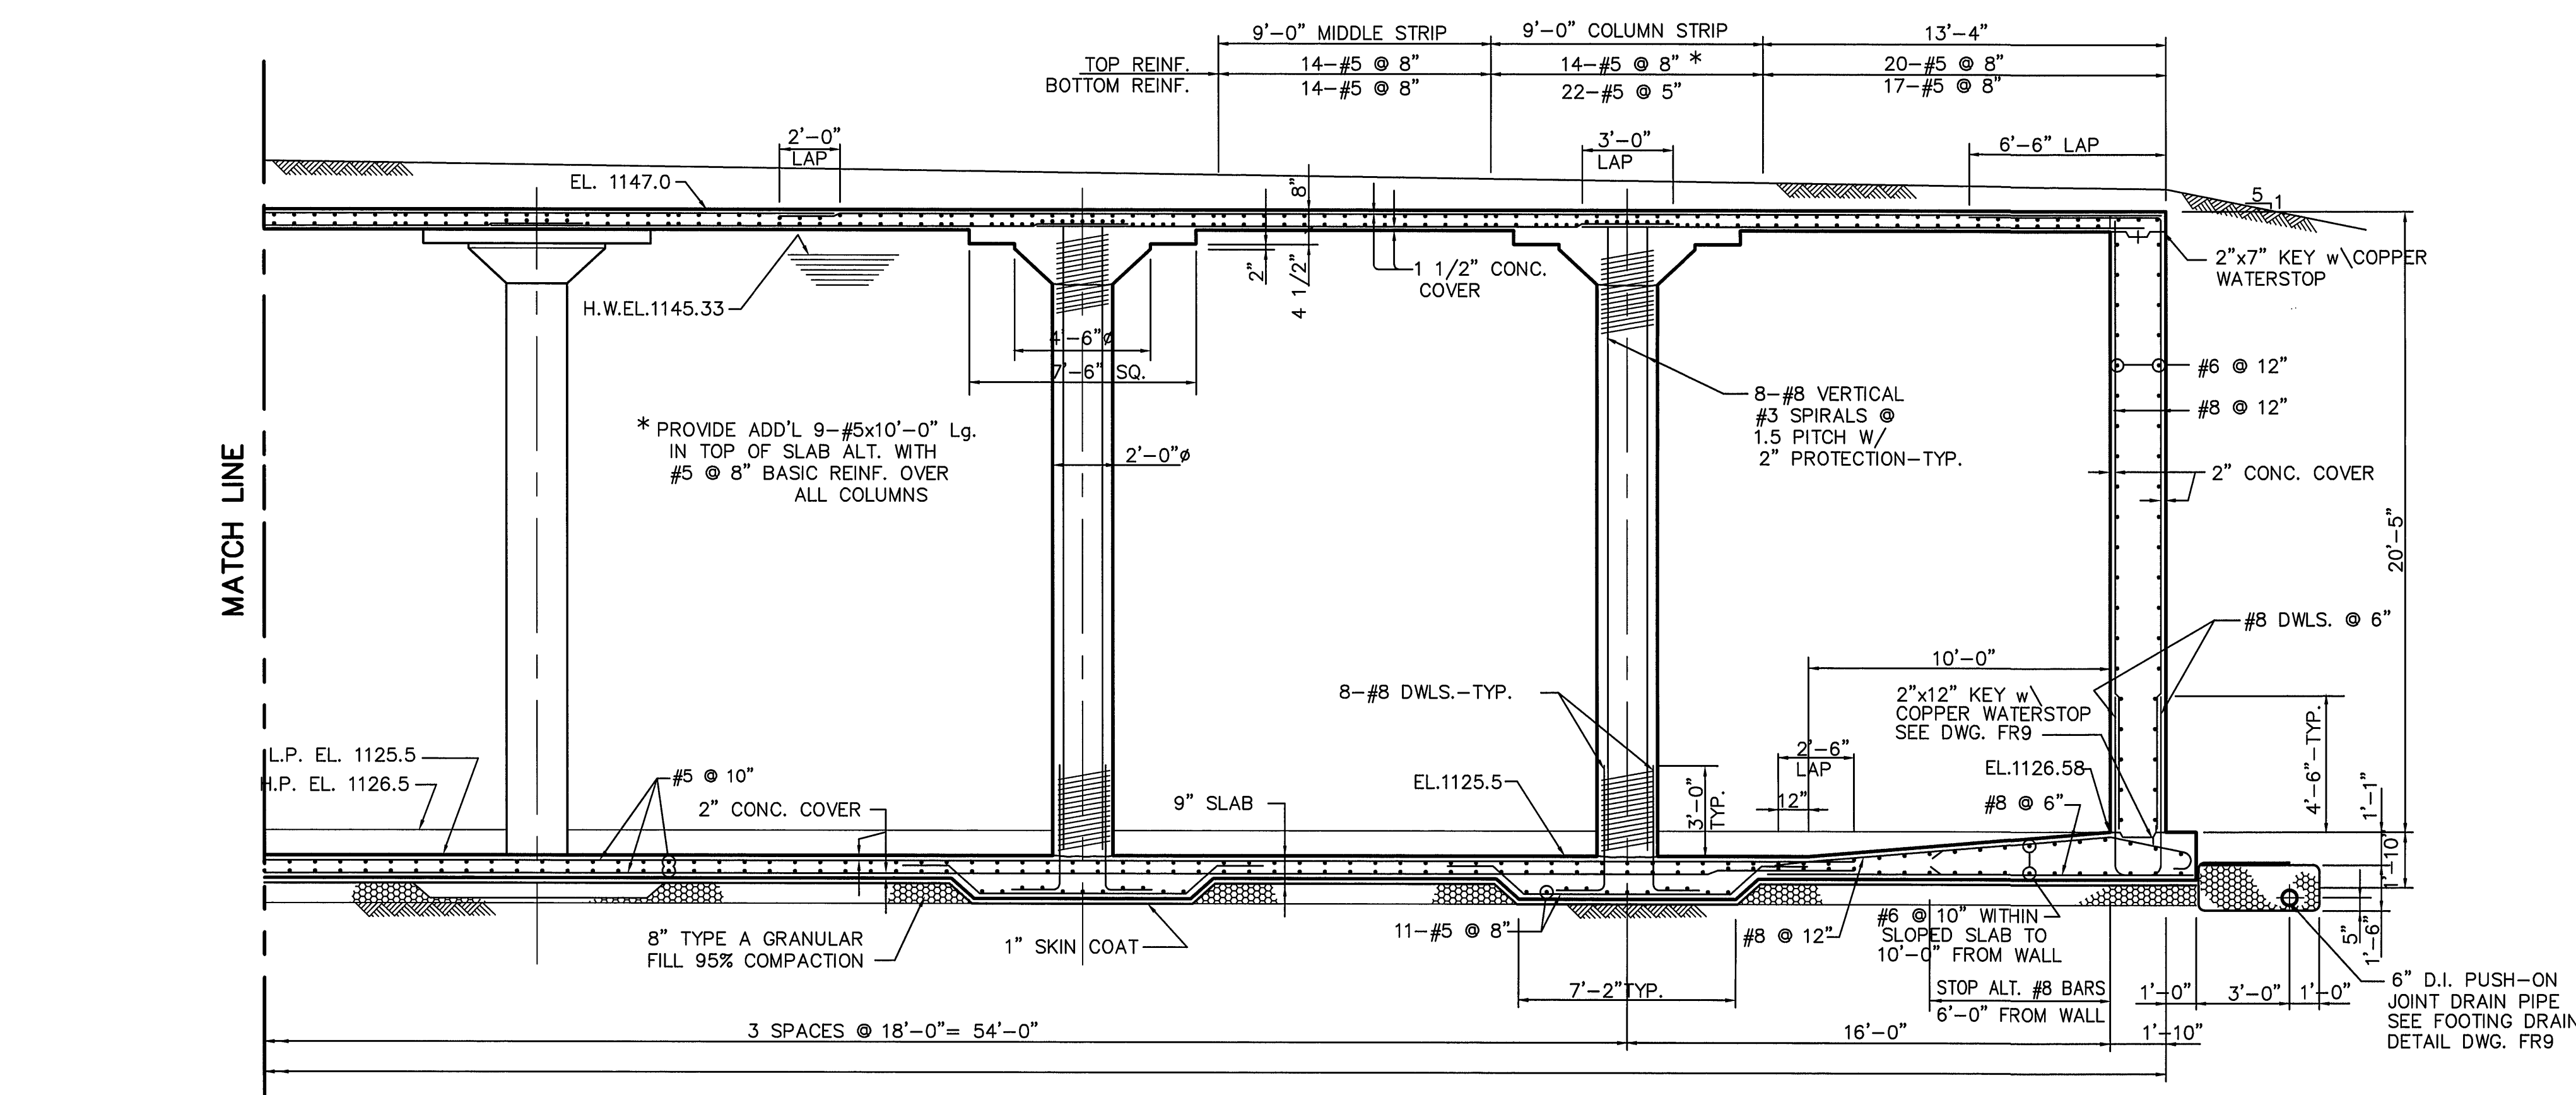


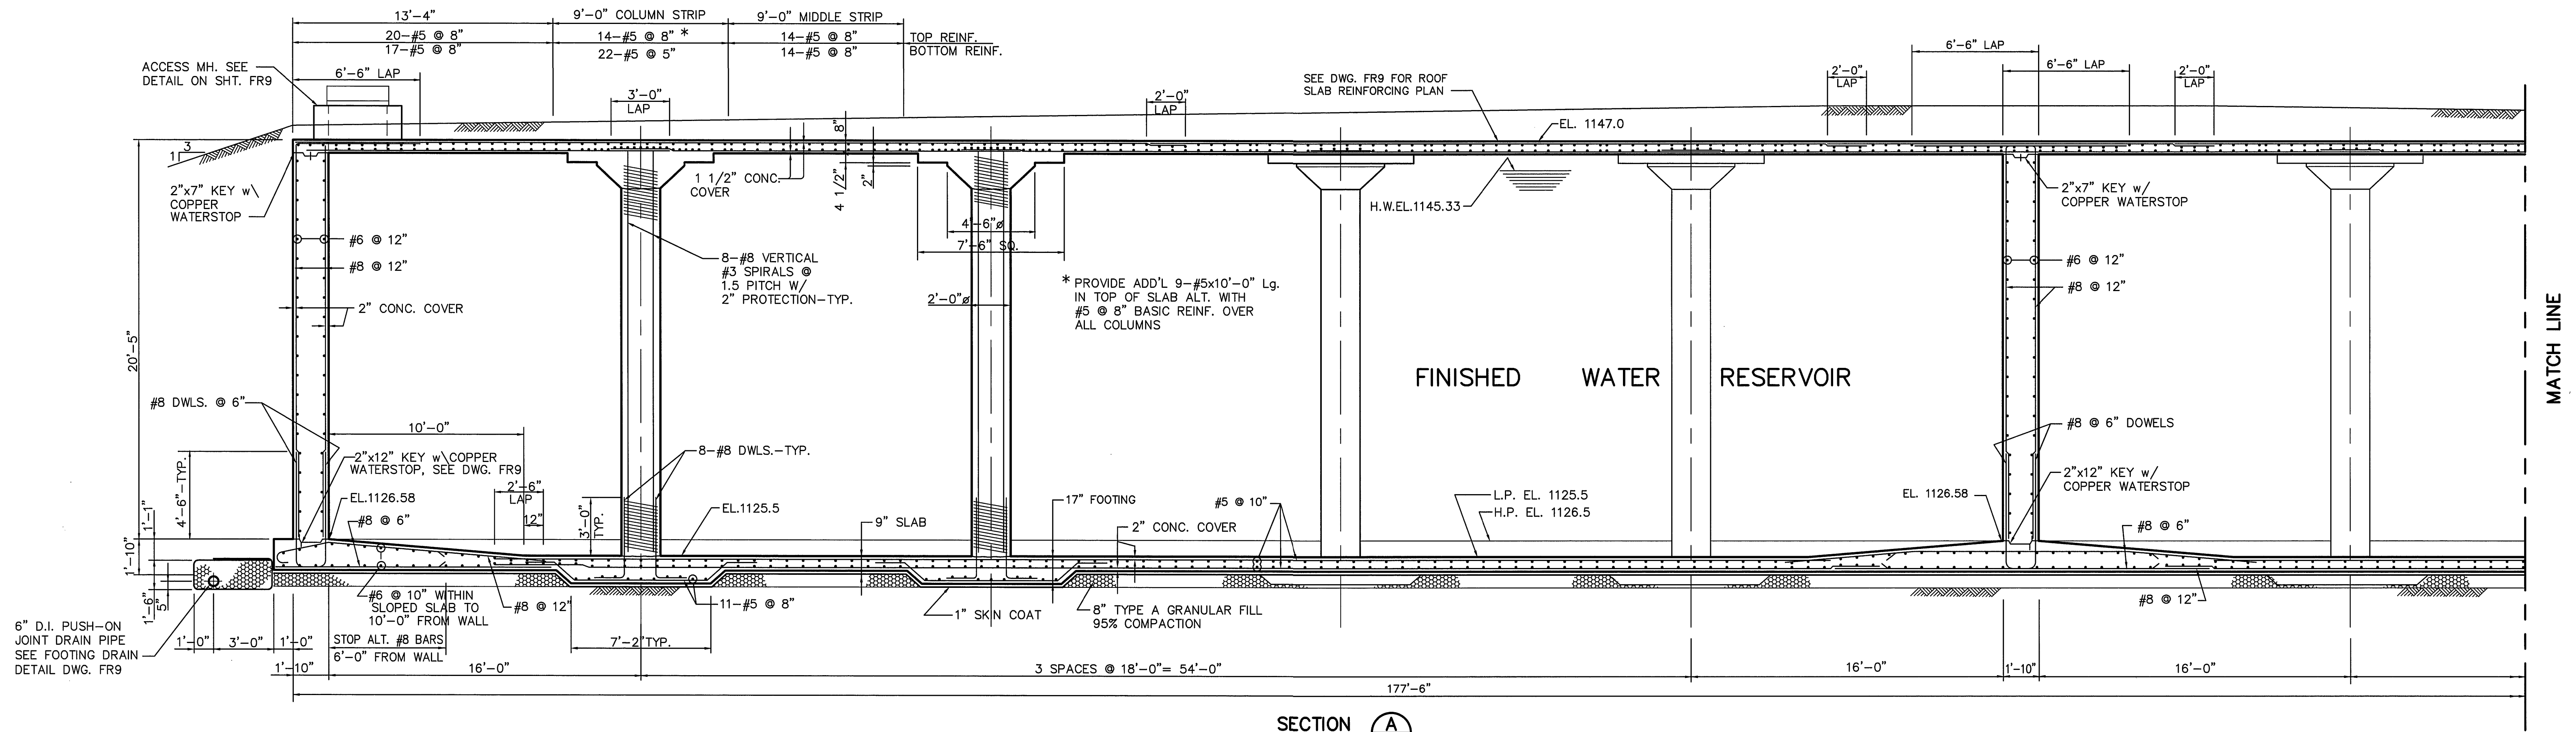

GENERAL NOTES:
1. FOR GENERAL DETAILS
SEE DWG. FR9.

PUMP STATION RETAINING WALL DETAIL
FOR LOCATION SEE DWG. FR6

SCALE OF DRAWING
1/4"=1'-0"

MATTERN & CRAIG CONSULTING ENGINEERS • SURVEYORS ROANOKE VIRGINIA	DESIGNED: S.C.P.			REV.	DATE	DESCRIPTION	BY	APP.	CARVINS COVE FILTER PLANT IMPROVEMENTS – PHASE I	ROANOKE, VIRGINIA	DATE	
	DRAWN: C.T.M.											APRIL 1992
	CHECKED: Y.T.L.											COMM. NO.
ALVORD, BURDICK & HOWSON											9130	
ENGINEERS CHICAGO									4 MG FINISHED WATER RESERVOIR		SHEET	
									SECTIONS & DETAILS		FR3	