
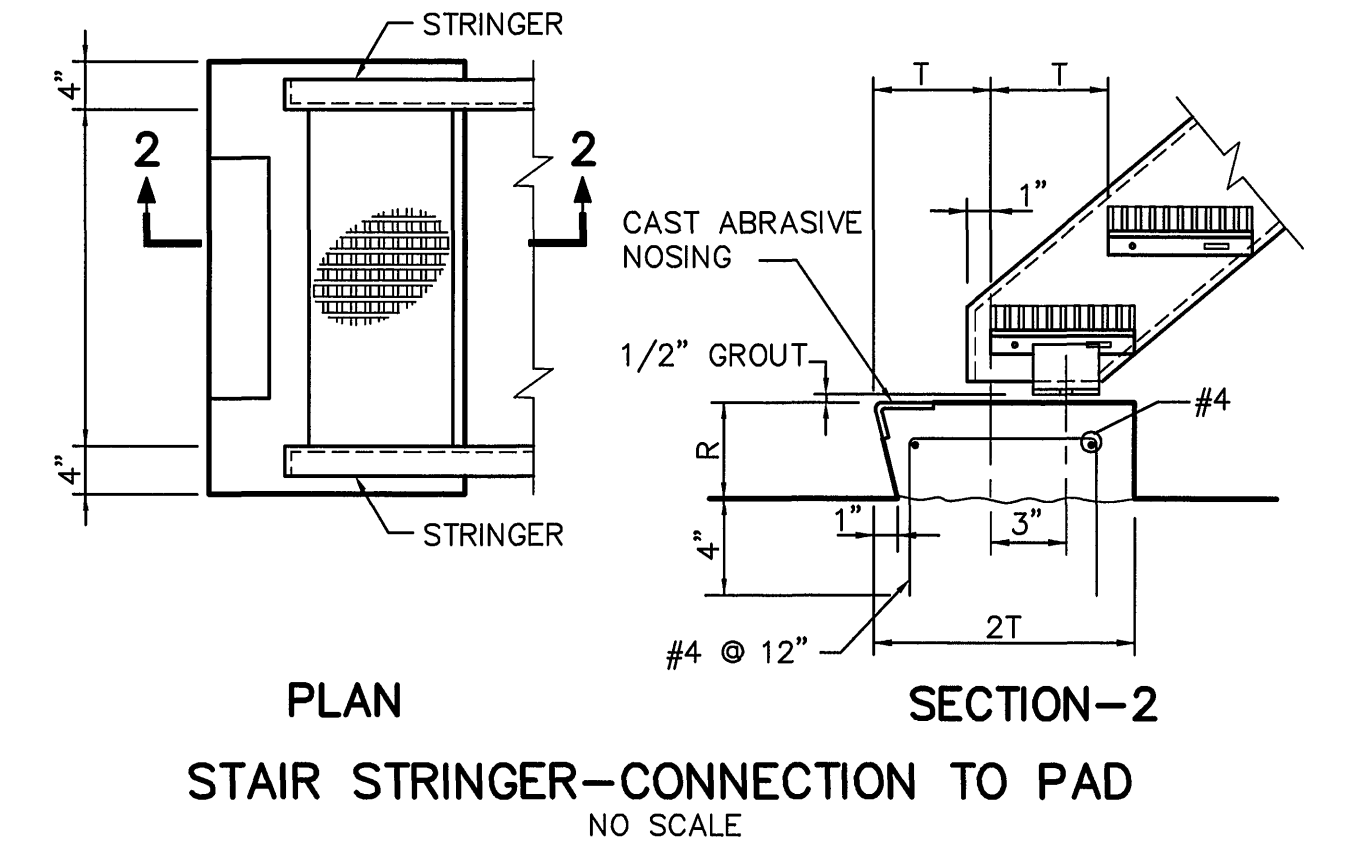
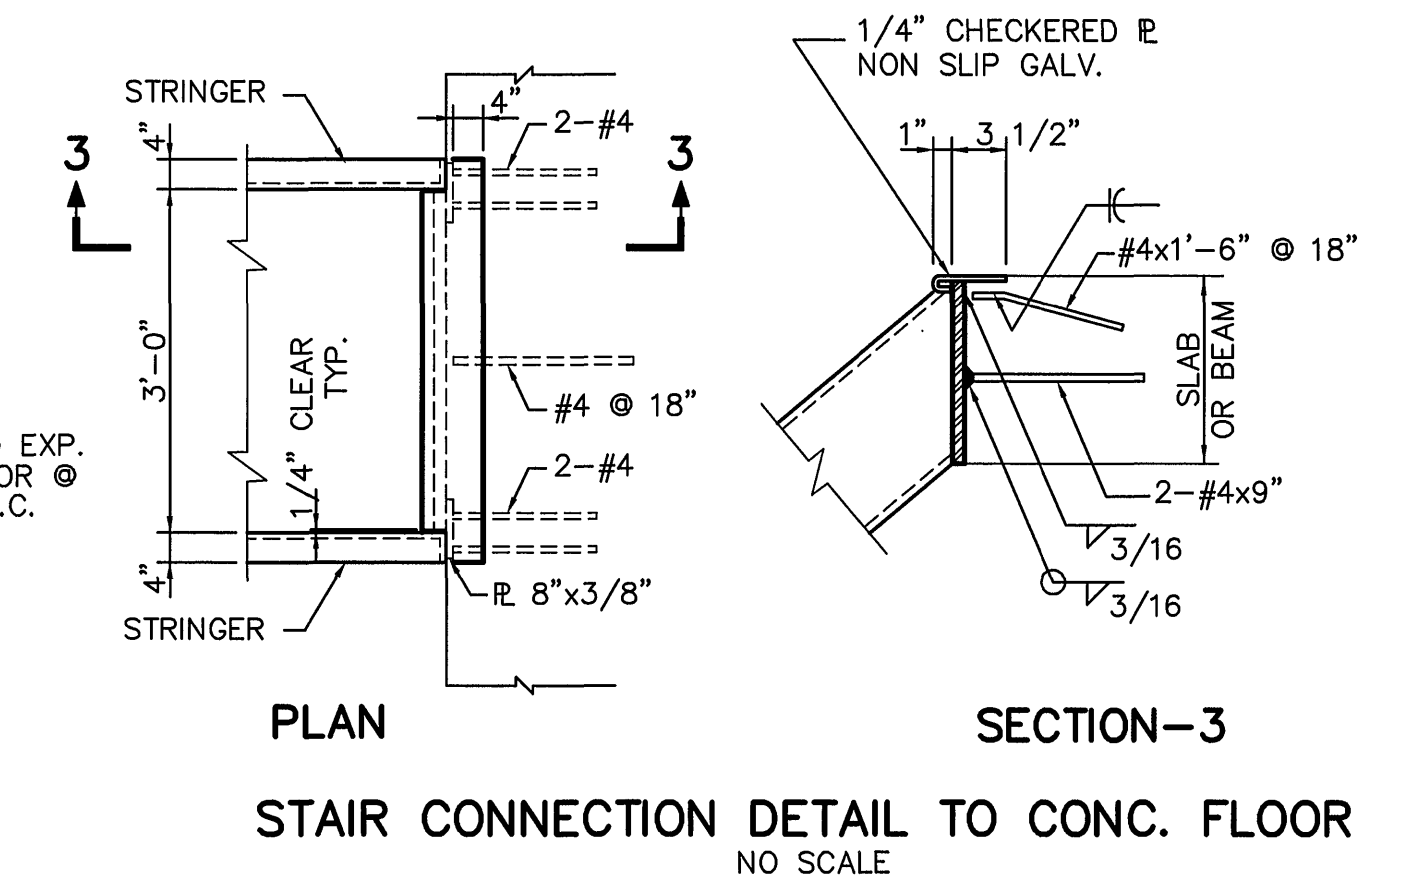
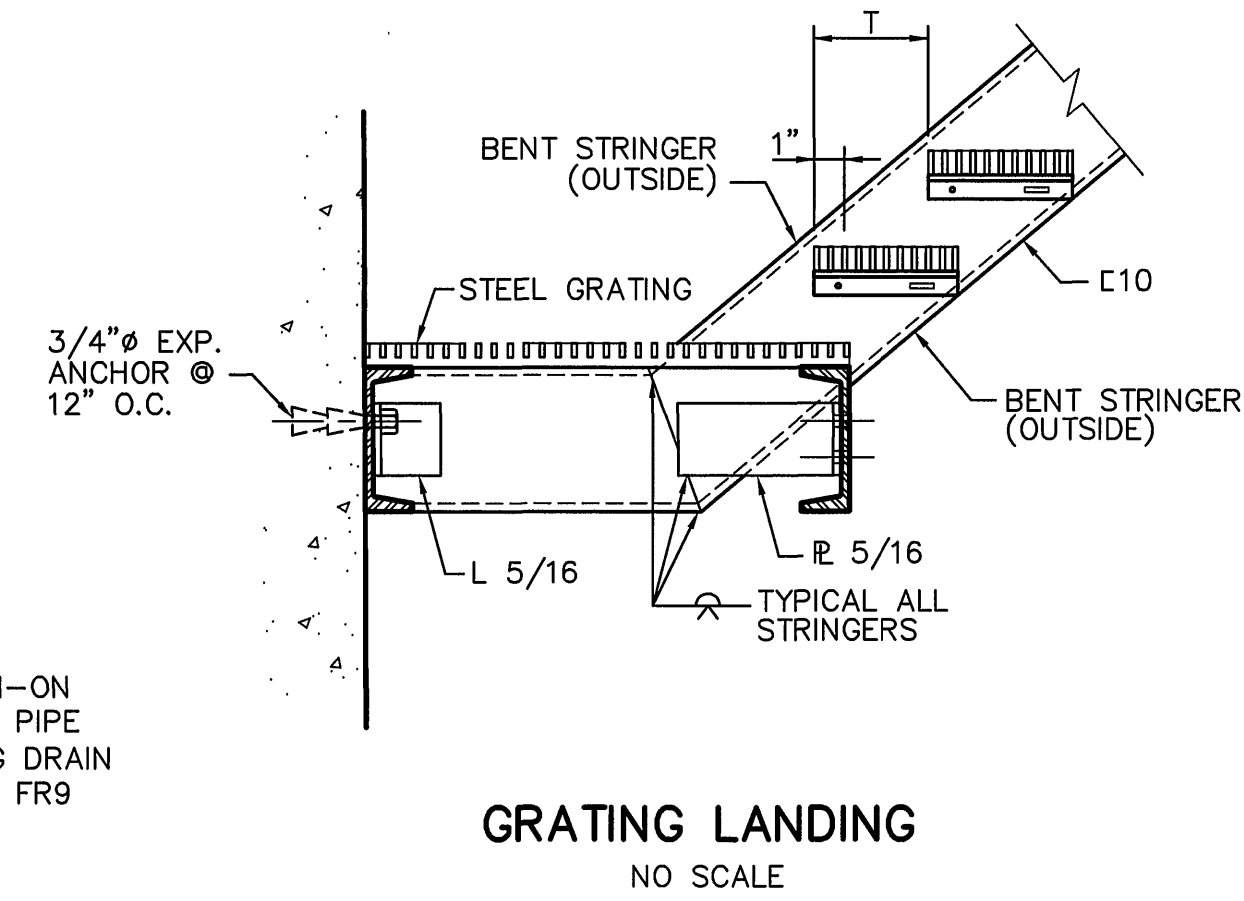
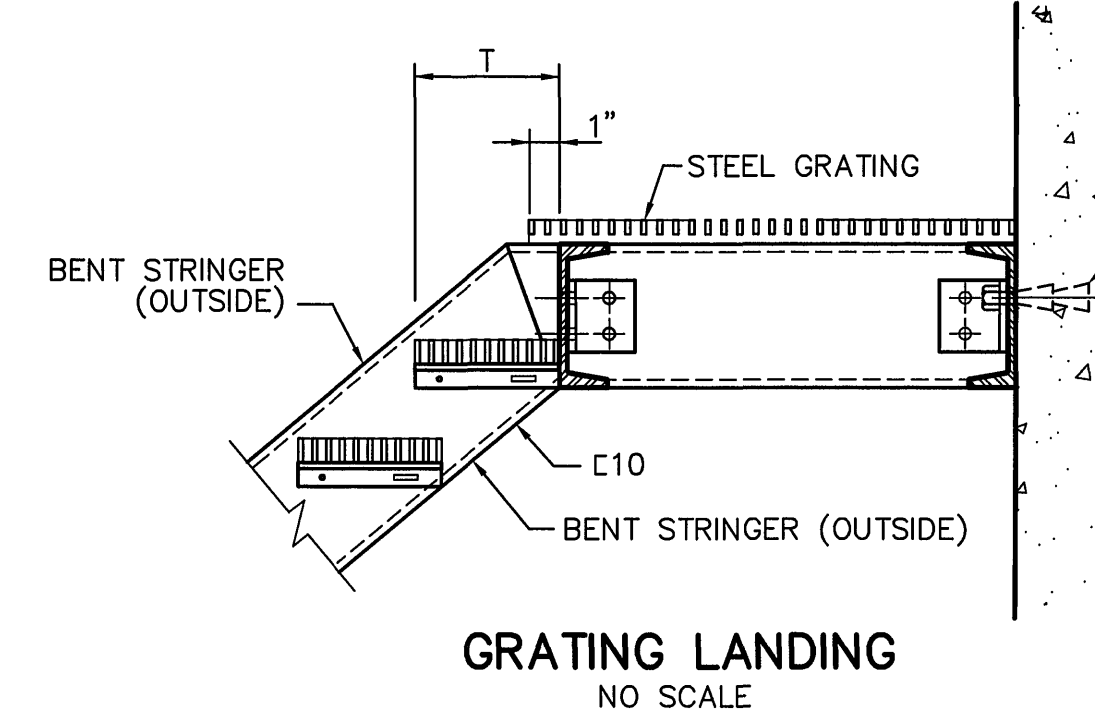
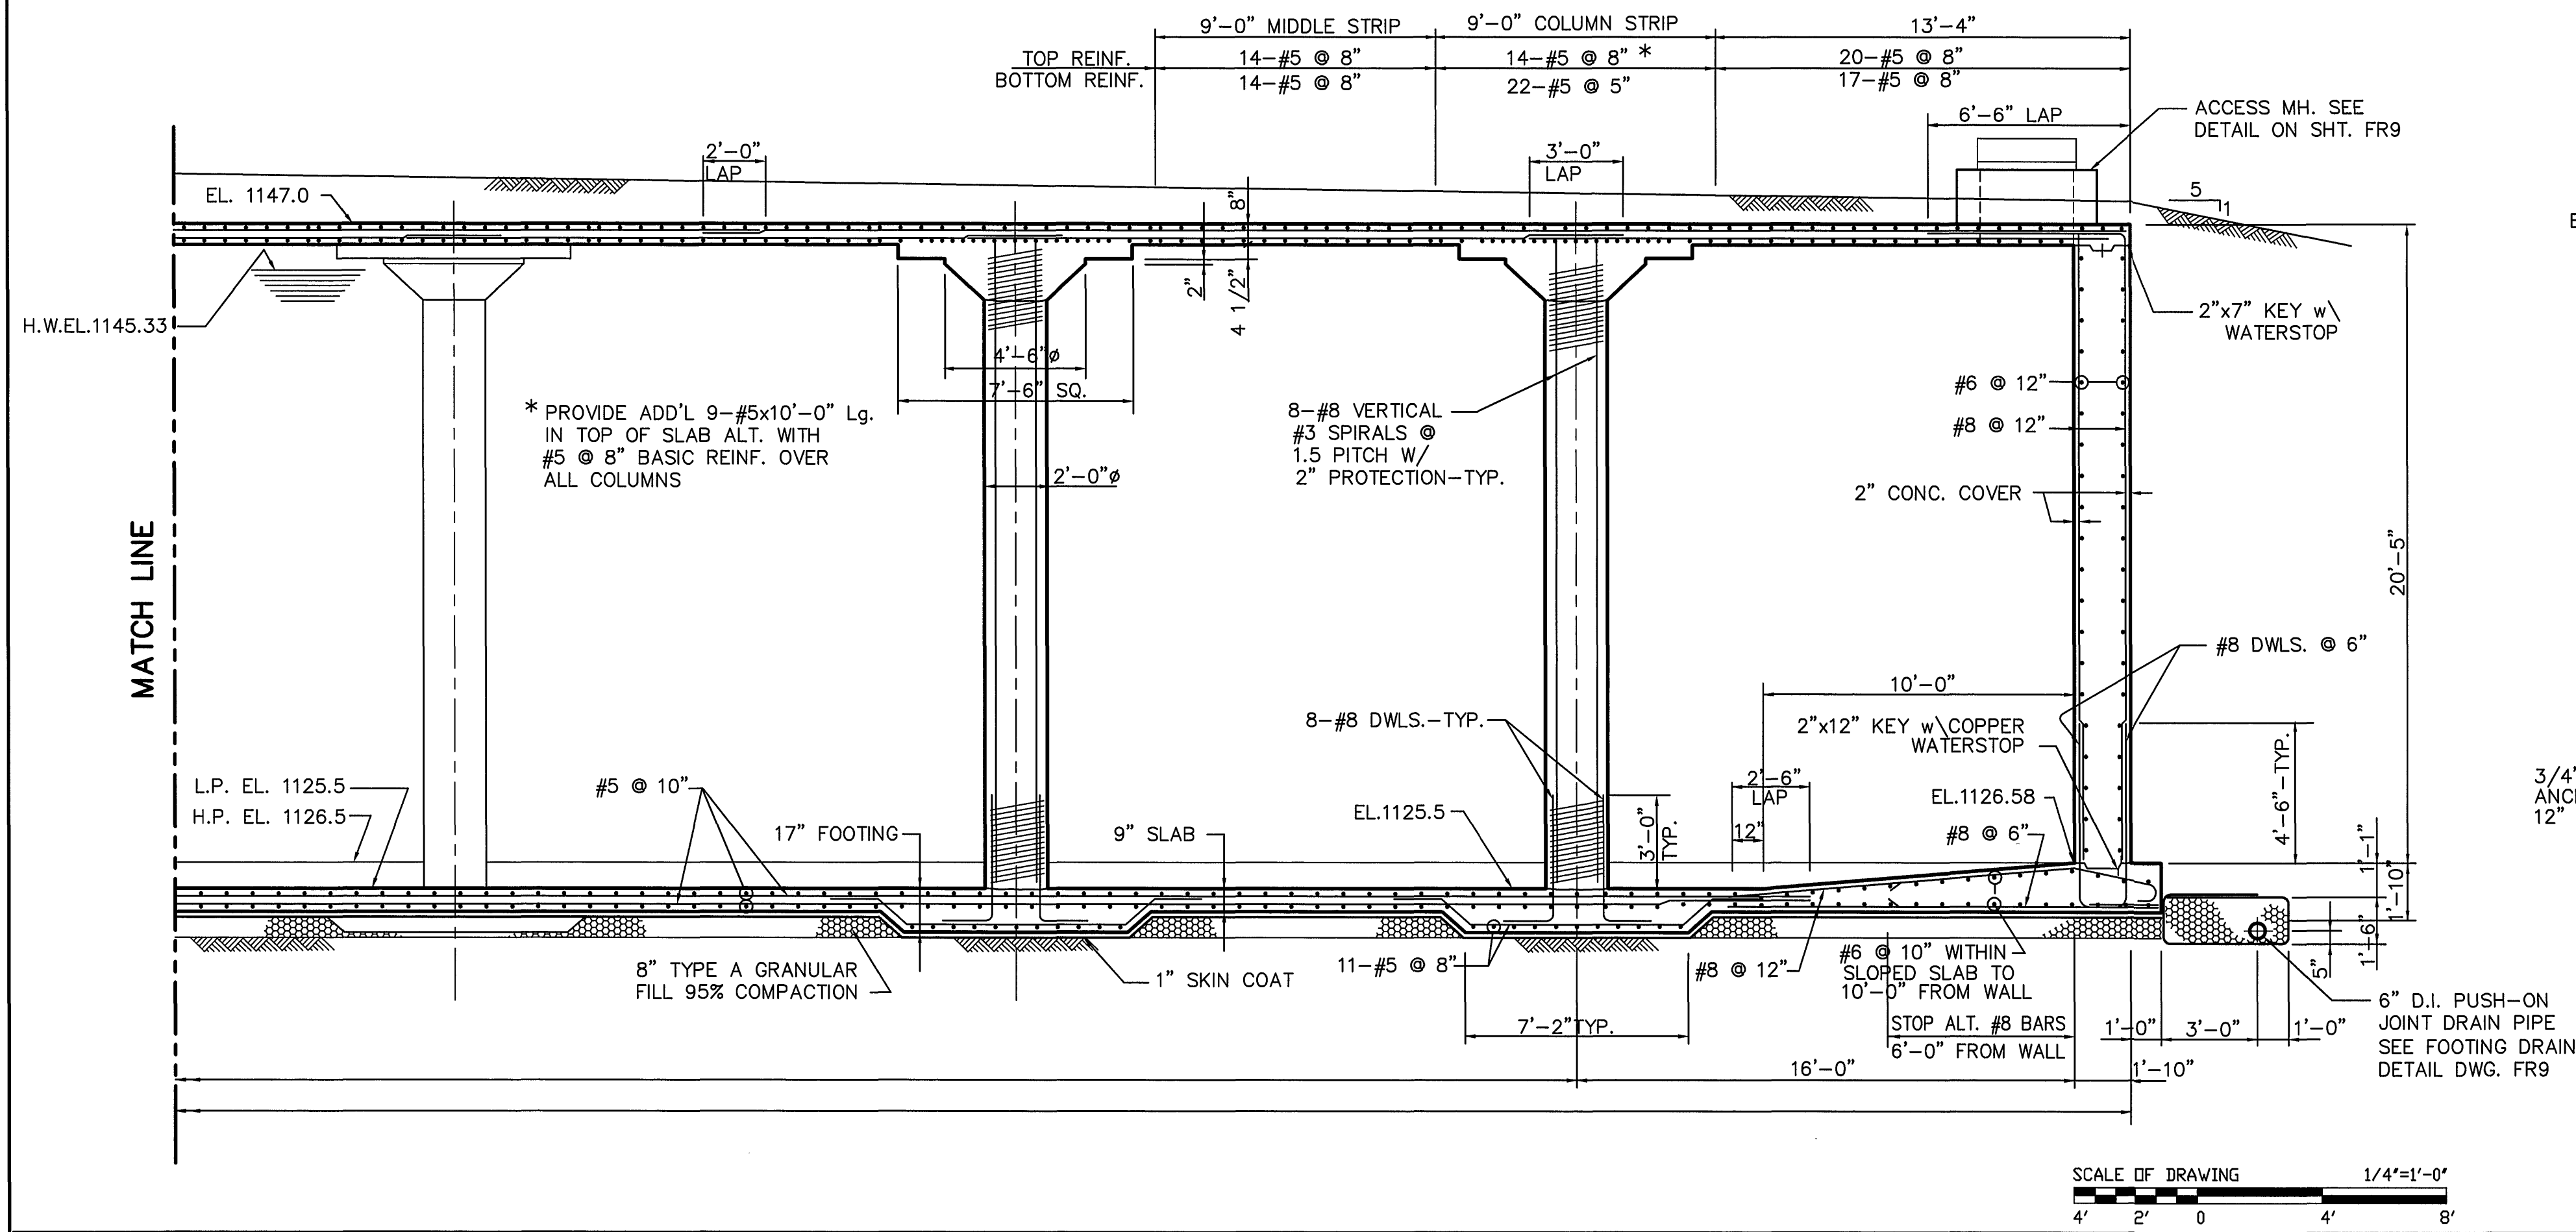


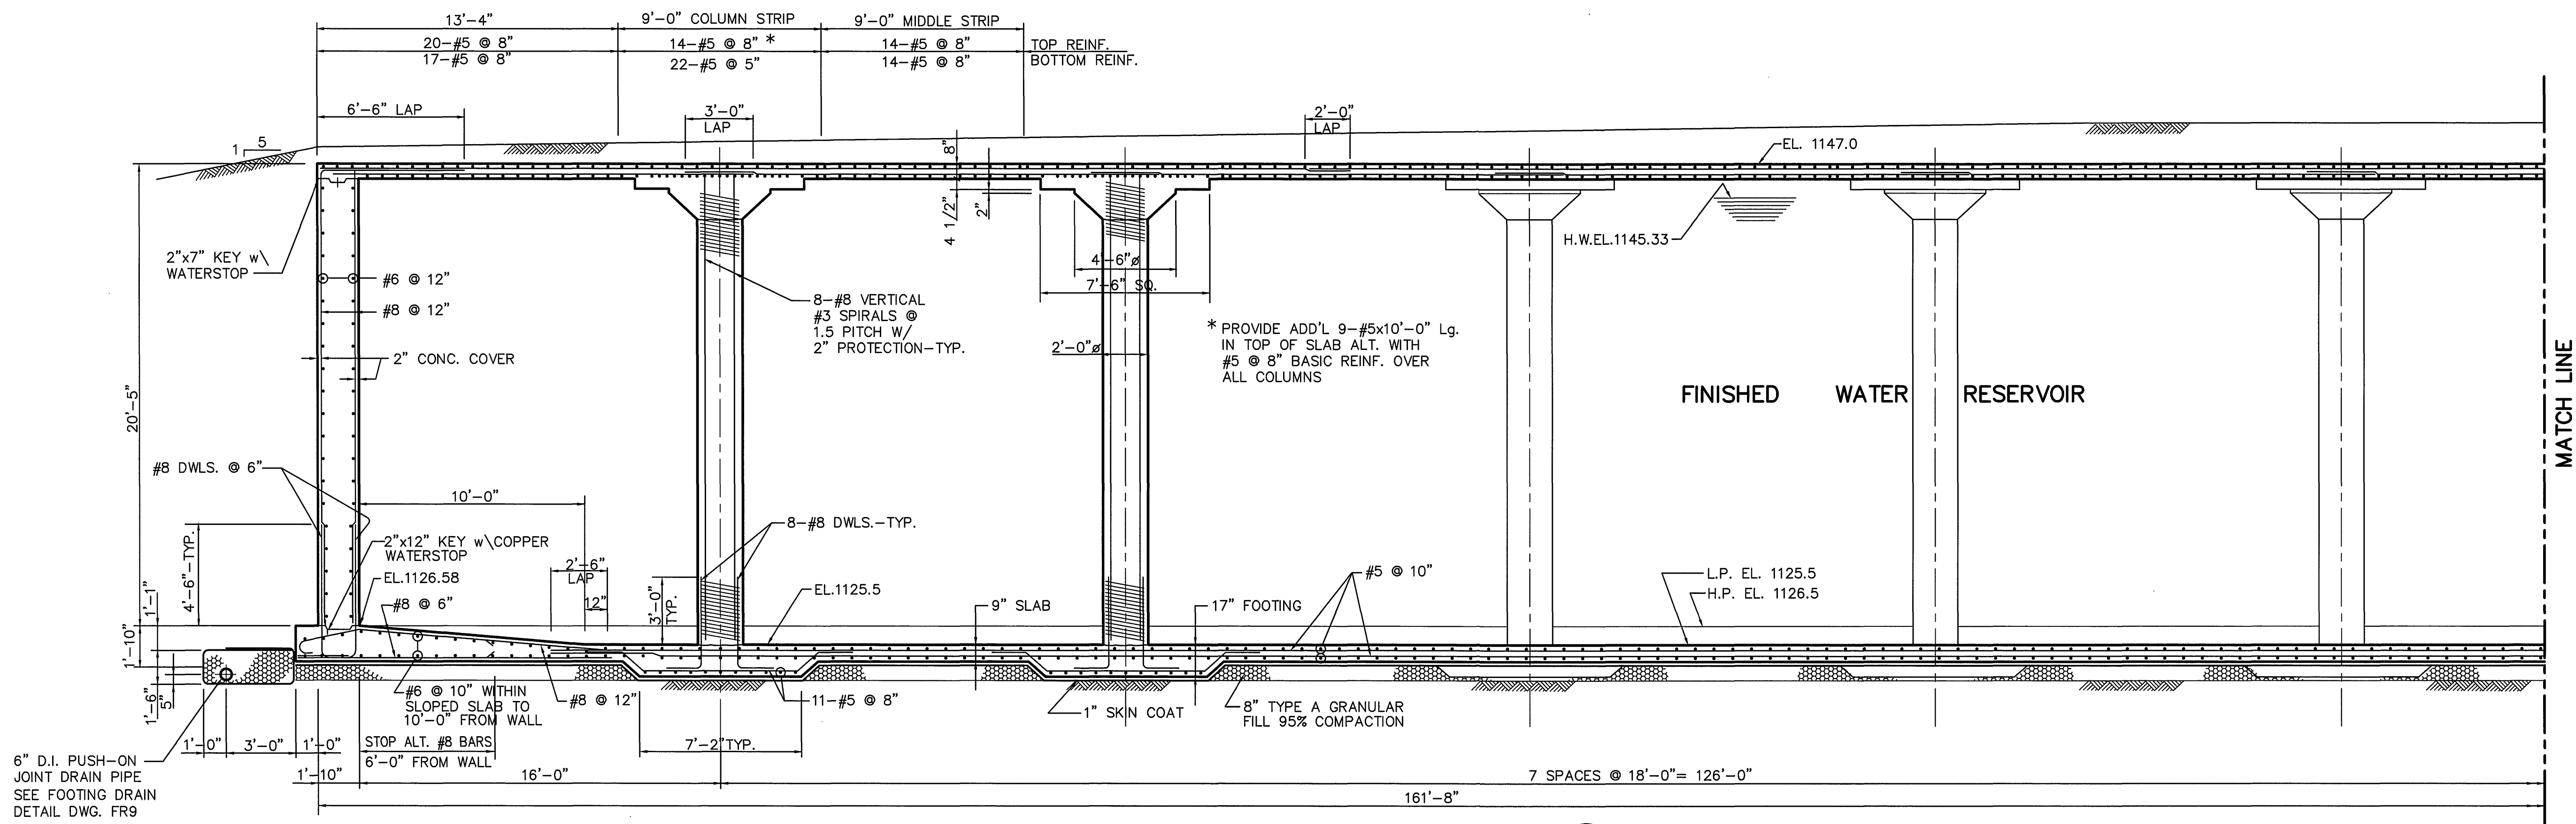

DRAWING OF RECORD
DATE: SEP 30 1997

GENERAL NOTES:
1. FOR GENERAL DETAILS SEE DWG. FR9.

MATTERN & CRAIG CONSULTING ENGINEERS • SURVEYORS ROANOKE VIRGINIA	DESIGNED: S.C.P.		REV.	DATE	DESCRIPTION	BY	APP.	CARVINS COVE FILTER PLANT IMPROVEMENTS – PHASE I ROANOKE, VIRGINIA	DATE APRIL 1992
	DRAWN: C.T.M.								
	ALVORD, BURDICK & HOWSON ENGINEERS CHICAGO		CHECKED: Y.T.L.						