
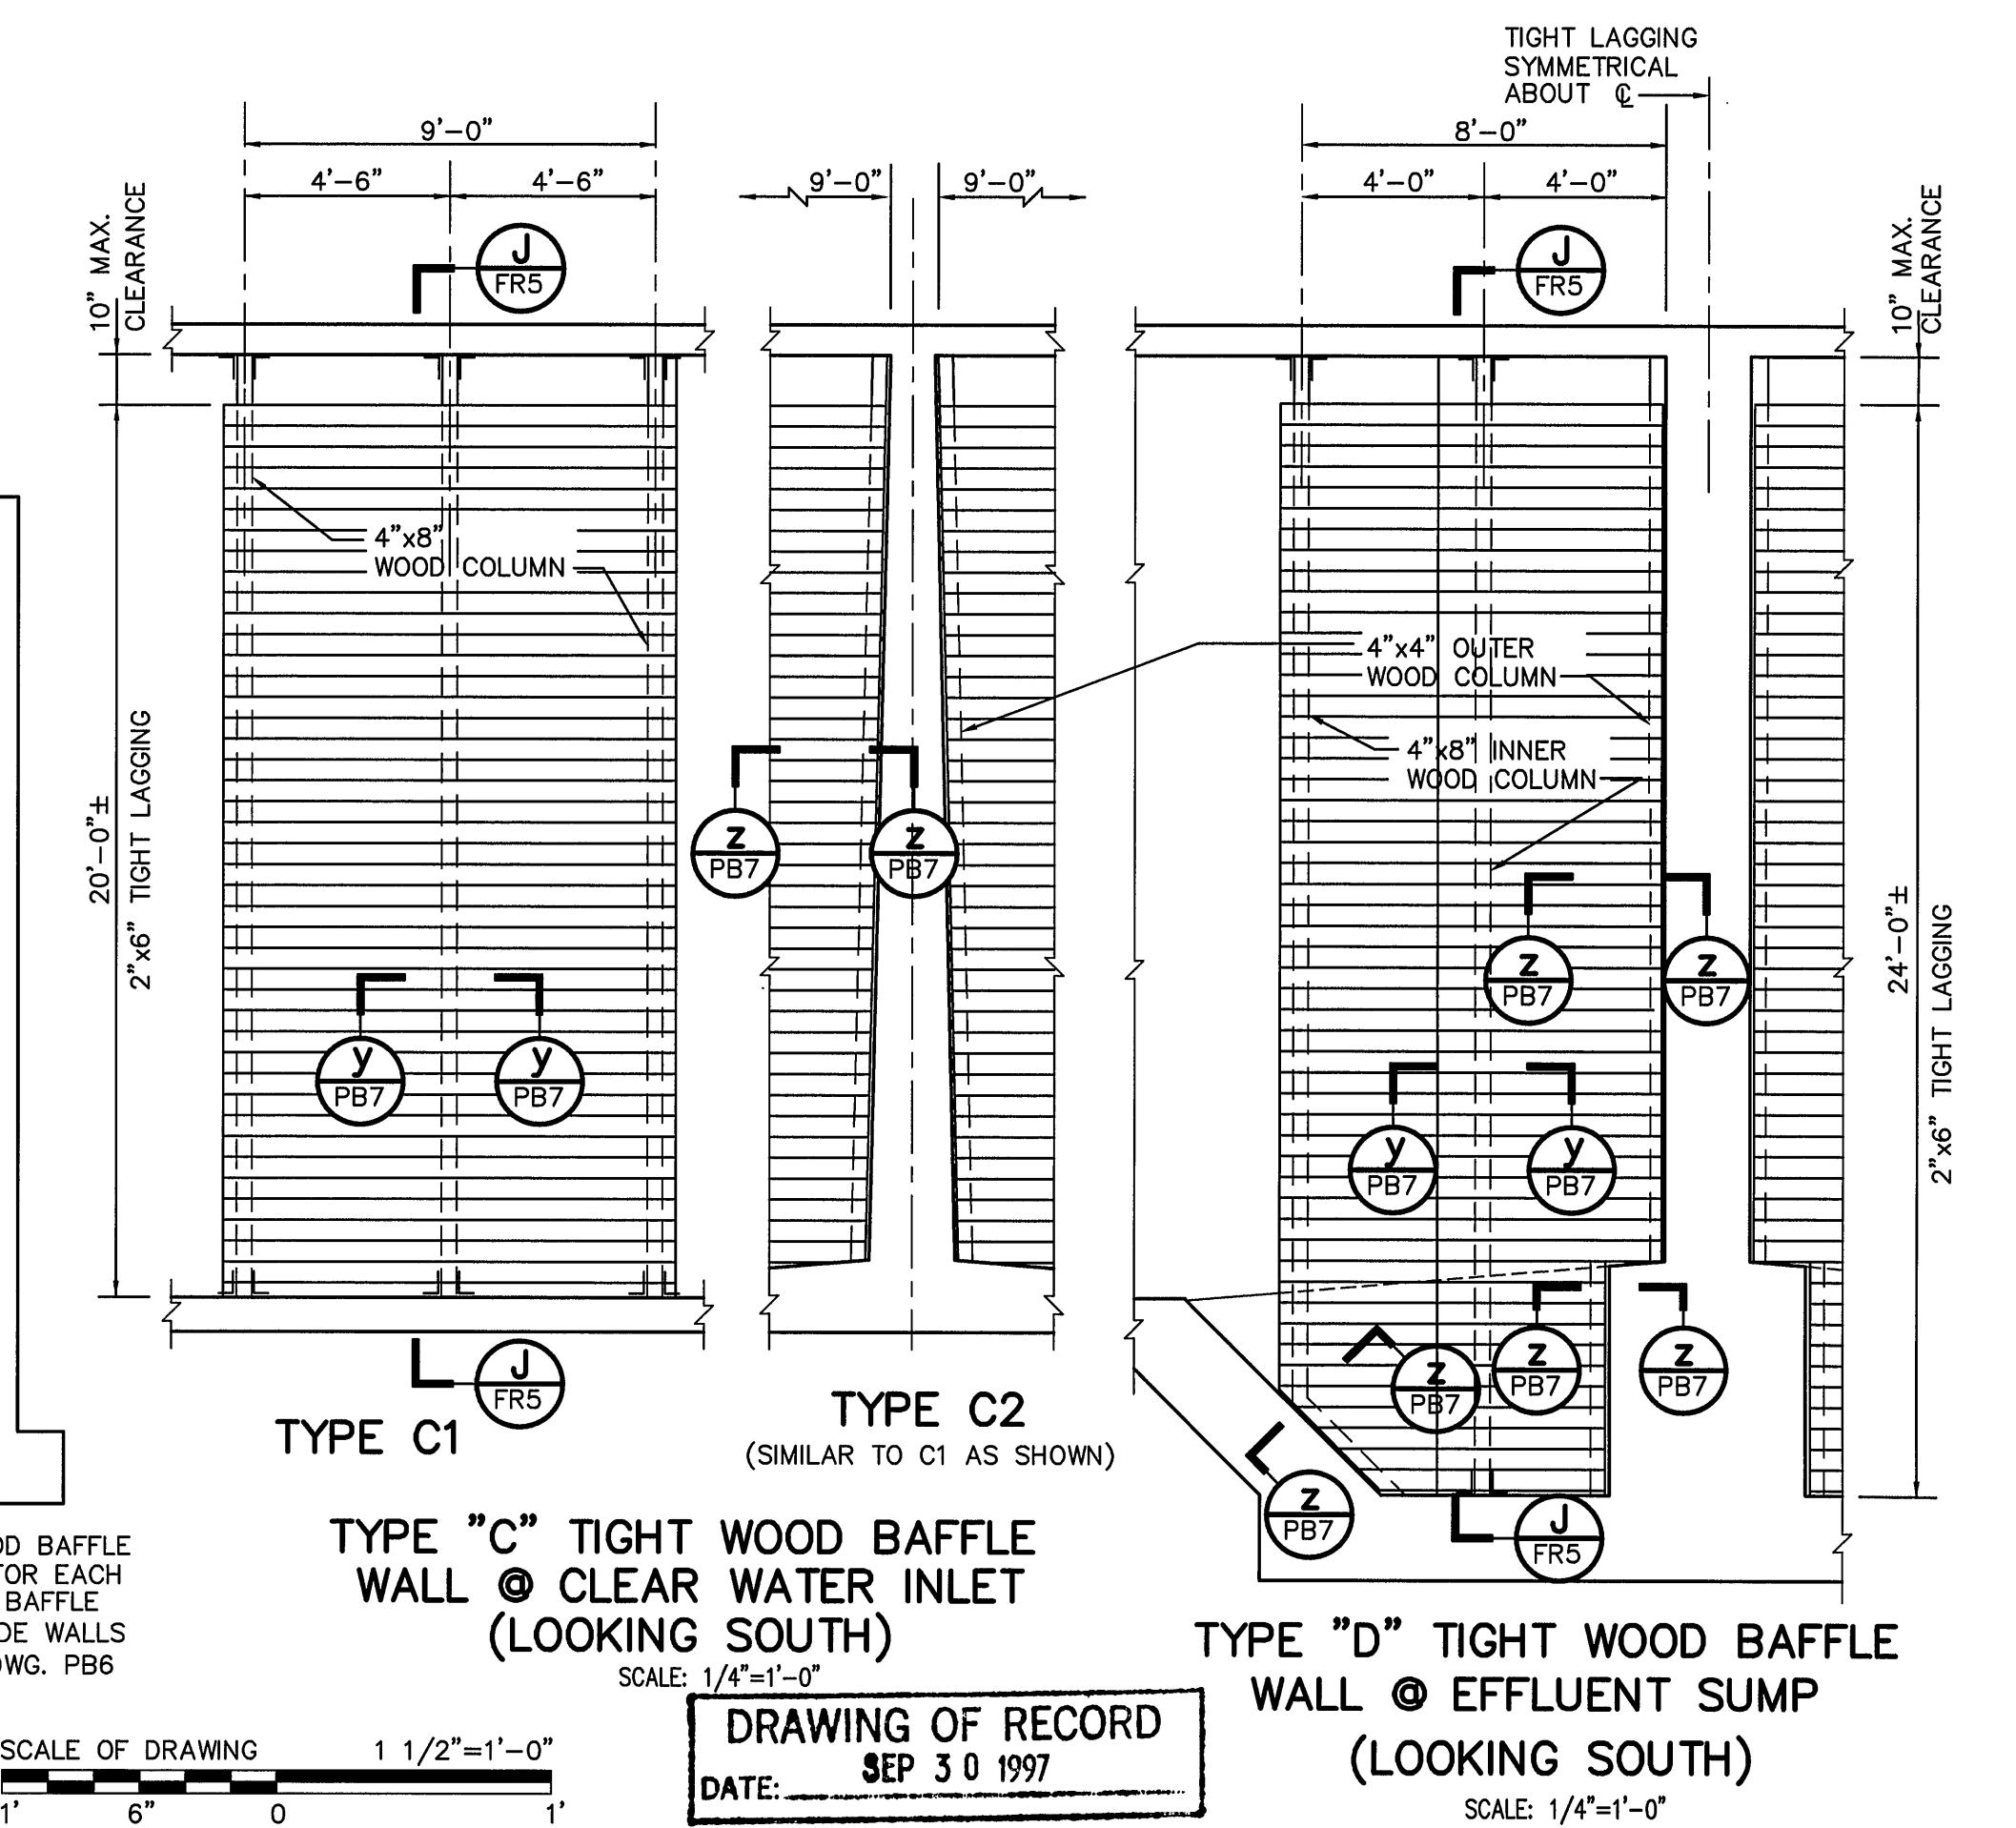


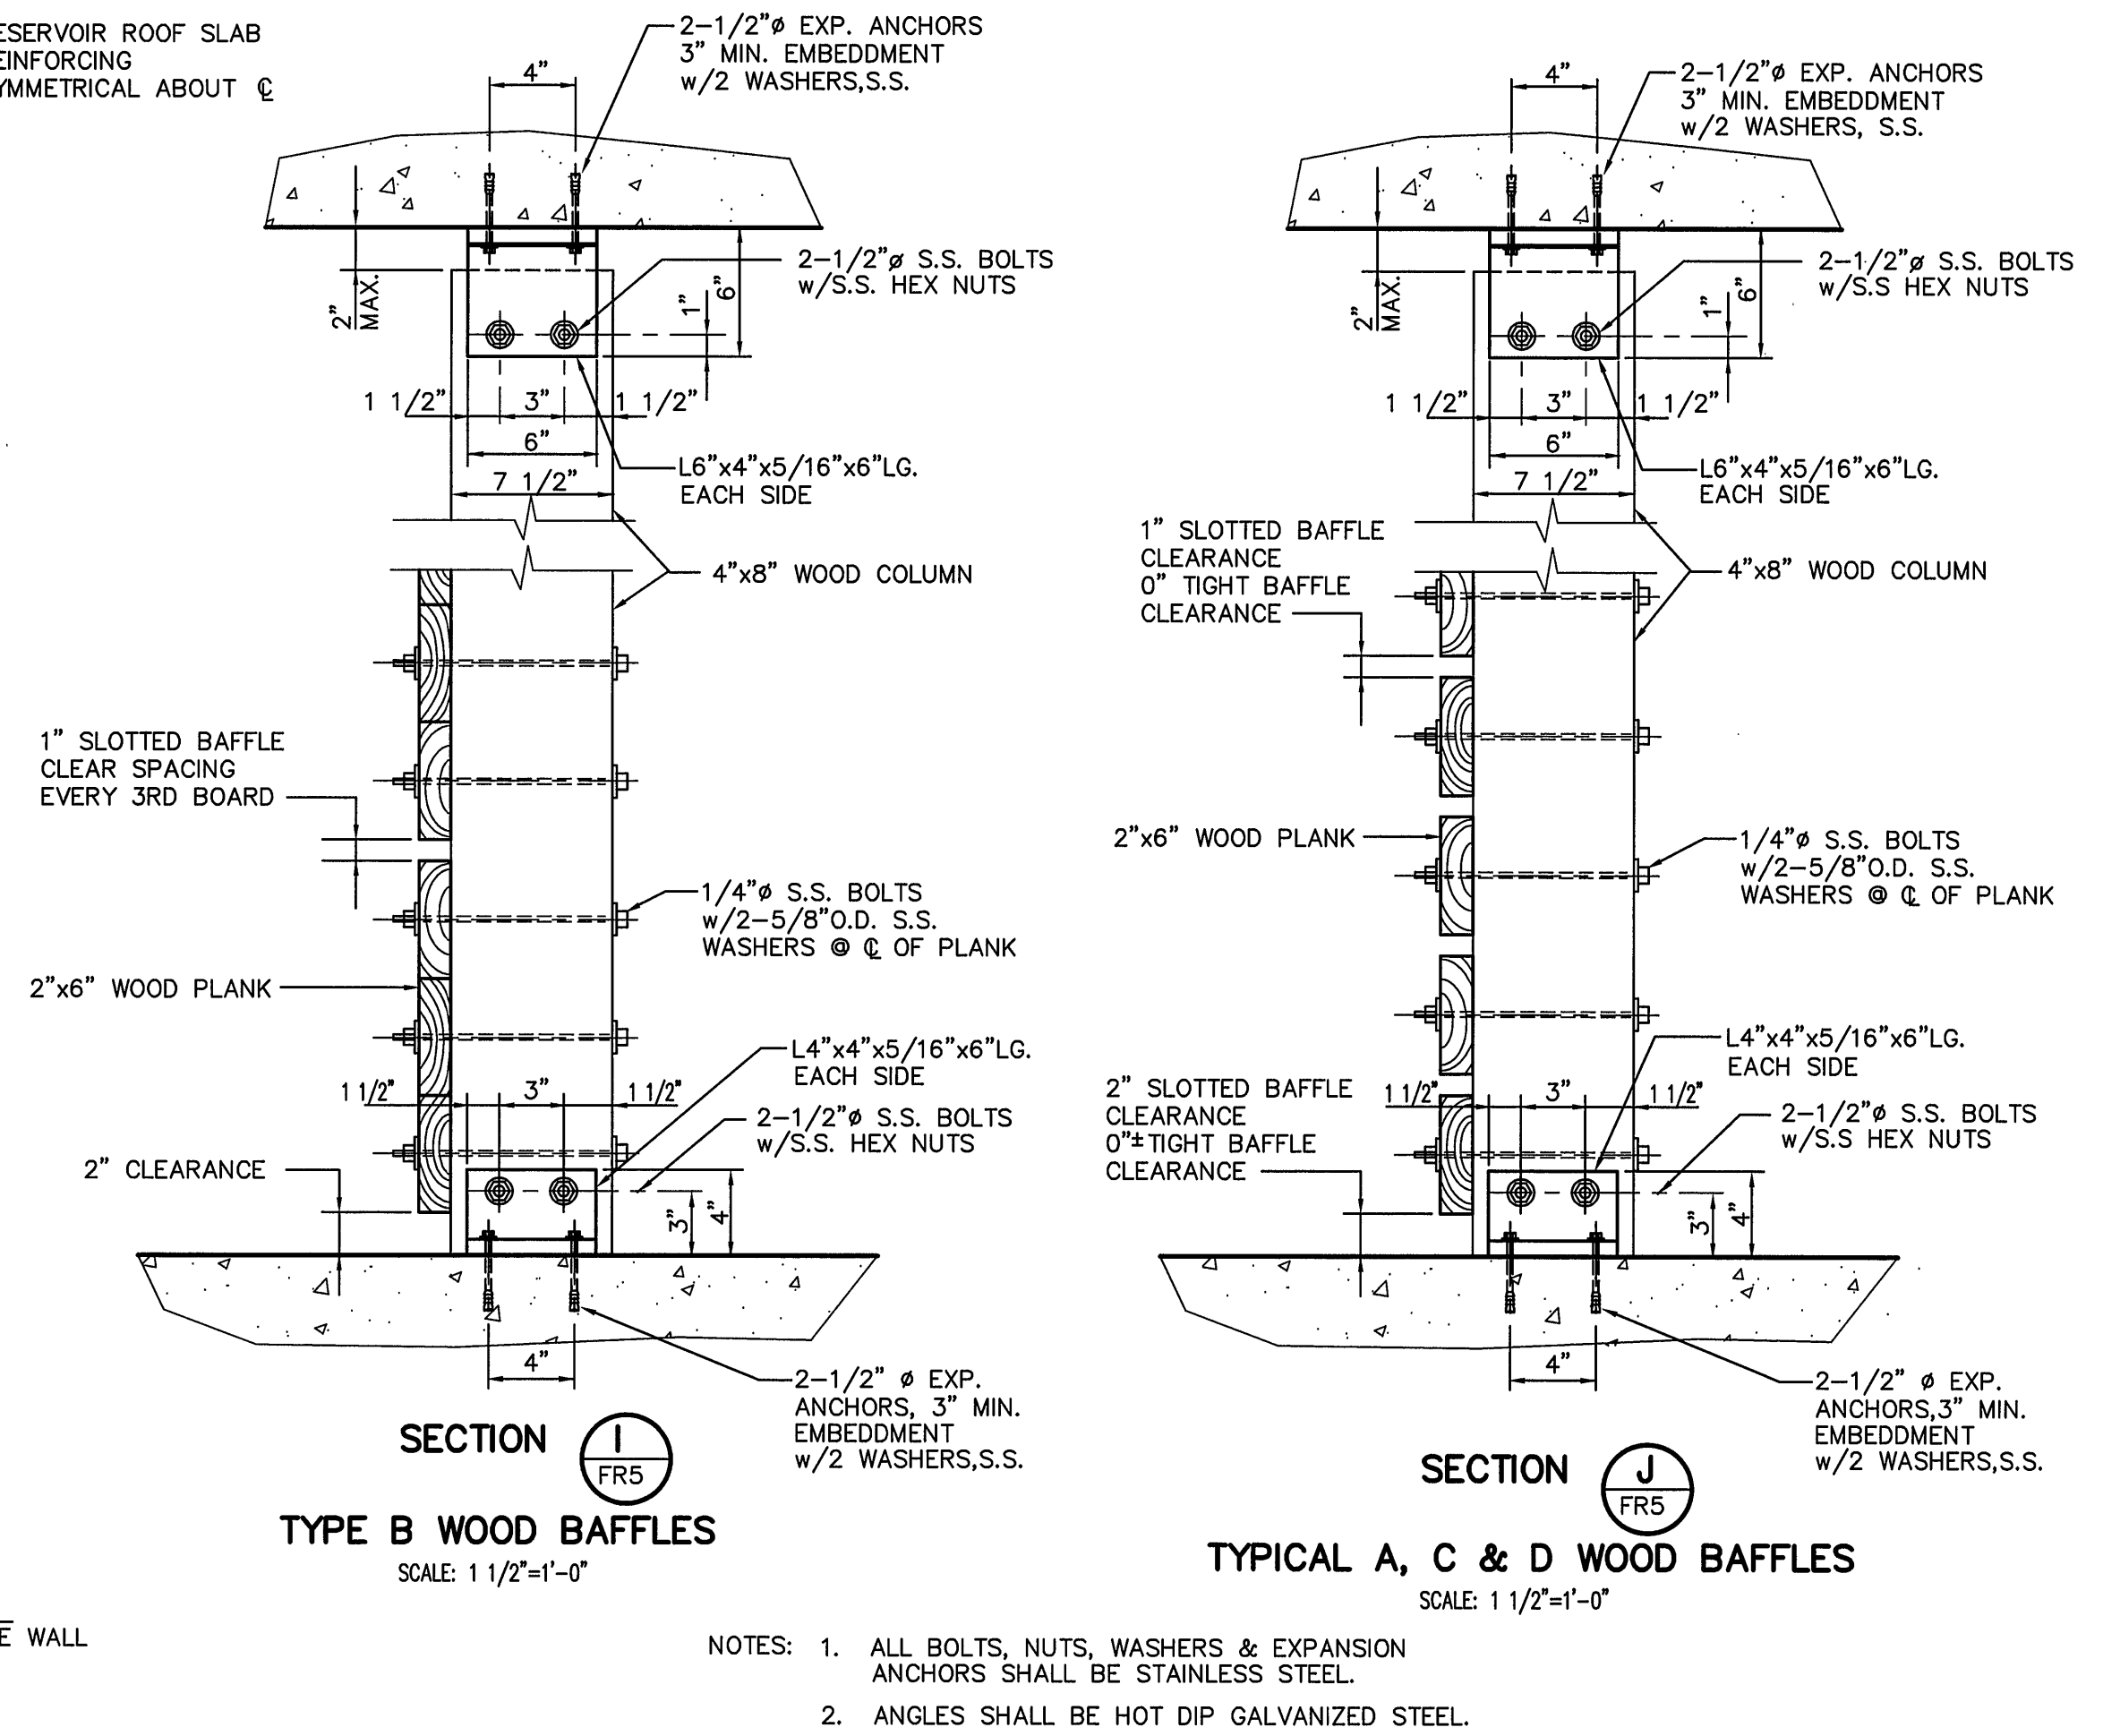

MATTERN & CRAIG CONSULTING ENGINEERS • SURVEYORS ROANOKE VIRGINIA	DESIGNED: S.C.P.			REV.	DATE	DESCRIPTION	BY	APP.	CARVINS COVE FILTER PLANT IMPROVEMENTS – PHASE I ROANOKE, VIRGINIA	DATE APRIL 1992	
	DRAWN: C.T.M. R.E.T.										COMM. NO. 9130
	CHECKED: Y.T.L.										SHEET FR5
ALVORD, BURDICK & HOWSON ENGINEERS CHICAGO									FINISHED WATER RESERVOIR ROOF SLAB REINF. & WOOD BAFFLES		