

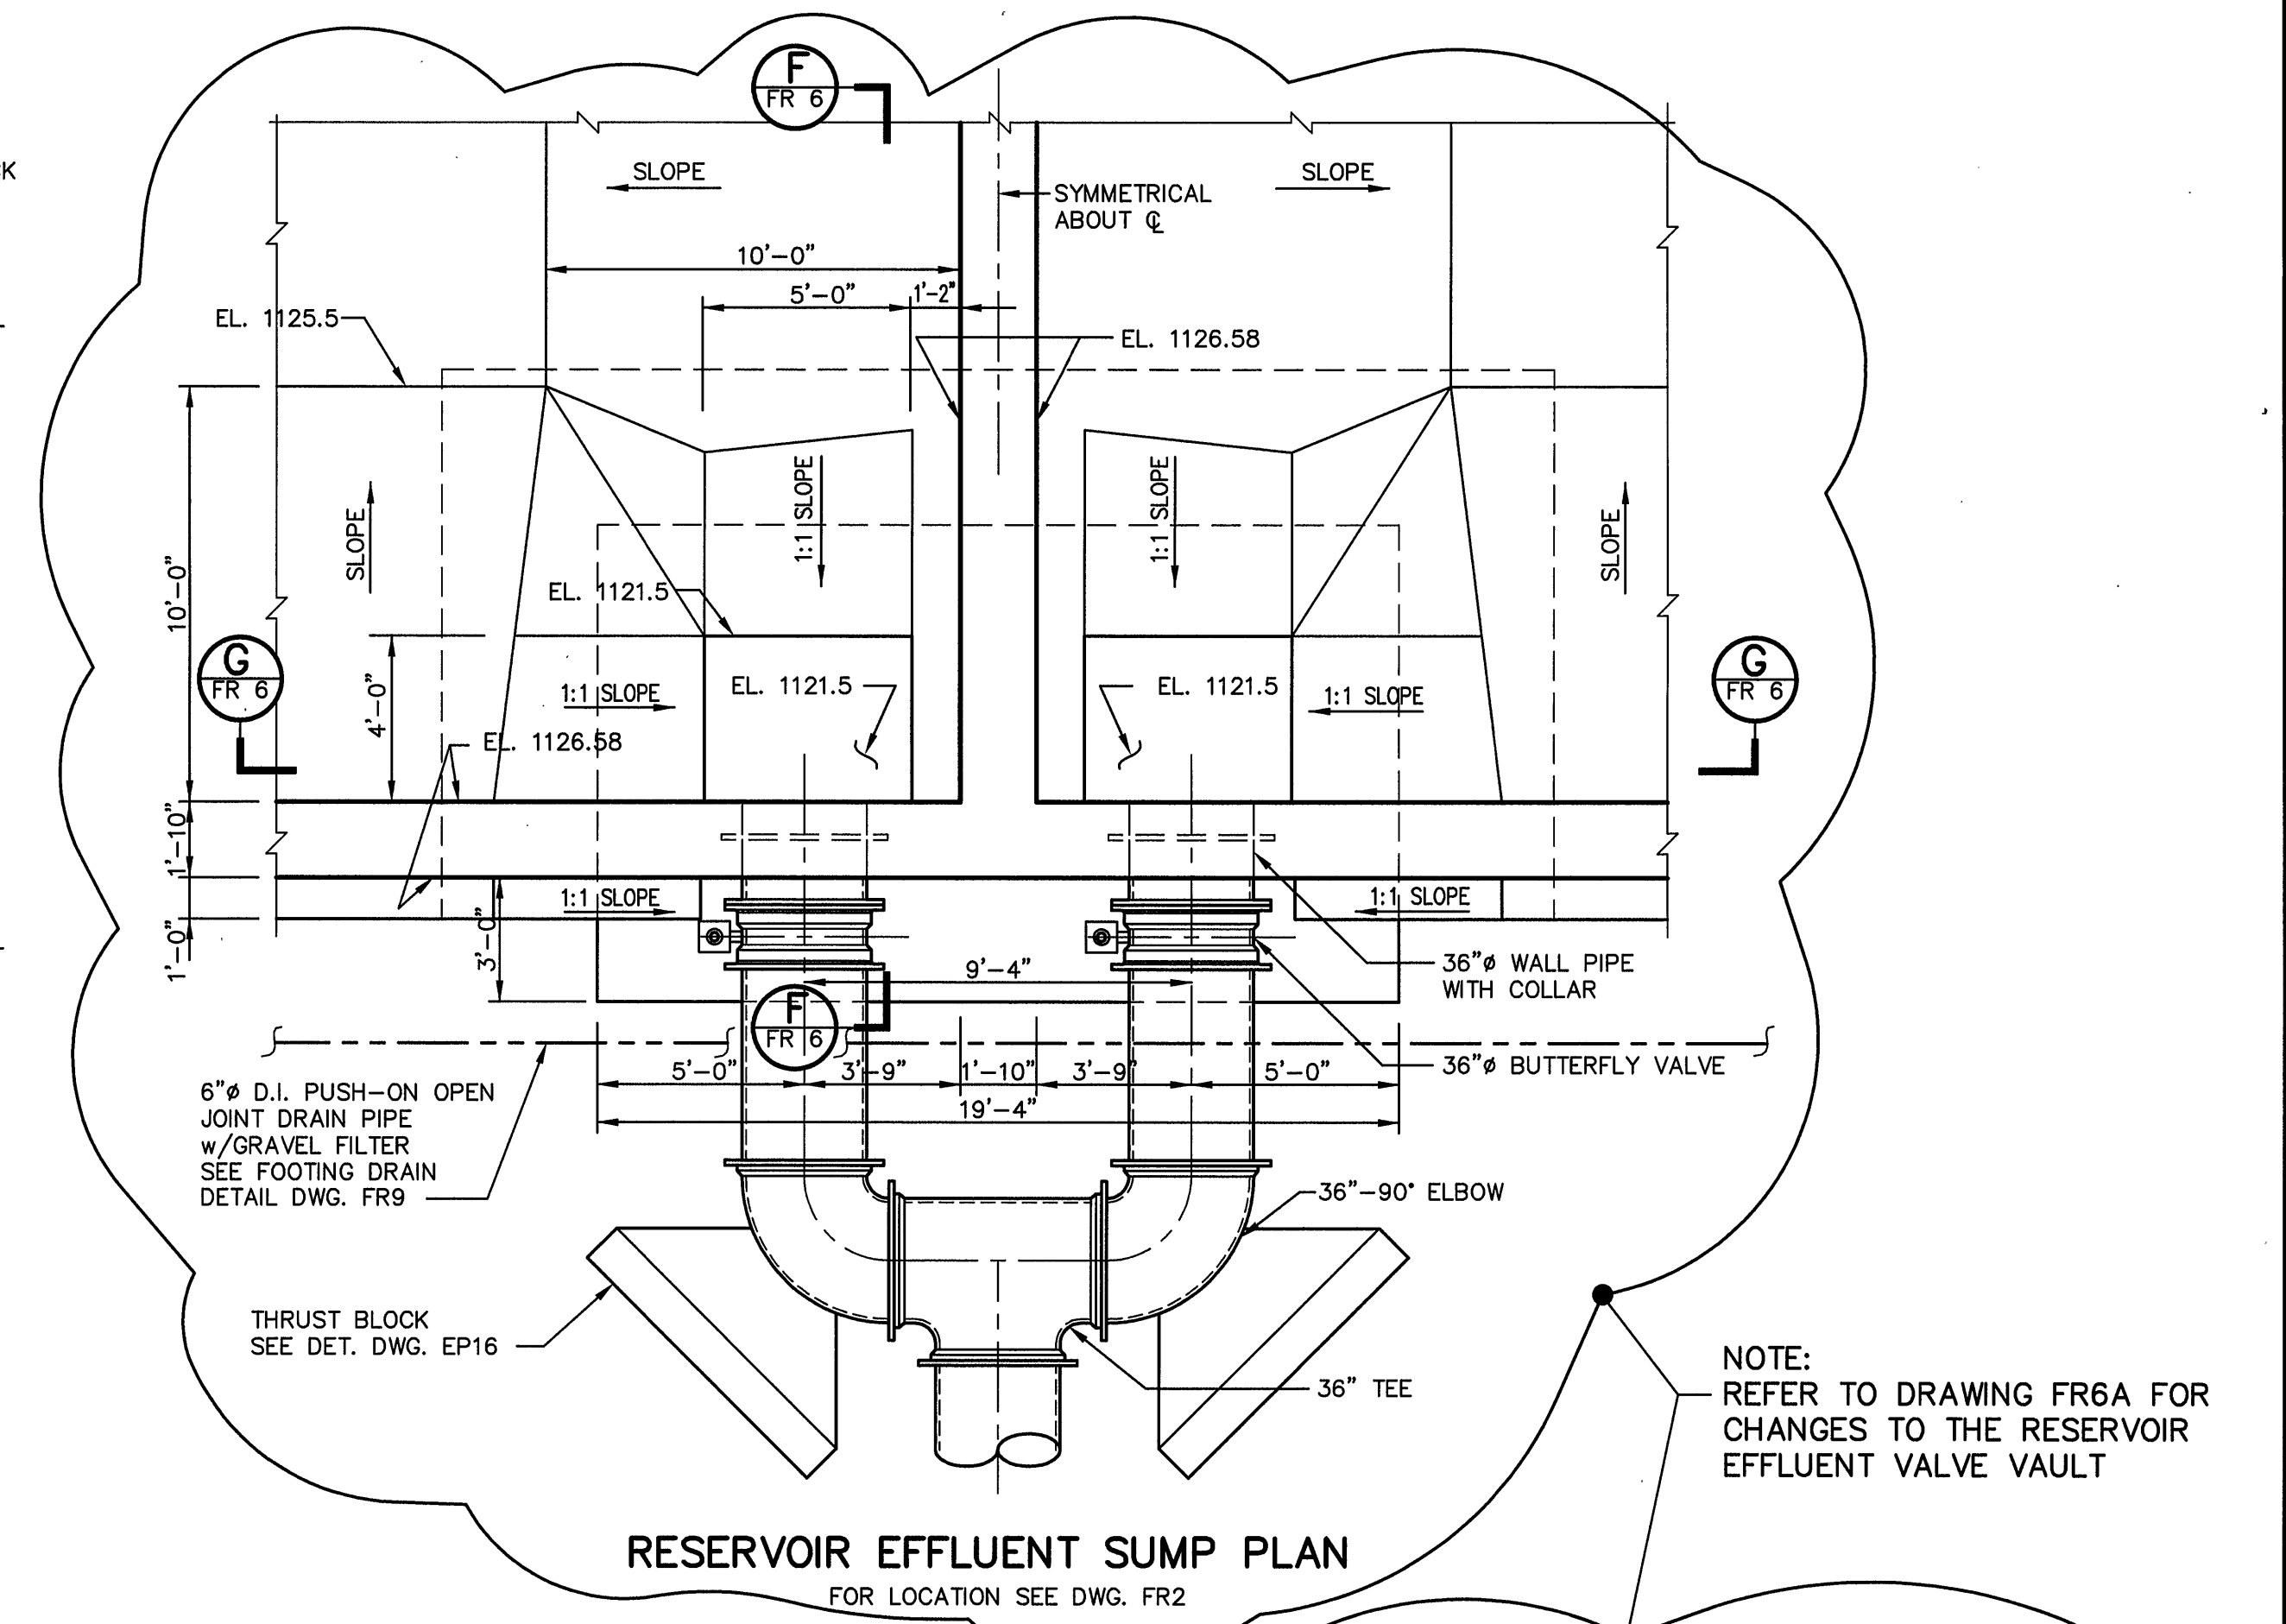


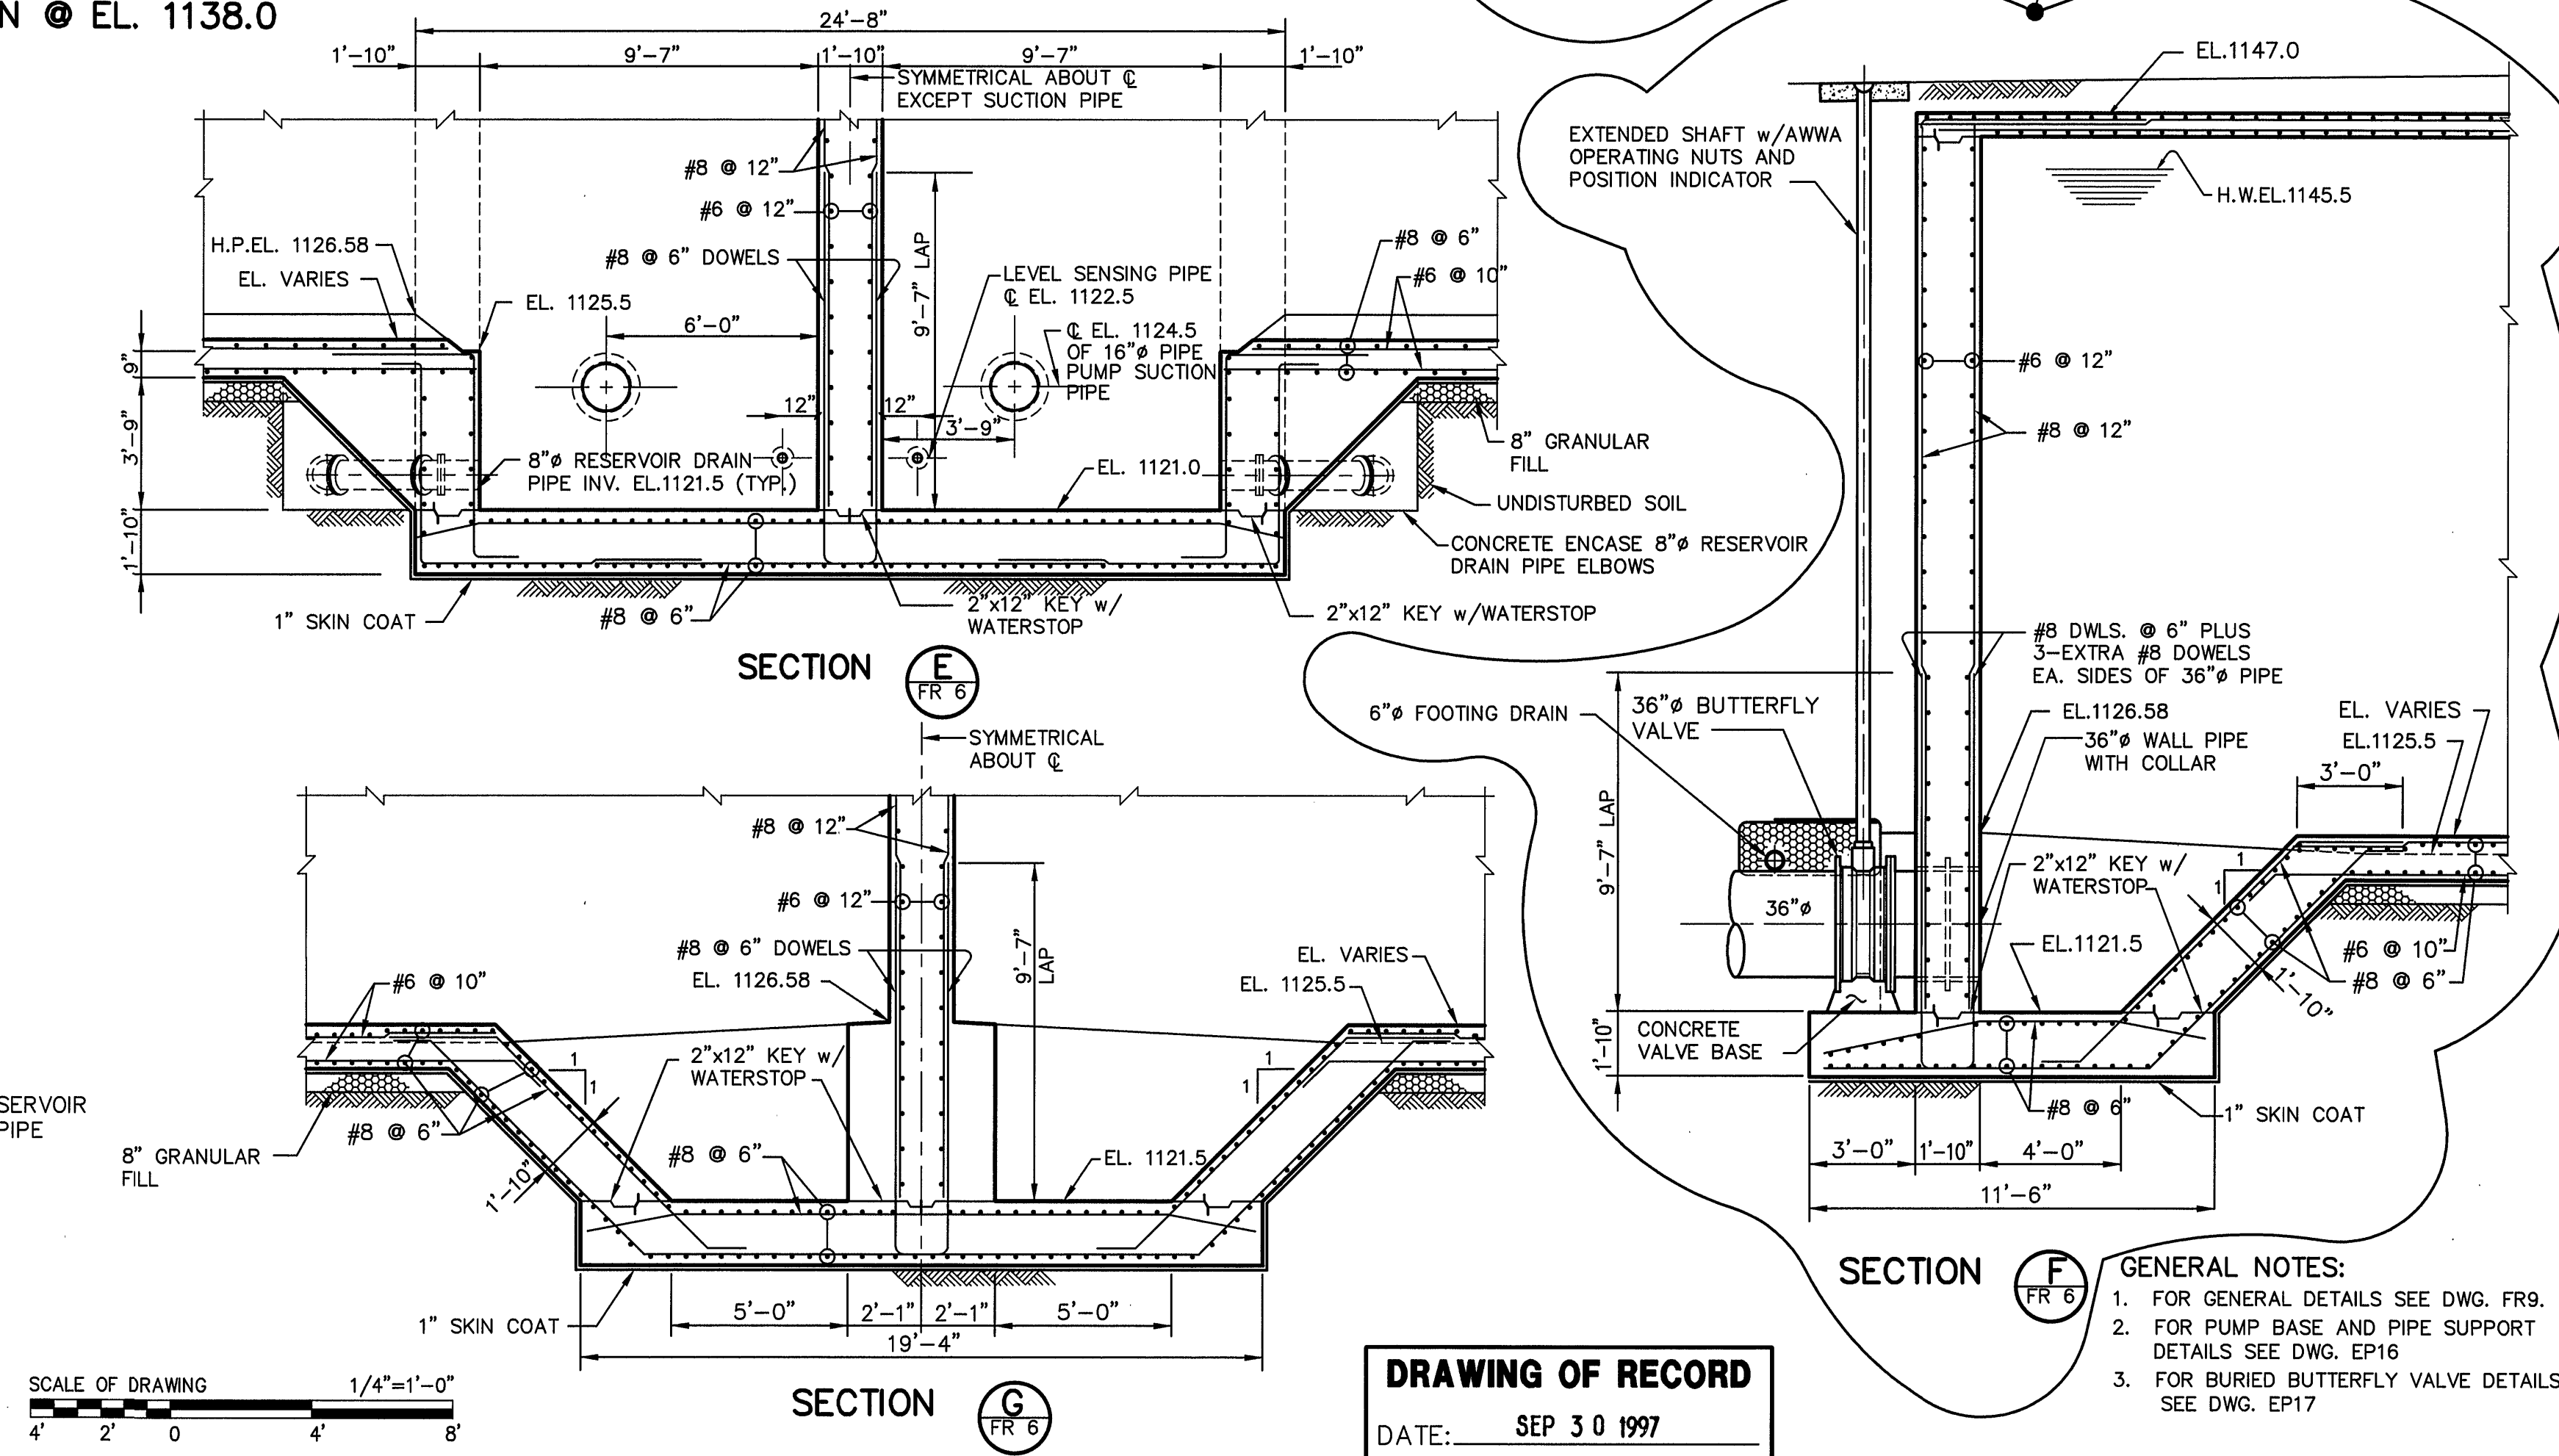

WASHWATER PUMP STATION PLAN @ EL. 1138.0

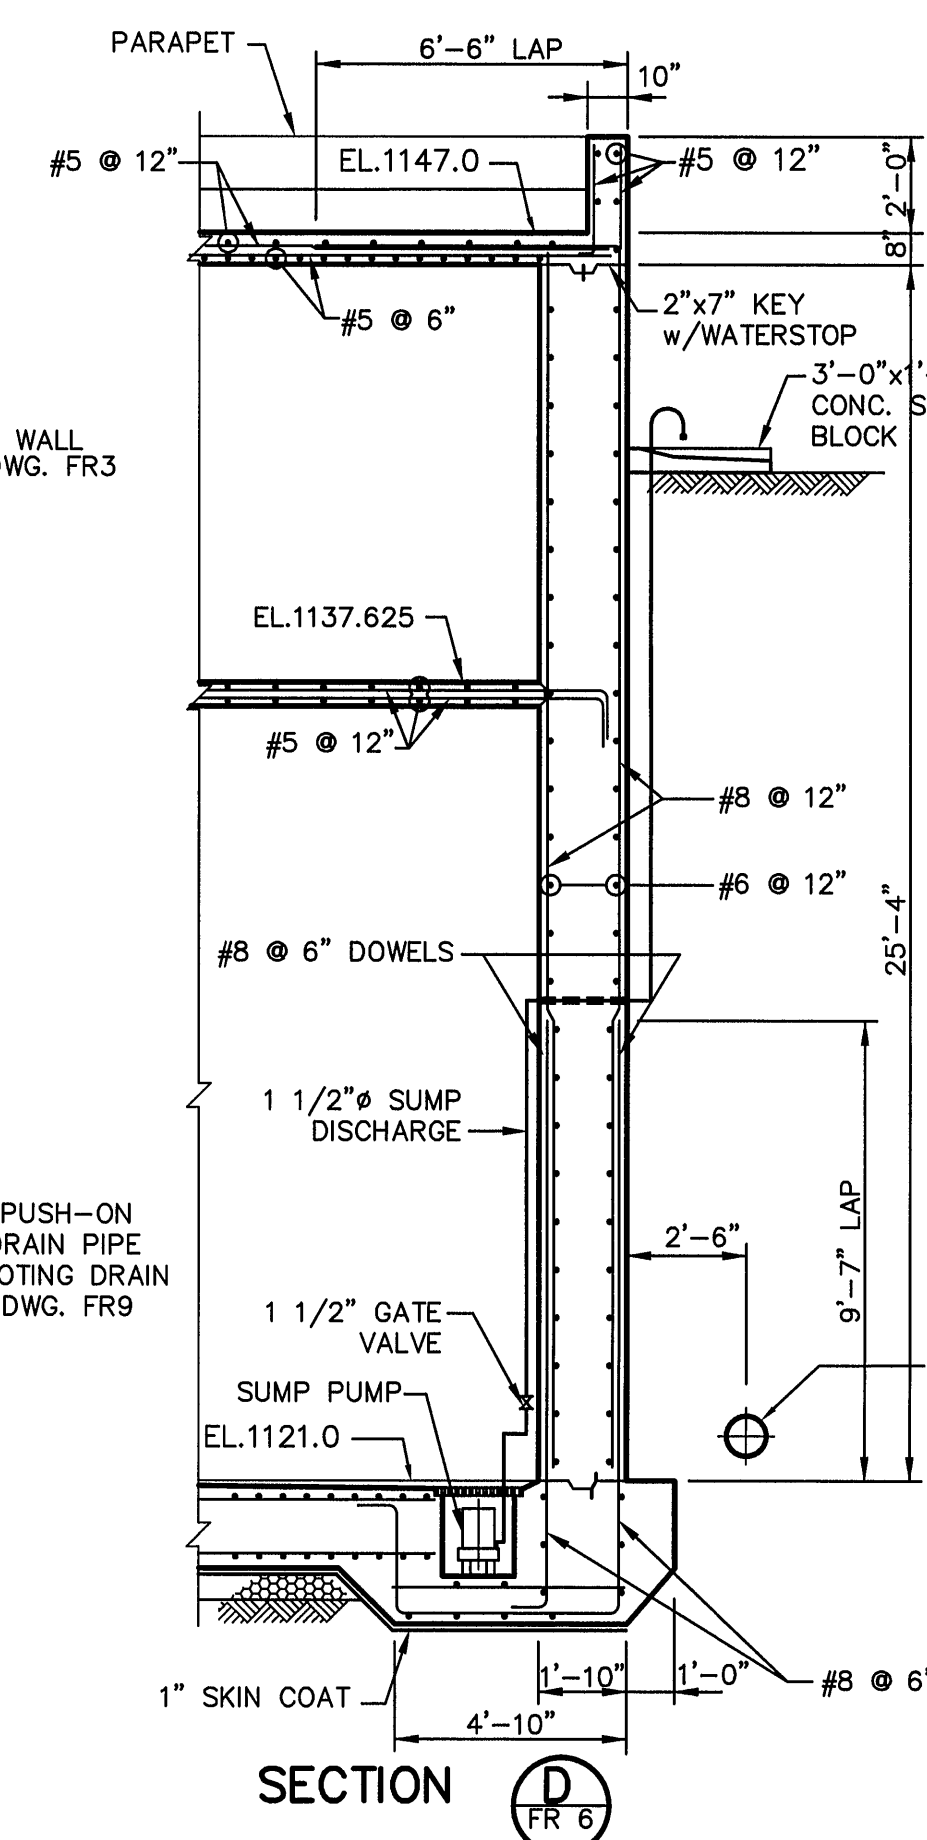

GENERAL NOTES:

1. FOR GENERAL DETAILS SEE DWG. FR9.
2. FOR PUMP BASE AND PIPE SUPPORT DETAILS SEE DWG. EP16
3. FOR BURIED BUTTERFLY VALVE DETAILS SEE DWG. EP17

DATE	APRIL 1992
COMM. NO.	9130
SHEET	FR6