
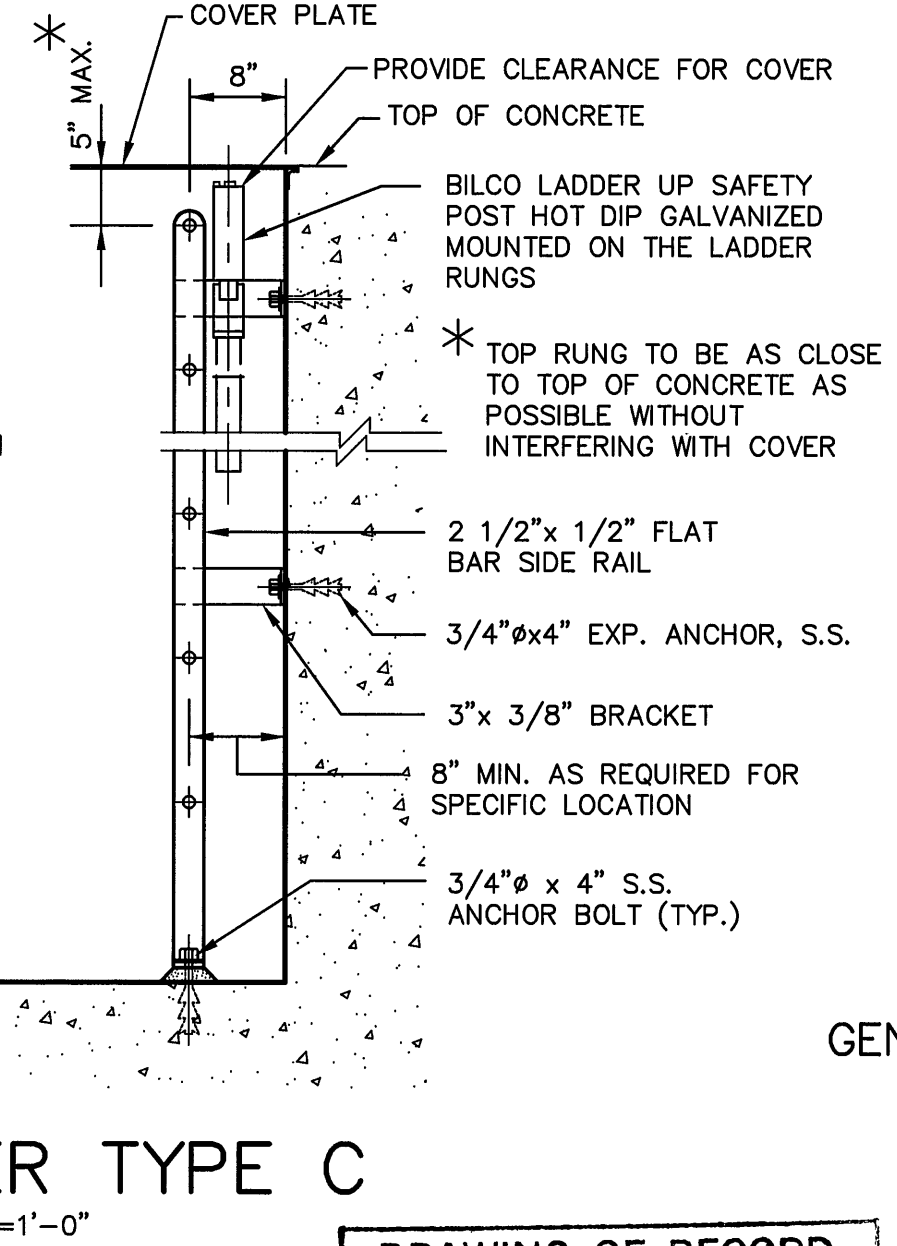
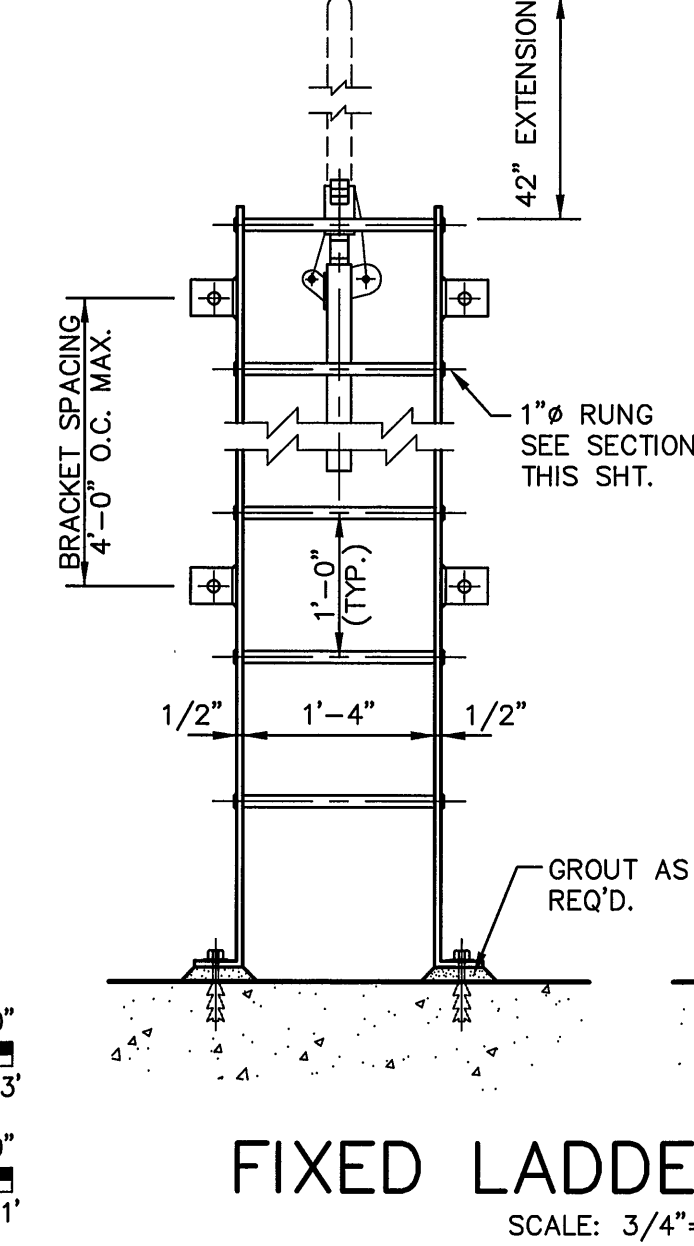
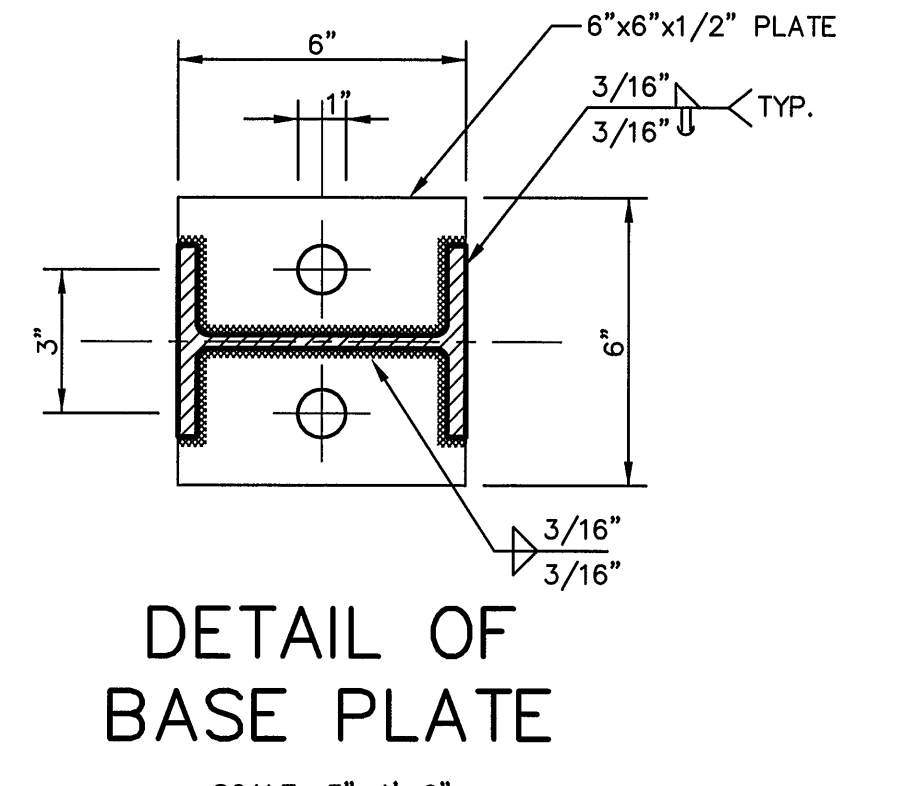
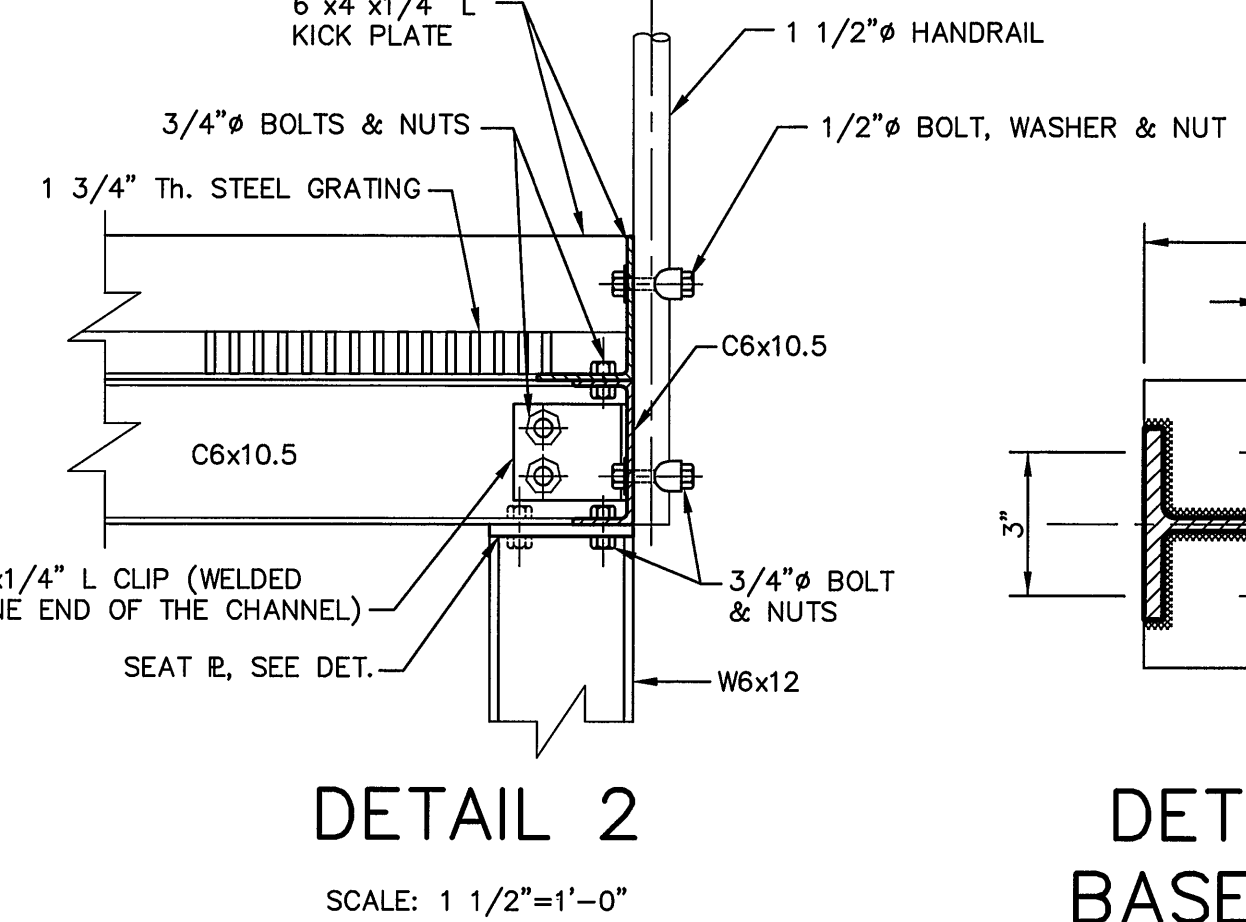
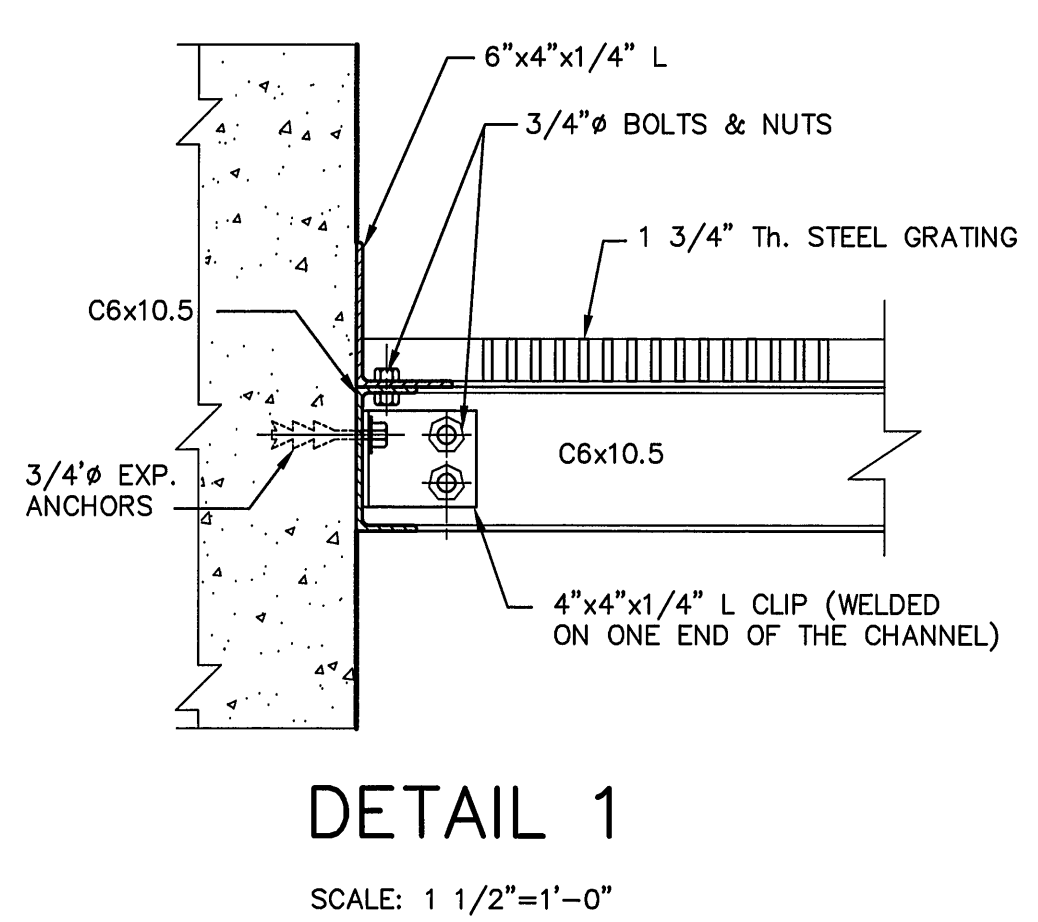
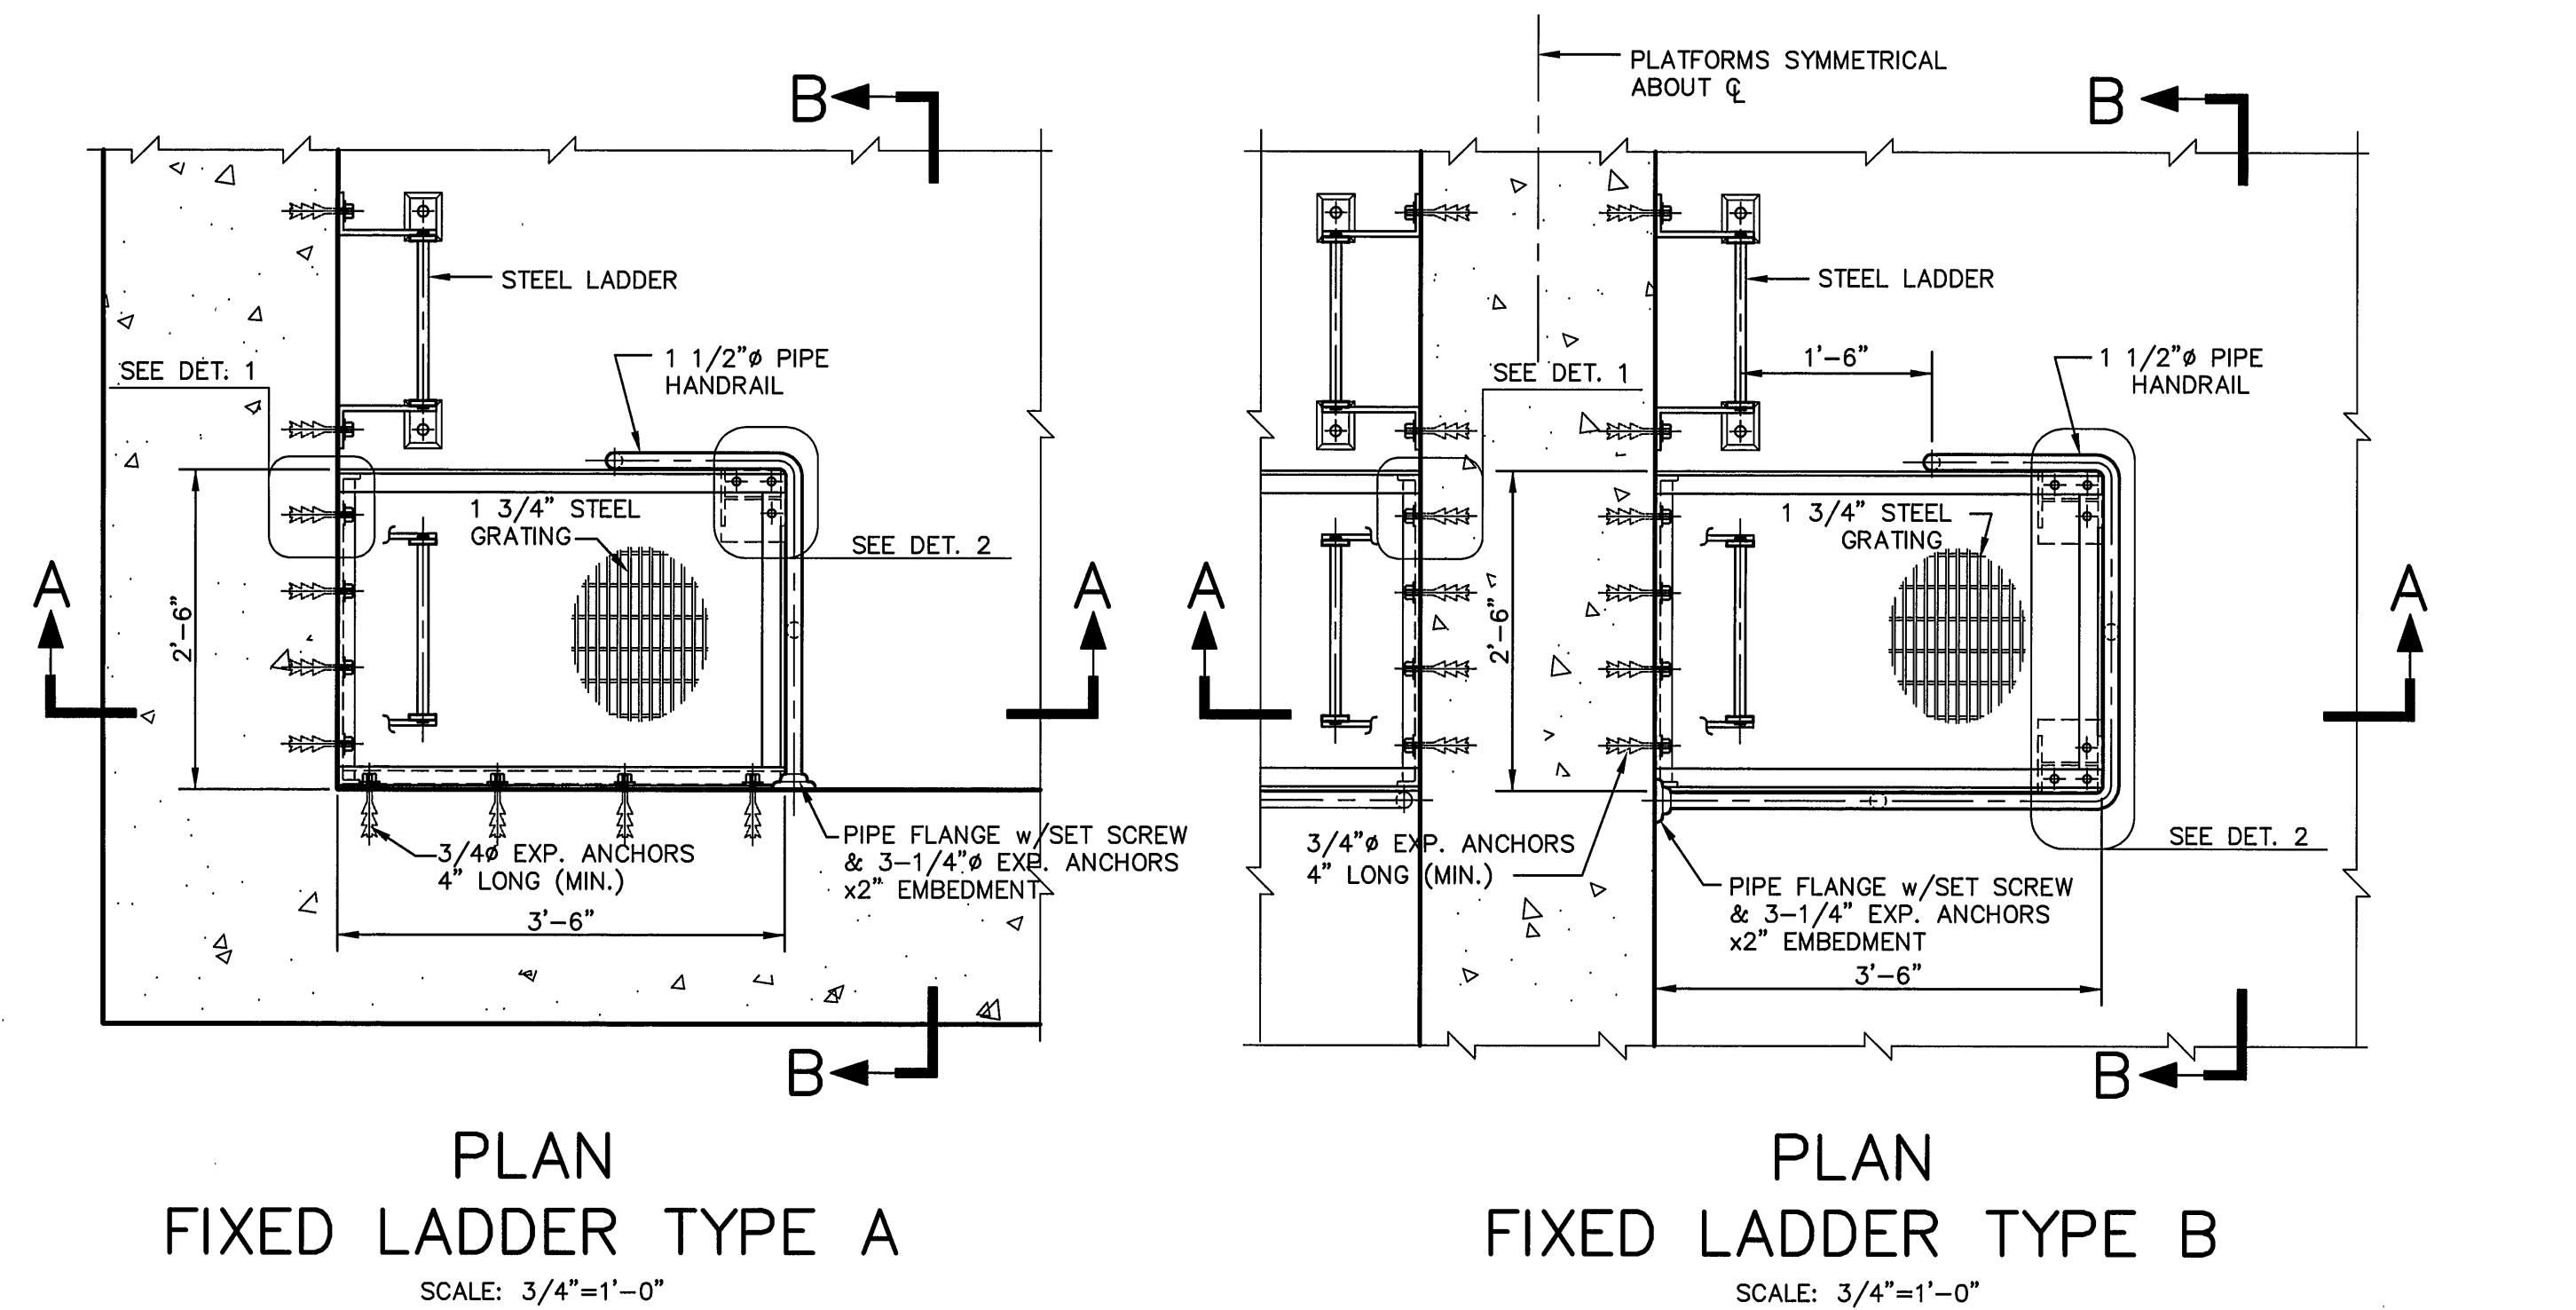


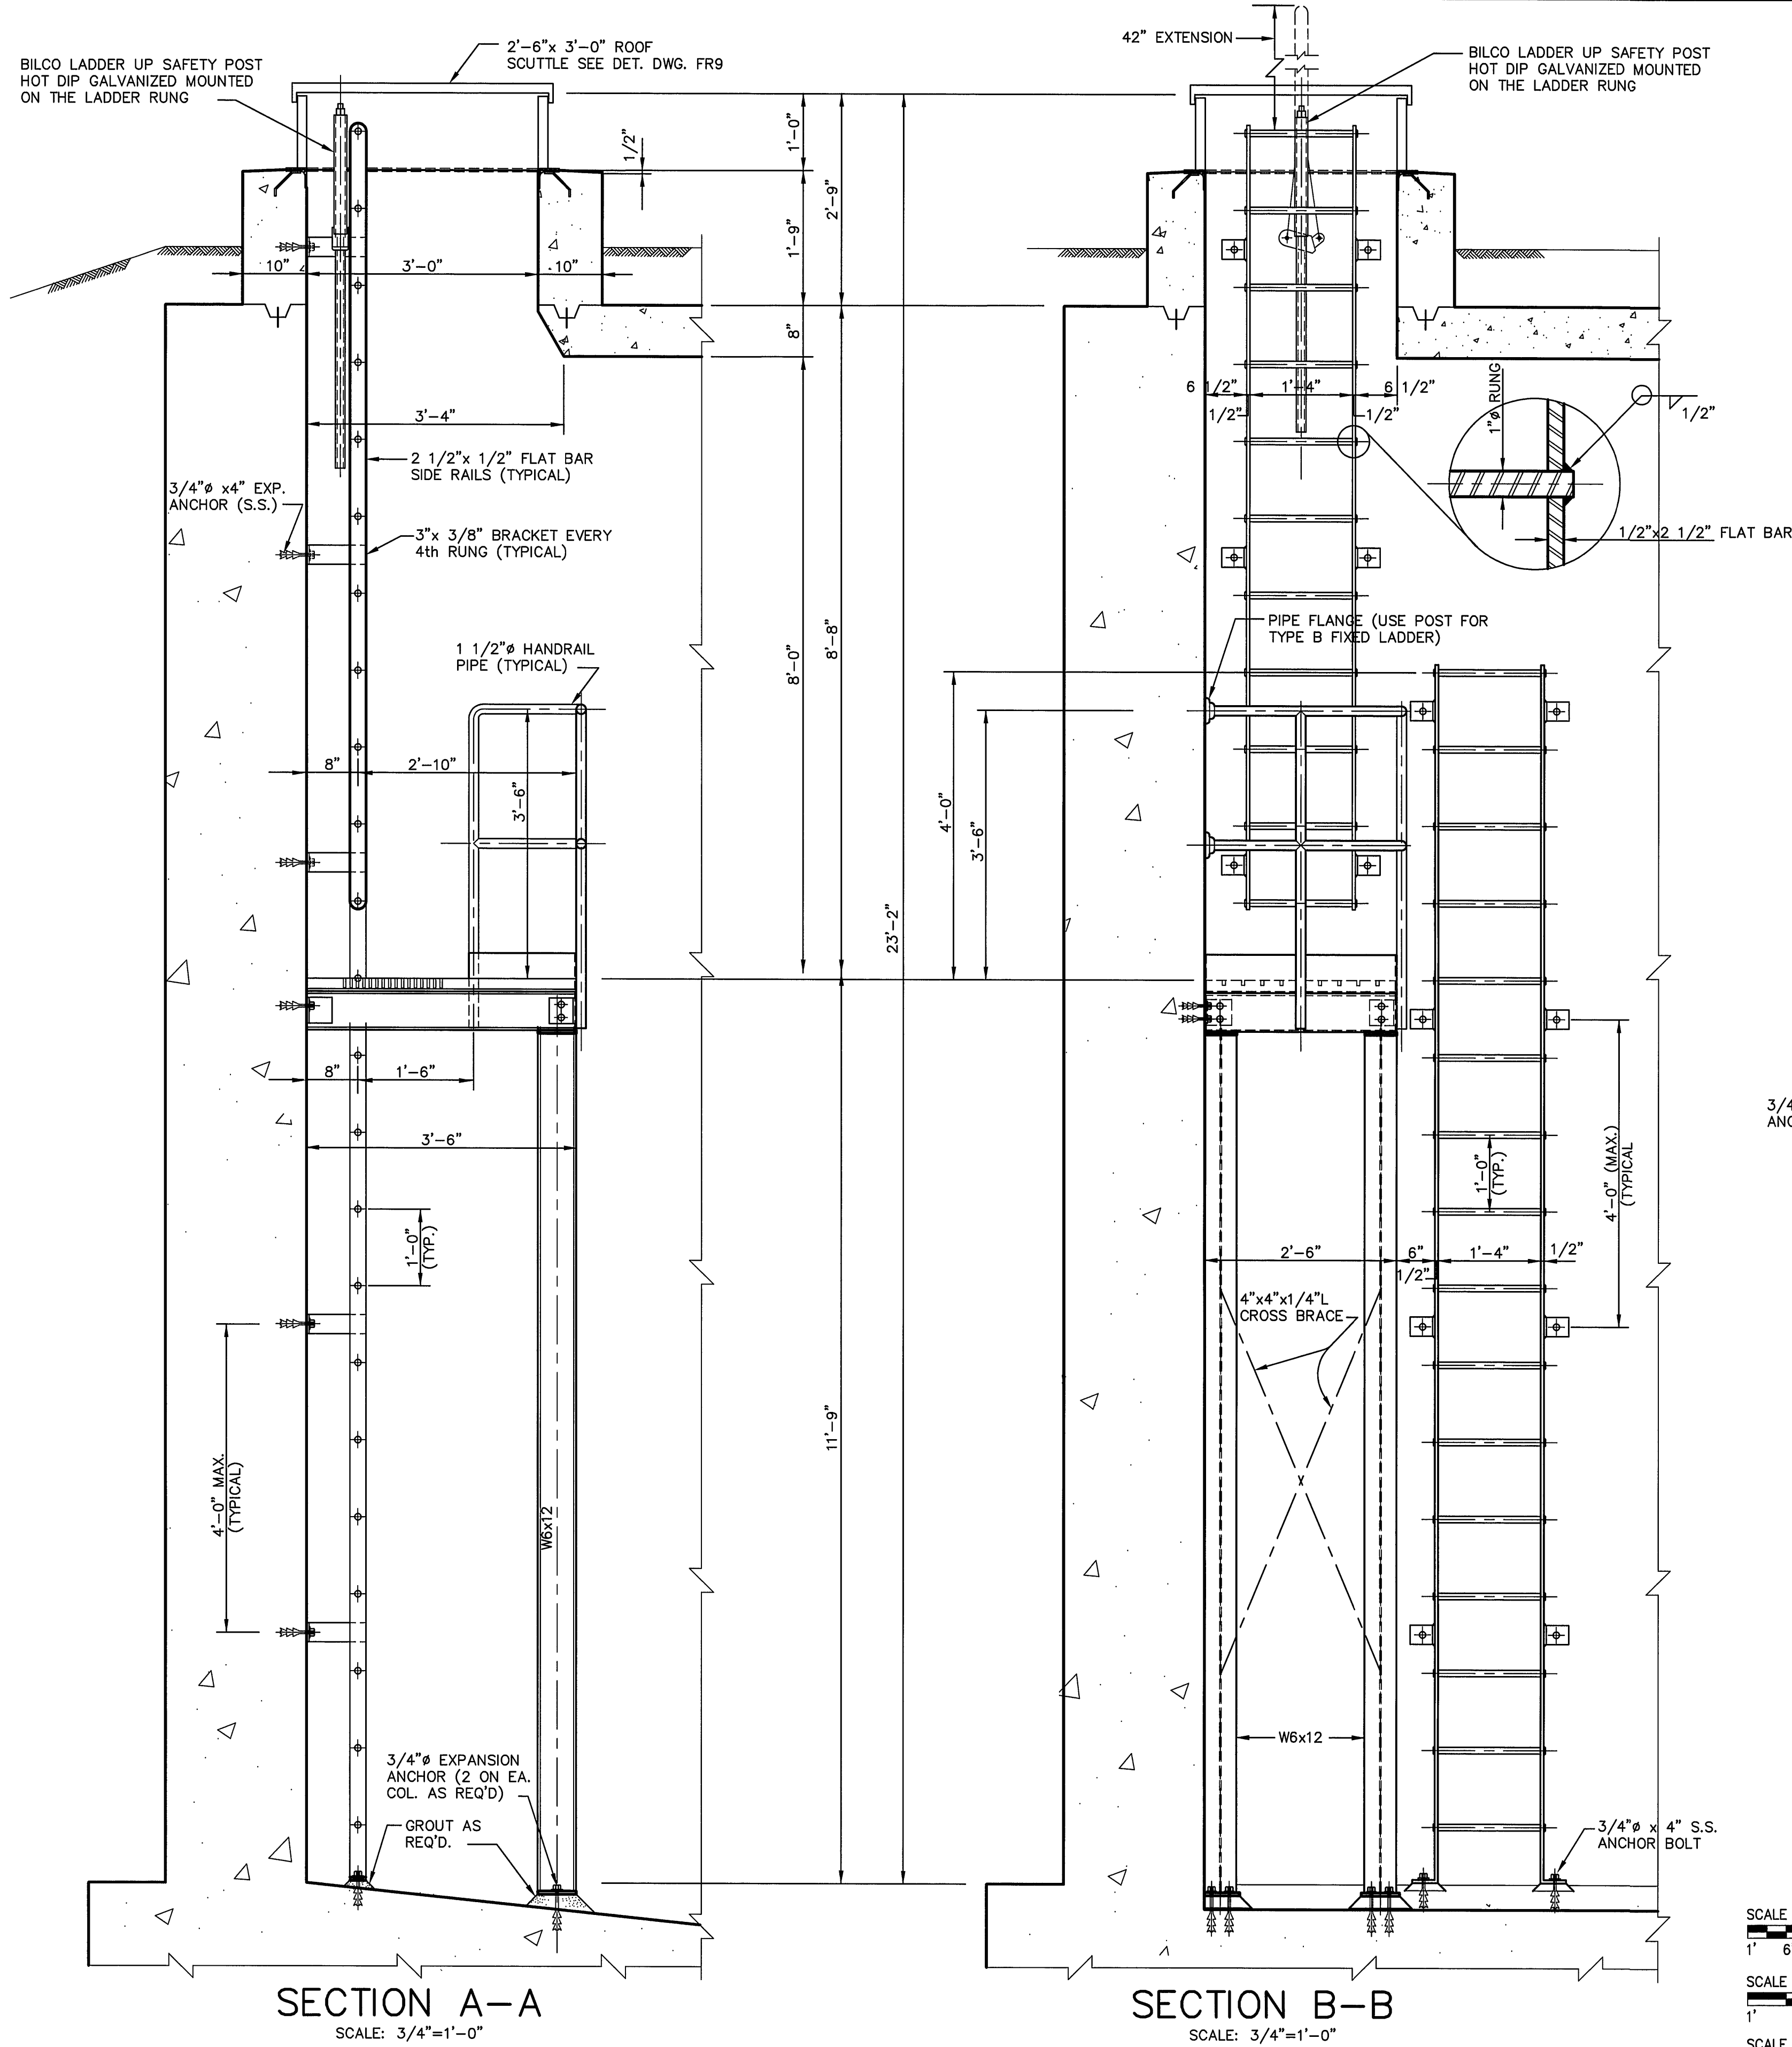

- GENERAL NOTES:**
- LADDER AND PLATFORMS SHALL BE MADE TO SATISFY ALL OSHA REQUIREMENTS.
 - LADDERS AND PLATFORMS SHALL BE ALL STEEL CONSTRUCTION HOT DIPPED GALV. AFTER FABRICATION.
 - ALL BOLTS, NUTS, WASHERS AND EXPANSION ANCHORS SHALL BE STAINLESS STEEL.

DRAWING OF RECORD
DATE: SEP 30 1997

SCALE OF DRAWING 3/4"=1'-0"
1" 6" 0 1' 2' 3'
SCALE OF DRAWING 1 1/2"=1'-0"
1" 6" 0 1'
SCALE OF DRAWING 3"=1'-0"
6" 3" 0 6"

MATTERN & CRAIG CONSULTING ENGINEERS • SURVEYORS ROANOKE VIRGINIA ALVORD, BURDICK & HOWSON ENGINEERS CHICAGO	DESIGNED: S.C.P. DRAWN: C.T.M. CHECKED: Y.T.L.	COMMONWEALTH OF VIRGINIA YA-TAI LIN NO. 022786 PROFESSIONAL ENGINEER	<table> <tr> <th>REV.</th><th>DATE</th><th>DESCRIPTION</th><th>BY</th><th>APP.</th></tr> <tr><td> </td><td> </td><td> </td><td> </td><td> </td></tr> <tr><td> </td><td> </td><td> </td><td> </td><td> </td></tr> <tr><td> </td><td> </td><td> </td><td> </td><td> </td></tr> <tr><td> </td><td> </td><td> </td><td> </td><td> </td></tr> <tr><td> </td><td> </td><td> </td><td> </td><td> </td></tr> </table>	REV.	DATE	DESCRIPTION	BY	APP.																										CARVINS COVE FILTER PLANT IMPROVEMENTS – PHASE I ROANOKE, VIRGINIA 4 MG FINISHED WATER RESERVOIR PLATFORMS & LADDERS DATE: APRIL 1992 COMM. NO. 9130 SHEET FR7
REV.	DATE	DESCRIPTION	BY	APP.																														