
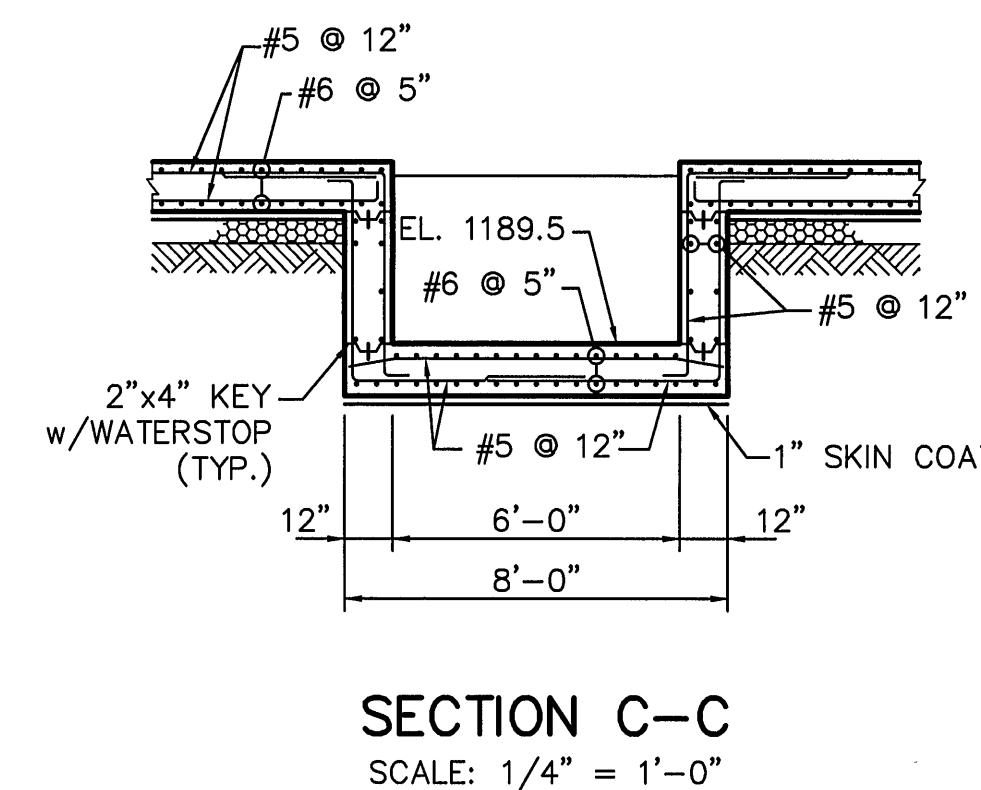
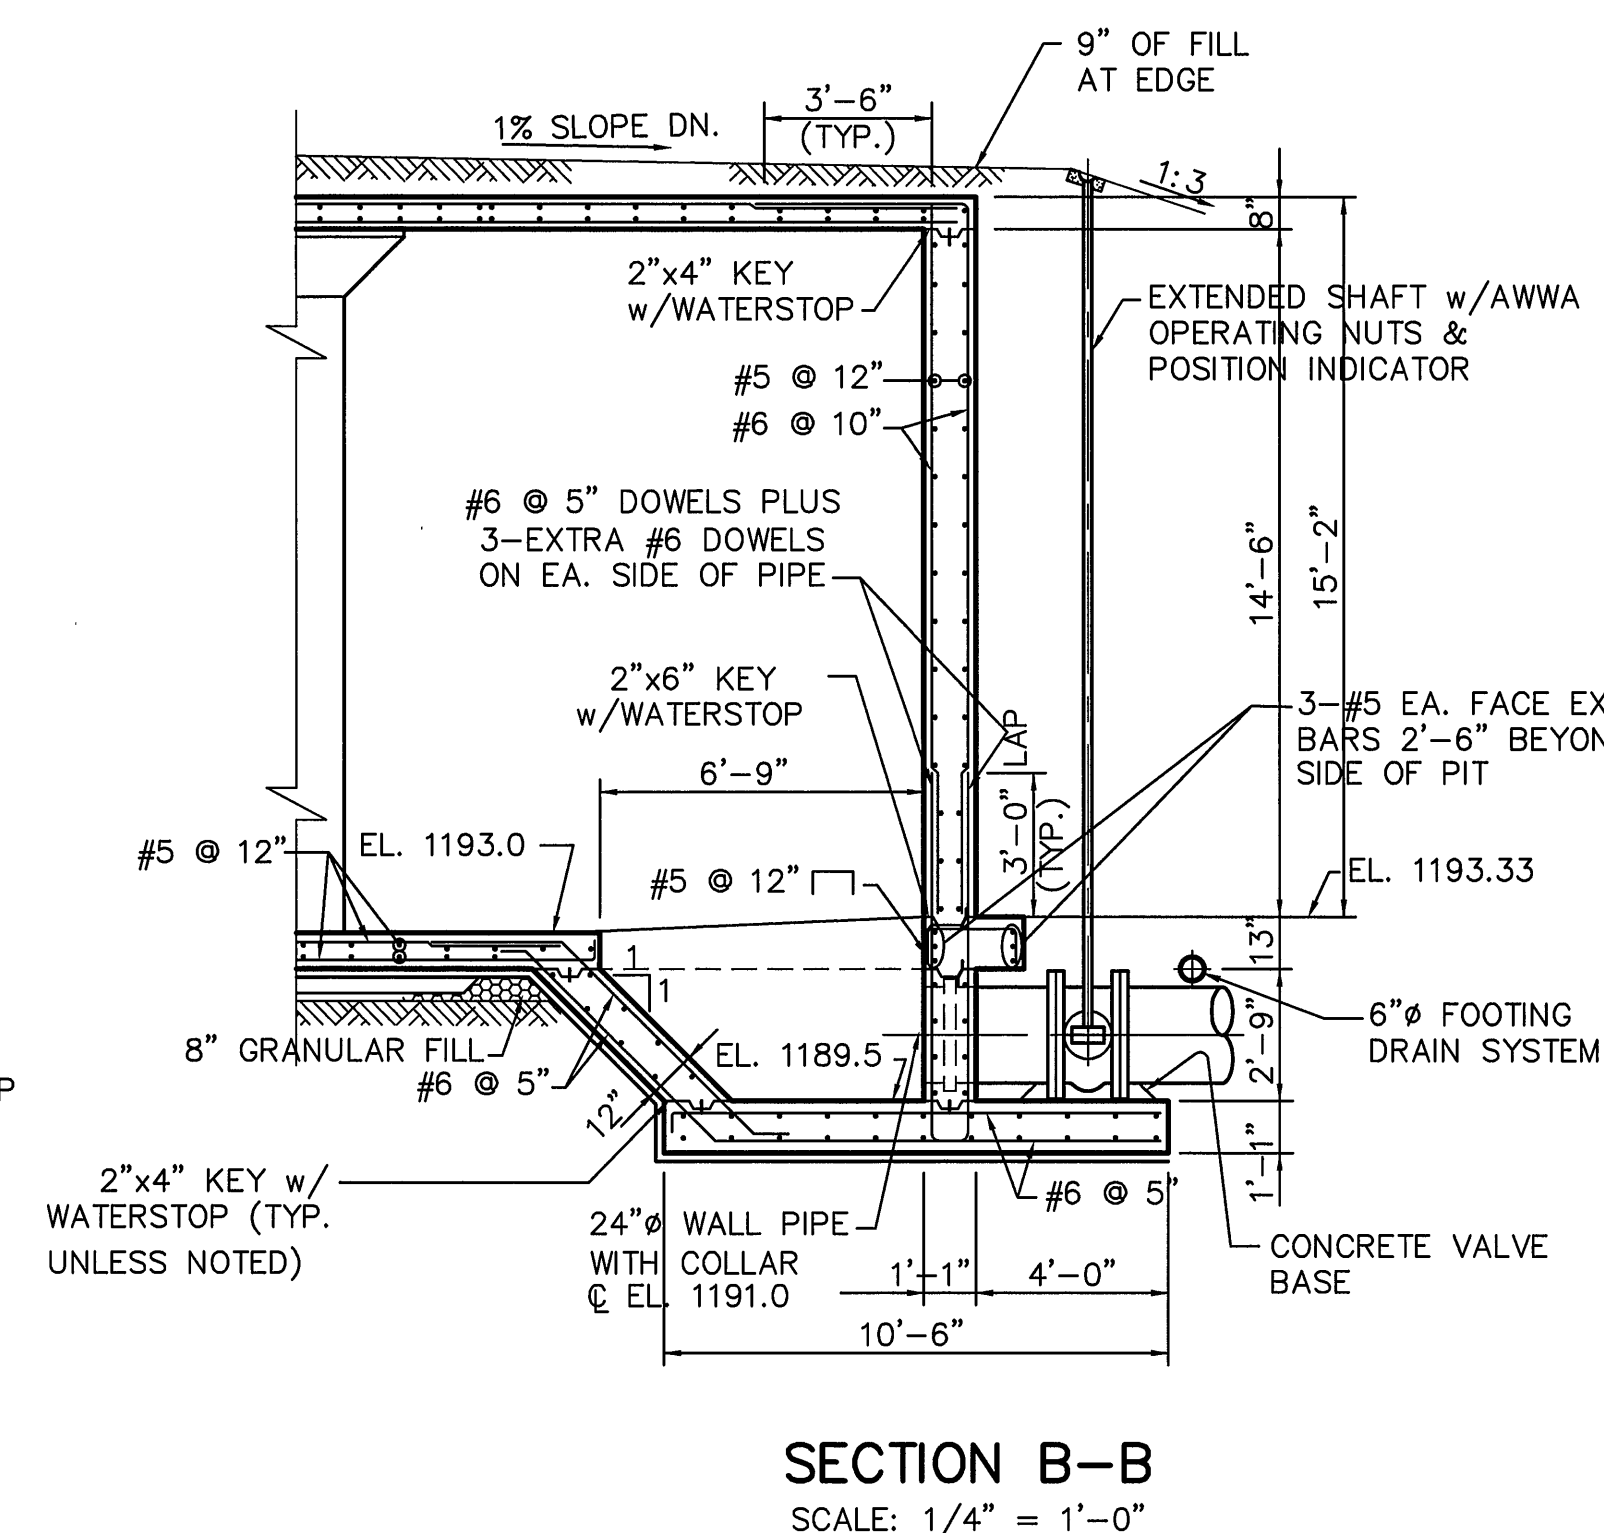
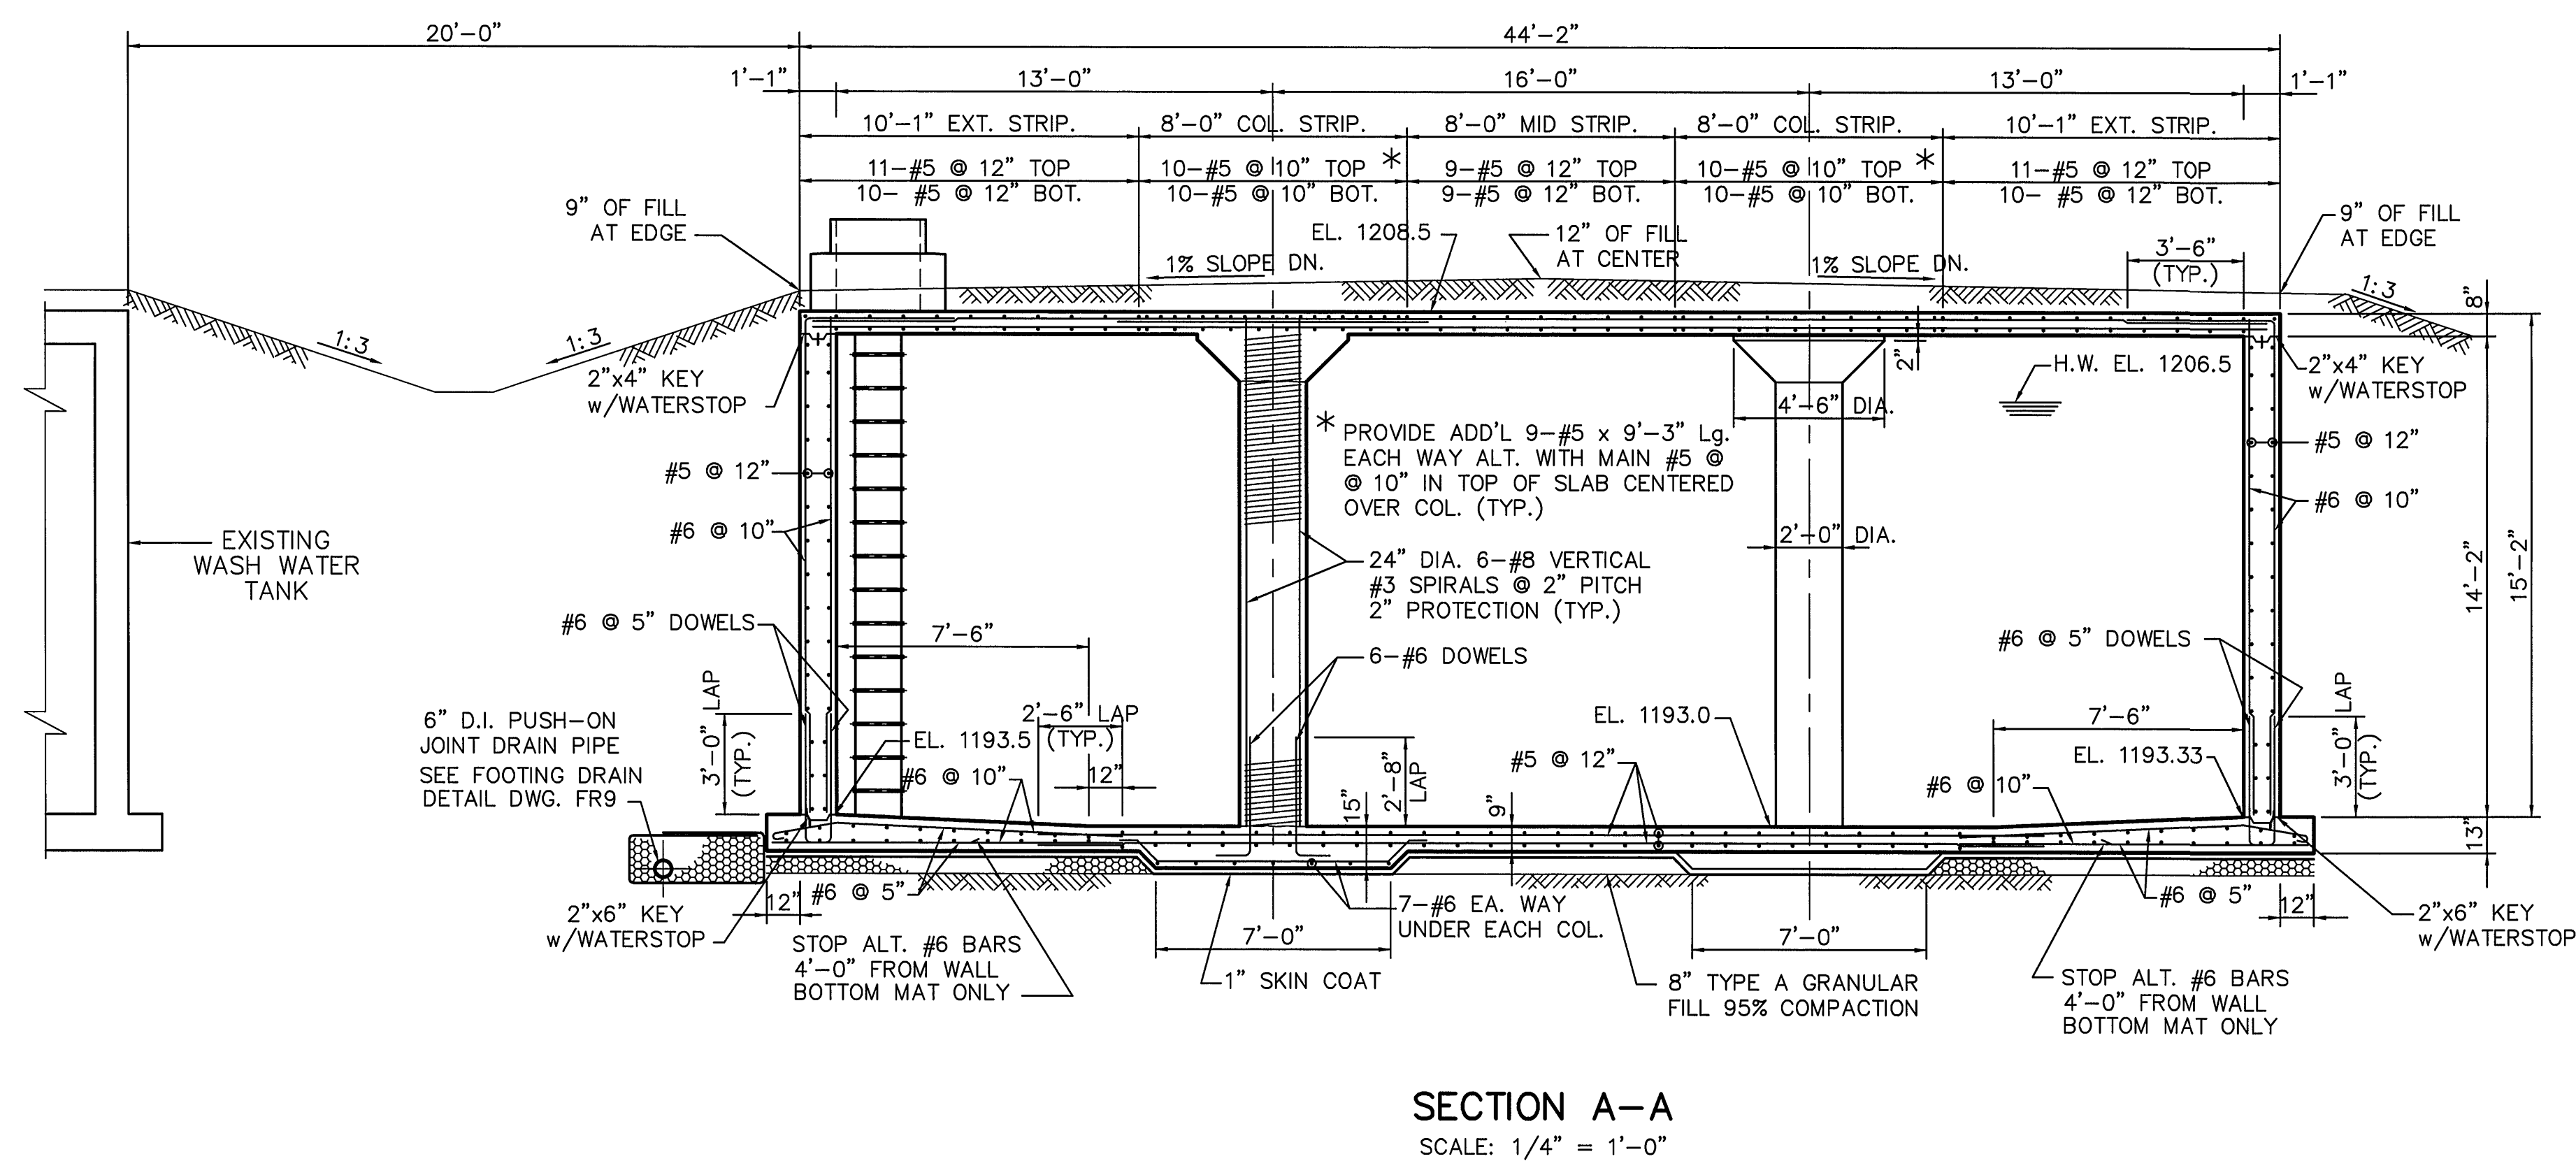
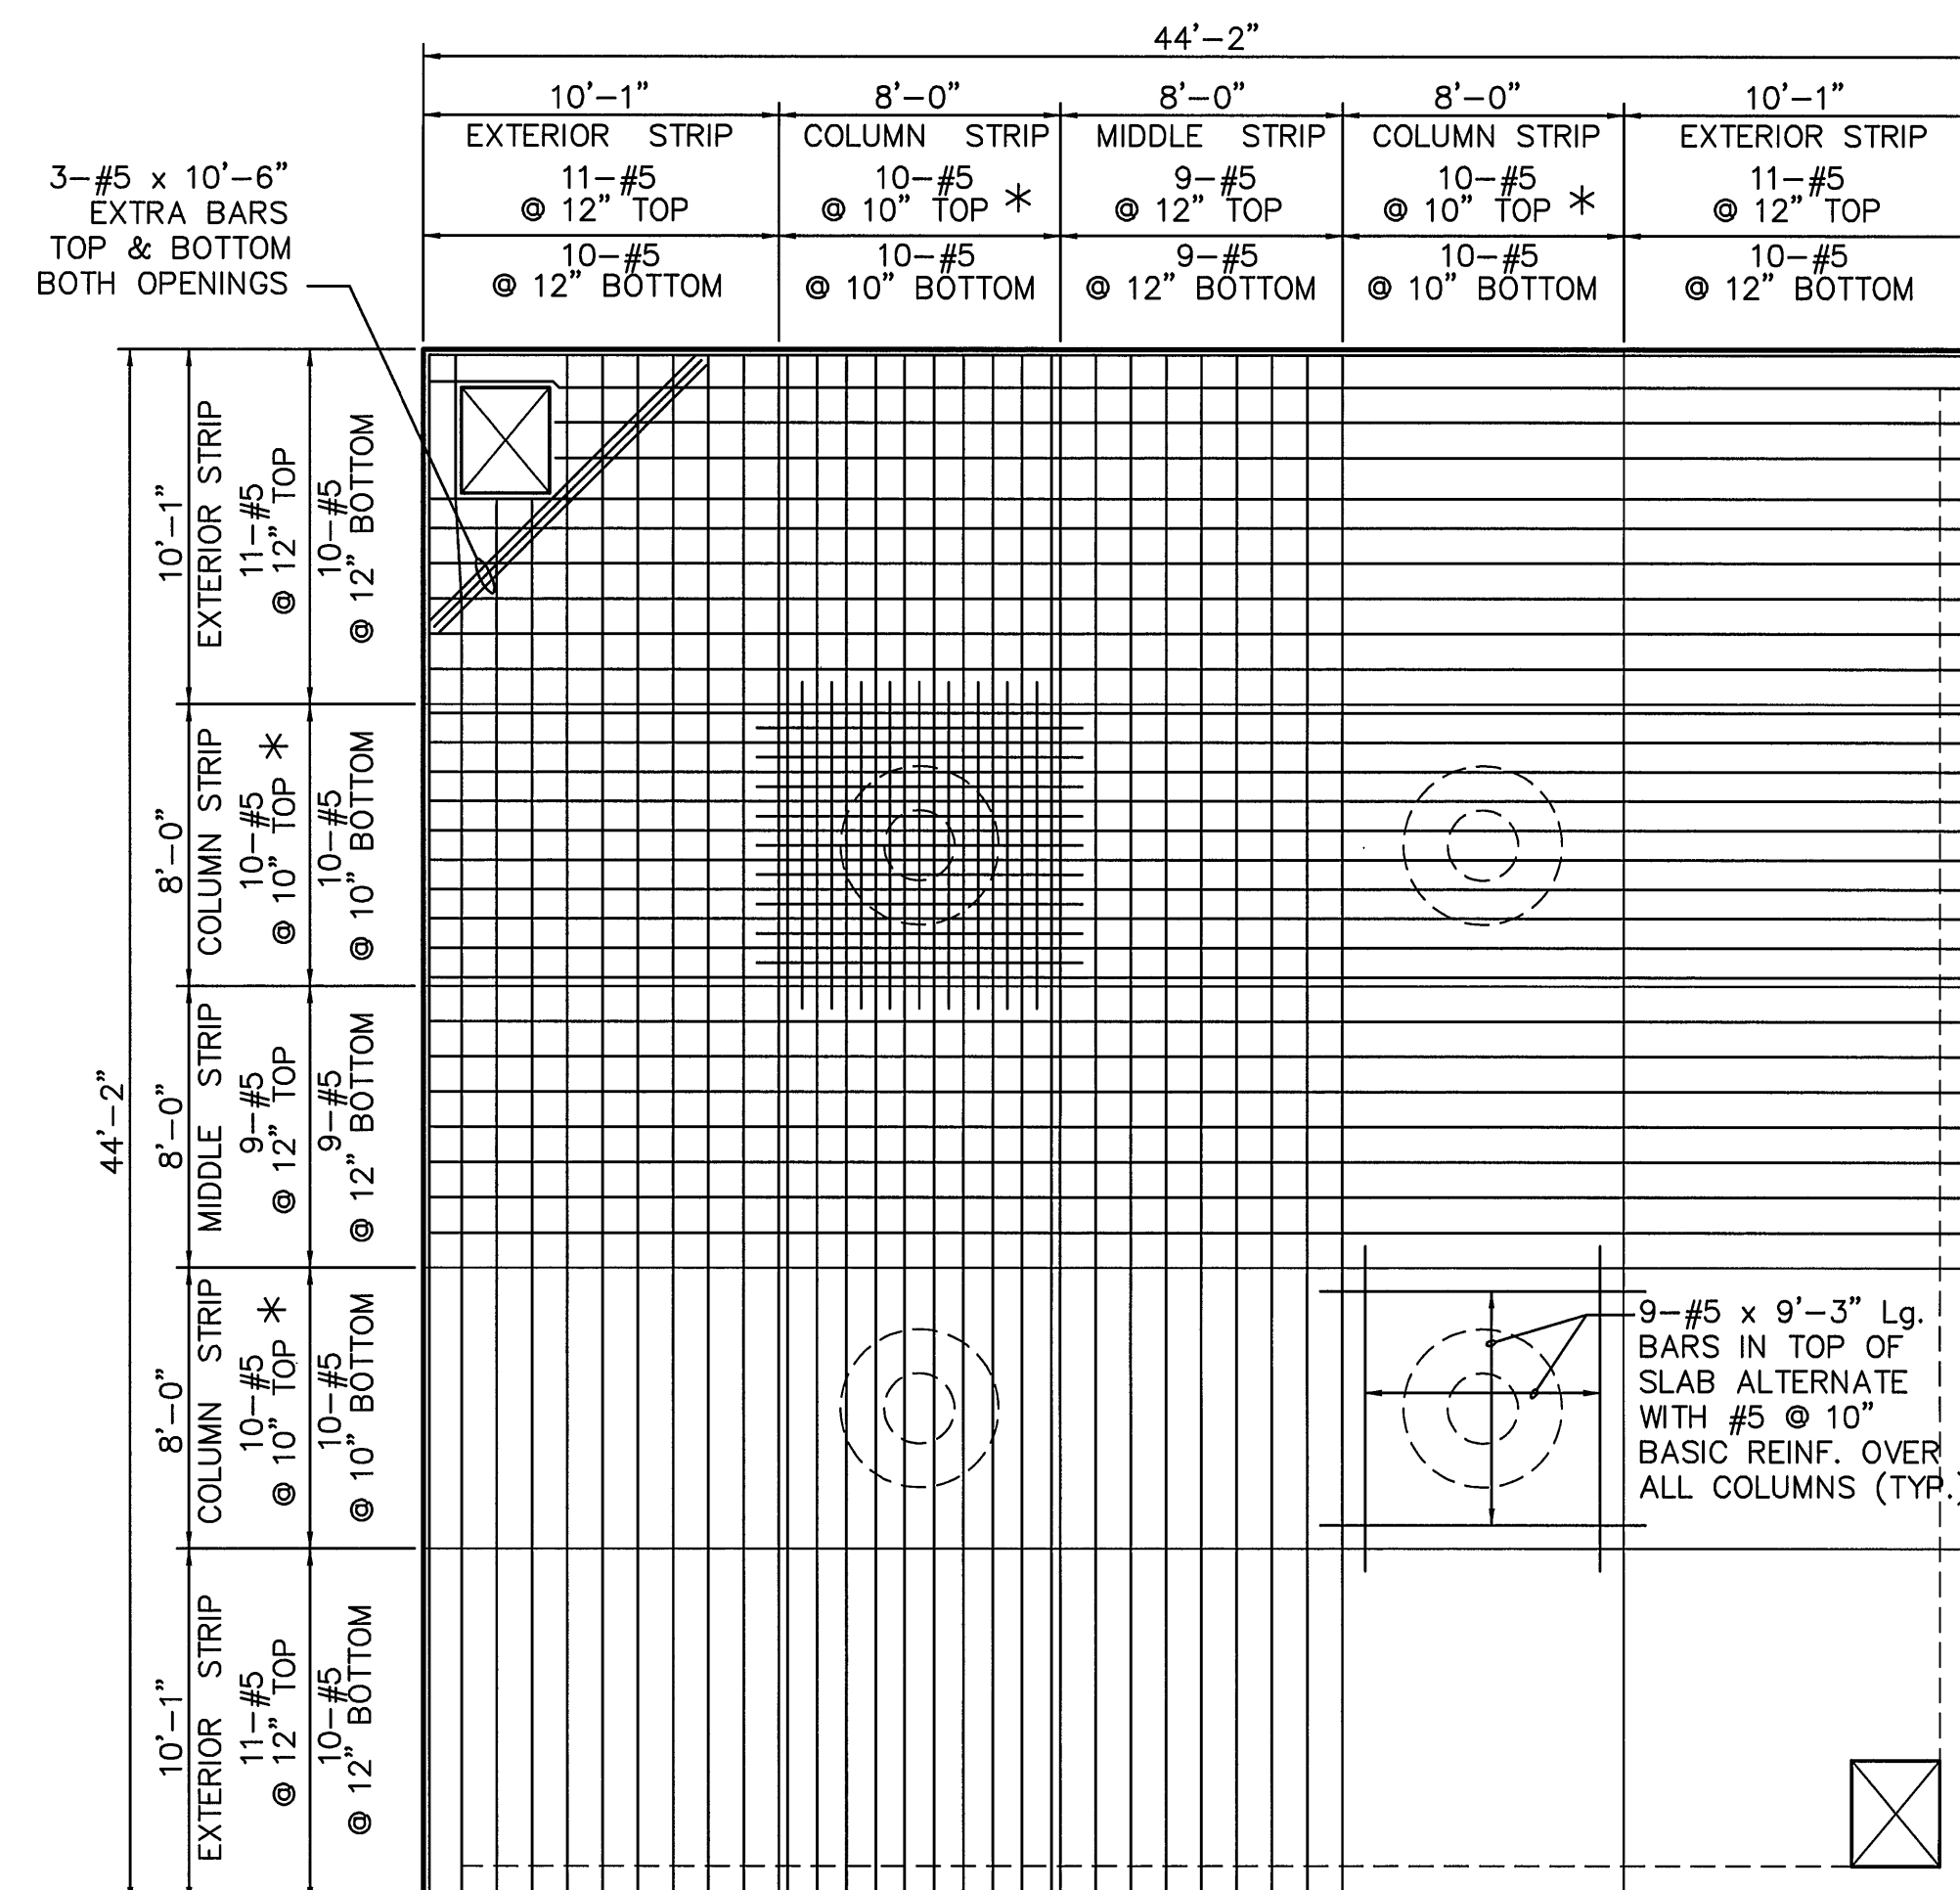
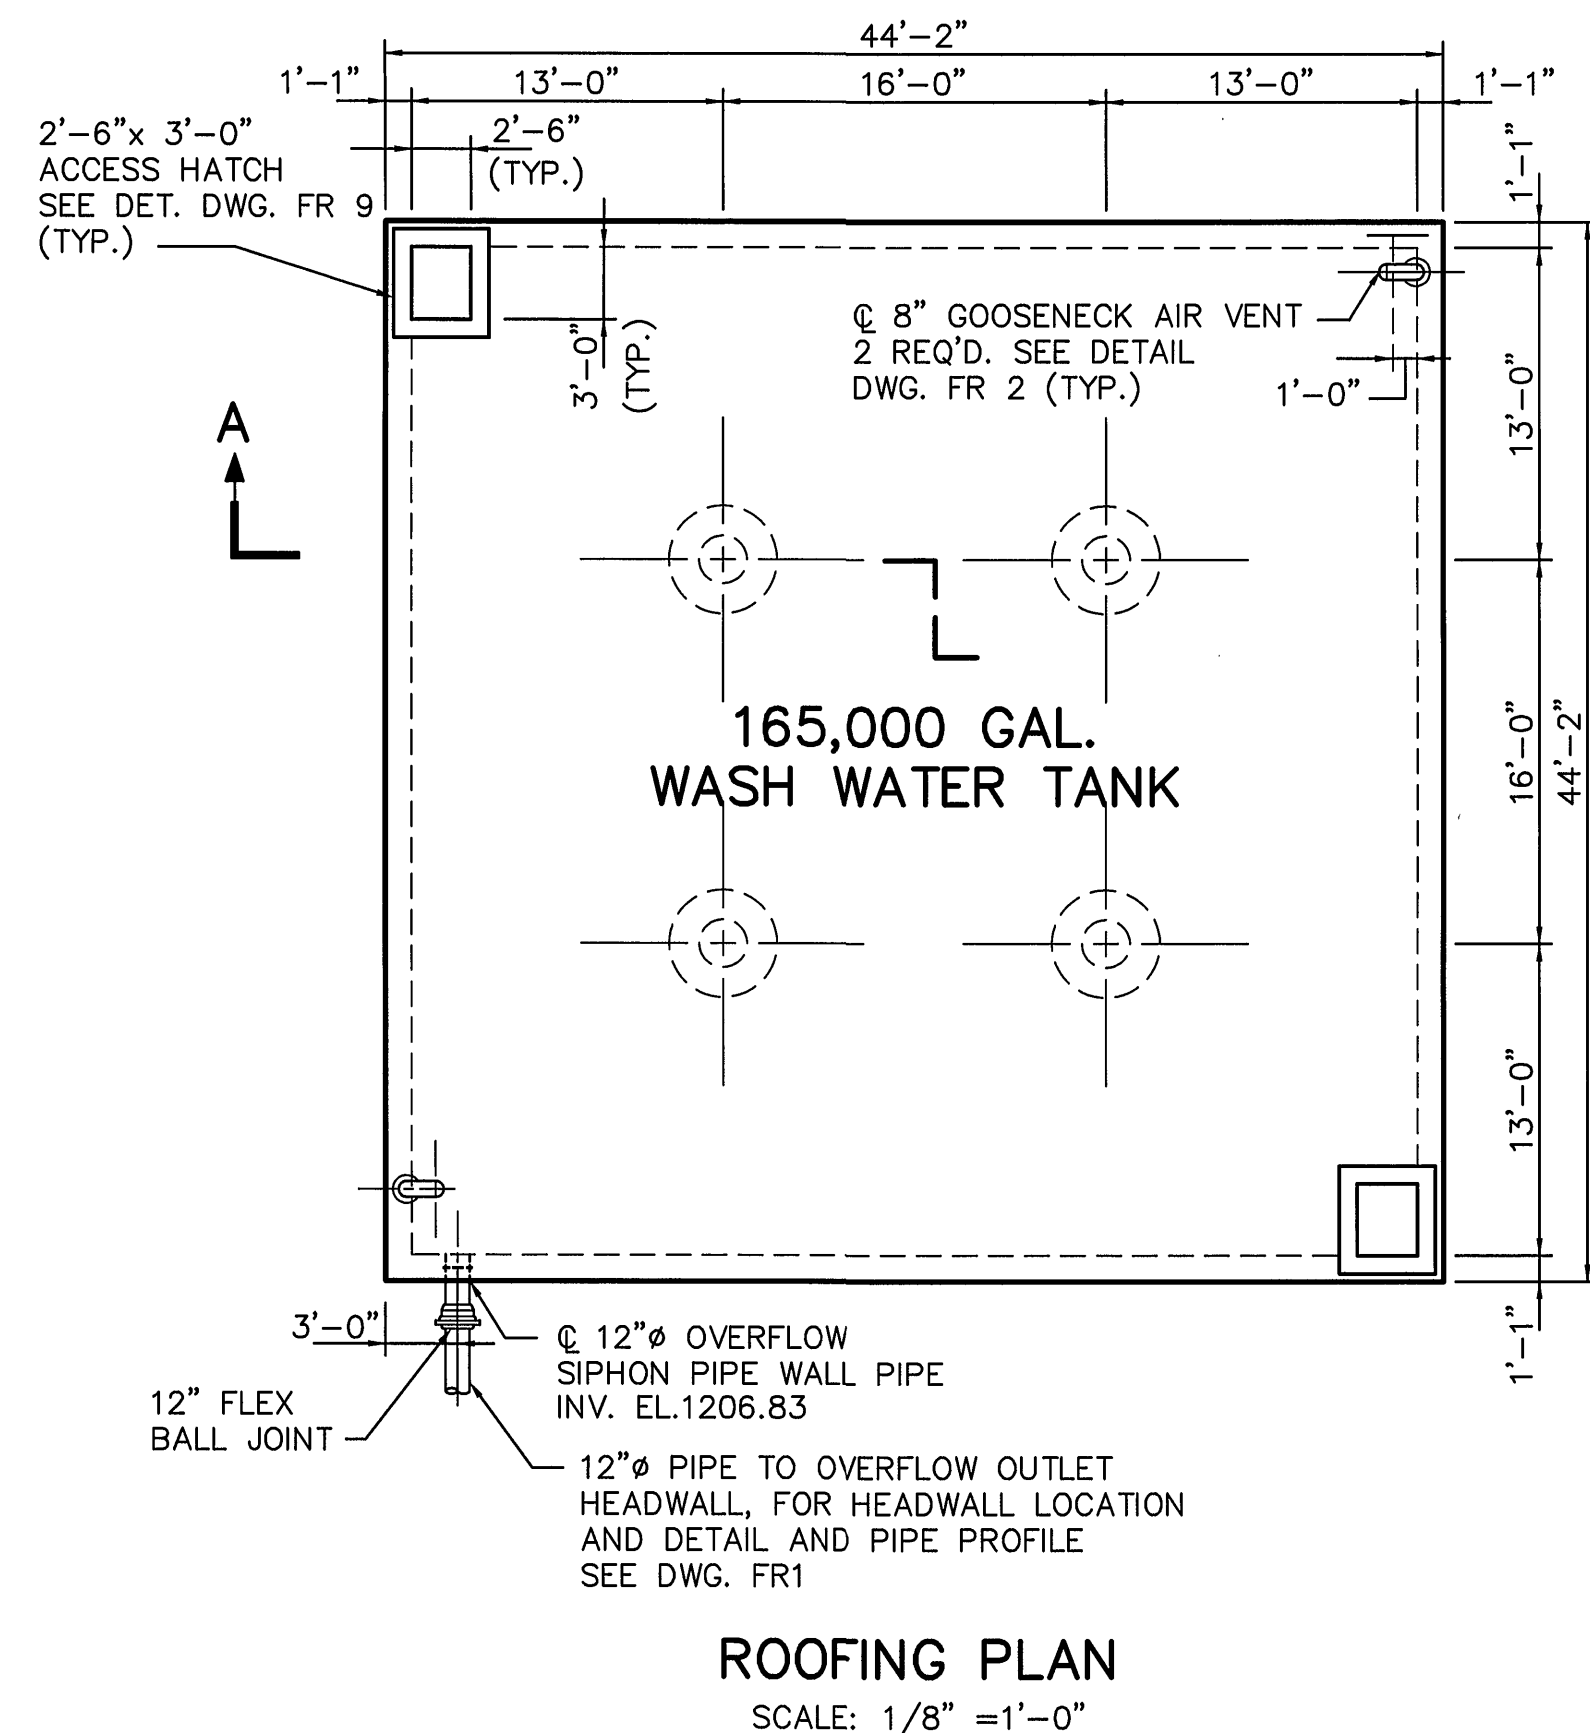


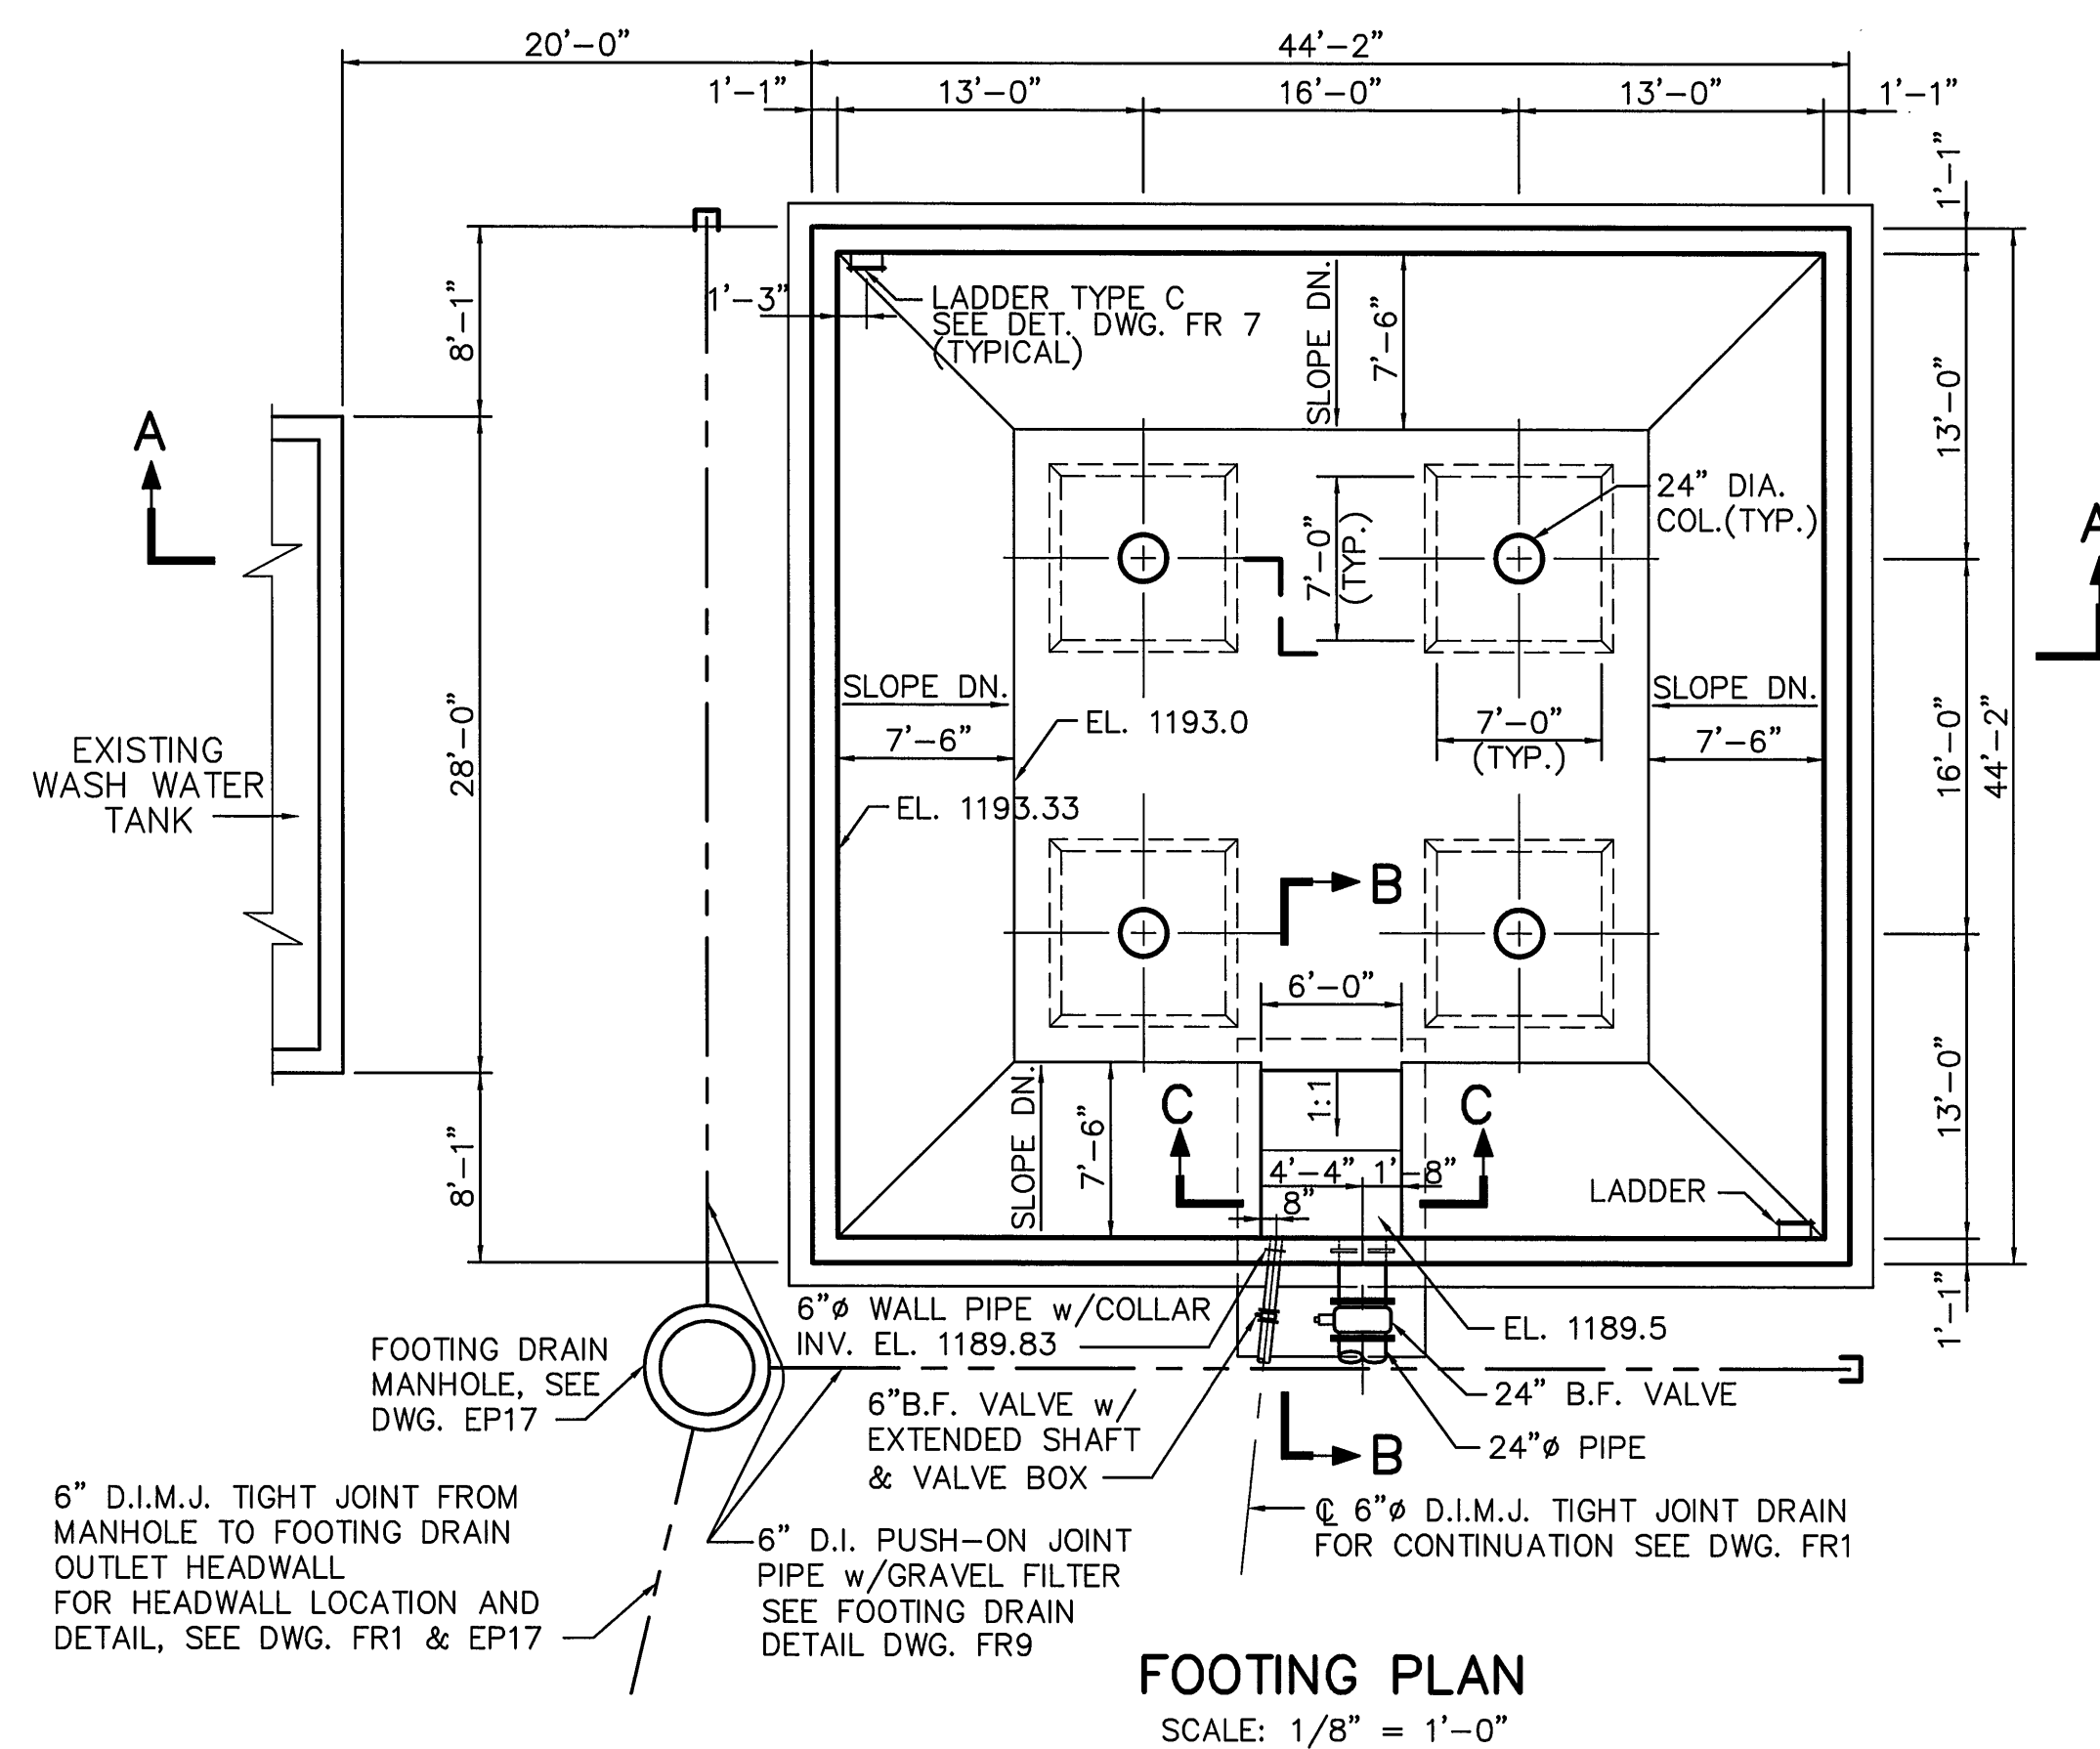

- GENERAL NOTES:
1. FOR GENERAL DETAILS SEE DWG. FR9.
 2. FOR LOCATION PLAN SEE DWG. EP1.

DRAWING OF RECORD
DATE: SEP 30 1997

MATTERN & CRAIG CONSULTING ENGINEERS • SURVEYORS ROANOKE VIRGINIA	DESIGNED: S.C.P.			REV.	DATE	DESCRIPTION	BY	APP.	CARVINS COVE FILTER PLANT IMPROVEMENTS – PHASE I	DATE		
	DRAWN: C.T.M.											APRIL 1992
	CHECKED: Y.T.L.											COMM. NO.
ALVORD, BURDICK & HOWSON										9130		
ENGINEERS CHICAGO									WASHWATER TANK—PLANS & SECTIONS	SHEET		
										FR8		