




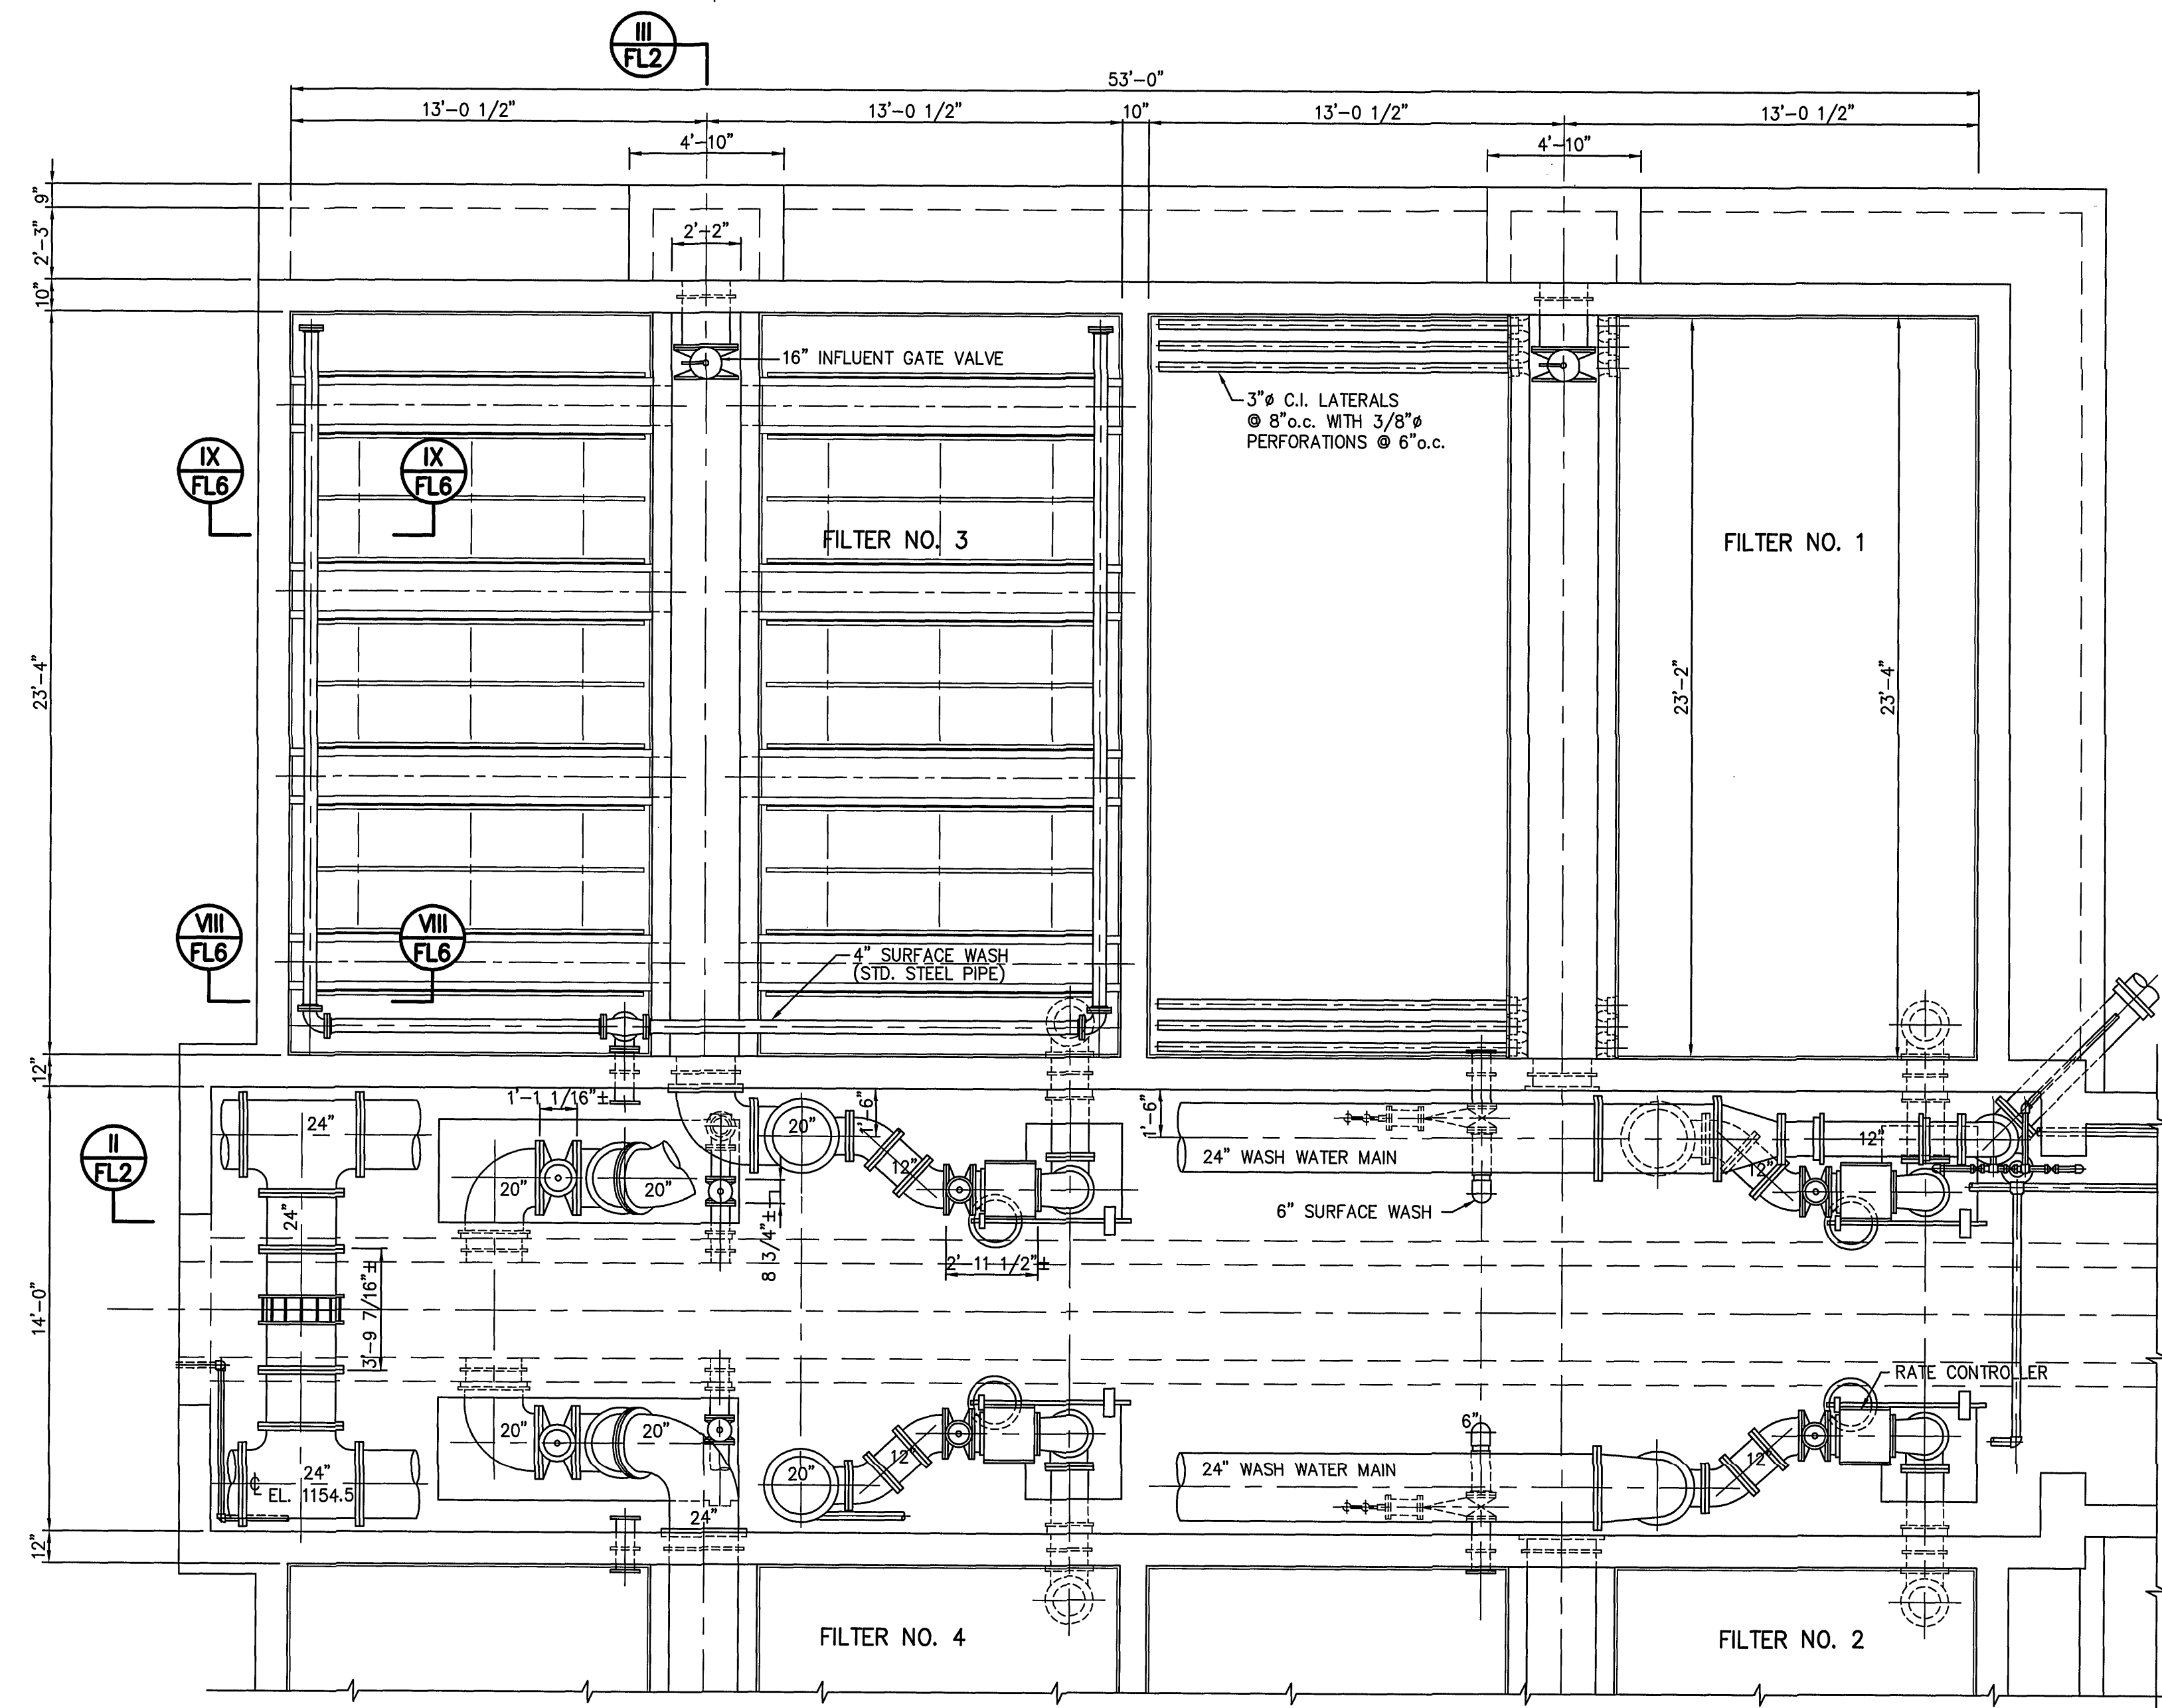


PLAN
SCALE: 1/4" = 1'-0"

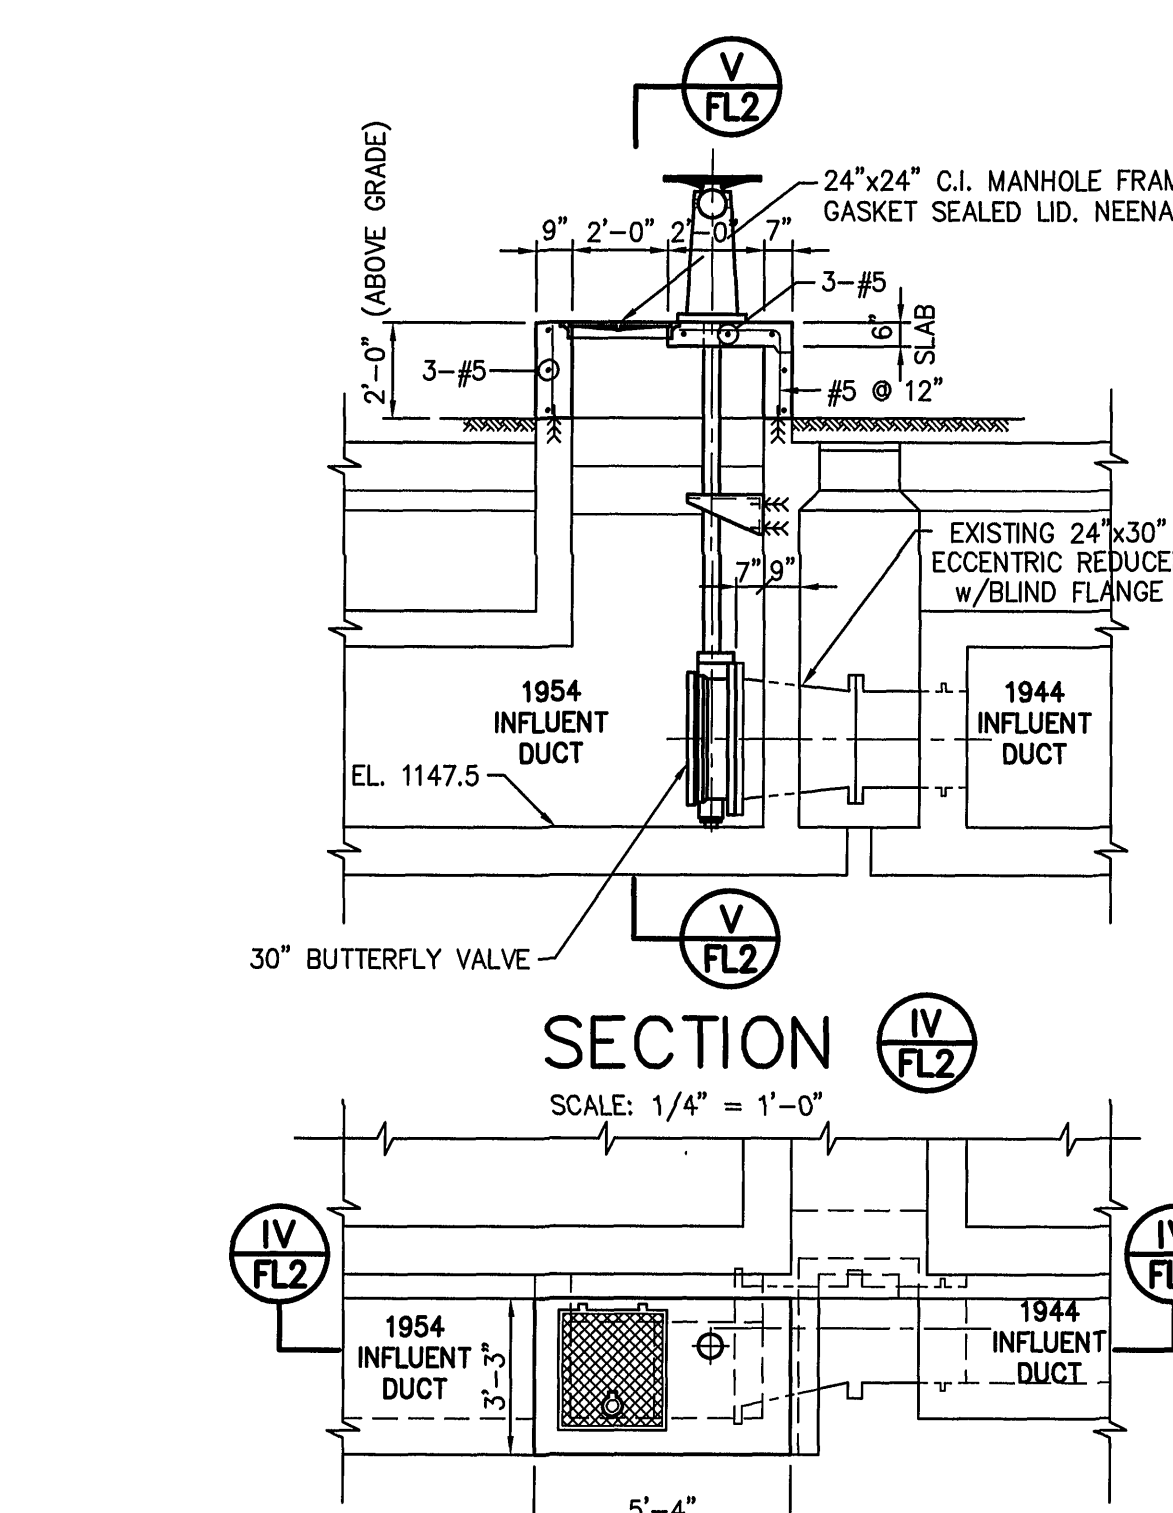


DETAIL A
SCALE: 1/4" = 1'-0"

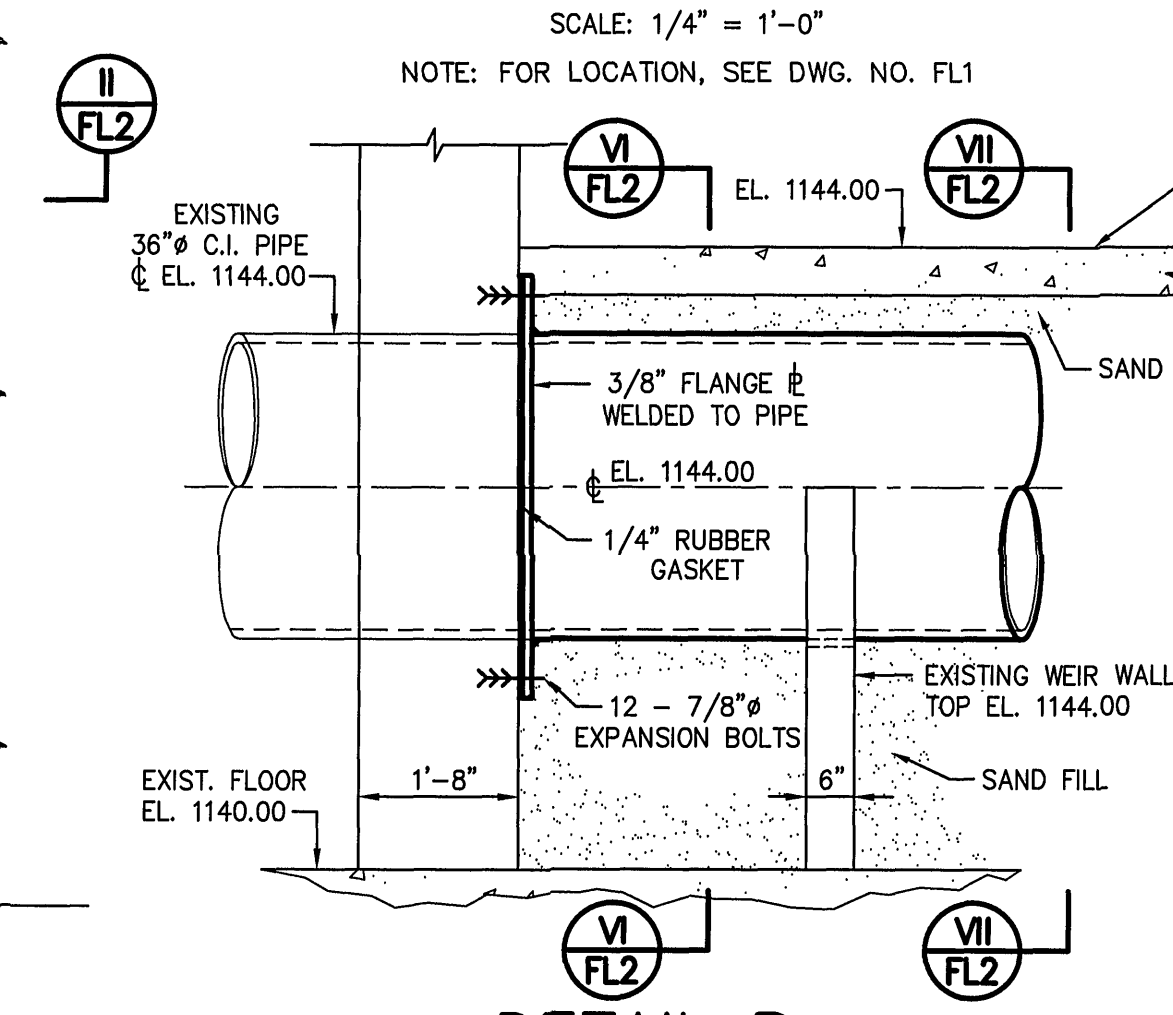


DETAIL B
SCALE: 1/2" = 1'-0"

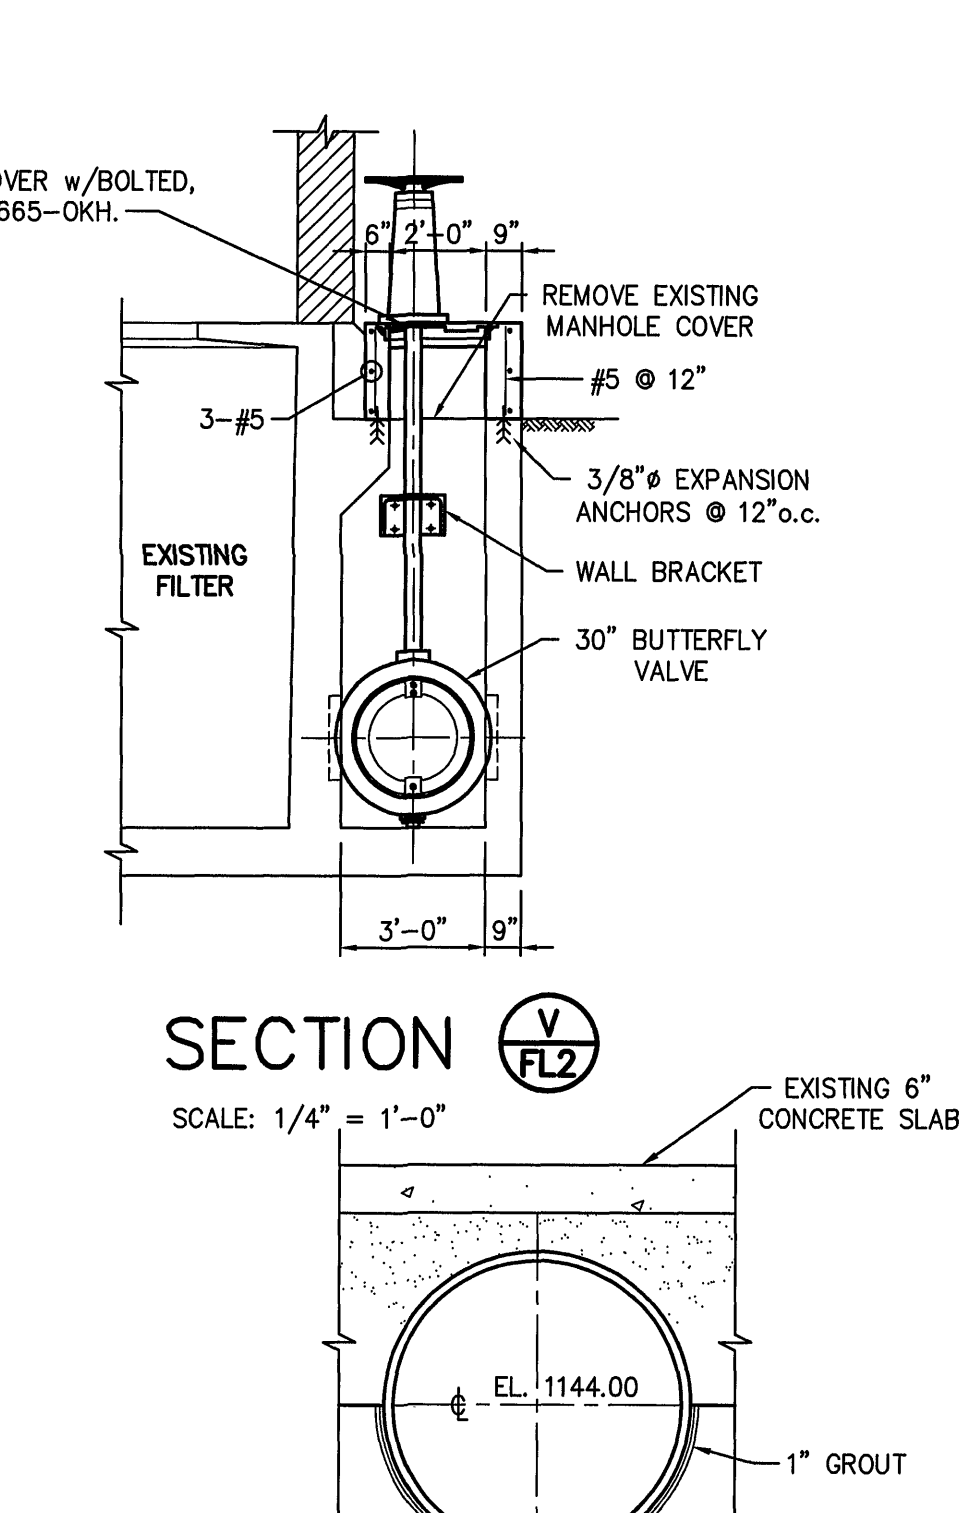


SECTION V FL2
SCALE: 1/4" = 1'-0"

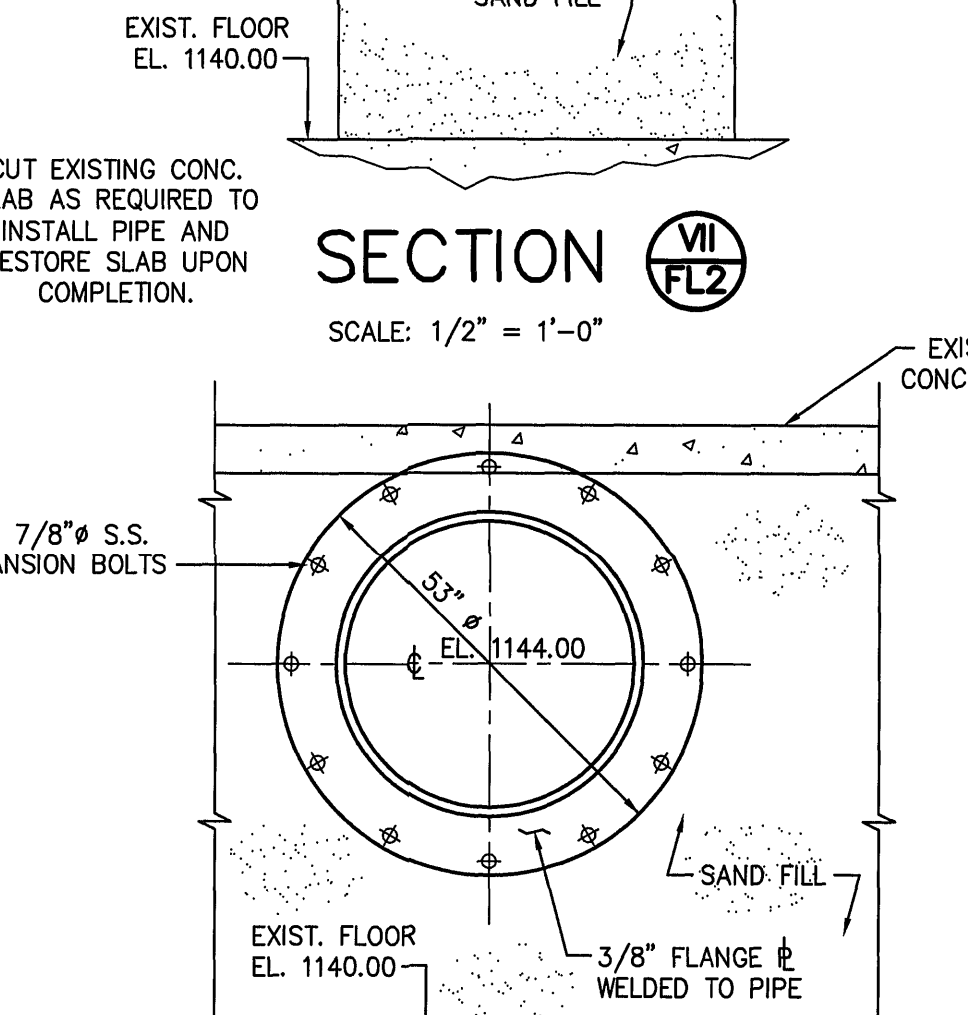


SECTION VI FL2
SCALE: 1/2" = 1'-0"

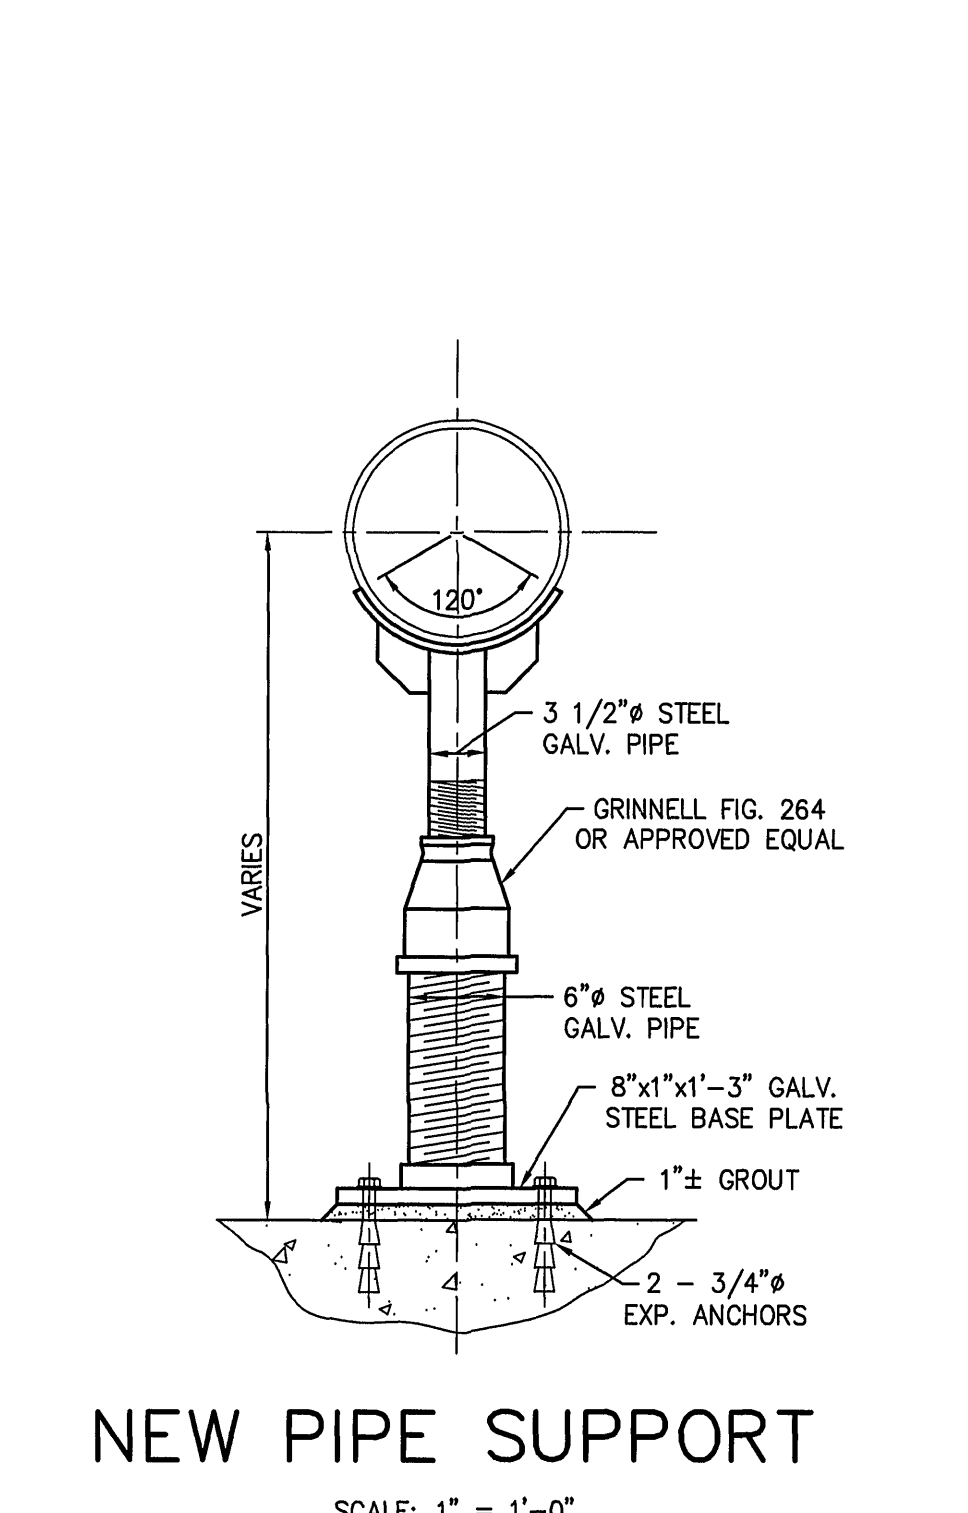


NEW PIPE SUPPORT
SCALE: 1" = 1'-0"

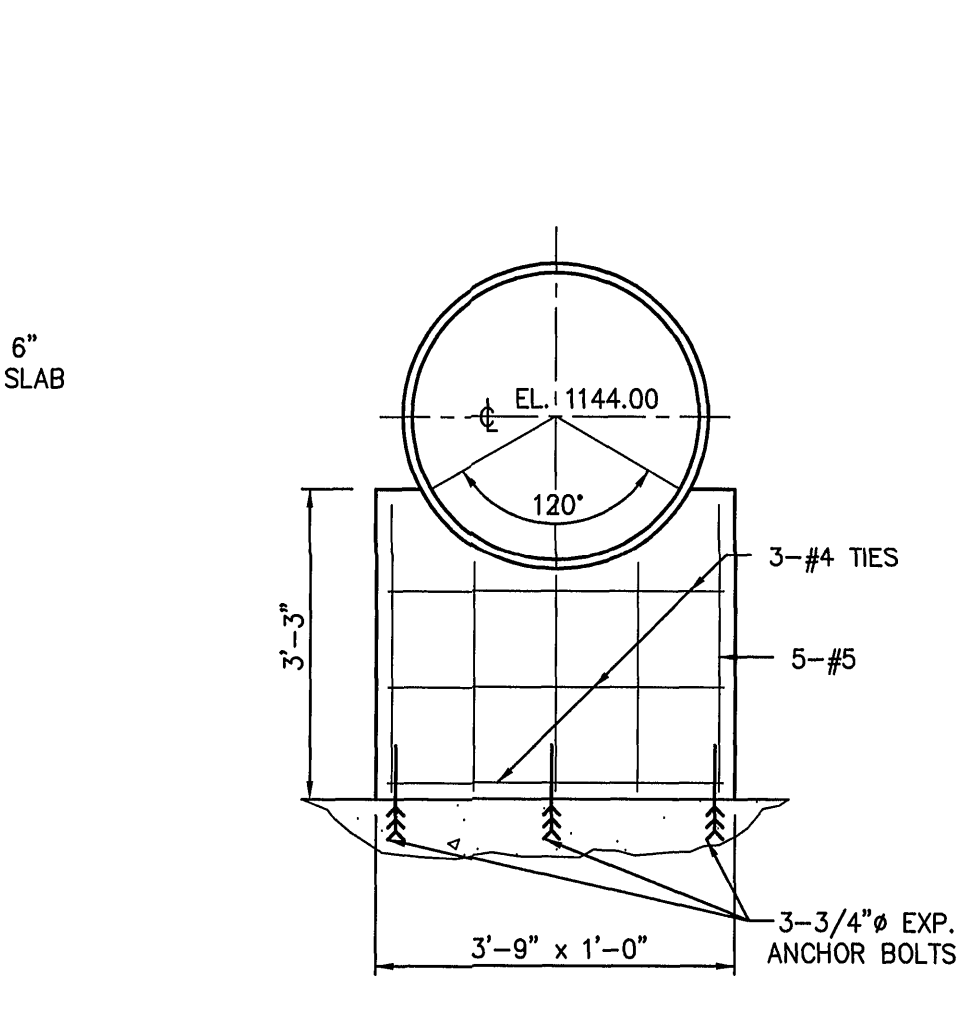


DETAIL C
SCALE: 1/2" = 1'-0"

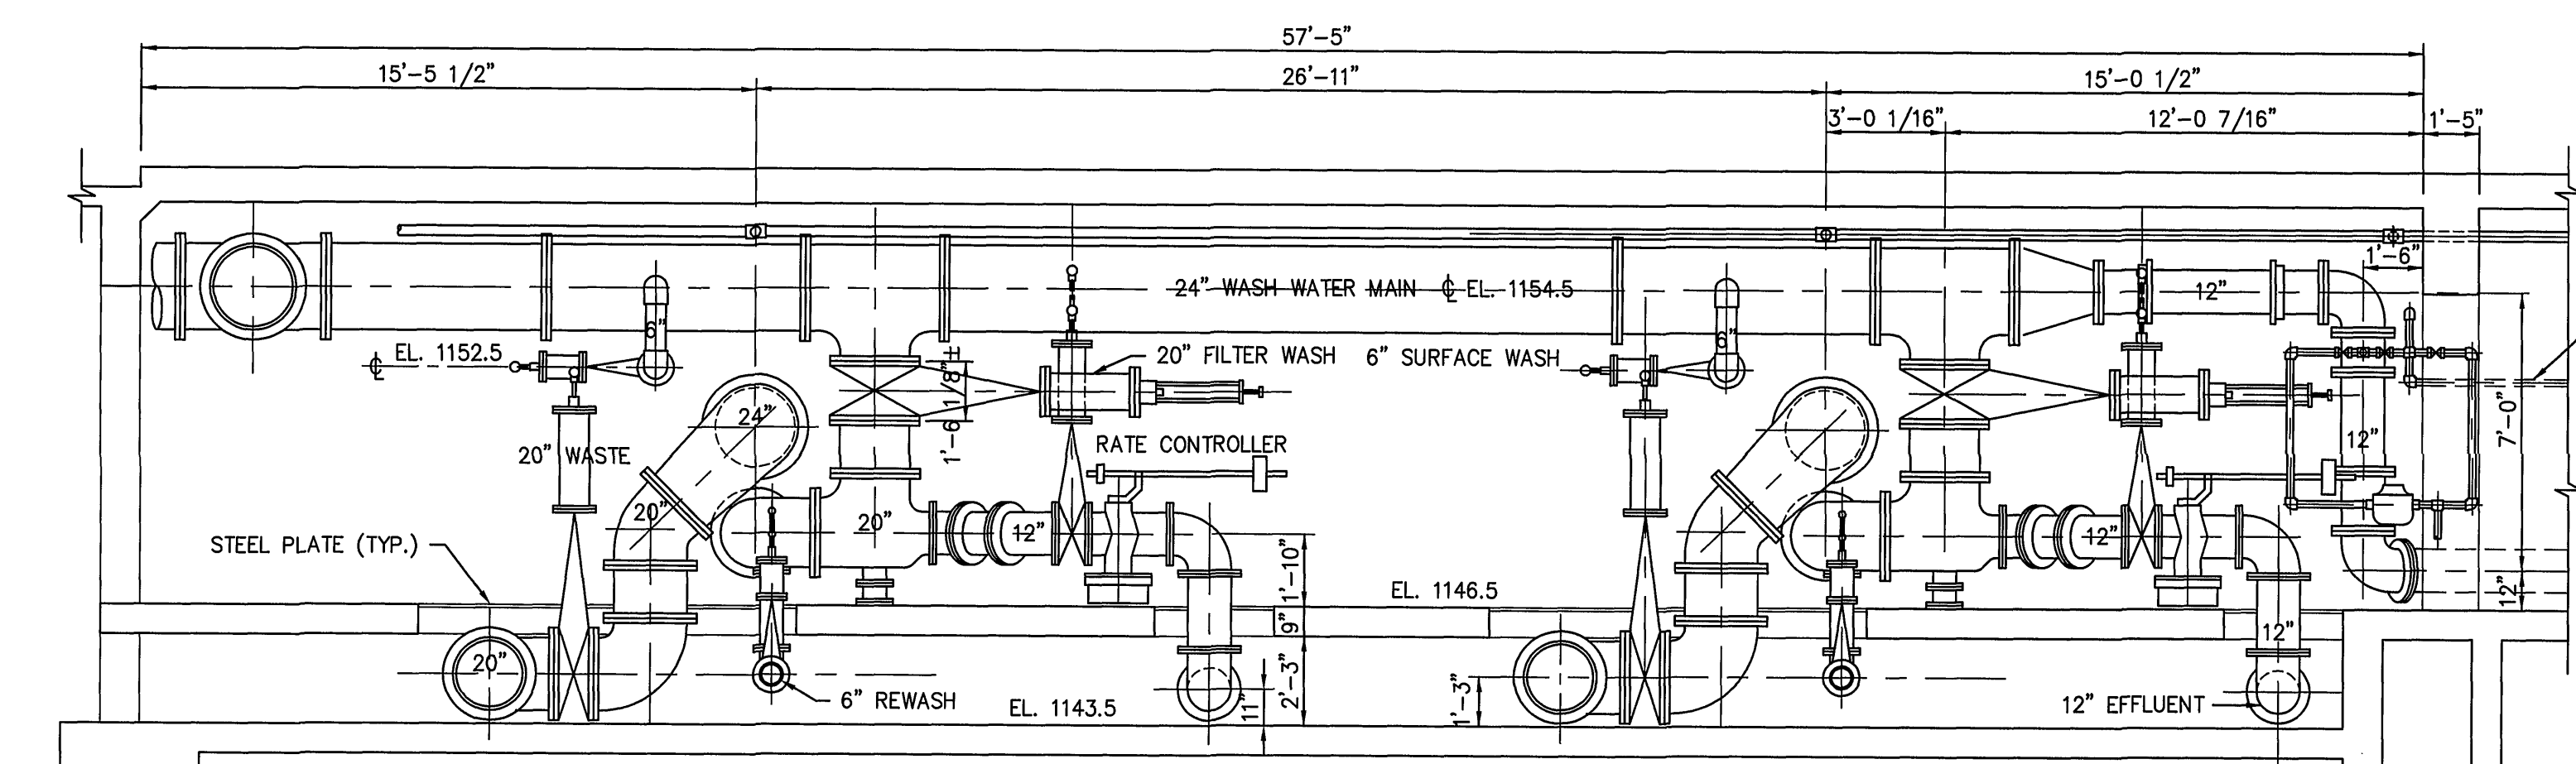

SECTION II FL2
SCALE: 1/4" = 1'-0"

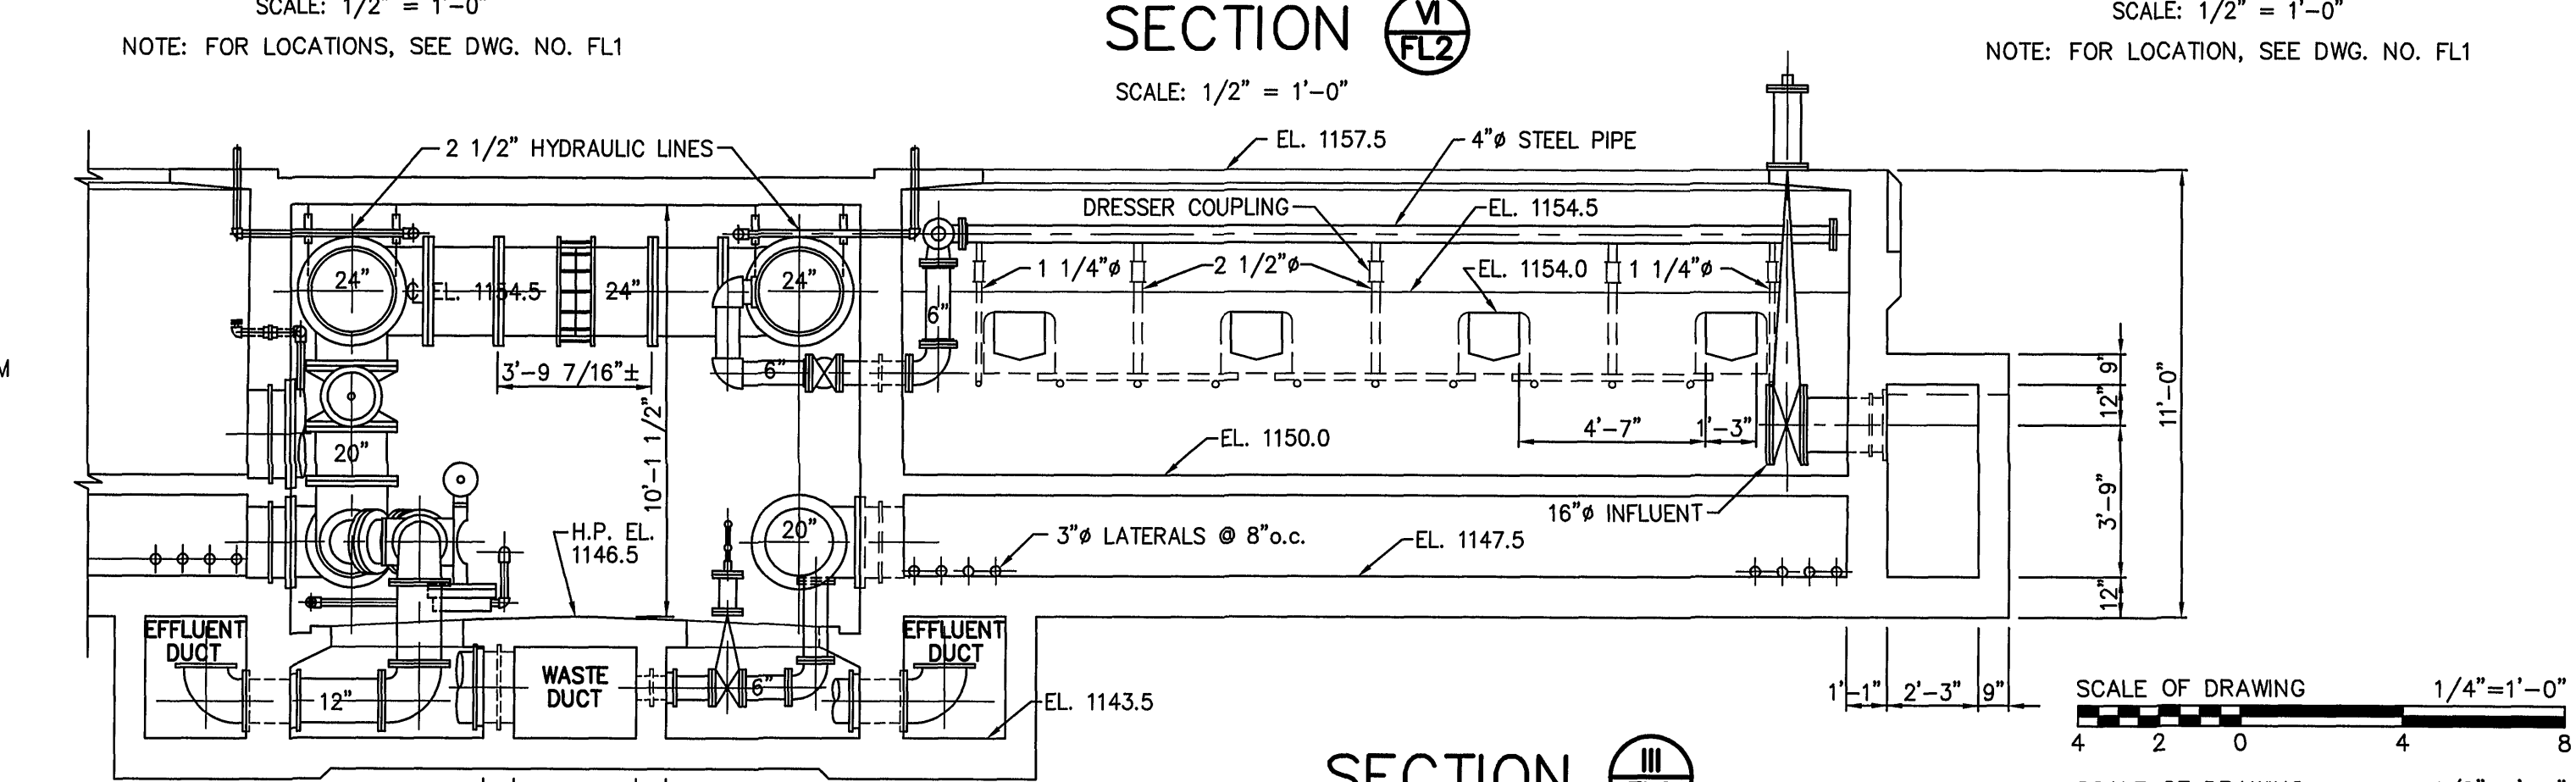

SECTION III FL2
SCALE: 1/4" = 1'-0"

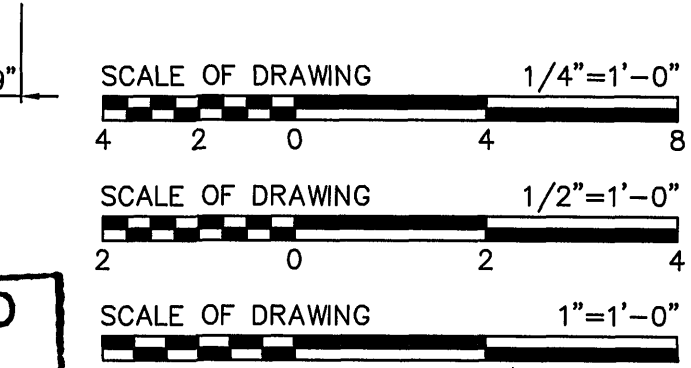

DRAWING OF RECORD
DATE: SEP 30 1997


MATTERN & CRAIG
CONSULTING ENGINEERS • SURVEYORS
ROANOKE VIRGINIA

ALVORD, BURDICK & HOWSON
ENGINEERS CHICAGO

DESIGNED: R.S.T.C.
W.G.N.

DRAWN: L.M.J.

CHECKED: Y.T.L.

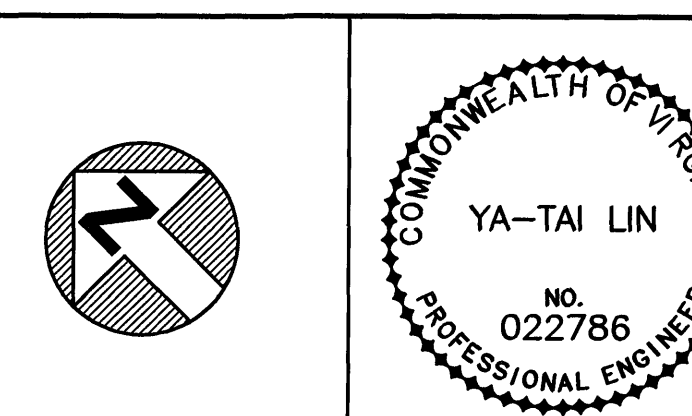

REV.	DATE	DESCRIPTION	BY	APP.

CARVINS COVE FILTER PLANT IMPROVEMENTS – PHASE I
ROANOKE, VIRGINIA

EXISTING 1944 FILTER PIPING AND VALVES

DATE: APRIL 1992
COMM. NO. 9130
SHEET FL2