




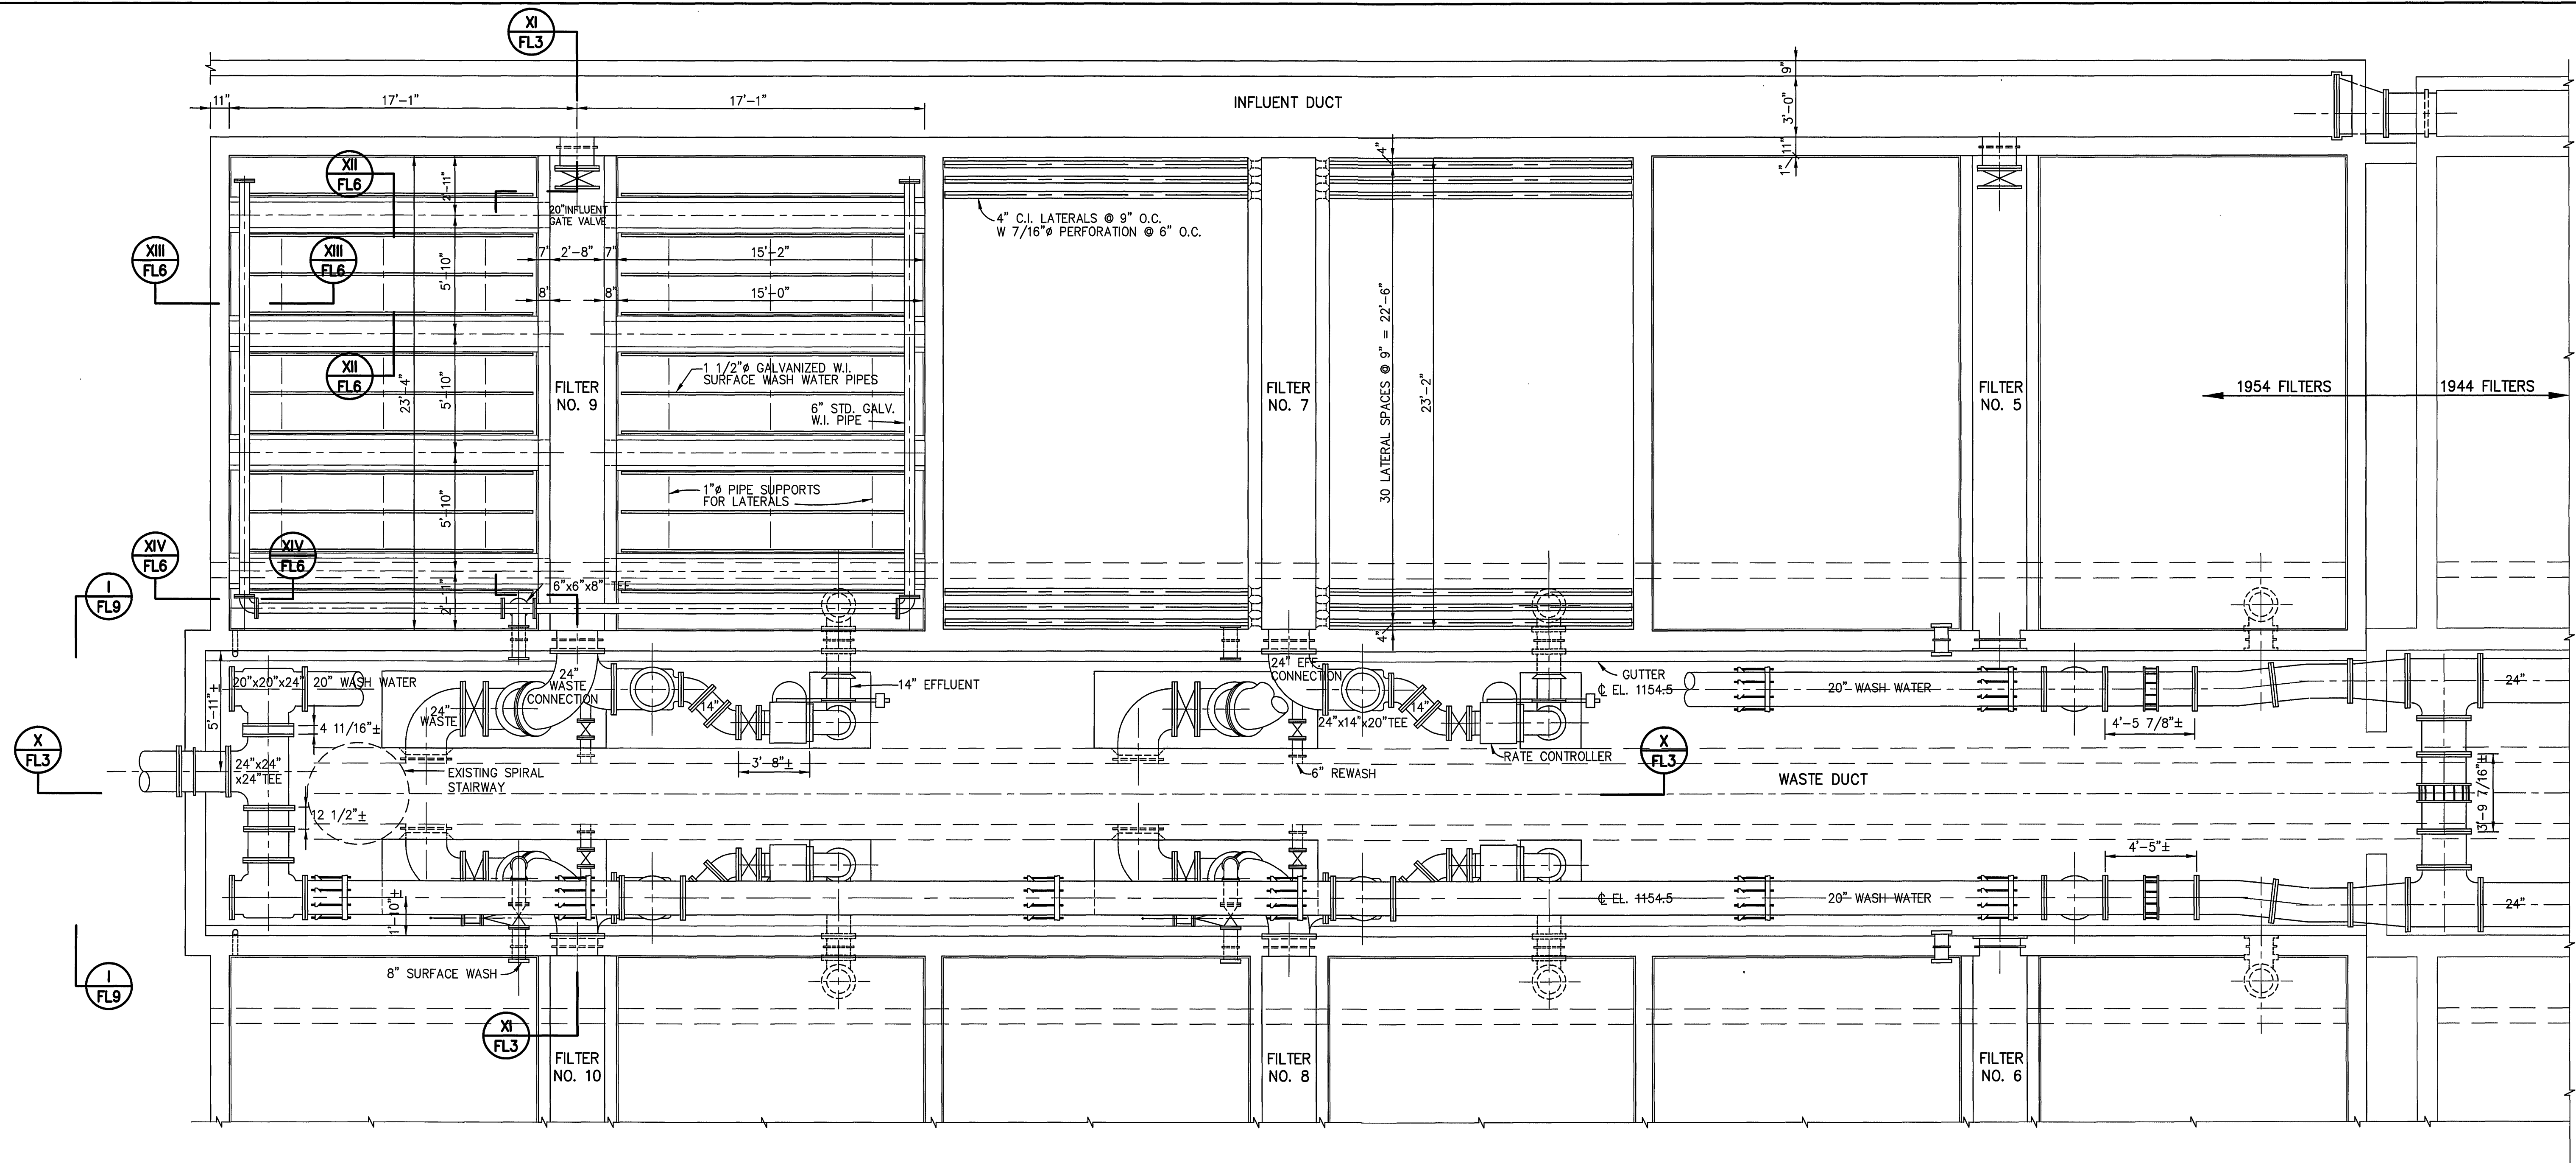

PLAN
SCALE: 1/4" = 1'

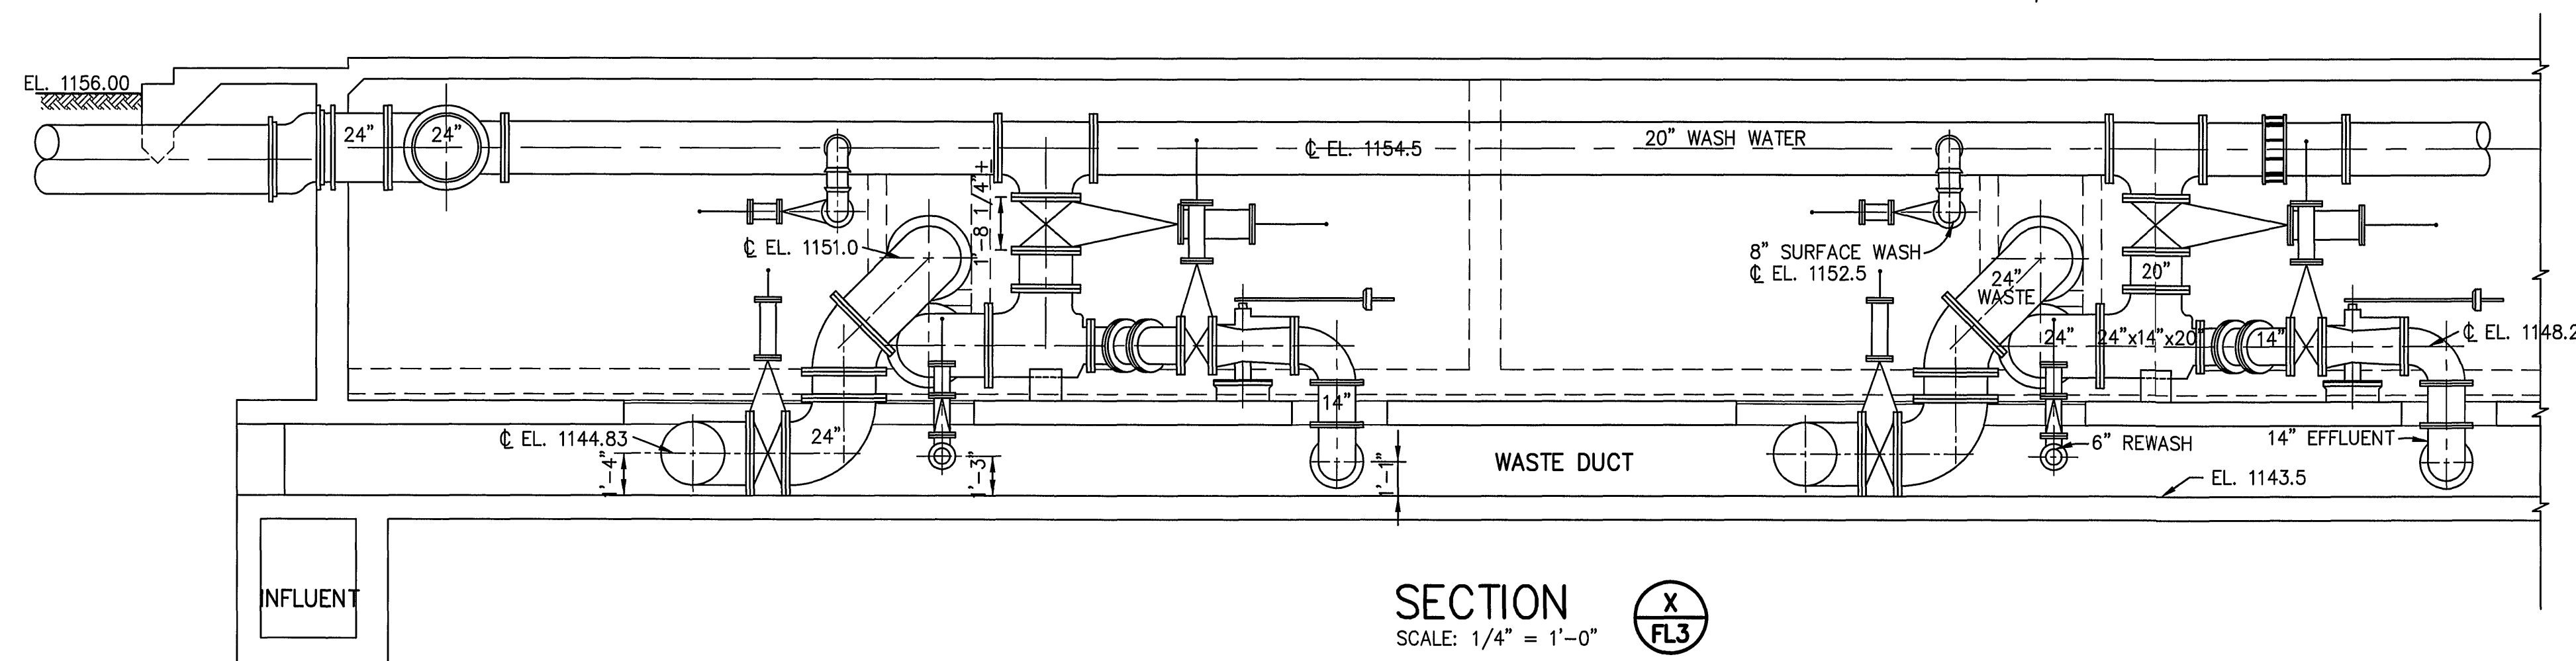


SECTION X-X
SCALE: 1/4" = 1'-0"

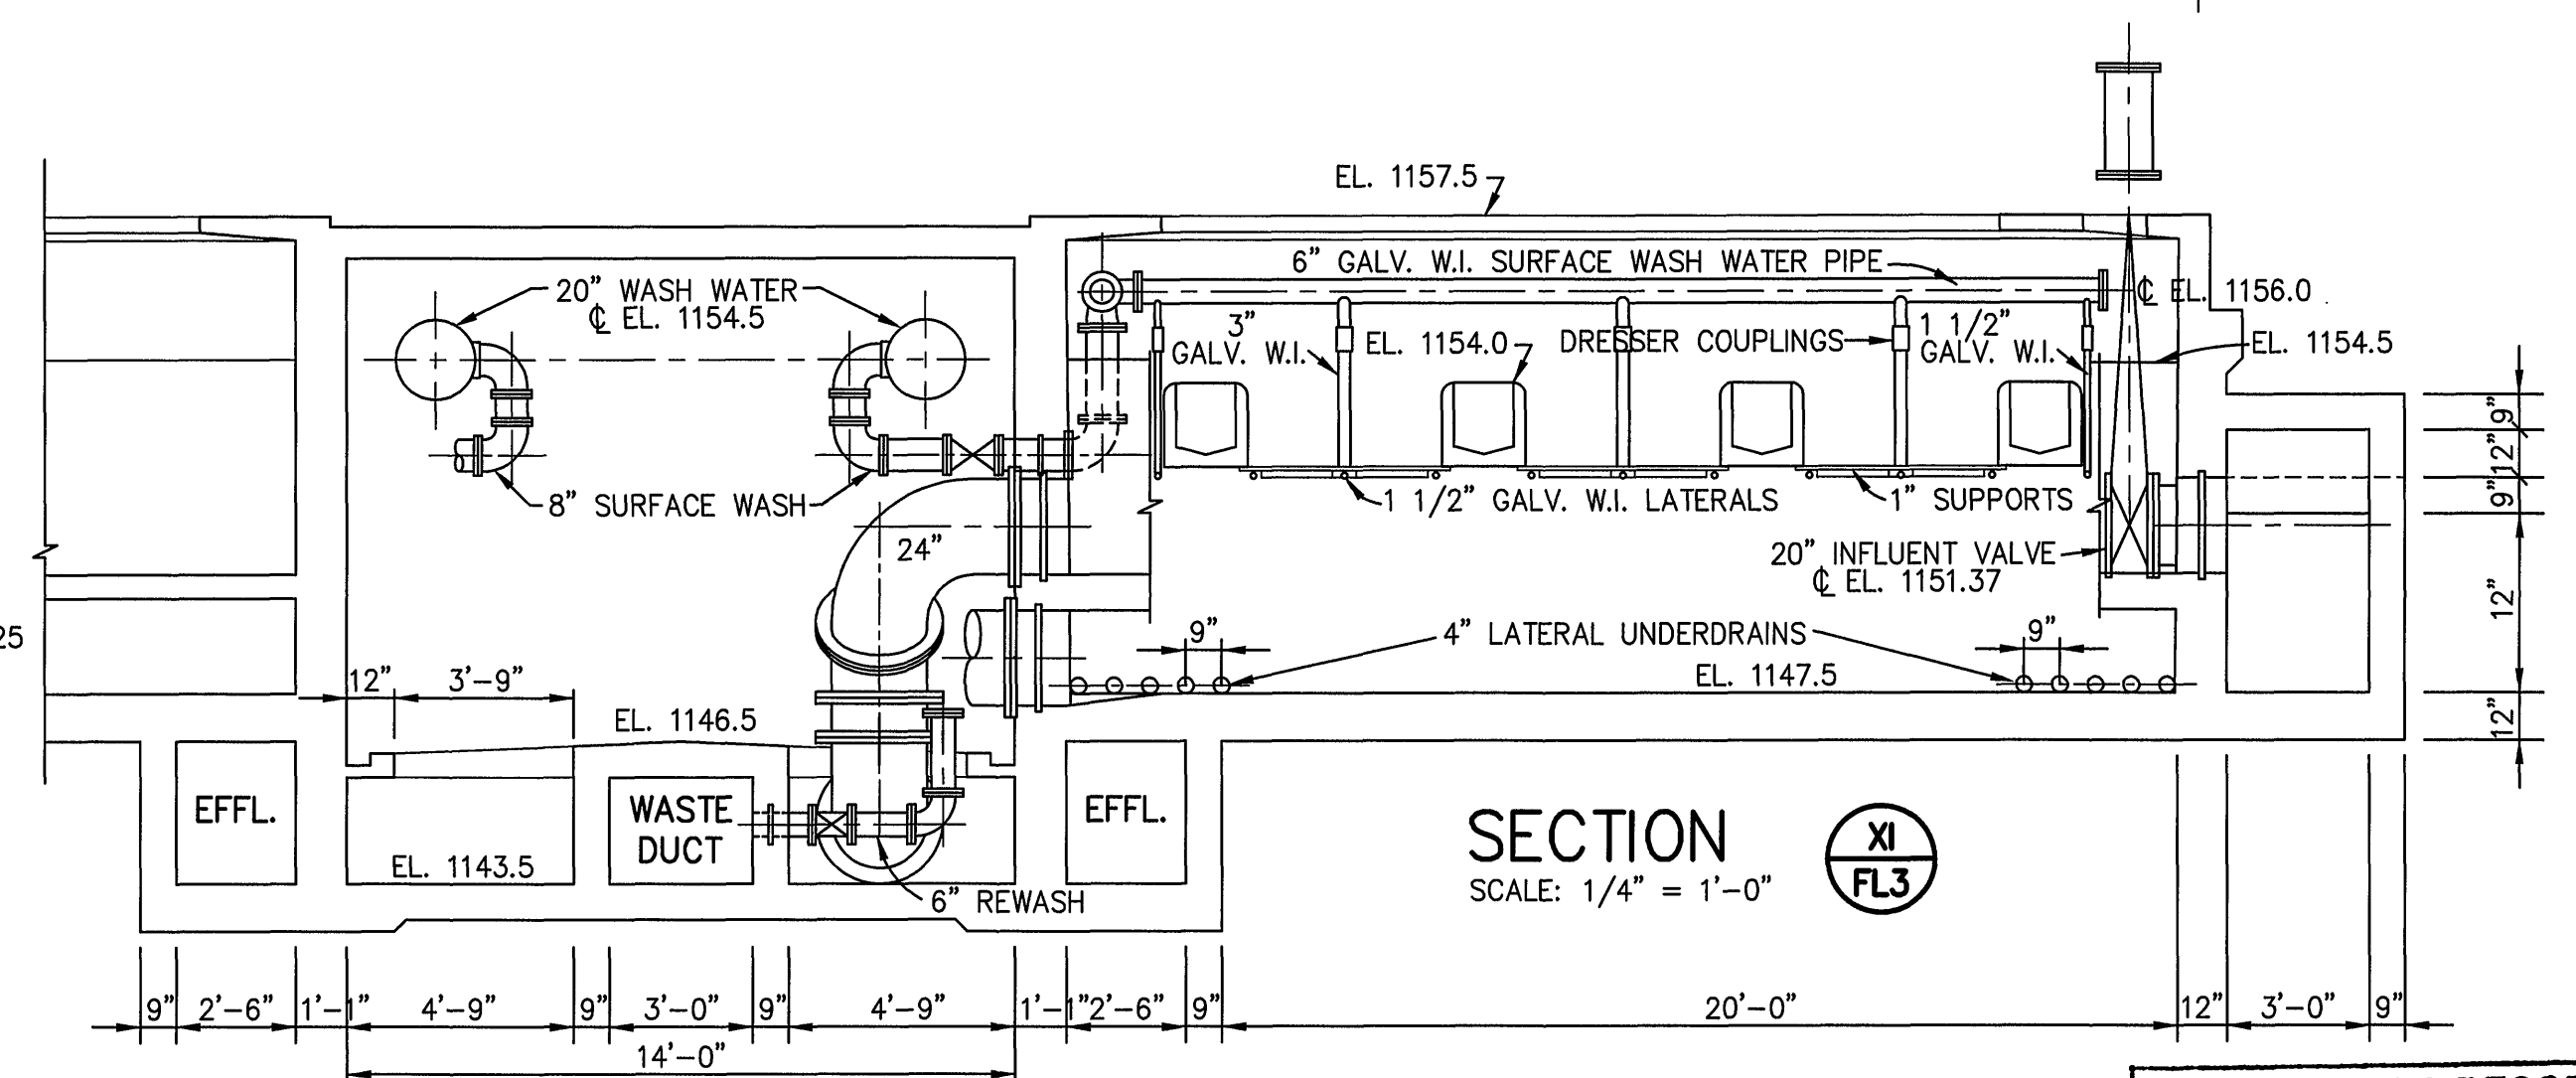

SECTION XI-XI
SCALE: 1/4" = 1'-0"

DRAWING OF RECORD
DATE: SEP 30 1997

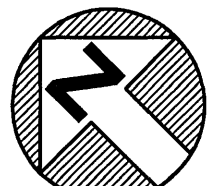MATTERN & CRAIG CONSULTING ENGINEERS • SURVEYORS ROANOKE VIRGINIA	DESIGNED: R.S.T.C. W.G.N.			REV.	DATE	DESCRIPTION	BY	APP.	CARVINS COVE FILTER PLANT IMPROVEMENTS – PHASE I ROANOKE, VIRGINIA	DATE APRIL 1992
	DRAWN: D.Y.									
ALVORD, BURDICK & HOWSON ENGINEERS CHICAGO	CHECKED: Y.T.L.									