



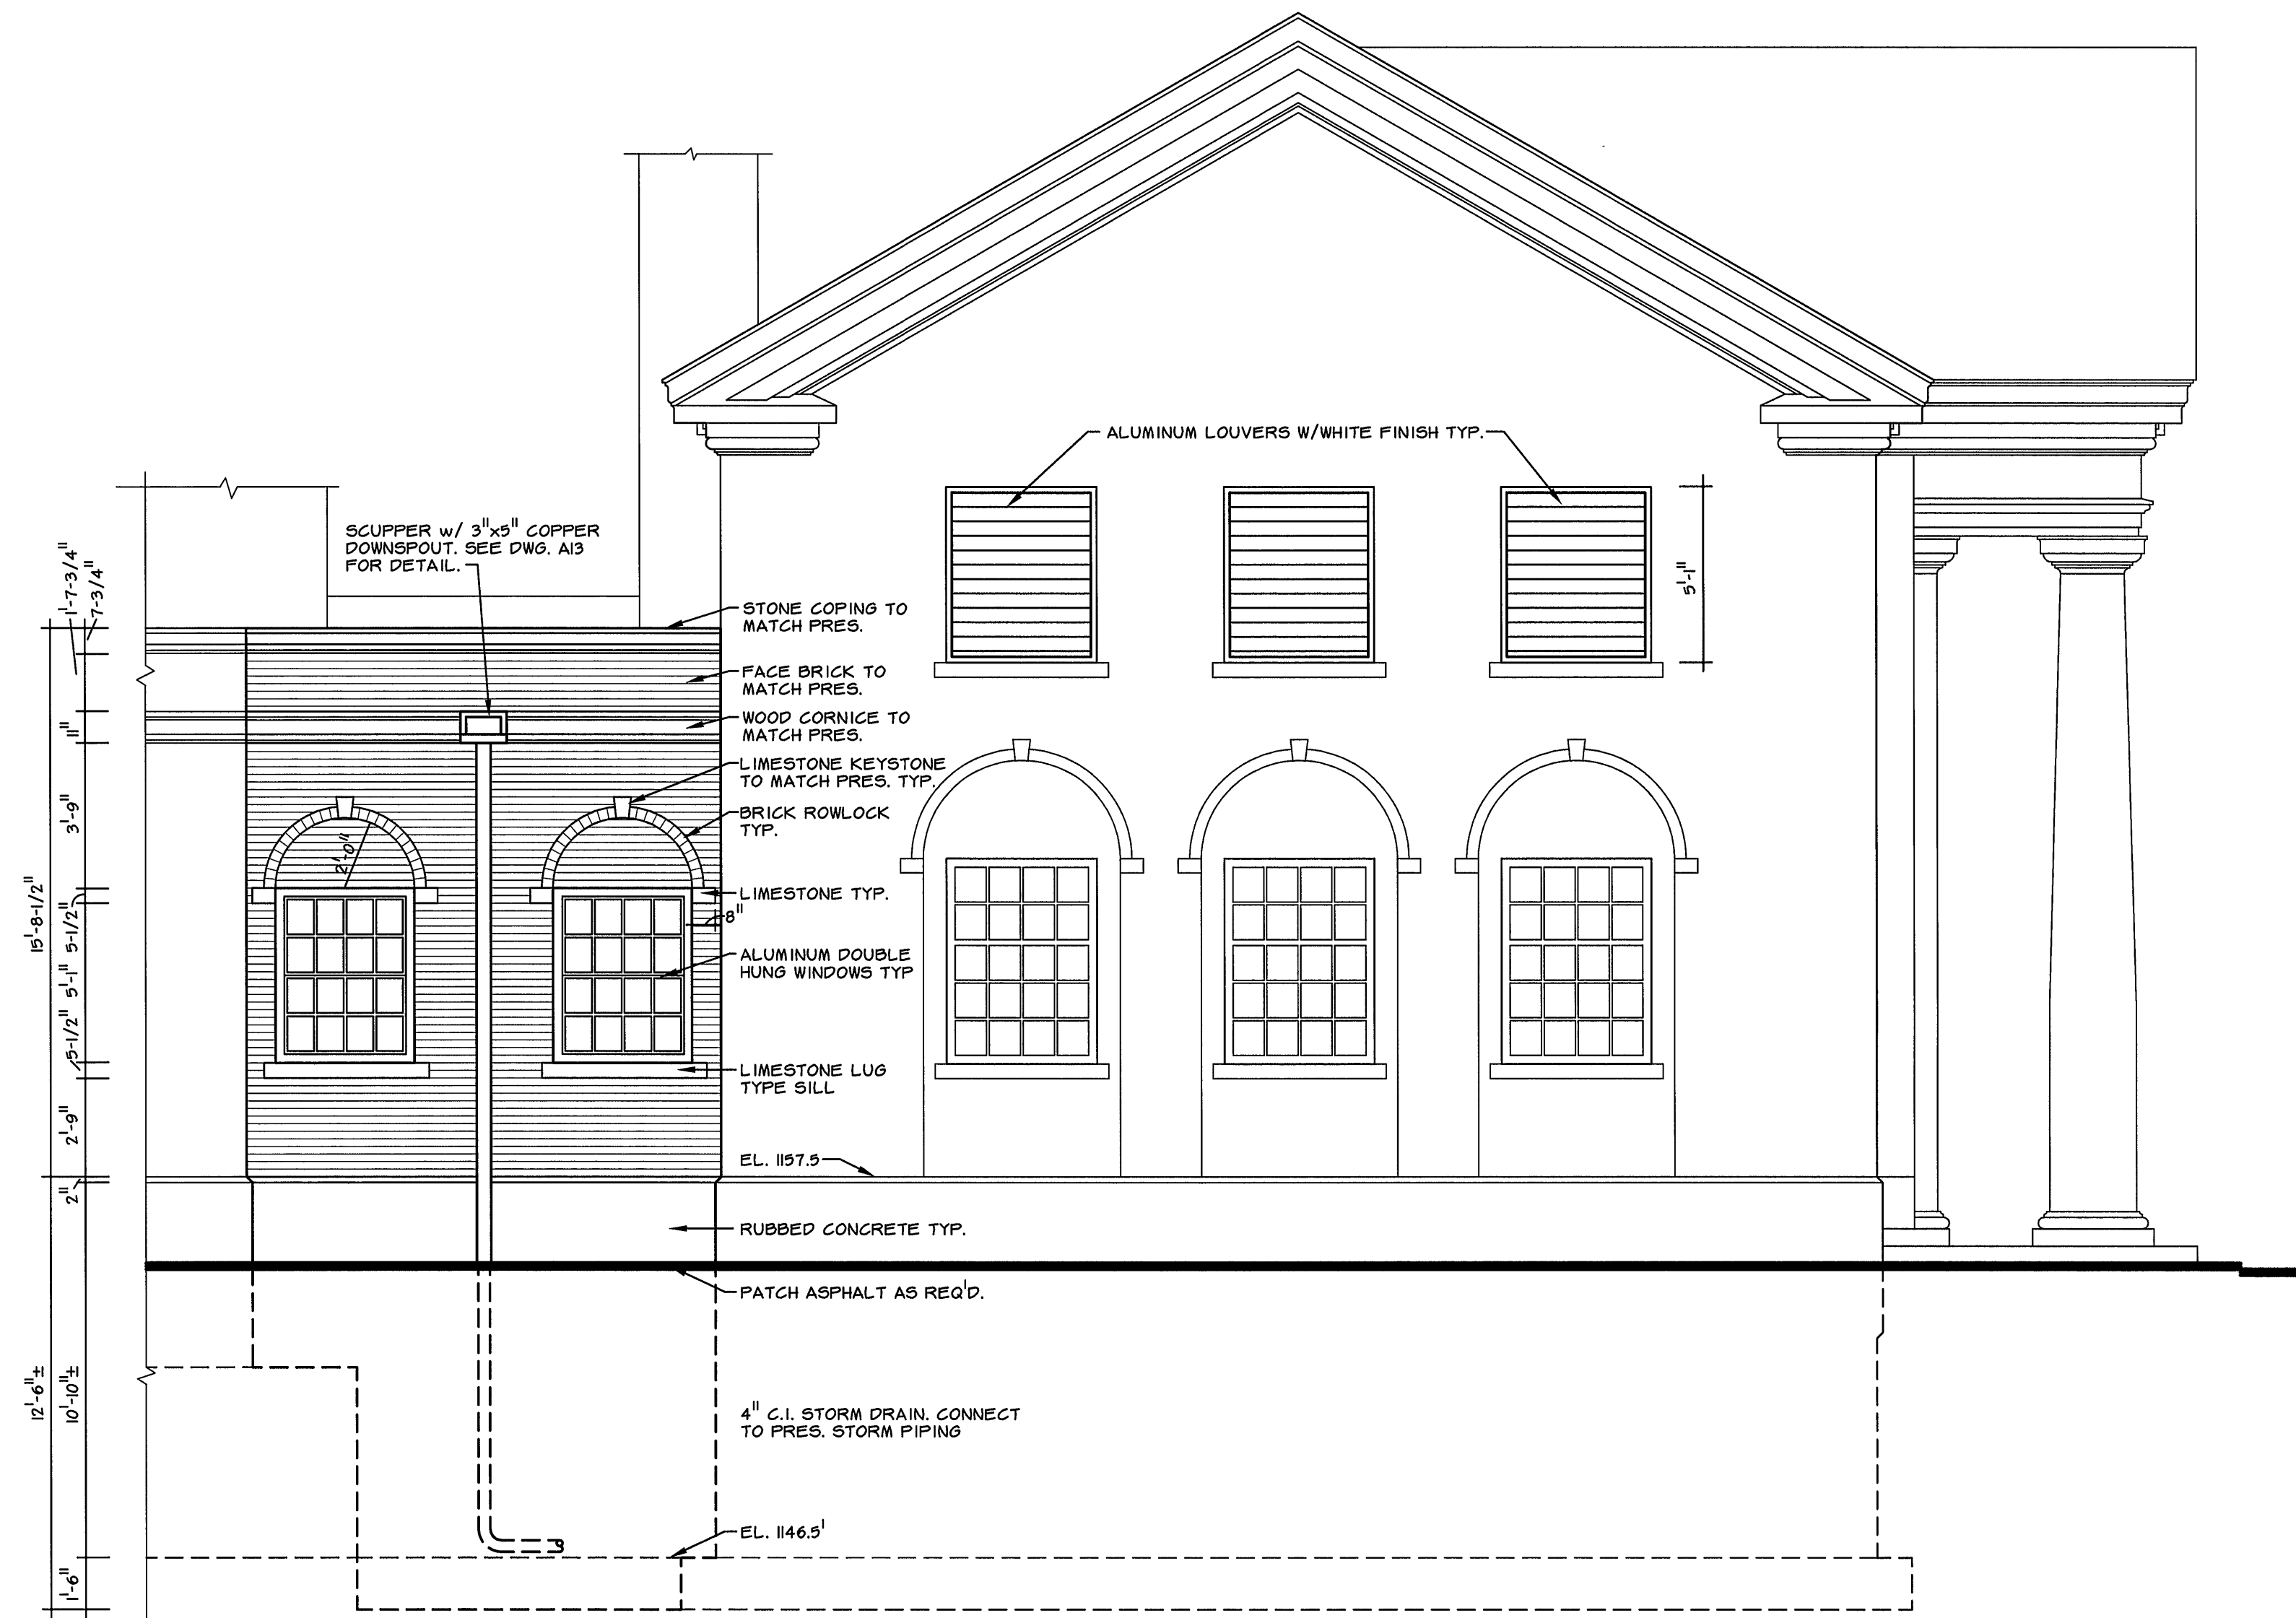


SOUTHWEST ELEVATION

SCALE: 0 4'-0" 8'-0"

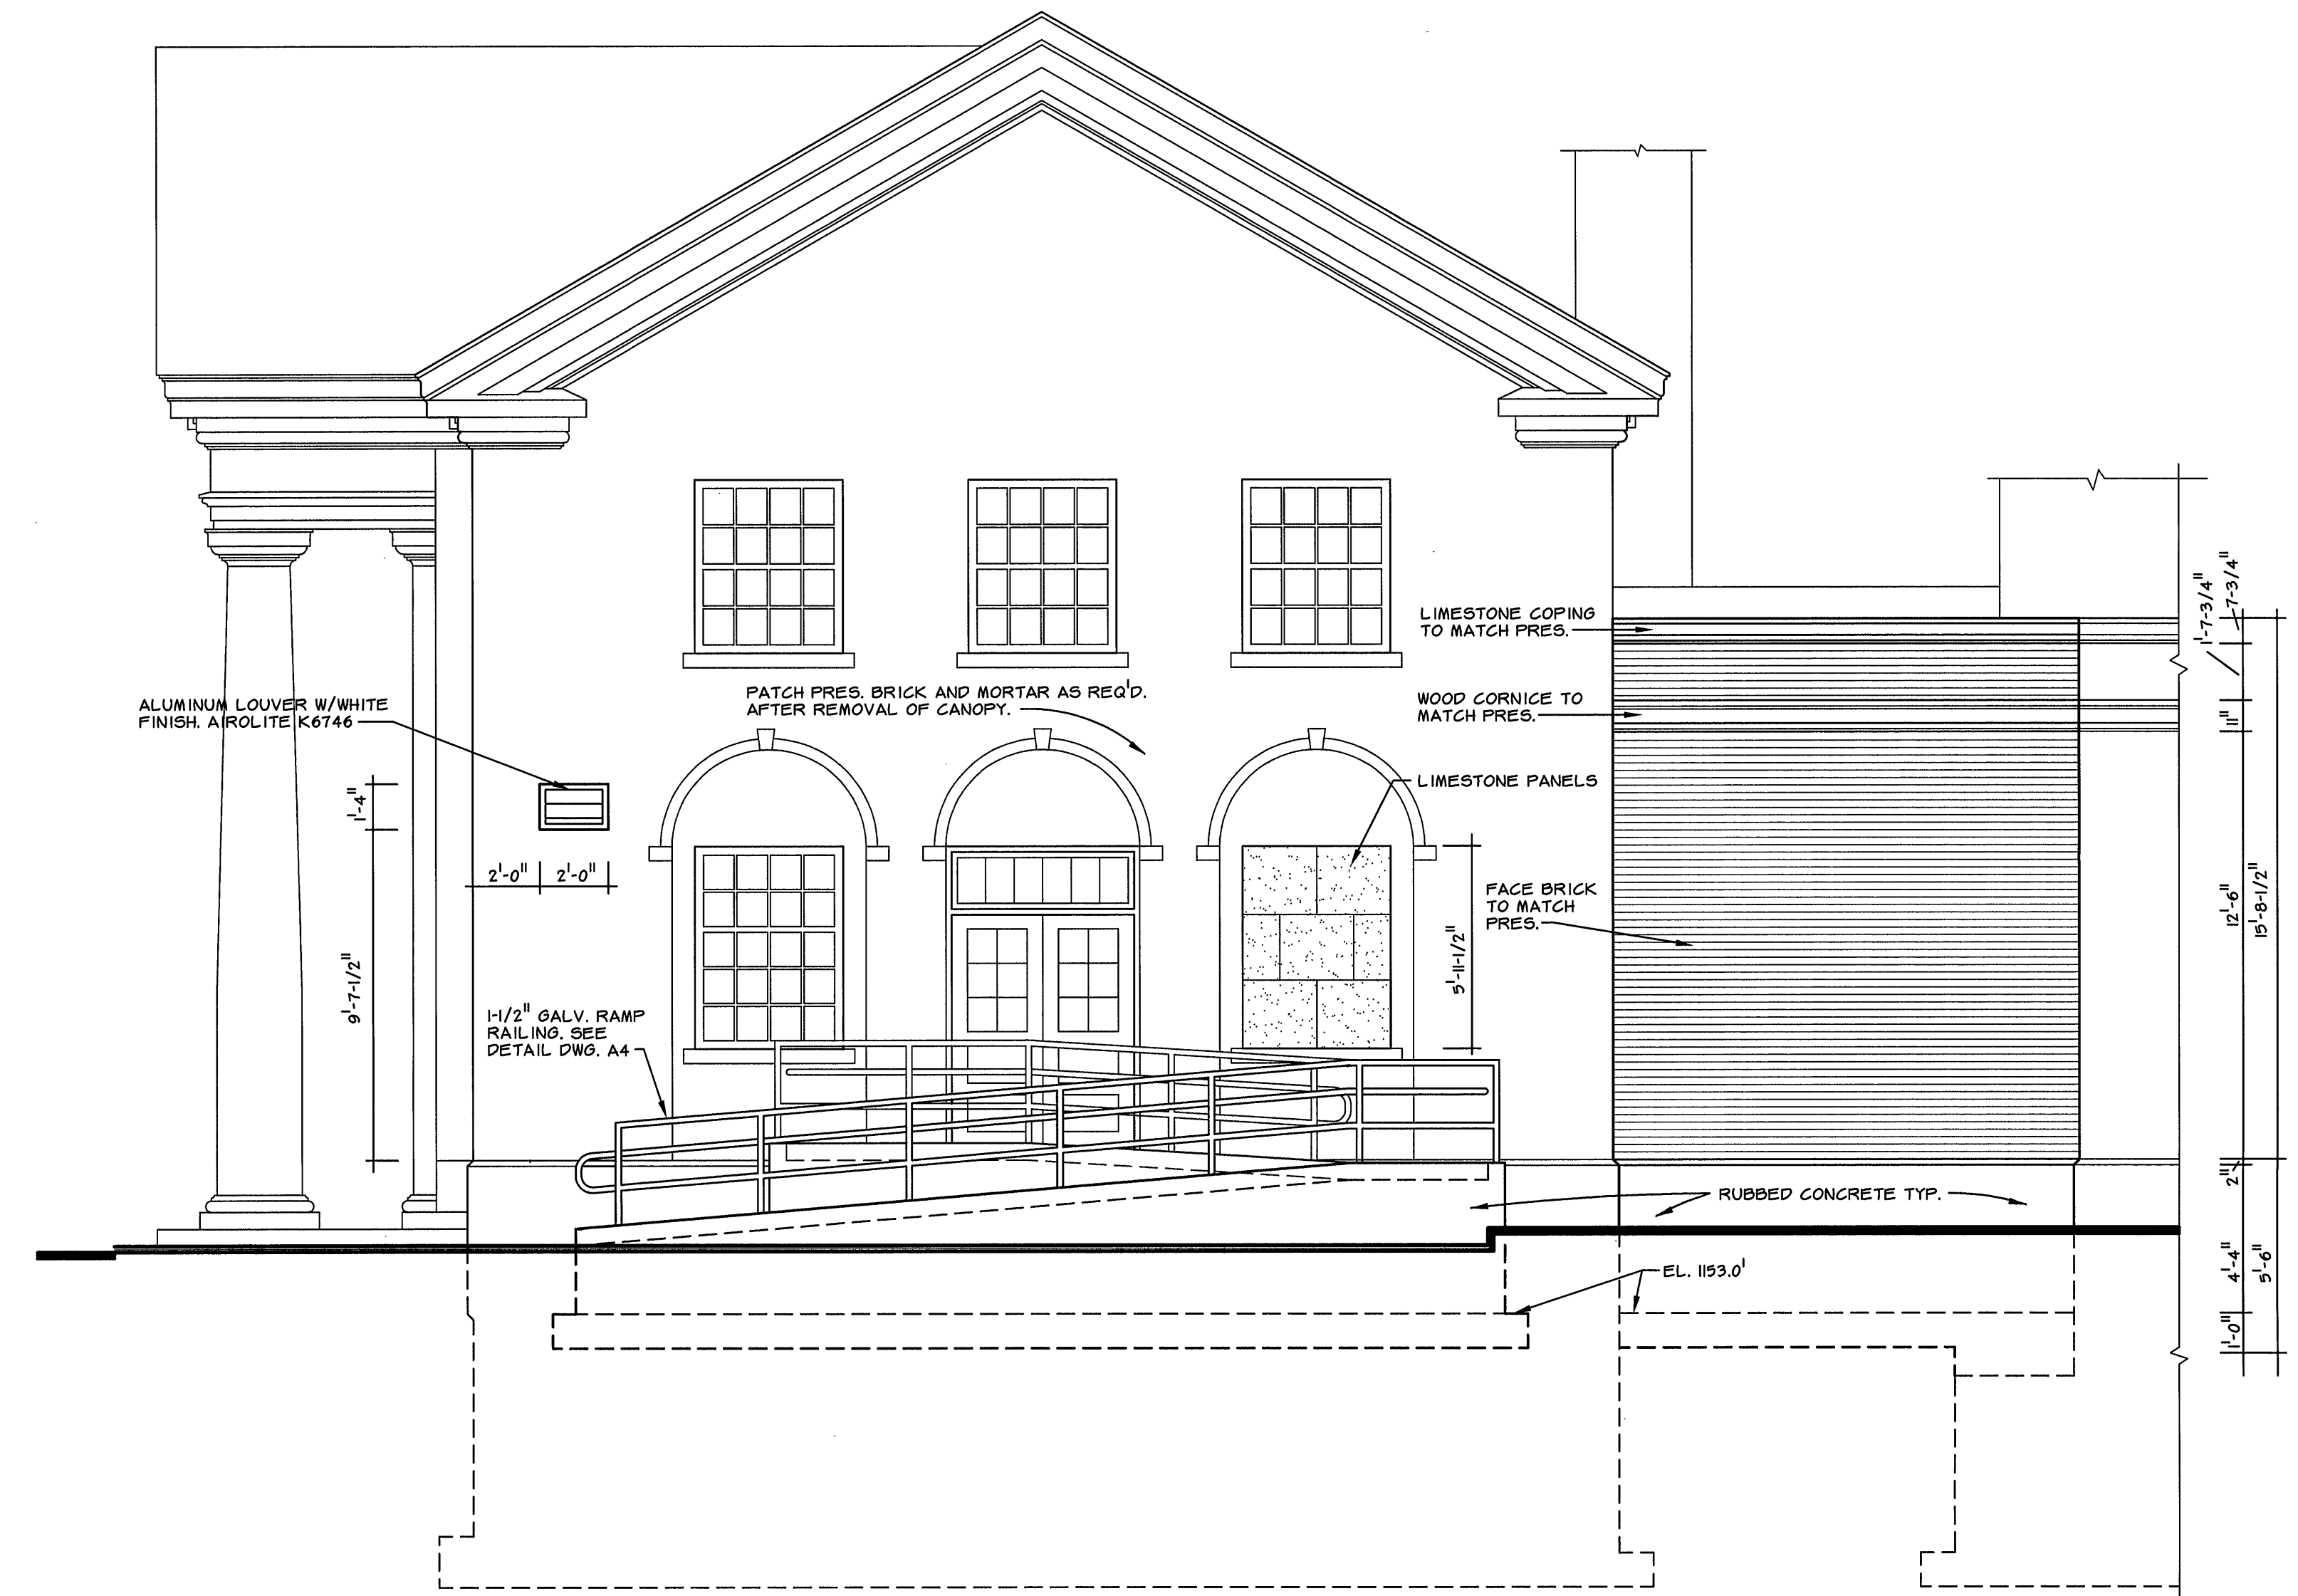


NORTHEAST ELEVATION


SCALE: 0 4'-0" 8'-0"

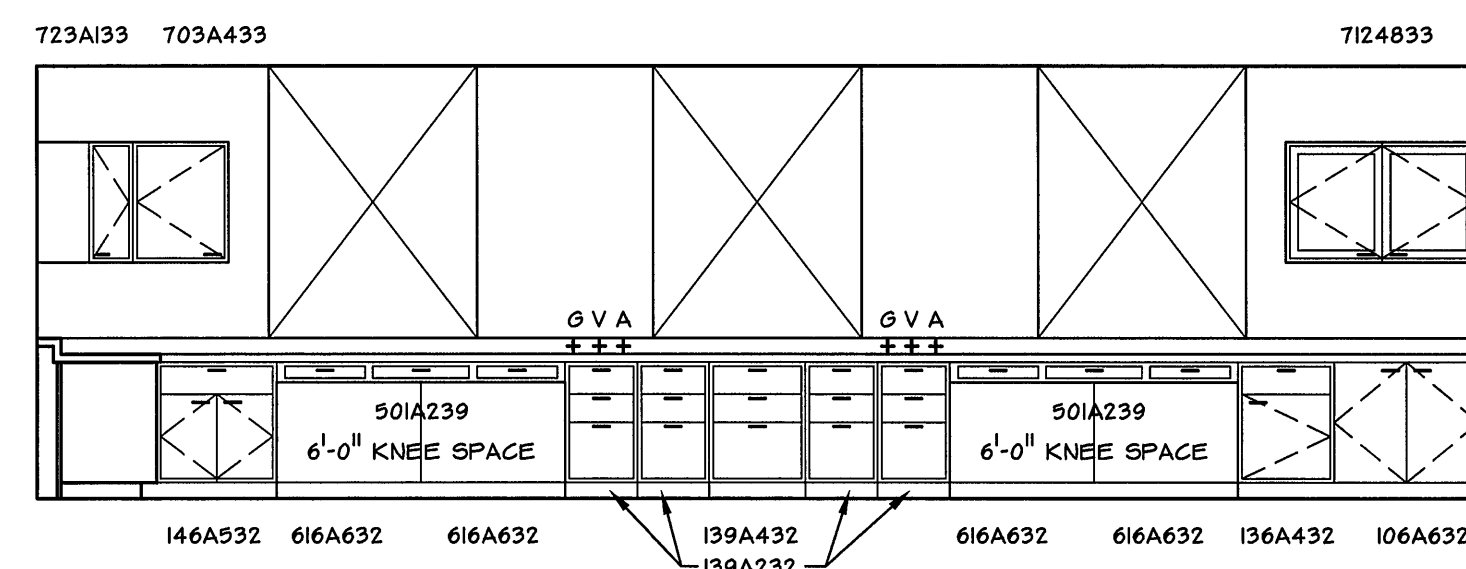


ELEVATION A

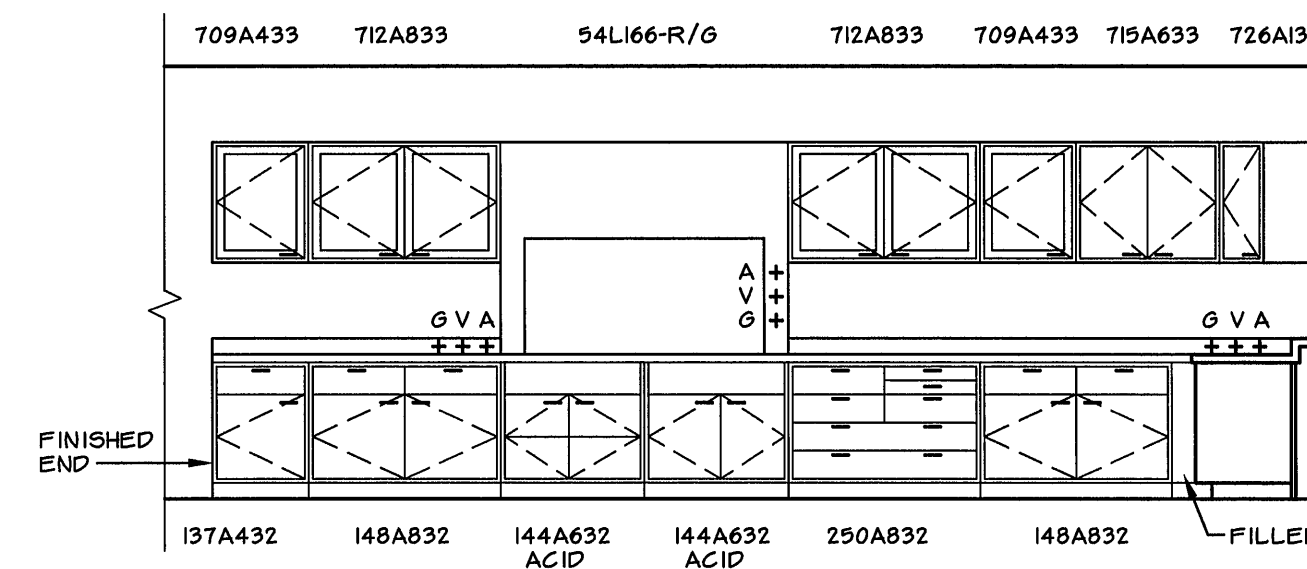


ELEVATION B

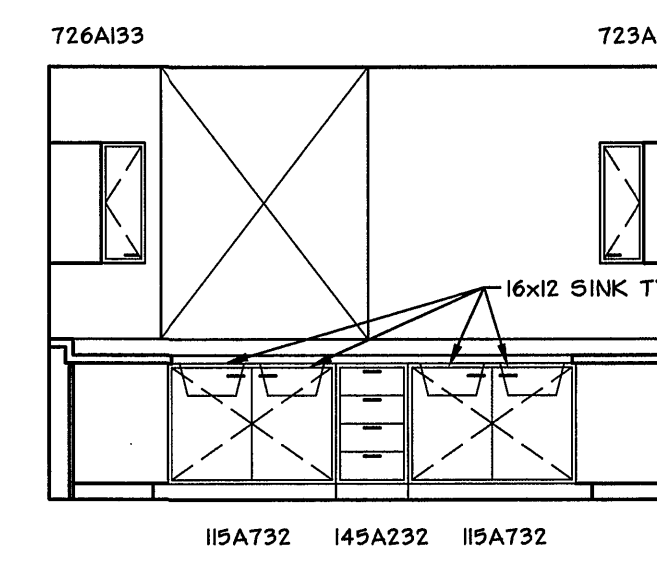


ELEVATION C

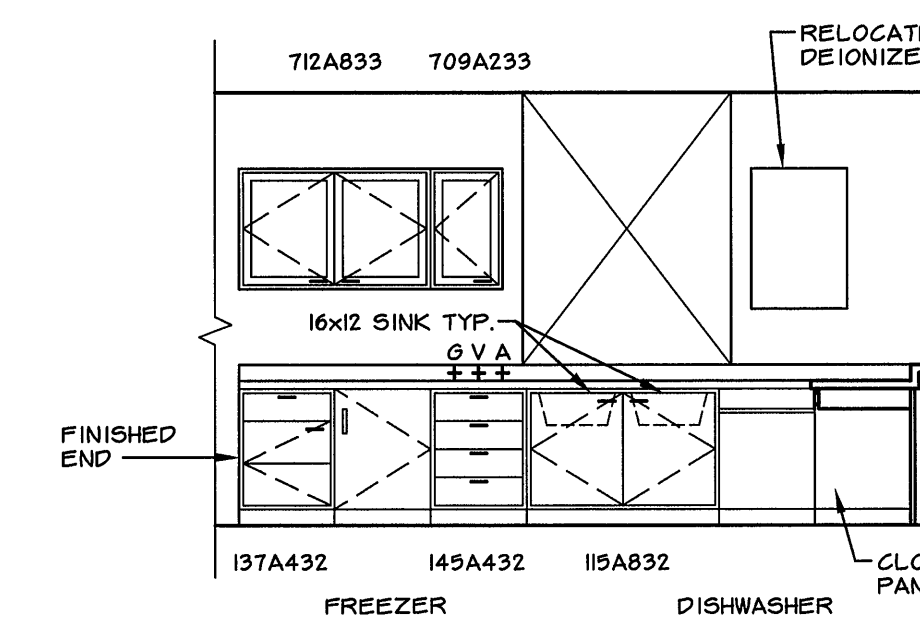

ELEVATION D

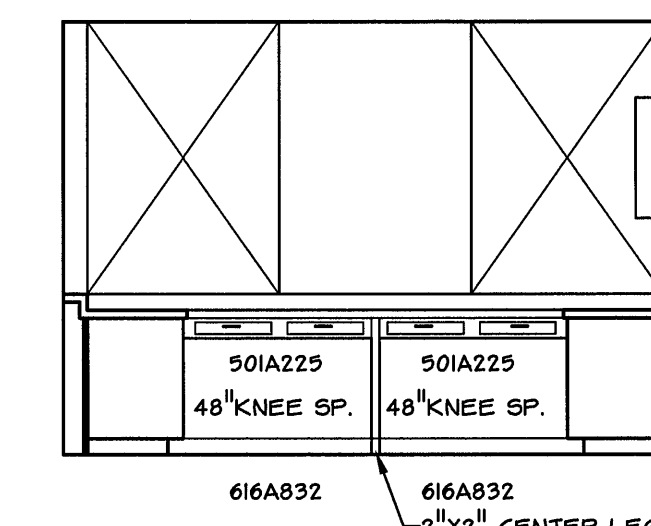

ELEVATION E

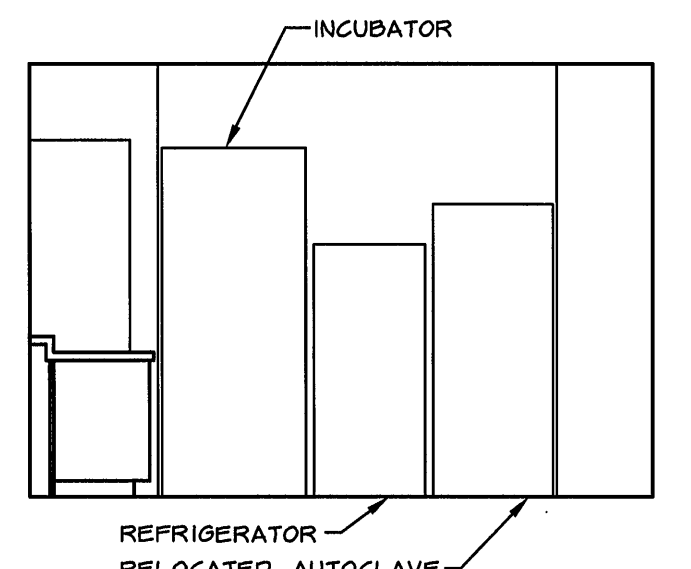

ELEVATION G

LABORATORY ELEVATIONS

SCALE: 0 4'-0" 8'-0"

NOTES

1. SEE SECTION A ON A6 FOR ELEVATION F.
2. ALL CABINET CATALOG NUMBERS ARE HAMILTON.
3. VERIFY ALL DIMENSIONS IN THE FIELD.

DRAWING OF RECORD

DATE: SEP 30 1997

MATTEN & CRAIG CONSULTING ENGINEERS • SURVEYORS ROANOKE VIRGINIA	DESIGNED:			REV.	DATE	DESCRIPTION	BY	APP.	CARVINS COVE FILTER PLANT IMPROVEMENTS – PHASE I ROANOKE, VIRGINIA	DATE APRIL 1992
	DRAWN:									
ALVORD, BURDICK & HOWSON ENGINEERS CHICAGO	CHECKED:									