



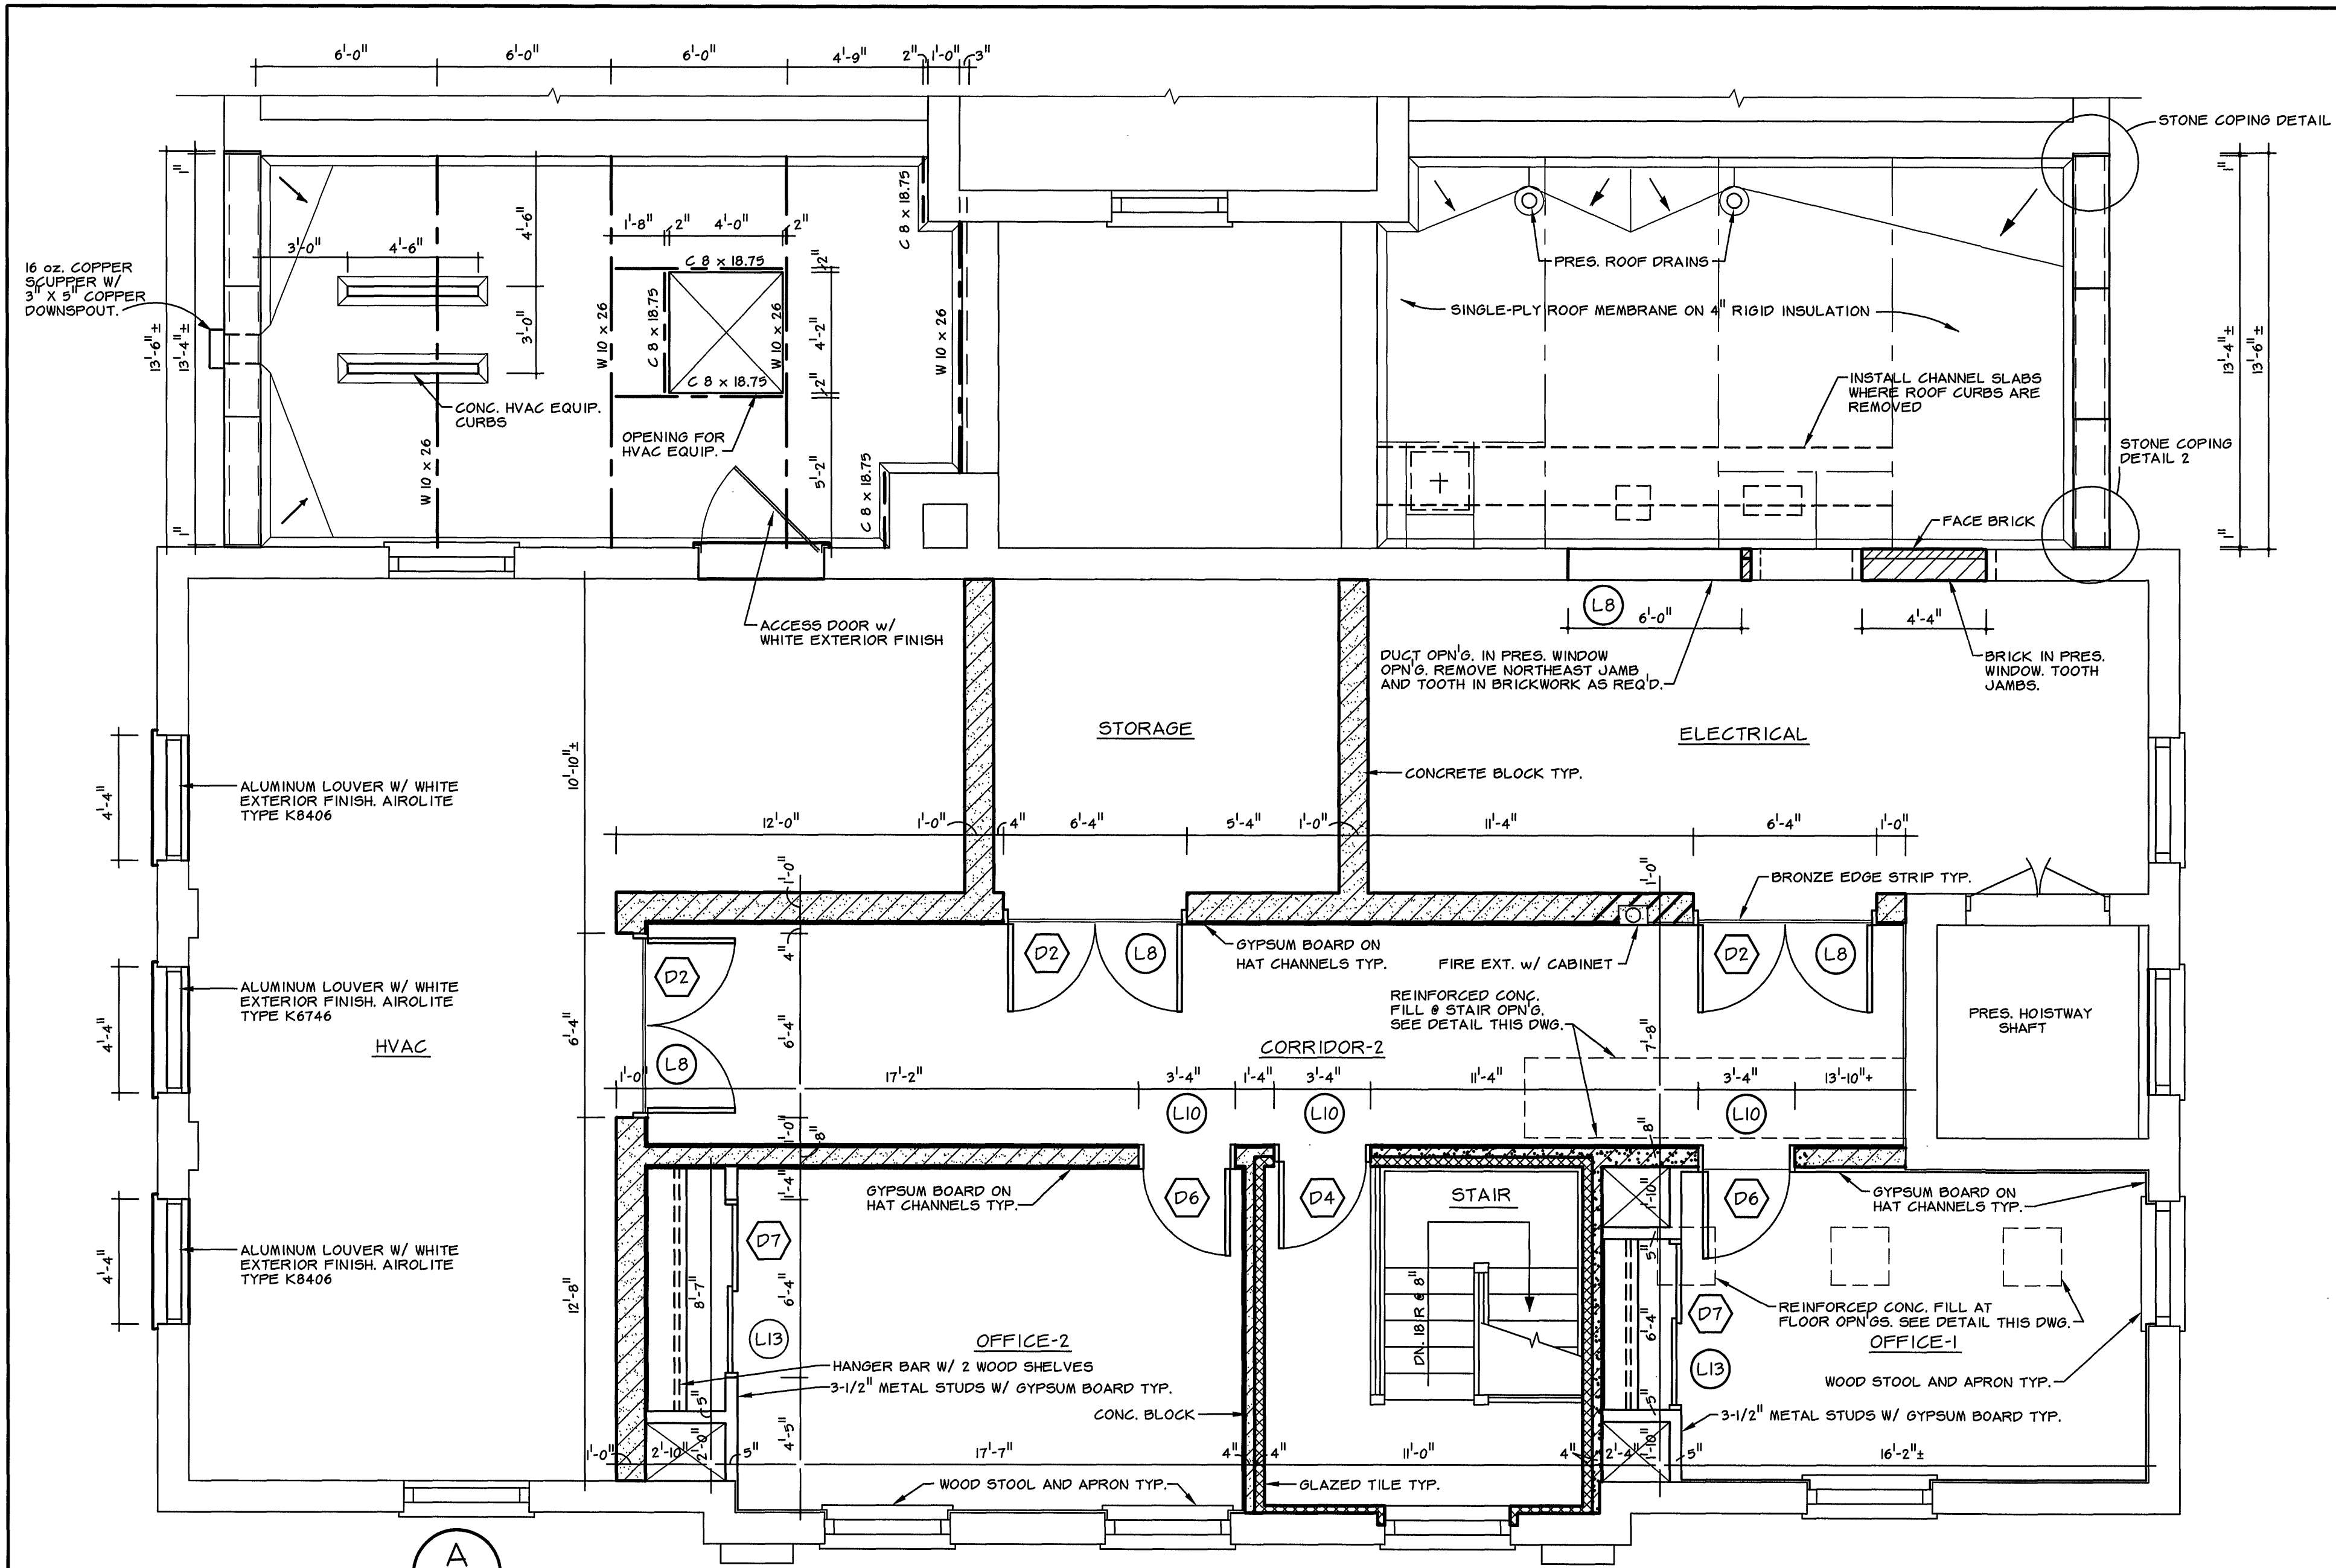


PLAN AT EL. 1169.5

SCALE: 0 4'-0" 8'-0"

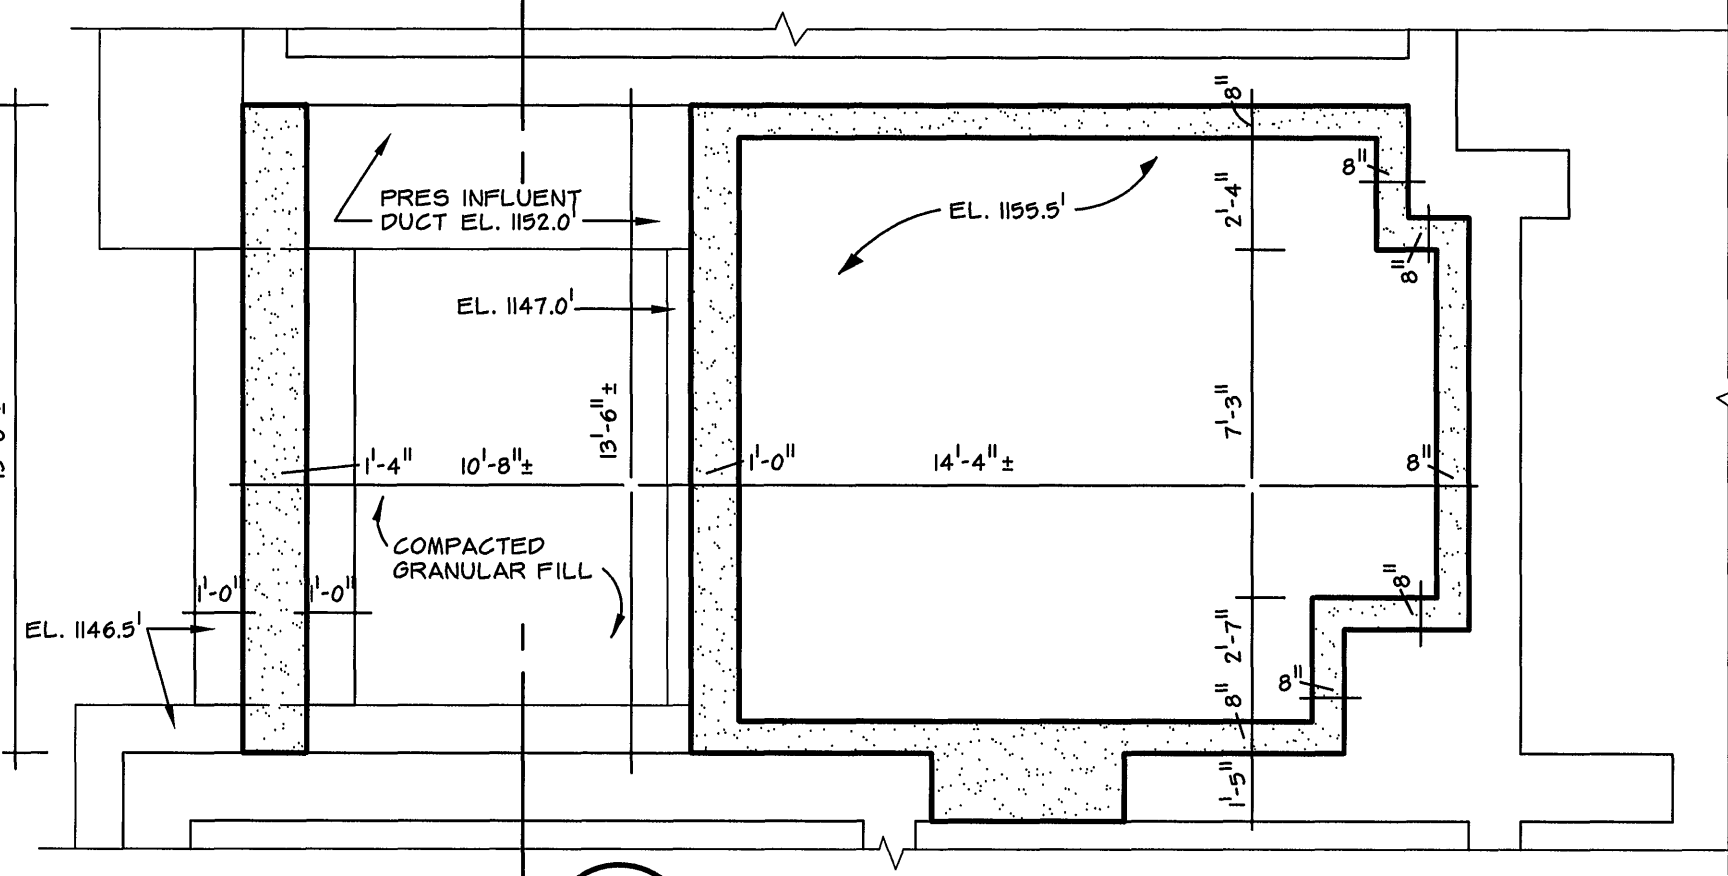

LABORATORY FOUNDATION PLAN

SCALE: 0 4'-0" 8'-0"

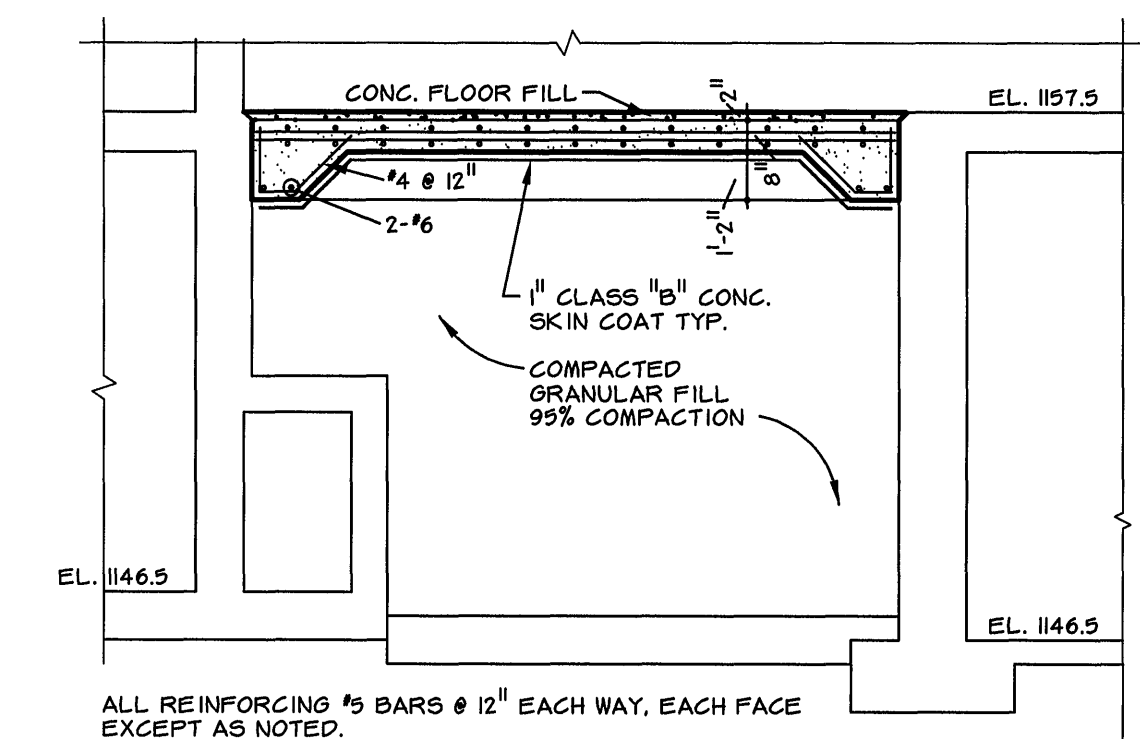


SECTION

SCALE: 0 4'-0" 8'-0"


NOTES:

1. ALL DIMENSIONS TO BE VERIFIED IN THE FIELD.
2. ALL 12" CONCRETE BLOCK PARTITIONS EXTEND TO UNDERSIDE OF PRESENT ROOF STRUCTURE.
3. ALL 8" PARTITIONS AT EL. 1169.5 ARE 9'-4" HIGH.
4. ALL PARTITION DIMENSIONS TO BE VERIFIED FROM LOCATION OF STAIR OPENING.
5. OPENING FOR STAIR TO BE VERIFIED WITH WALL LOCATIONS AT EL. 1157.5. GLAZED TILE IN STAIR IS CONTINUOUS THROUGH EL. 1169.5.

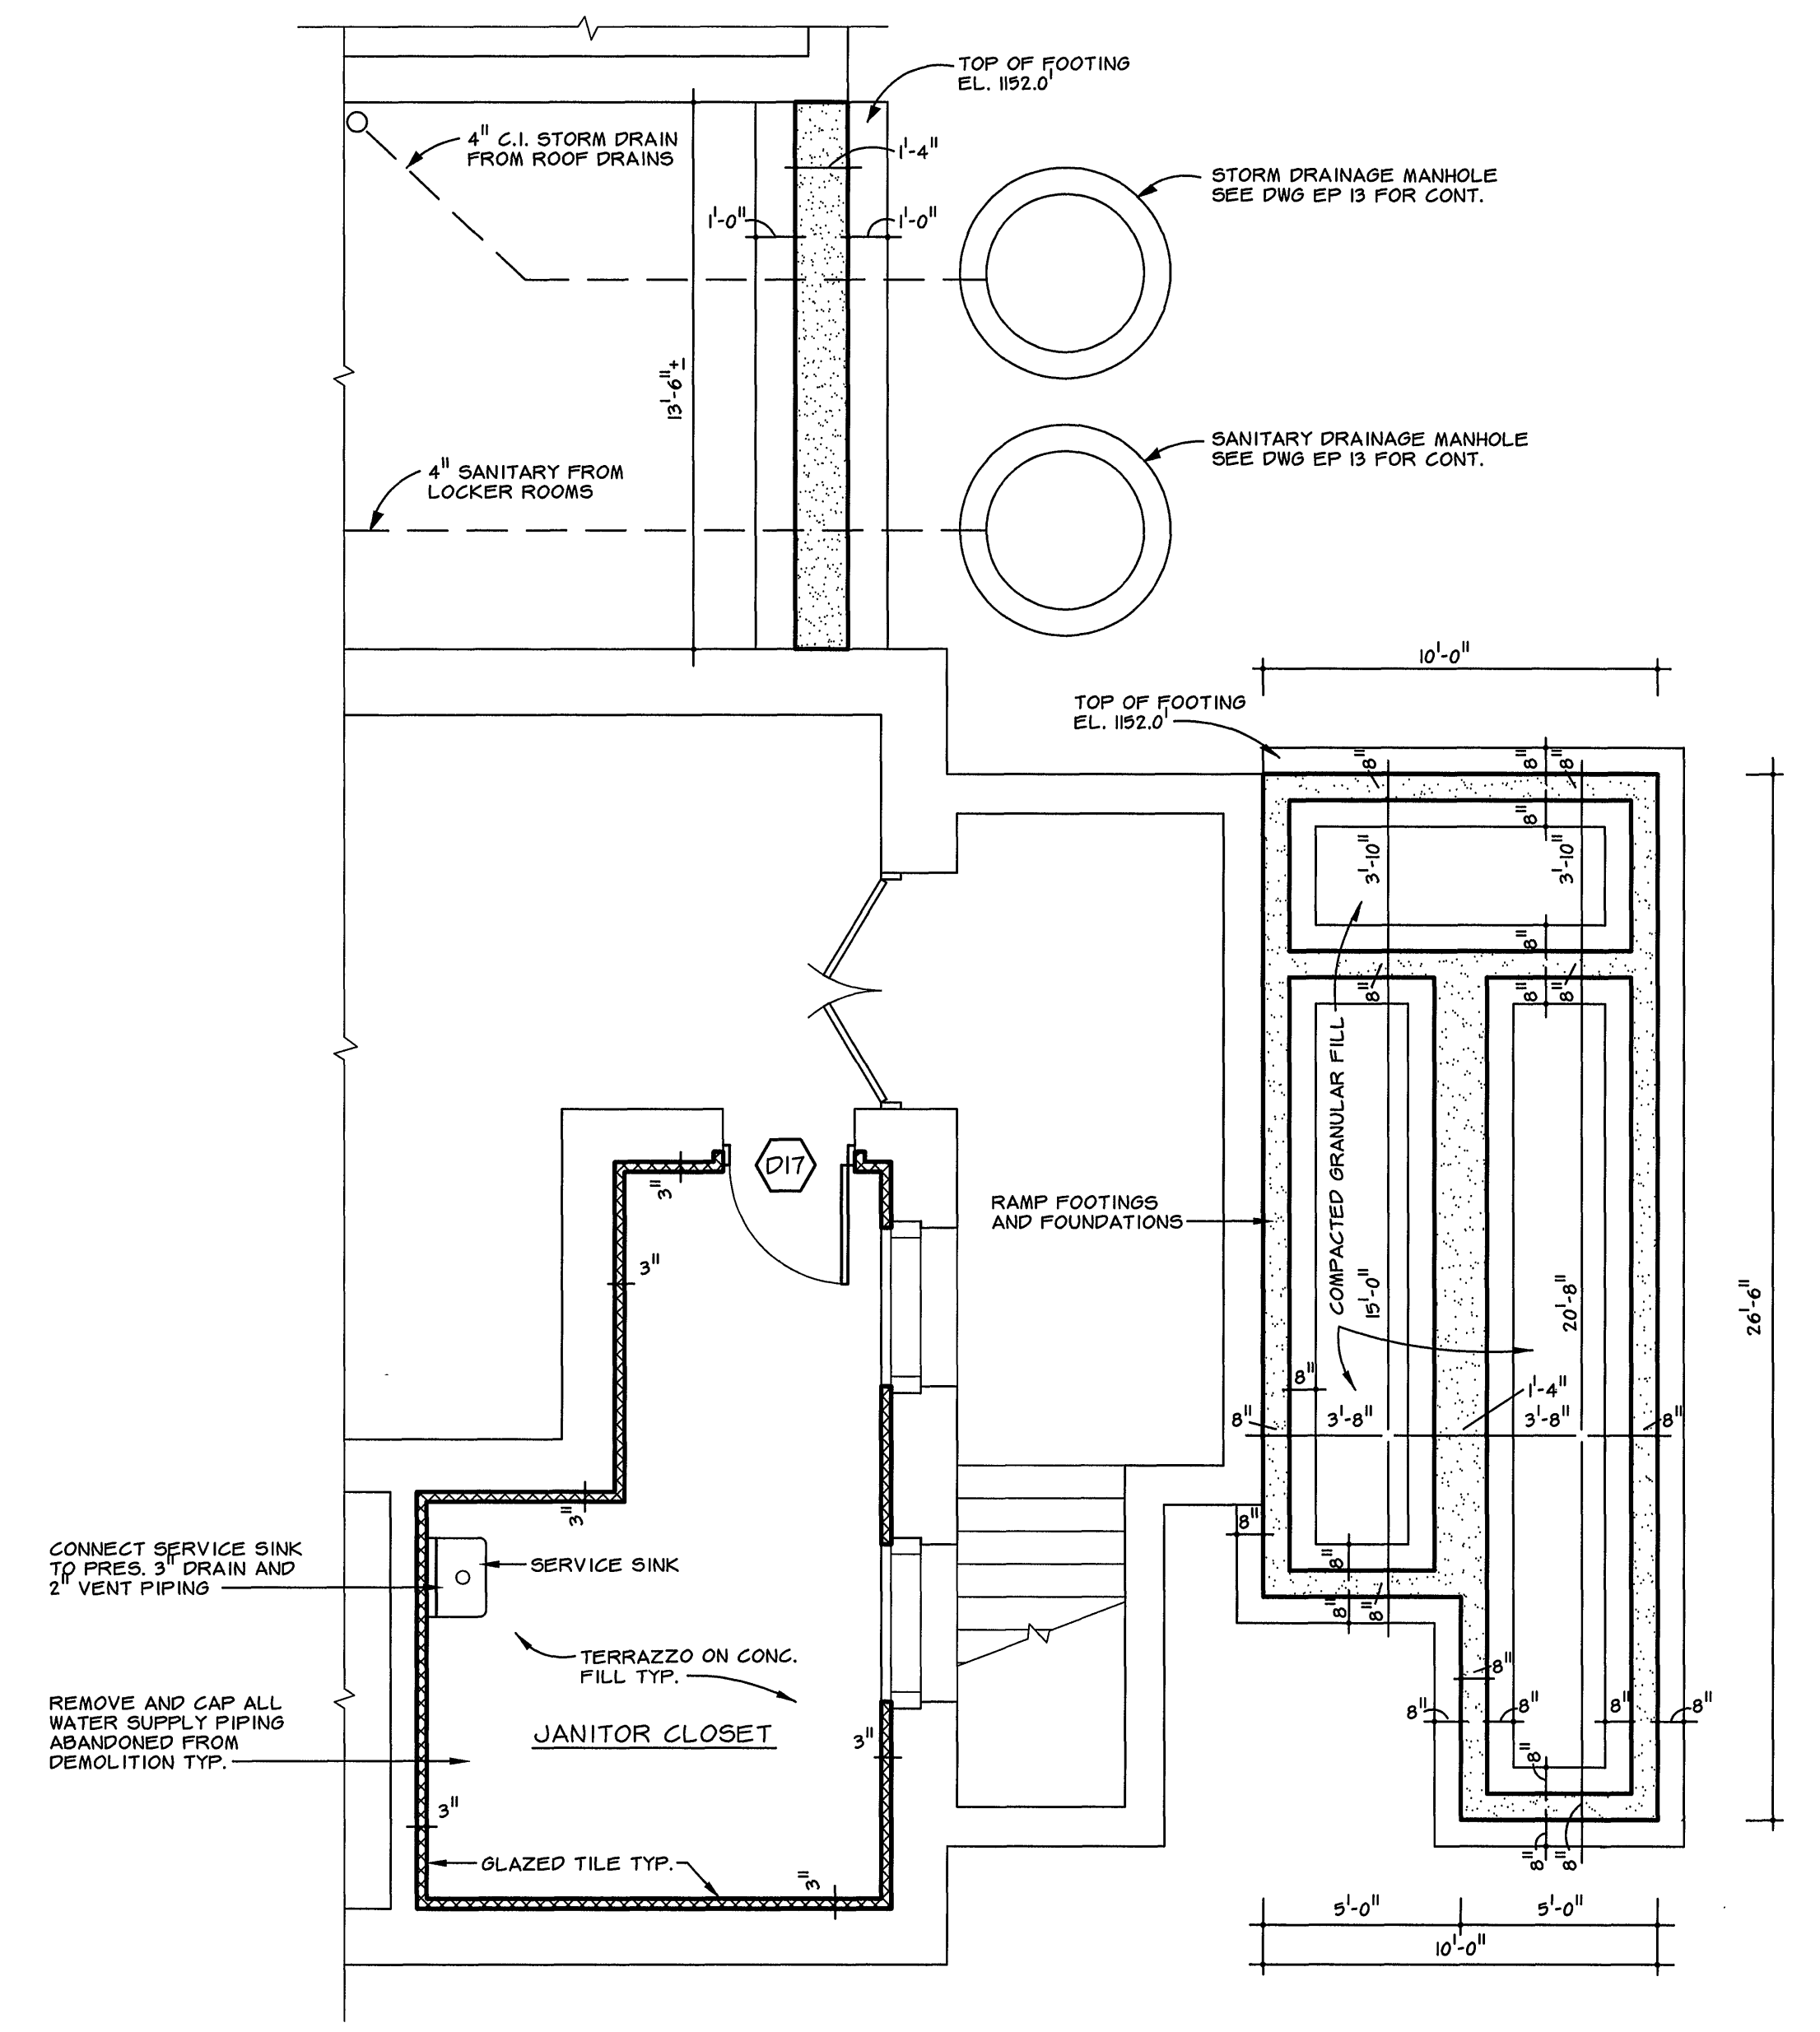


PARTIAL PLAN AT EL. 1146.5

SCALE: 0 4'-0" 8'-0"

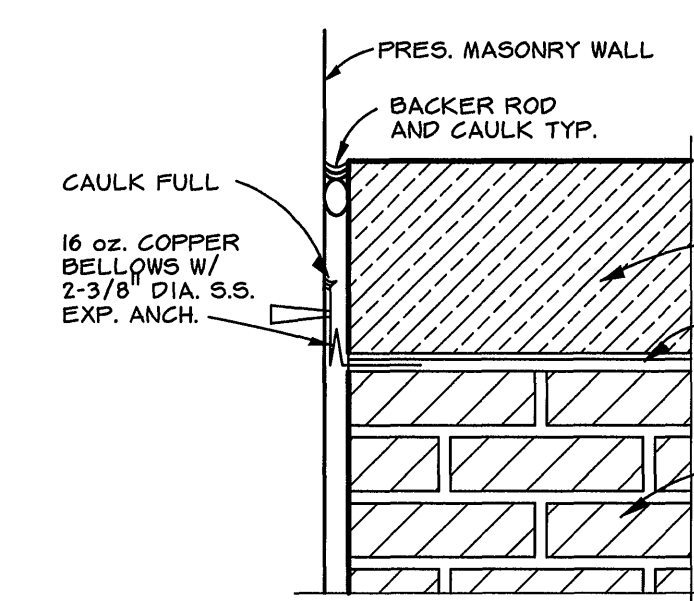

DETAIL 1
COPING DETAILS

SCALE: 0 6" 1'-0"

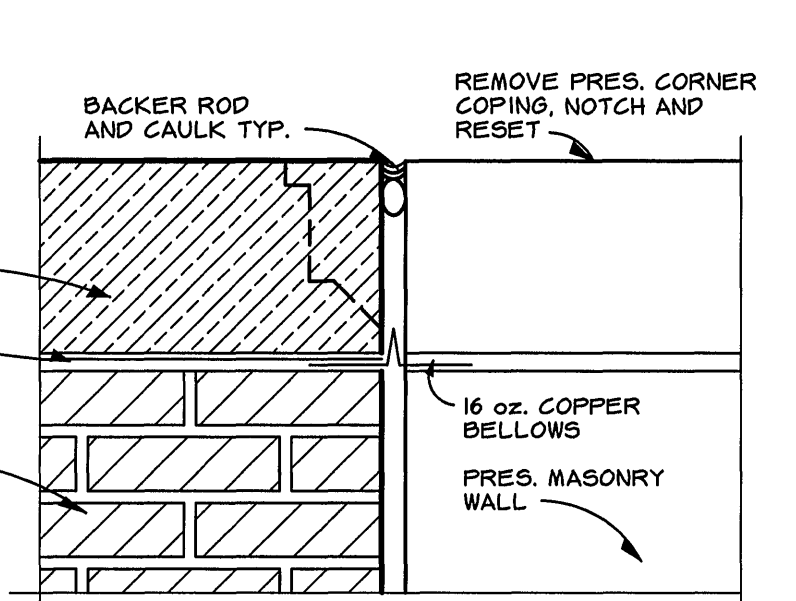

DETAIL 2

DRAWING OF RECORD
DATE: SEP 30 1997

MATTEN & CRAIG CONSULTING ENGINEERS • SURVEYORS ROANOKE VIRGINIA	DESIGNED:			REV.	DATE	DESCRIPTION	BY	APP.	CARVINS COVE FILTER PLANT IMPROVEMENTS – PHASE I	DATE	
	DRAWN:										APRIL 1992
	CHECKED:										COMM. NO.
ALVORD, BURDICK & HOWSON									ADMINISTRATION BUILDING	9130	
ENGINEERS CHICAGO									PLANS & DETAILS	SHEET	
										A5	