

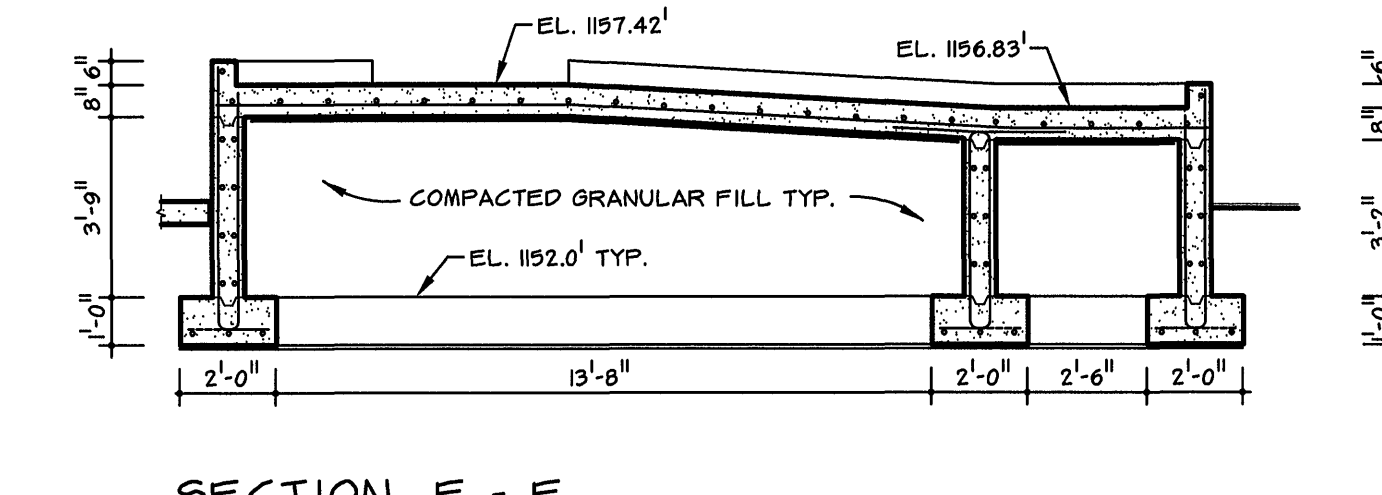
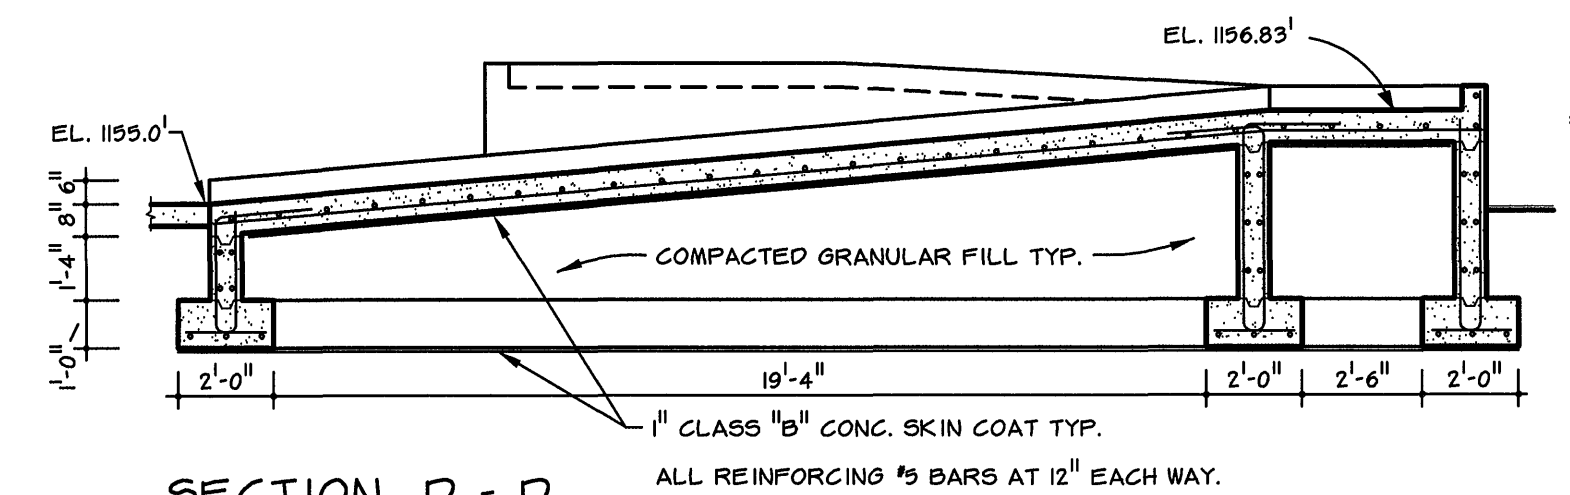


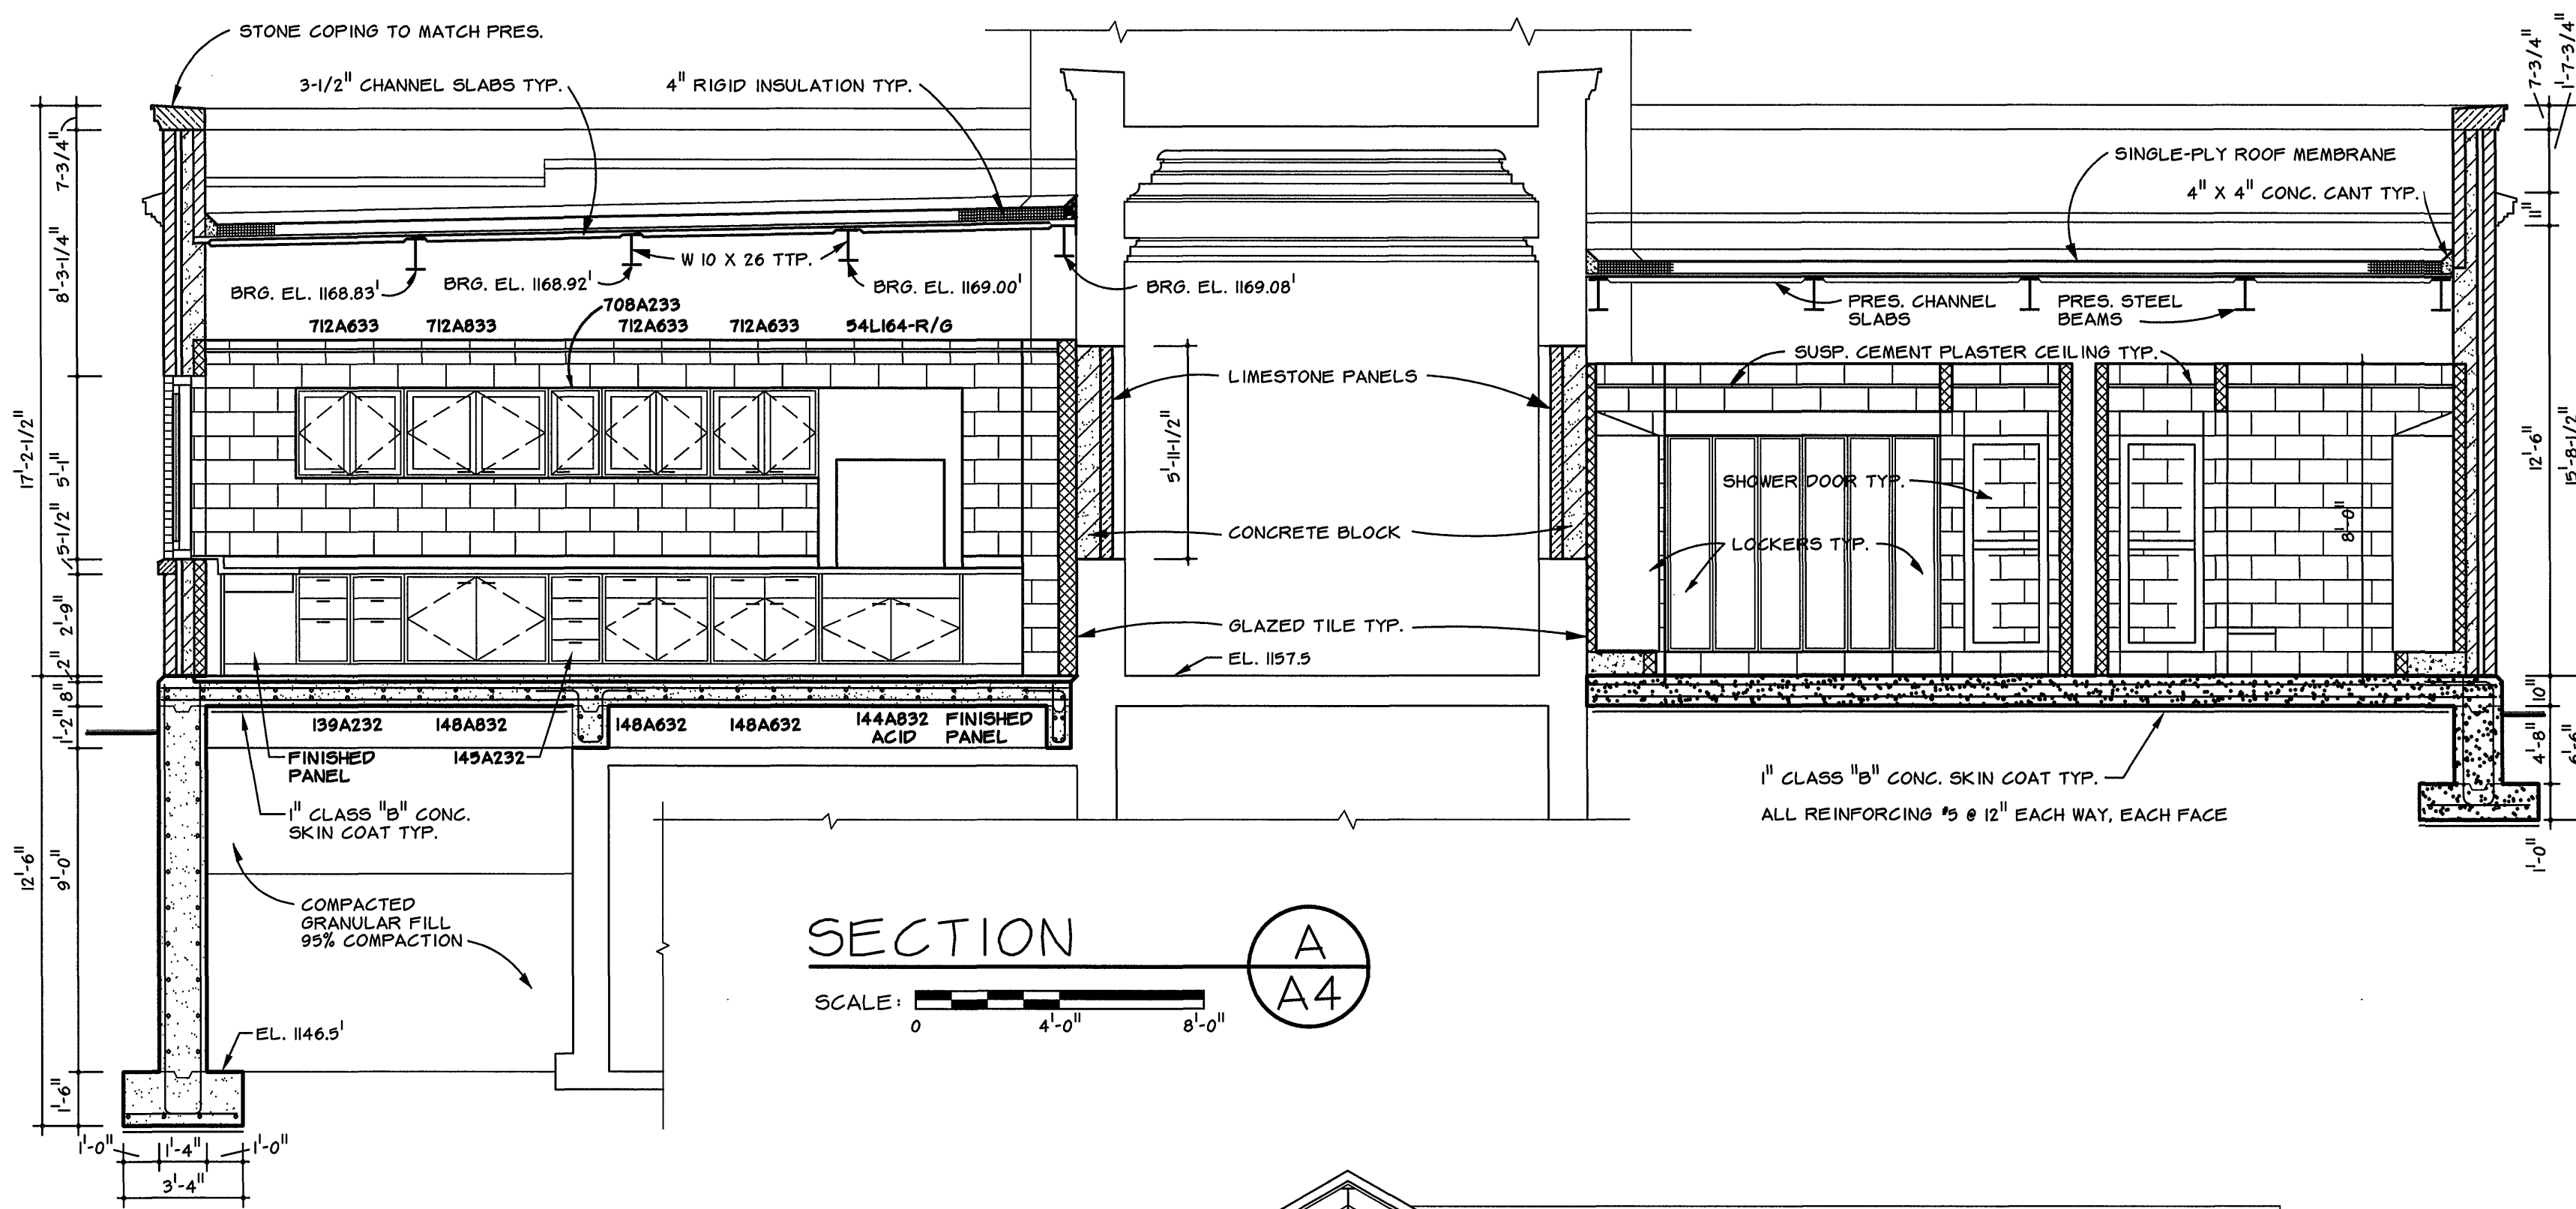



RAMP DETAILS

SCALE: 0 4'-0" 8'-0"

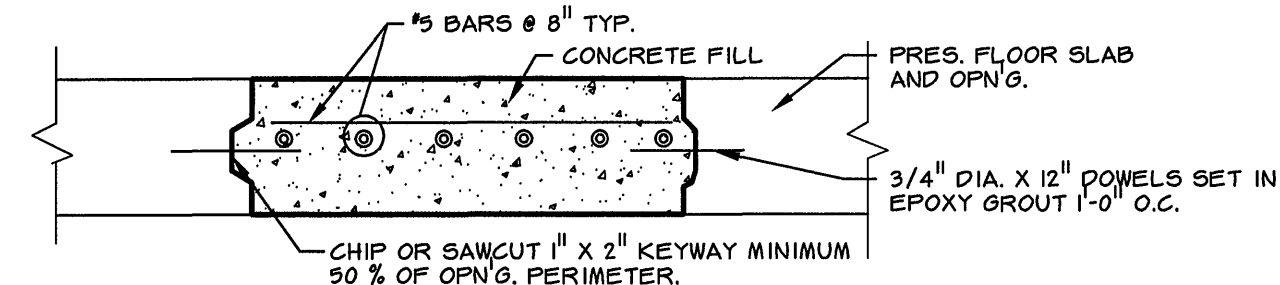

FLOOR PATCH DETAILS

SCALE: 0 4'-0" 8'-0"

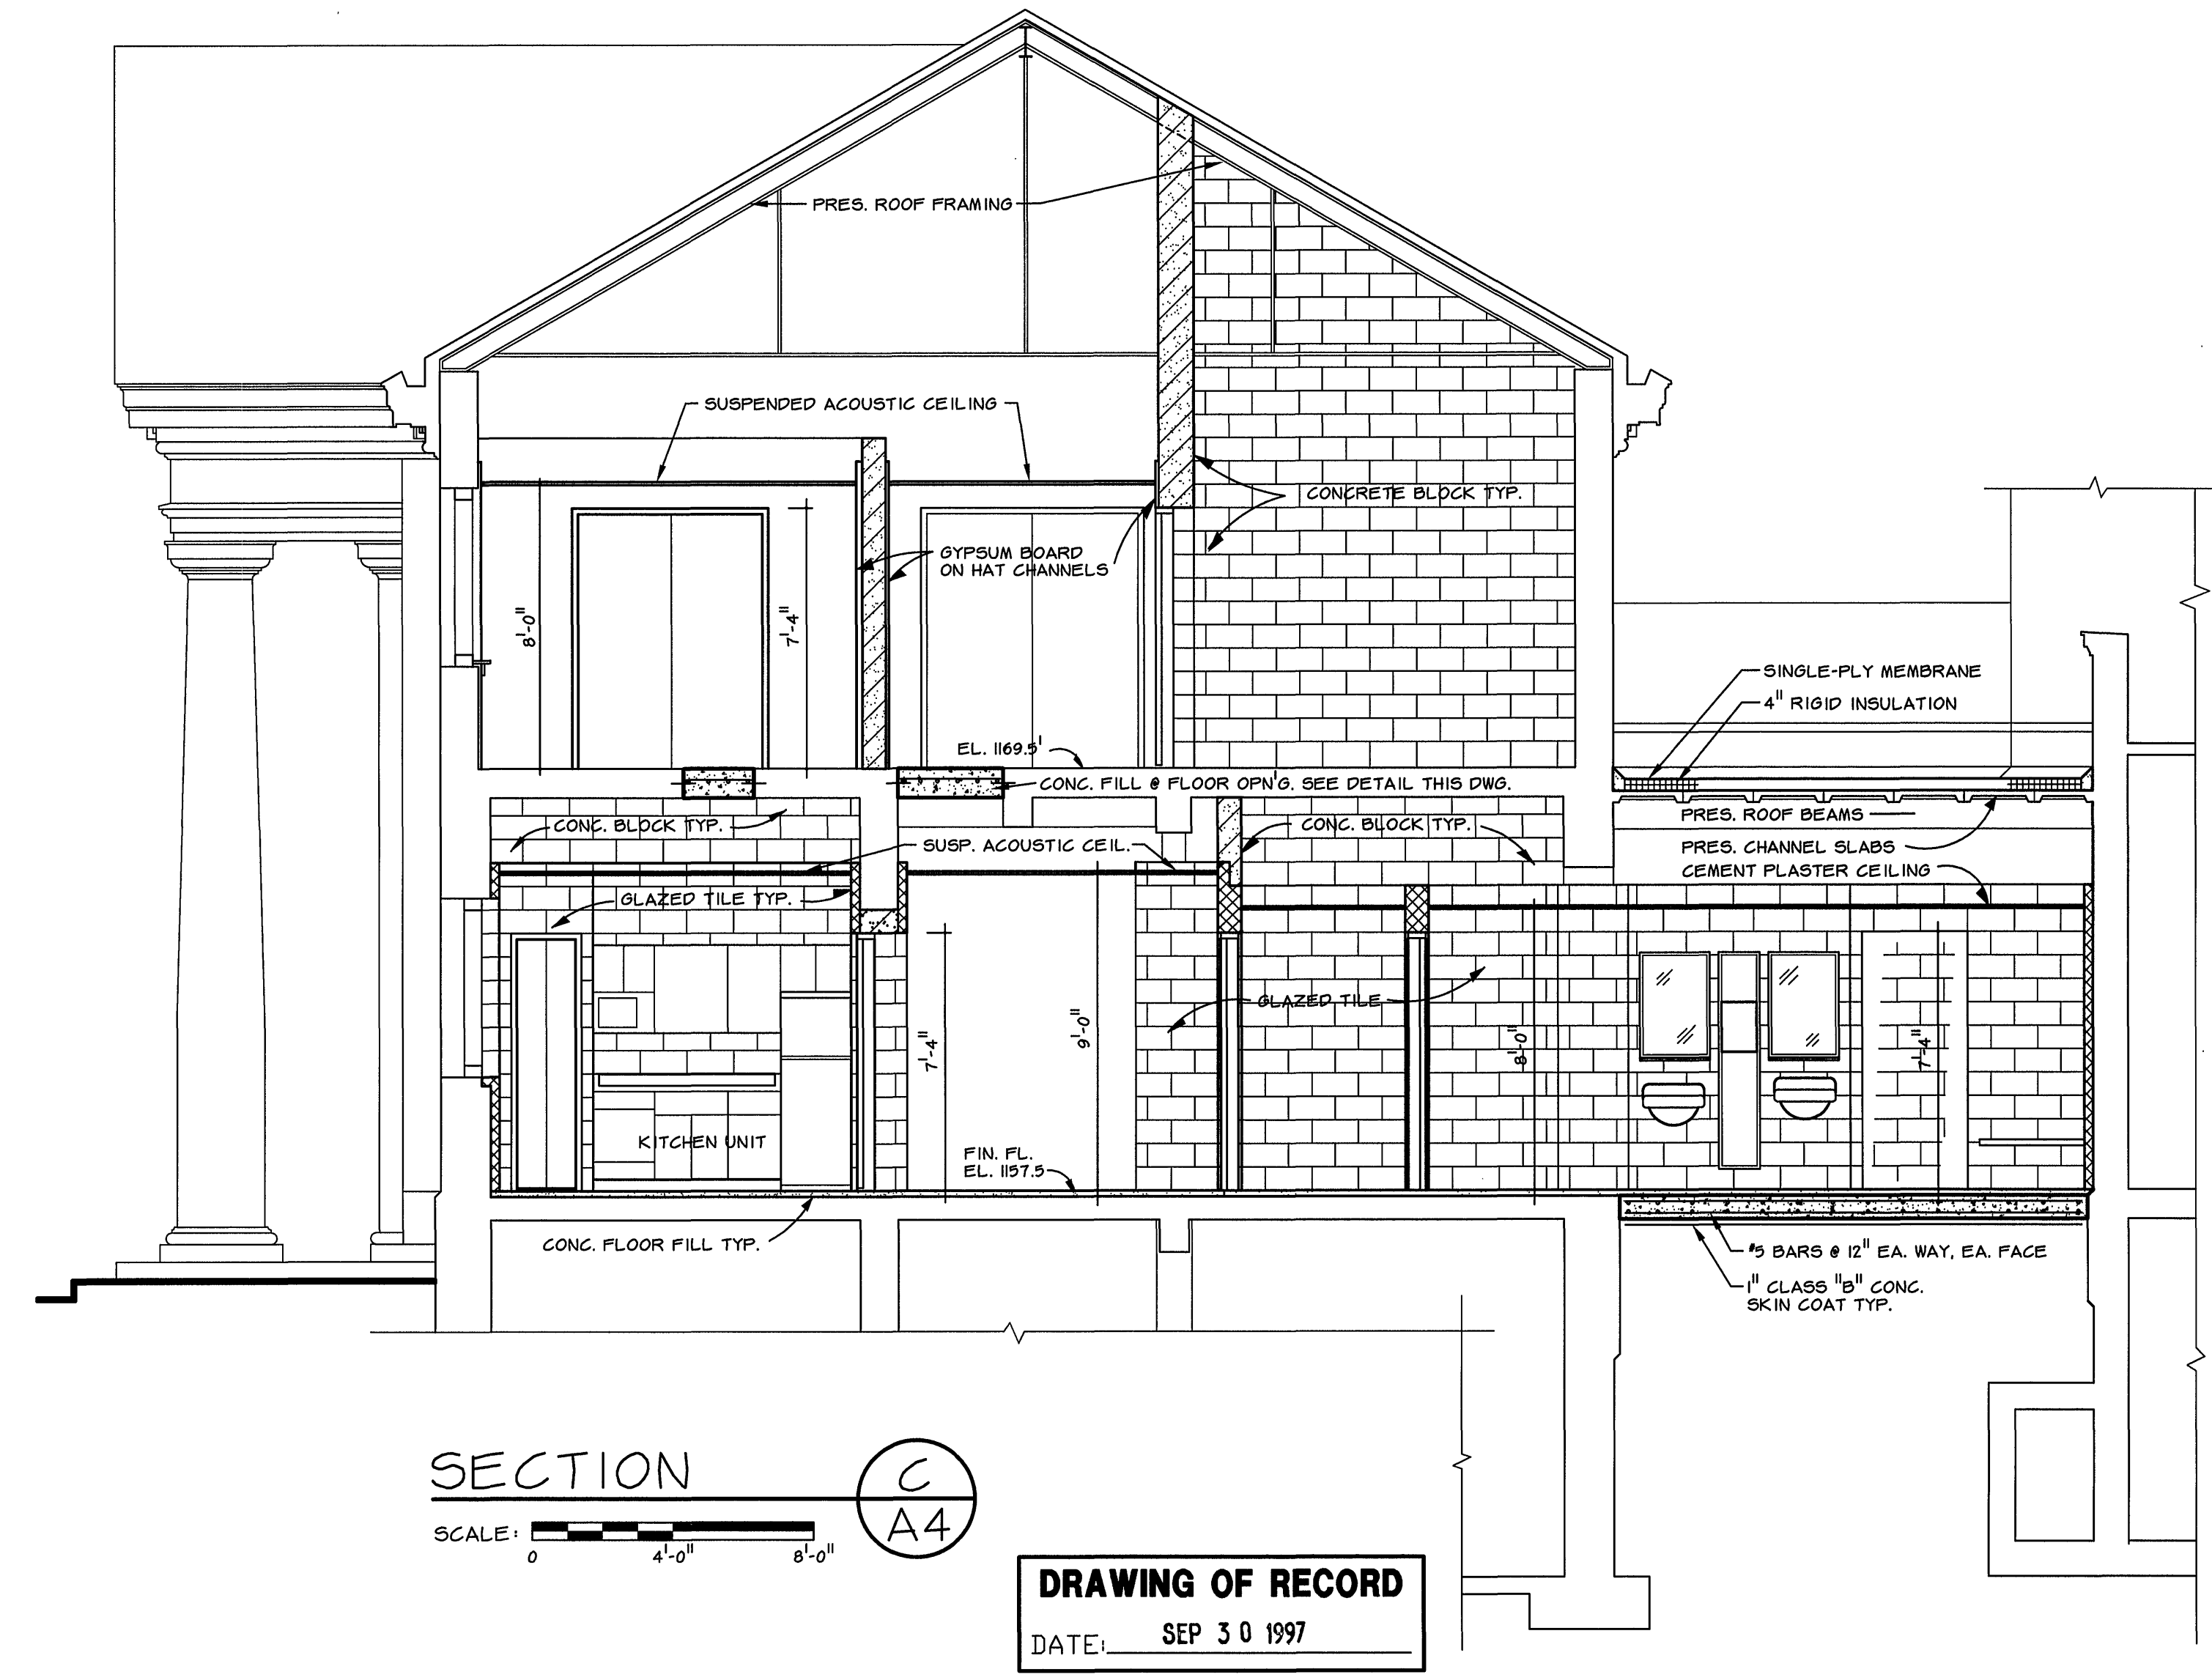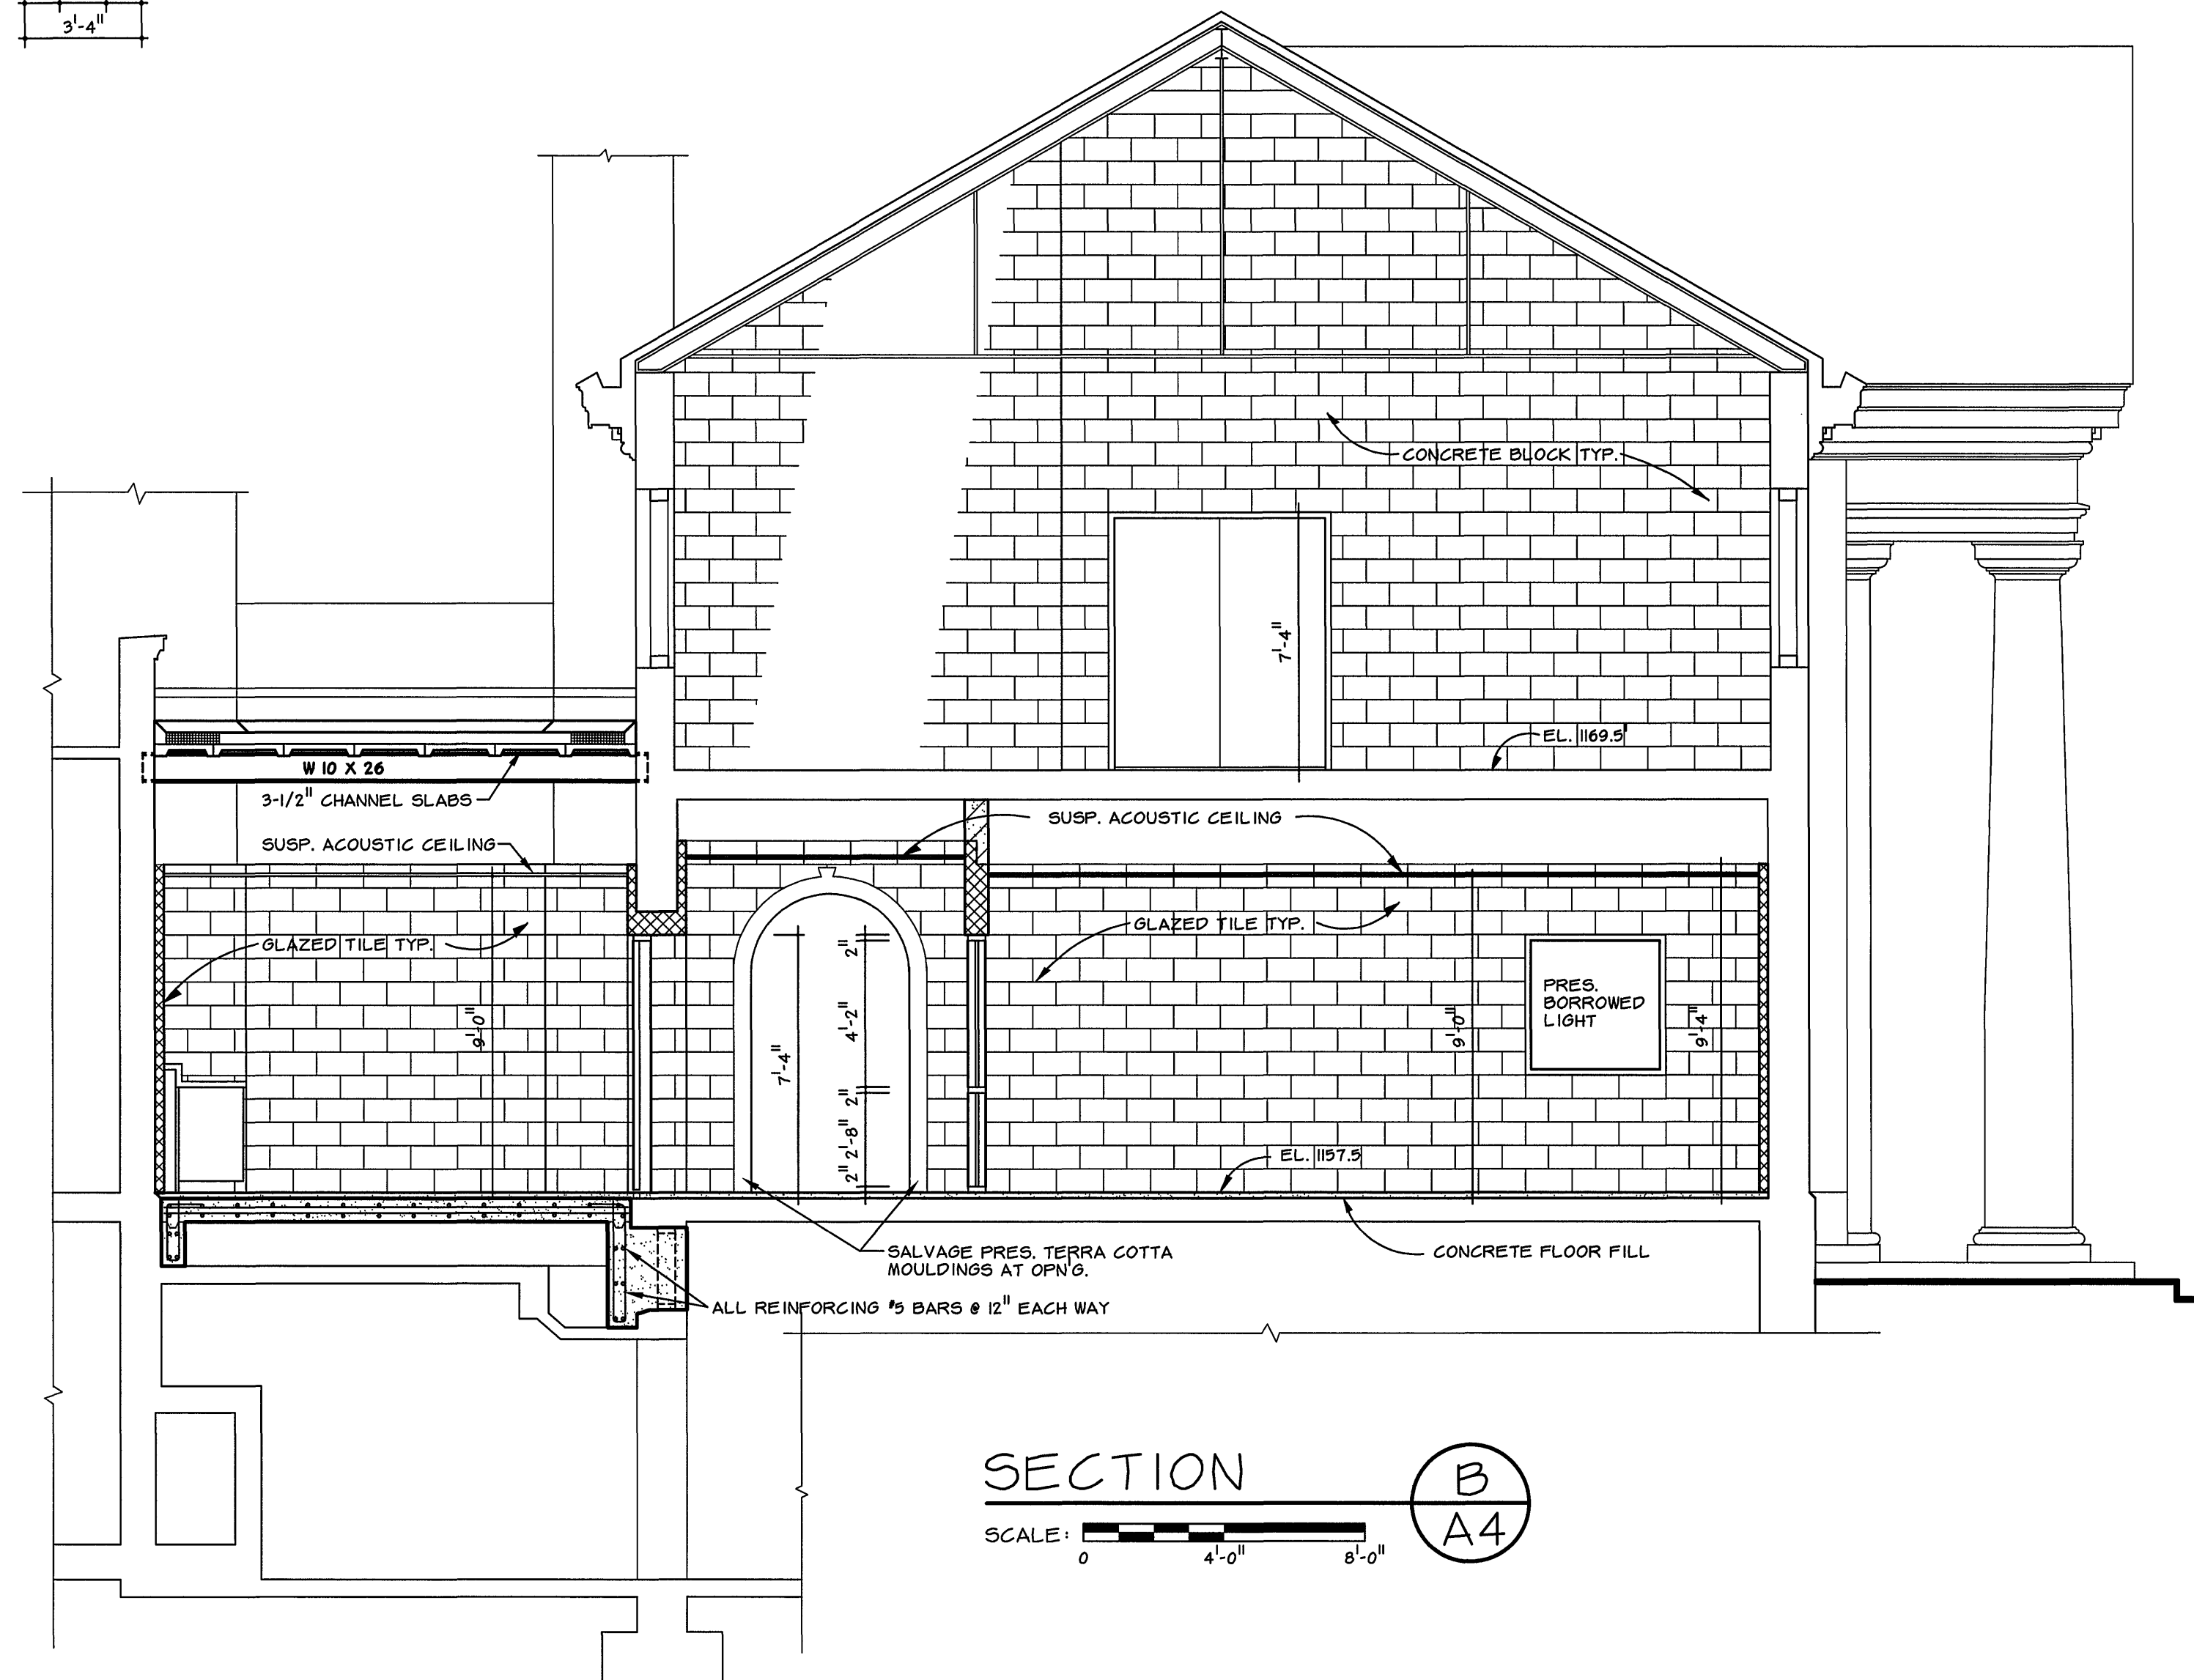

DRAWING OF RECORD
DATE: SEP 30 1997

MATTERN & CRAIG
CONSULTING ENGINEERS • SURVEYORS
ROANOKE VIRGINIA

ALVORD, BURDICK & HOWSON
ENGINEERS CHICAGO

DESIGNED:
DRAWN:
CHECKED:



REV.	DATE	DESCRIPTION	BY	APP.

CARVINS COVE FILTER PLANT IMPROVEMENTS – PHASE I
ROANOKE, VIRGINIA

ADMINISTRATION BUILDING
SECTIONS & DETAILS

DATE
APRIL 1992
COMM. NO.
9130
SHEET
A6