

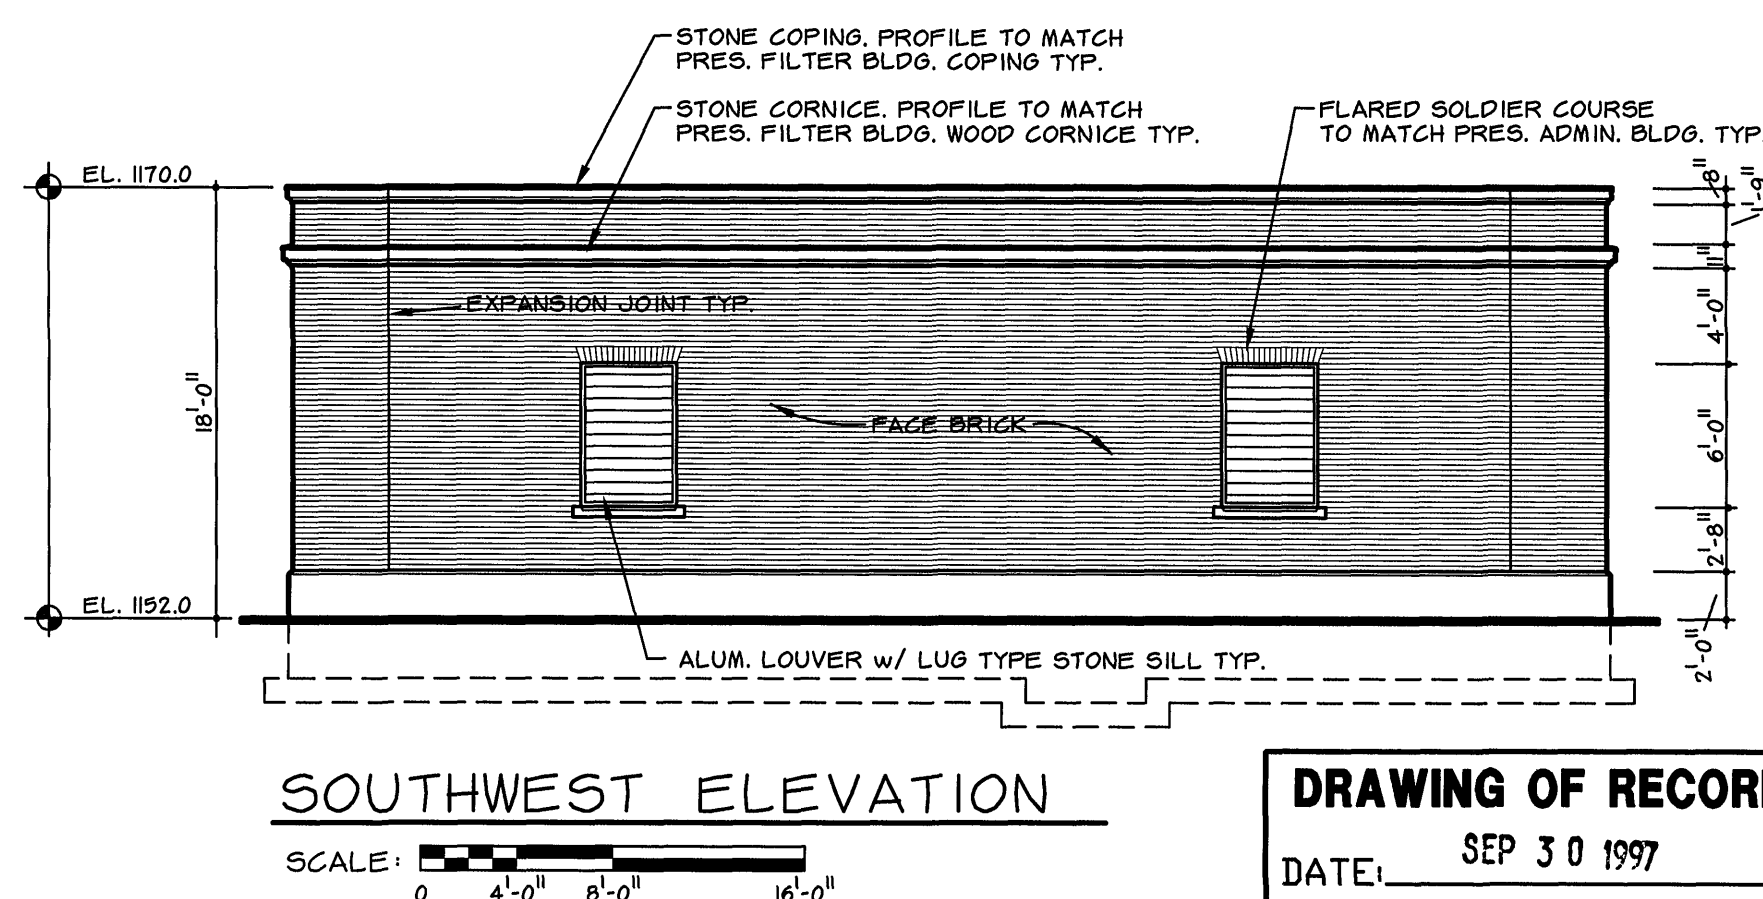
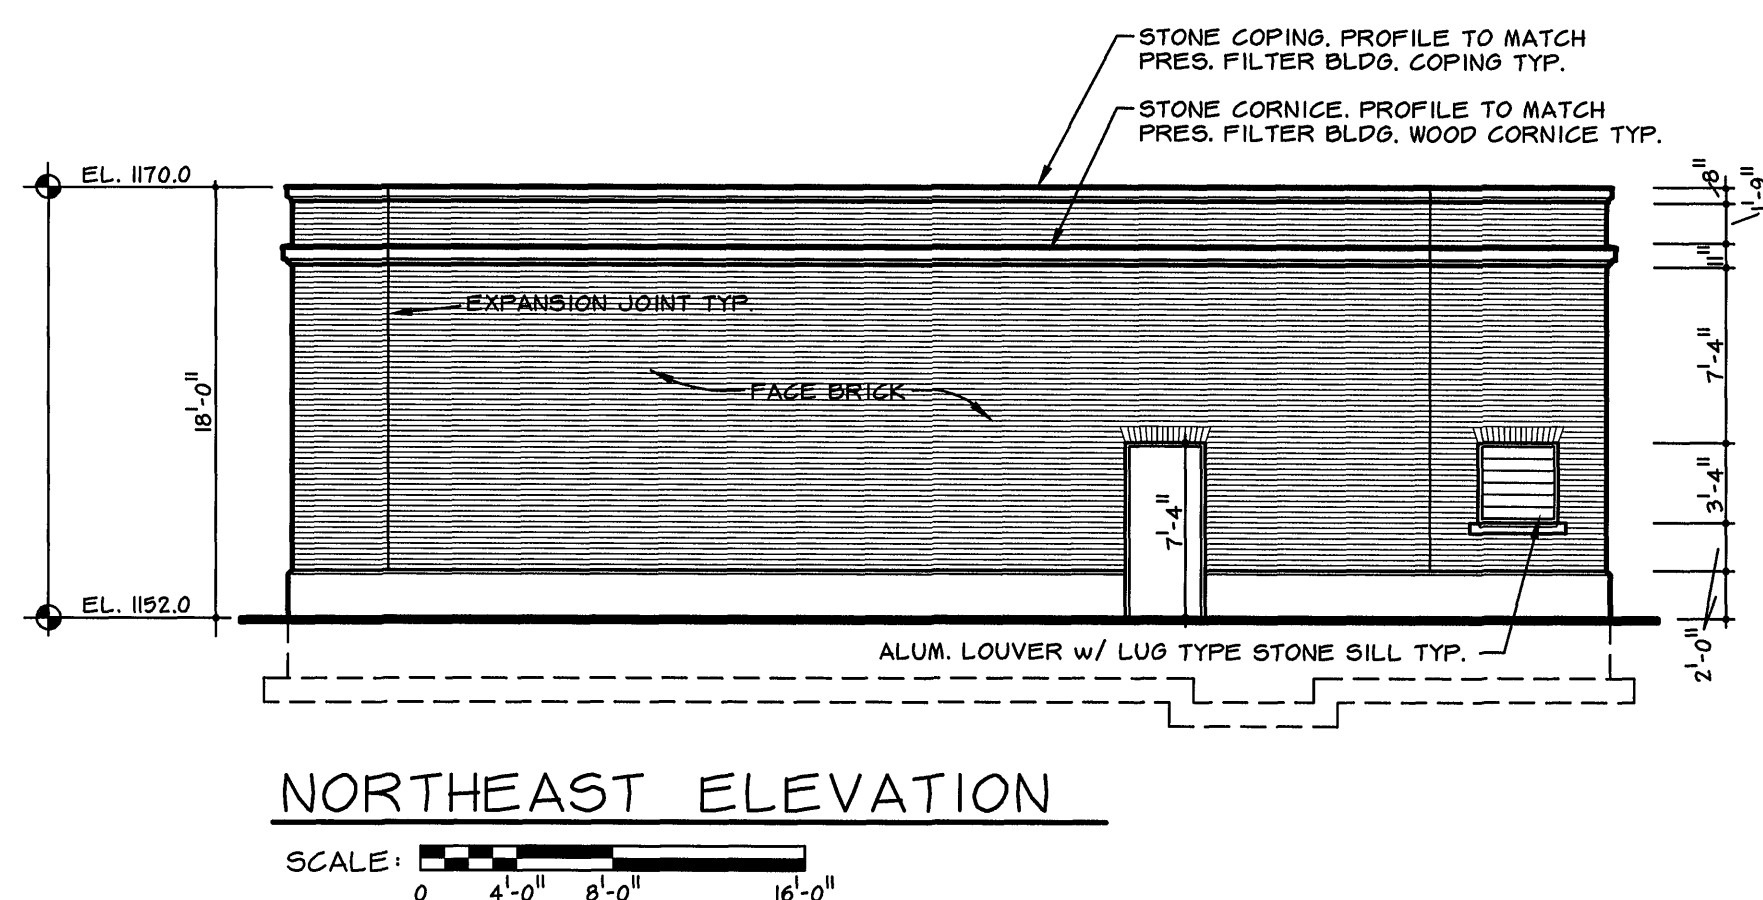
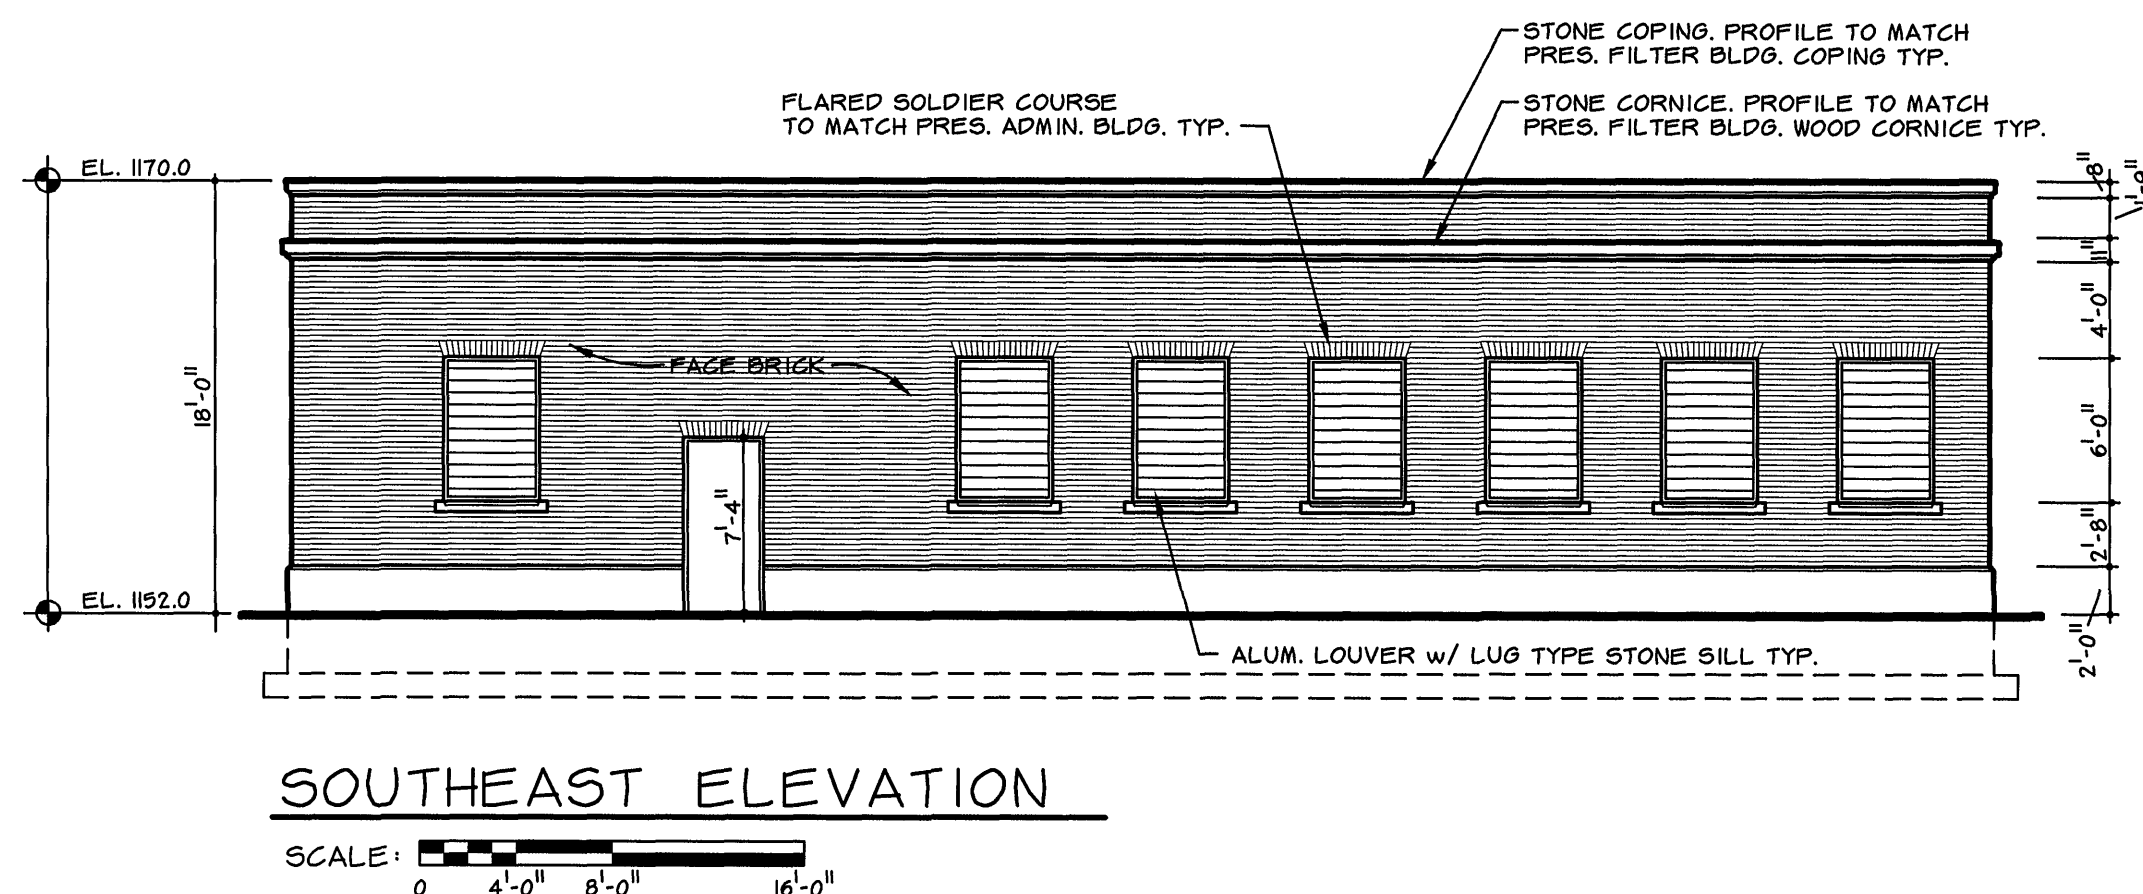


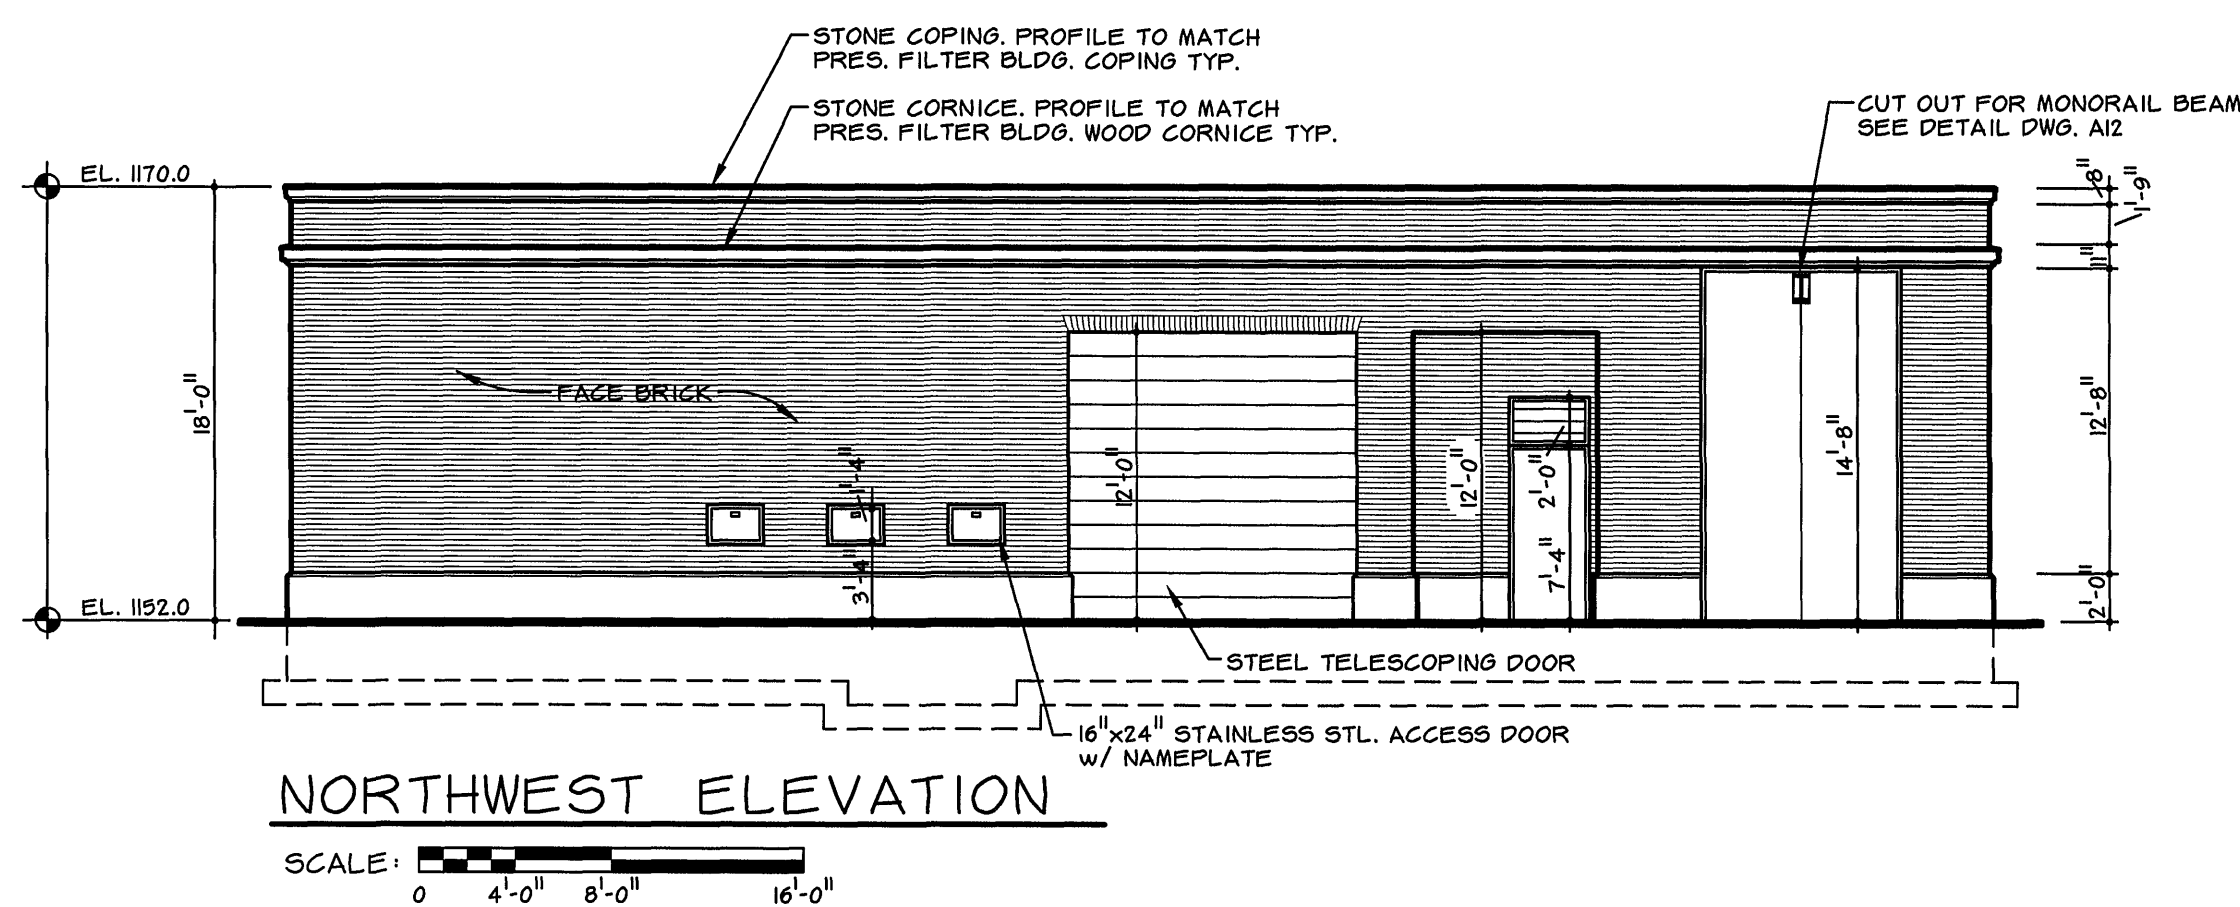

DRAWING OF RECORD
DATE: SEP 30 1997

LINTEL SCHEDULE

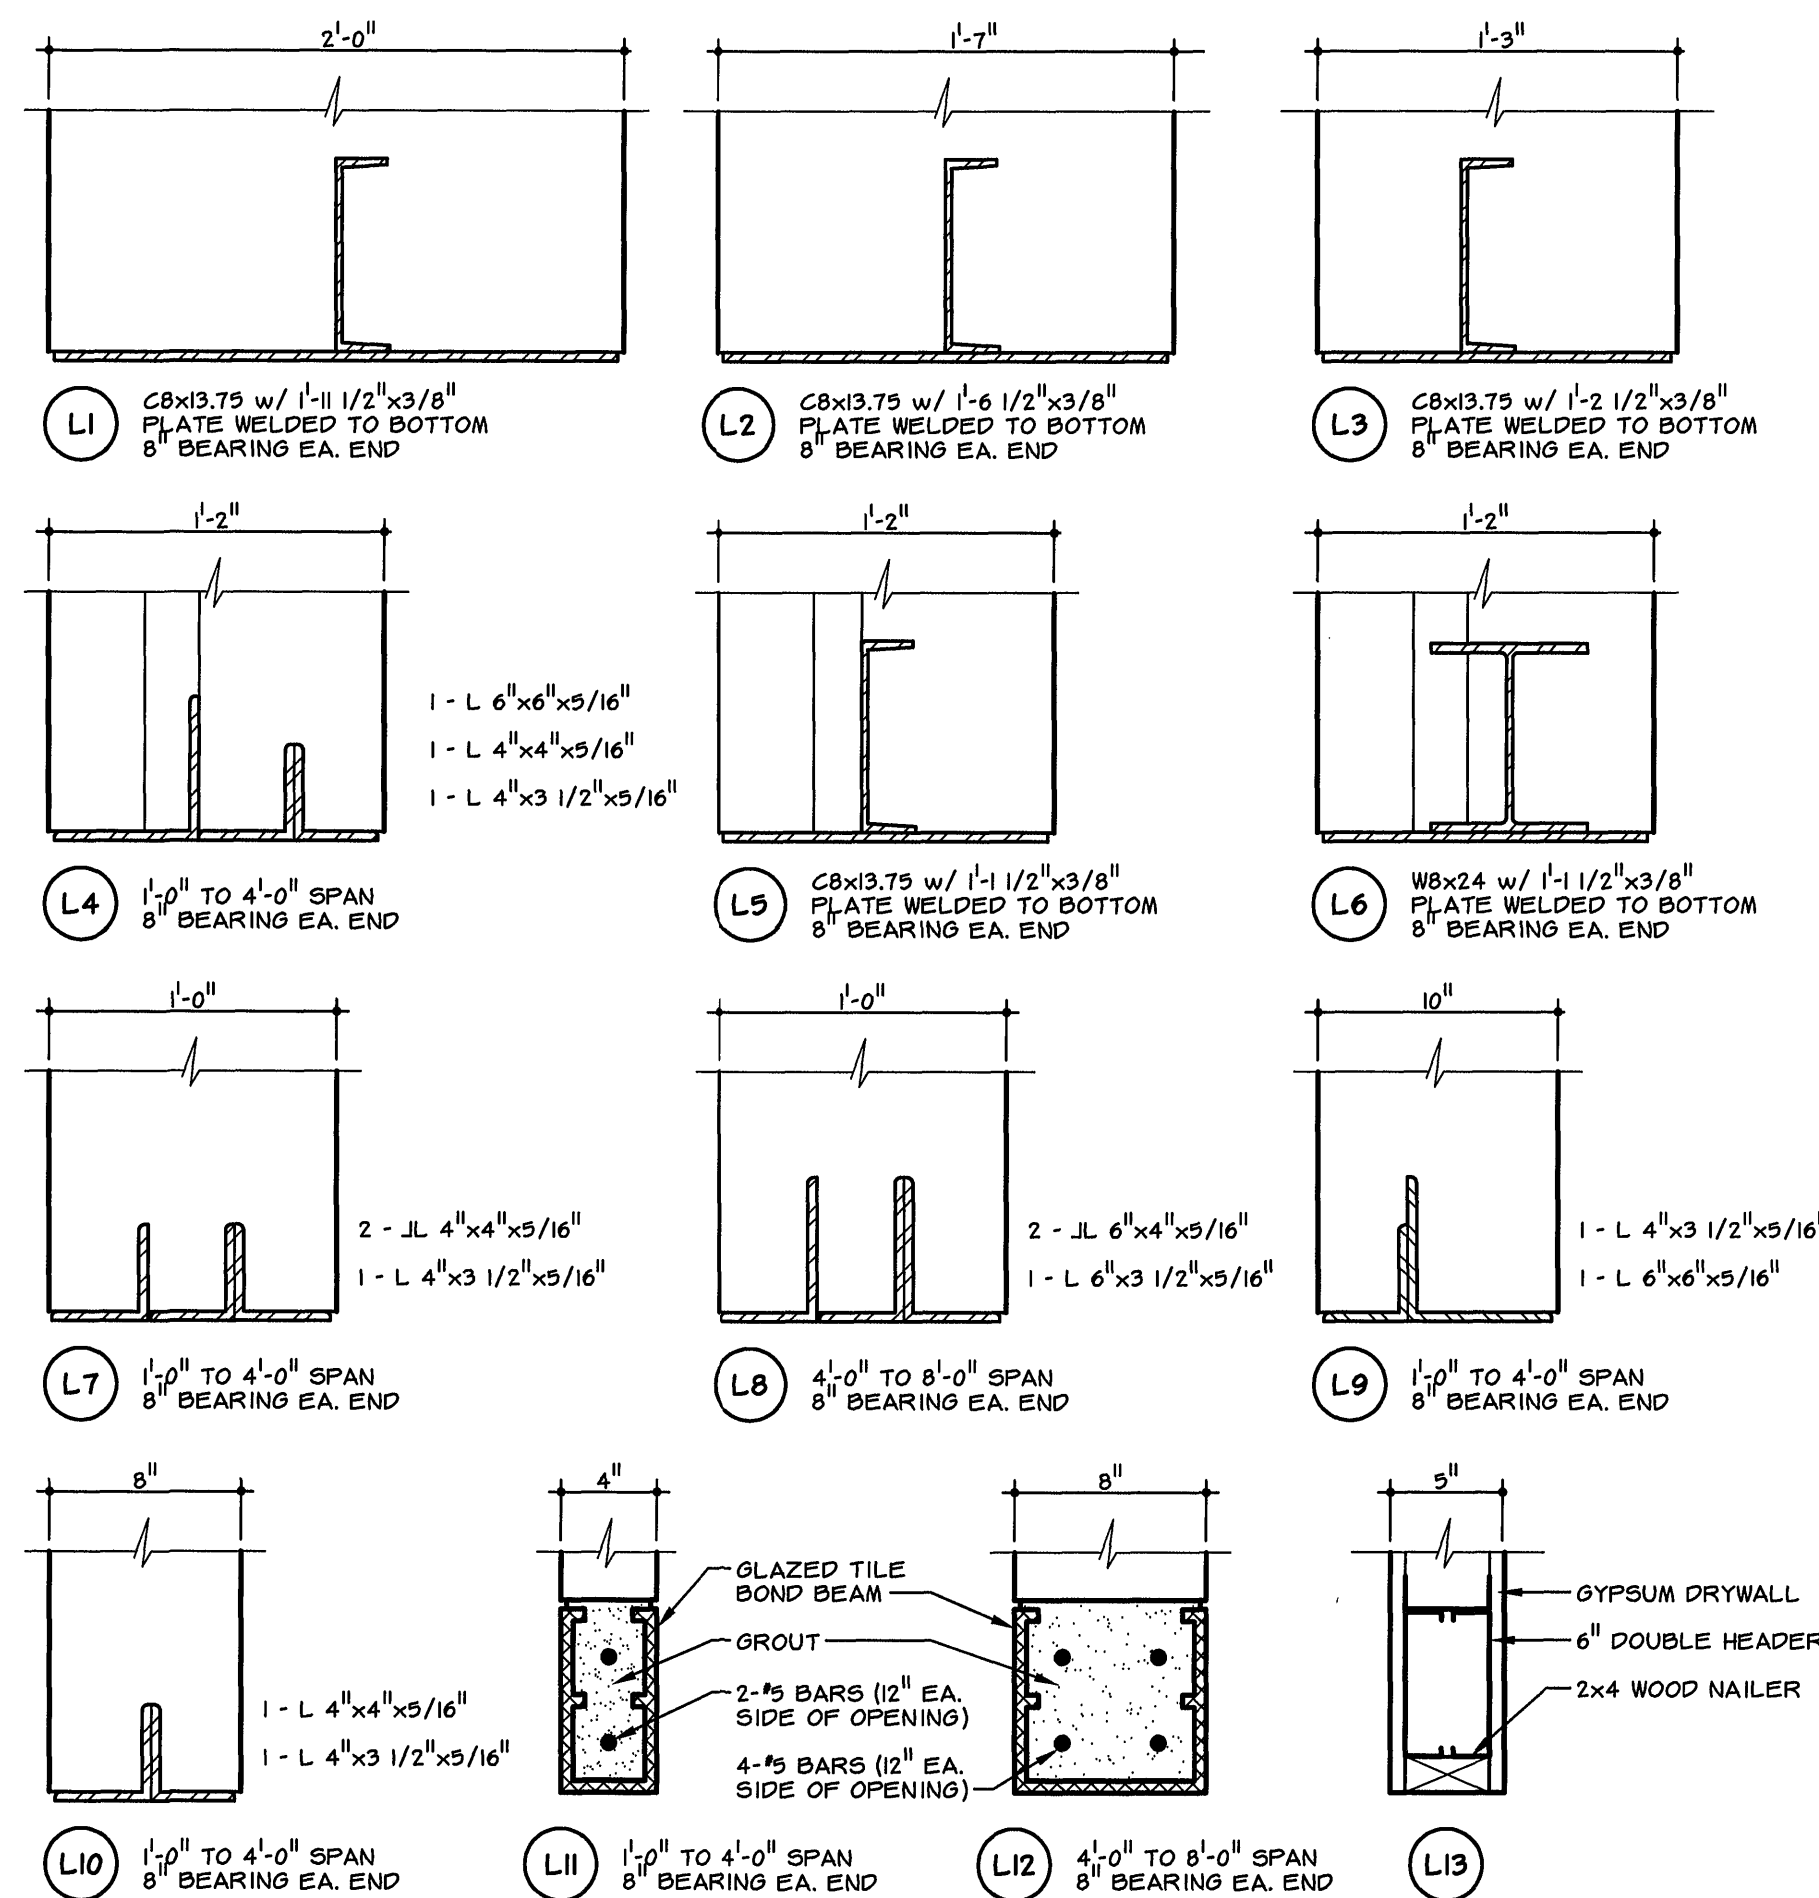

DOOR SCHEDULE

DOOR NO.	SIZE	MATERIAL	FRAME	FINISH	REMARKS
D1	1 PR.- 2'-10 ¹¹ x 7'-2 ¹¹ x 1 3/4 ¹¹ 5'-8 ¹¹ x 7'-4 ¹¹ PRES. M.O.	HALF GLAZE FLUSH WOOD	WOOD	STAIN & POLYURETHANE	1/4 ¹¹ TEMPERED GLASS
D2	1 PR.- 3'-0 ¹¹ x 7'-2 ¹¹ x 1 3/4 ¹¹ 6'-4 ¹¹ x 7'-4 ¹¹ M.O.	FLUSH WOOD	STEEL	STAIN & POLYURETHANE	B-LABEL - PAINT FRAME TO MATCH WOOD FINISH
D3	3'-0 ¹¹ x 7'-2 ¹¹ x 1 3/4 ¹¹ 3'-4 ¹¹ x 7'-4 ¹¹ M.O.	FLUSH WOOD	WOOD	STAIN & POLYURETHANE	12 ¹¹ x18 ¹¹ WOOD GRILLE
D4	3'-0 ¹¹ x 7'-2 ¹¹ x 1 3/4 ¹¹ 3'-4 ¹¹ x 7'-4 ¹¹ M.O.	FLUSH WOOD	STEEL	STAIN & POLYURETHANE	3 ¹¹ x33 ¹¹ VISION PANEL w/ 1/4 ¹¹ WIRE GLASS PAINT FRAME TO MATCH WOOD FINISH
D5	3'-0 ¹¹ x 7'-2 ¹¹ x 1 3/4 ¹¹ 3'-4 ¹¹ x 7'-4 ¹¹ M.O.	HALF GLAZE FLUSH WOOD	WOOD	STAIN & POLYURETHANE	1/4 ¹¹ TEMPERED GLASS
D6	3'-0 ¹¹ x 7'-2 ¹¹ x 1 3/4 ¹¹ 3'-4 ¹¹ x 7'-4 ¹¹ M.O.	FLUSH WOOD	WOOD	STAIN & POLYURETHANE	
D7	1 PR.- 2'-8 ¹¹ x 7'-2 ¹¹ x 1 3/4 ¹¹ 5'-8 ¹¹ x 7'-4 ¹¹ R.O.	FLUSH WOOD	WOOD	STAIN & POLYURETHANE	SLIDING DOOR HARDWARE w/ OAK PULLS
D8	1 PR.- 10 ¹¹ x 7'-2 ¹¹ x 1 3/4 ¹¹ 2'-0 ¹¹ x 7'-4 ¹¹ M.O.	FLUSH WOOD	WOOD	STAIN & POLYURETHANE	FOLDING DOOR HARDWARE w/ WOOD PULLS
D9	3'-0 ¹¹ x 7'-2 ¹¹ x 1 3/4 ¹¹	FULL GLAZE ALUMINUM	ALUMINUM	DURANODIC BRONZE	3/8 ¹¹ TEMPERED GLASS
D10	3'-0 ¹¹ x 7'-2 ¹¹ x 1 3/4 ¹¹ 3'-4 ¹¹ x 7'-4 ¹¹ M.O.	FLUSH STEEL	STEEL	PAINT	PANIC HARDWARE
D11	3'-0 ¹¹ x 7'-2 ¹¹ x 1 3/4 ¹¹ 3'-4 ¹¹ x 7'-4 ¹¹ M.O.	FLUSH STEEL	STEEL	PAINT	
D12	3'-0 ¹¹ x 7'-2 ¹¹ x 1 3/4 ¹¹ 3'-4 ¹¹ x 7'-4 ¹¹ M.O.	HALF GLAZE FLUSH STEEL	STEEL	PAINT	1/4 ¹¹ TEMPERED GLASS PANIC HARDWARE
D13	1 PR.- 3'-0 ¹¹ x 7'-2 ¹¹ x 1 3/4 ¹¹ 6'-4 ¹¹ x 7'-4 ¹¹ M.O.	FLUSH STEEL	STEEL	PAINT	A-LABEL DOOR & FRAME
D14	1 PR.- 4'-0 ¹¹ x 14'-6 ¹¹ x 1 3/4 ¹¹ 8'-4 ¹¹ x 14'-8 ¹¹ M.O.	FLUSH STEEL	STEEL	PAINT	PANIC HARDWARE
D15	12'-0 ¹¹ x 12'-0 ¹¹	GALV. STEEL	STEEL	FACTORY FINISHED PANELS PAINT FRAME	TELESCOPING MOTOR OPERATED

ROOM FINISH SCHEDULE

BLDG.	ROOM NAME	FLOOR		WALLS	CEILING		REMARKS
		MATERIAL	BASE		MATERIAL	HEIGHT	
ADMINISTRATION BUILDING	ENTRY	PRES. FLOOR TO REMAIN	—	BRICK	—	—	REPAINT WALLS FULL HEIGHT OF HOISTWAY SHAFT
	CORRIDOR-1	QUARRY TILE	COVERED GLAZED TILE	GLAZED TILE	SUSPENDED ACOUSTIC	9'-0\"/>	PAIN ALL EXPOSED METAL STAIN & POLYURETHANE ALL WOOD
	LUNCH ROOM	QUARRY TILE	COVERED GLAZED TILE	GLAZED TILE	SUSPENDED ACOUSTIC	9'-0\"/>	STAIN & POLYURETHANE ALL WOOD
	STAIR	QUARRY TILE	COVERED GLAZED TILE	GLAZED TILE	SUSPENDED ACOUSTIC	8'-0\"/>	PAIN ALL EXPOSED METAL STAIN & POLYURETHANE ALL WOOD
	MEN'S LOCKER ROOM	TERRAZZO	COVERED GLAZED TILE	GLAZED TILE	SUSPENDED CEMENT PLASTER PAINTED	8'-0\"/>	STAIN & POLYURETHANE ALL WOOD
	WOMEN'S LOCKER ROOM	TERRAZZO	COVERED GLAZED TILE	GLAZED TILE	SUSPENDED CEMENT PLASTER PAINTED	8'-0\"/>	STAIN & POLYURETHANE ALL WOOD
	VESTIBULE	QUARRY TILE	COVERED GLAZED TILE	GLAZED TILE	SUSPENDED ACOUSTIC	9'-8\"/>	SALVAGE TERRA COTTA MOULDINGS, STAIN & POLYURETHANE ALL WOOD
	CONTROL ROOM	CARPET	COVERED GLAZED TILE	GLAZED TILE	SUSPENDED ACOUSTIC	9'-0\"/>	1/4\"/>
	CHEMICAL LAB	RESILIENT TILE	COVERED GLAZED TILE	GLAZED TILE	SUSPENDED ACOUSTIC	9'-0\"/>	STAIN & POLYURETHANE ALL WOOD, VINYL BASE AT ALL CABINETS
	BACTERIOLOGICAL LAB	RESILIENT TILE	COVERED GLAZED TILE	GLAZED TILE	SUSPENDED ACOUSTIC	9'-0\"/>	STAIN & POLYURETHANE ALL WOOD, VINYL BASE AT ALL CABINETS
	OFFICE-1	CARPET	WOOD	PAINTED GYPSUM BOARD	SUSPENDED ACOUSTIC	8'-0\"/>	STAIN & POLYURETHANE ALL WOOD, REPAINT WINDOWS & TRIM
	OFFICE-2	CARPET	WOOD	PAINTED GYPSUM BOARD	SUSPENDED ACOUSTIC	8'-0\"/>	STAIN & POLYURETHANE ALL WOOD, REPAINT WINDOWS & TRIM
	HVAC	PRES. FLOOR TO REMAIN	—	BRICK & CONC. BLOCK	—	—	PAIN ALL MASONRY & METALWORK, STAIN & POLYURETHANE ALL WOOD
CHEMICAL BUILDING 1	STORAGE	PRES. FLOOR TO REMAIN	—	BRICK & CONC. BLOCK	—	—	PAIN ALL MASONRY & METALWORK, STAIN & POLYURETHANE ALL WOOD
	ELECTRICAL	PRES. FLOOR TO REMAIN	—	BRICK & CONC. BLOCK	—	—	PAIN ALL MASONRY & METALWORK, STAIN & POLYURETHANE ALL WOOD
	CORRIDOR-2	QUARRY TILE	WOOD	PAINTED GYPSUM BOARD	SUSPENDED ACOUSTIC	8'-0\"/>	PAIN ALL EXPOSED METAL STAIN & POLYURETHANE ALL WOOD
	JANITOR'S CLOSET	TERRAZZO	COVERED GLAZED TILE	GLAZED TILE	—	—	PAIN EXPOSED STRUCTURE & METALWORK
	VESTIBULE	CONC.	—	CONC. BLOCK PAINTED	EXPOSED STRUCTURE	—	PAIN ALL METAL & STRUCTURAL STEEL
	CHLORINATOR ROOM	CONC.	—	CONC. BLOCK PAINTED	EXPOSED STRUCTURE	—	PAIN ALL METAL & STRUCTURAL STEEL
	CL ₂ CYLINDER STORAGE	CONC.	—	CONC. BLOCK PAINTED	EXPOSED STRUCTURE	—	PAIN ALL METAL & STRUCTURAL STEEL
	JANITOR'S CLOSET	CONC.	—	CONC. BLOCK PAINTED	SUSPENDED CEMENT PLASTER PAINTED	9'-0\"/>	PAIN ALL METAL
	CARBON FEED ROOM	CONC.	—	CONC. BLOCK PAINTED	EXPOSED STRUCTURE	—	PAIN ALL METAL & STRUCTURAL STEEL
	ELECTRICAL ROOM	CONC.	—	CONC. BLOCK PAINTED	EXPOSED STRUCTURE	—	PAIN ALL METAL & STRUCTURAL STEEL
	CHEMICAL STORAGE 1	CONC.	—	CONC. BLOCK PAINTED	EXPOSED STRUCTURE	—	PAIN ALL METAL & STRUCTURAL STEEL
	CHEMICAL STORAGE 2	CONC.	—	CONC. BLOCK PAINTED	EXPOSED STRUCTURE	—	PAIN ALL METAL & STRUCTURAL STEEL
	CHEMICAL BUILDING 2 CHEMICAL STORAGE	CONC.	—	CONC. BLOCK PAINTED	EXPOSED STRUCTURE	—	PAIN ALL METAL & STRUCTURAL STEEL
MISCELLANEOUS	CHEMICAL BUILDING 2 AMMONIATOR ROOM	CONC.	—	CONC. BLOCK PAINTED	EXPOSED STRUCTURE	—	PAIN ALL METAL & STRUCTURAL STEEL
	FLASH MIX BUILDING 1	CONC.	—	CONC. BLOCK PAINTED	EXPOSED STRUCTURE	—	PAIN ALL METAL & STRUCTURAL STEEL
	FLASH MIX BUILDING 2	CONC.	—	CONC. BLOCK PAINTED	EXPOSED STRUCTURE	—	PAIN ALL METAL & STRUCTURAL STEEL
	WASH WATER RATE CONTROLLER VAULT A	CONC.	—	CONC. BLOCK PAINTED	EXPOSED STRUCTURE	—	PAIN ALL METAL & STRUCTURAL STEEL

MATTEN & CRAIG
CONSULTING ENGINEERS • SURVEYORS
ROANOKE VIRGINIA

ALVORD, BURDICK & HOWSON
ENGINEERS CHICAGO

DESIGNED:
DRAWN:
CHECKED:



REV.	DATE	DESCRIPTION	BY	APP.

CARVINS COVE FILTER PLANT IMPROVEMENTS — PHASE I
ROANOKE, VIRGINIA

CHEMICAL BUILDING 1
ELEVATIONS & SCHEDULES

DATE
APRIL 1992
COMM. NO.
9130
SHEET
A8