




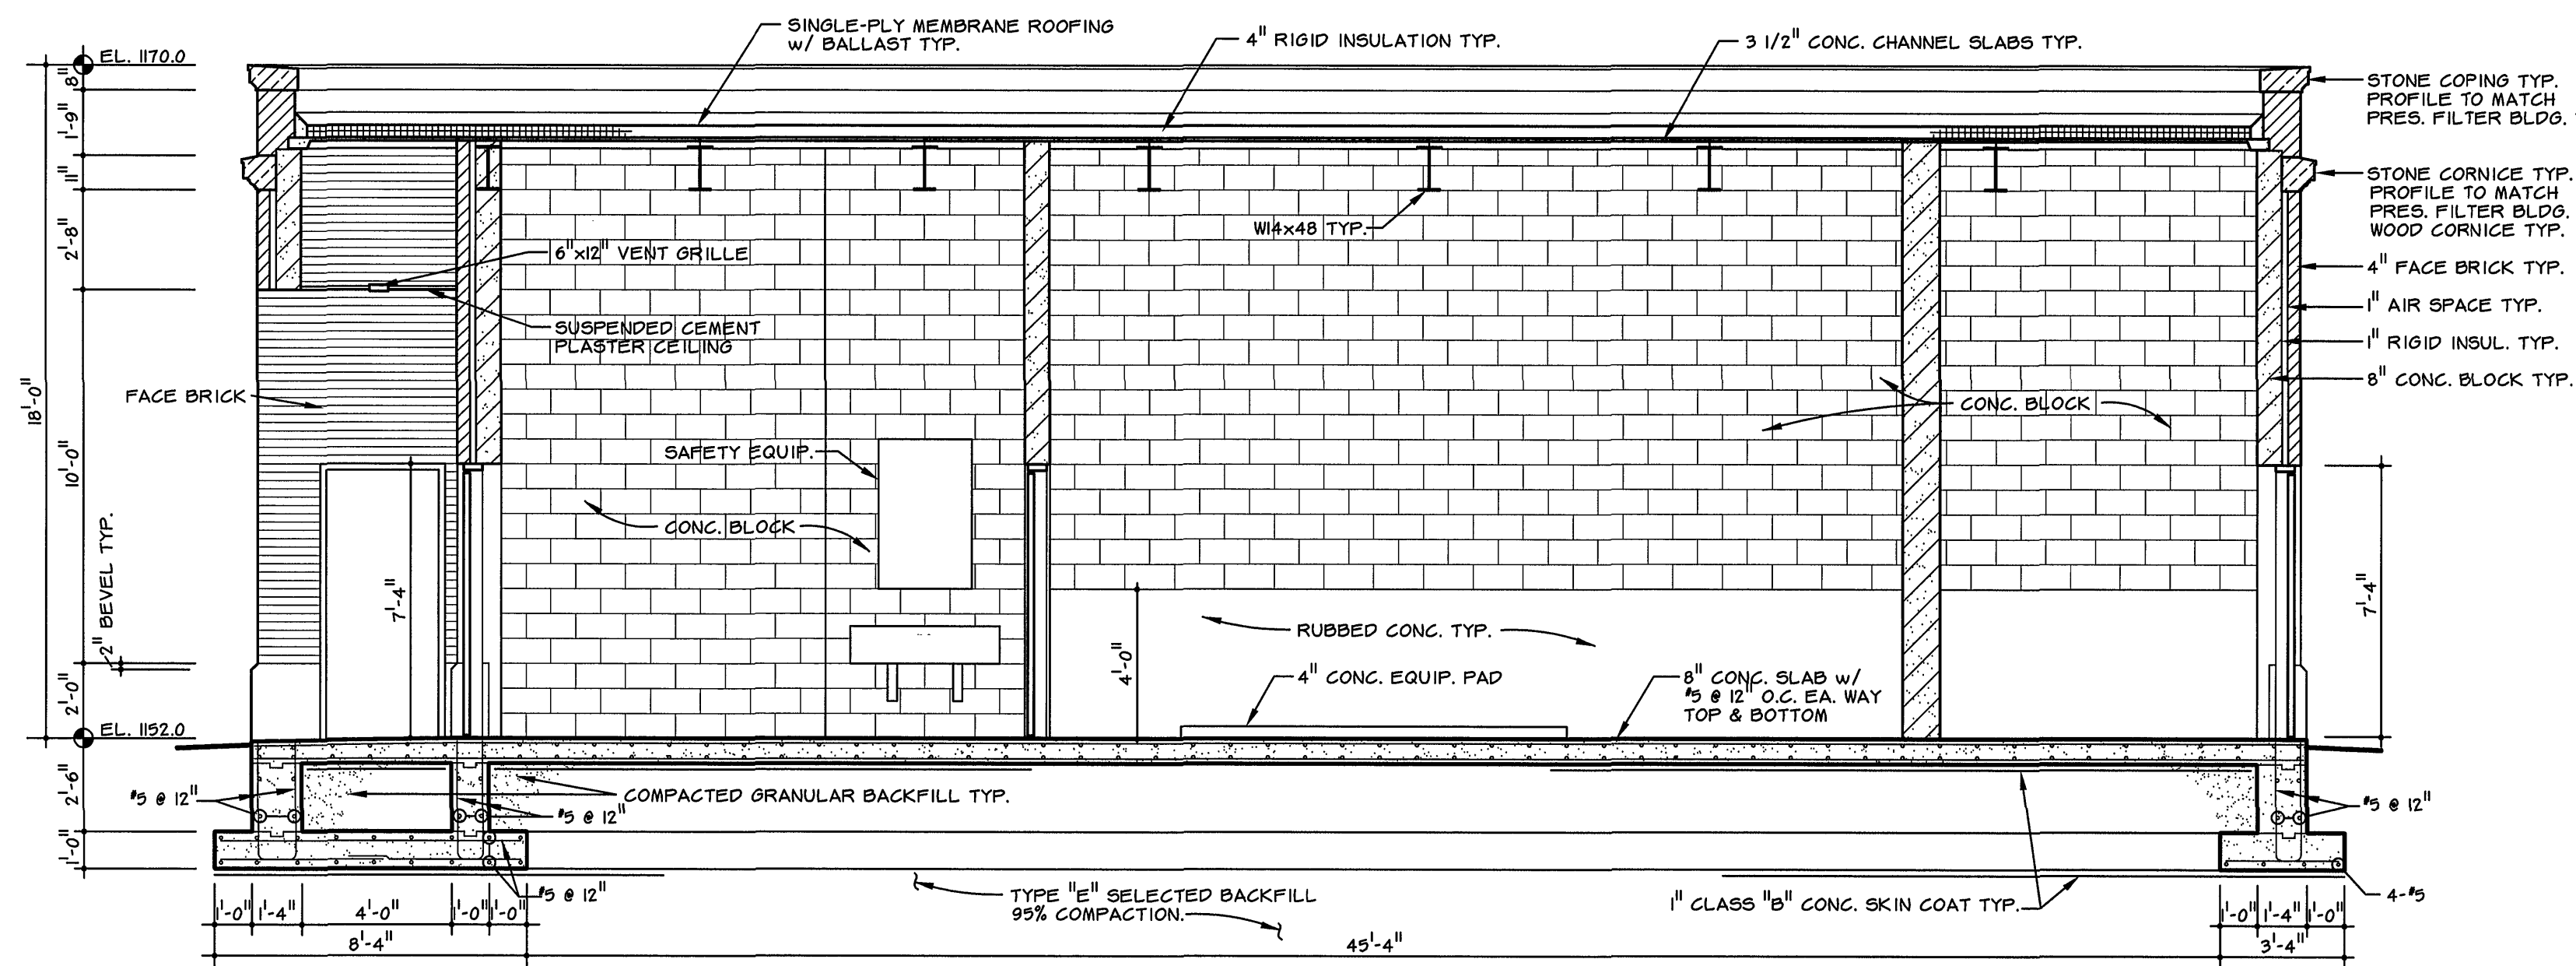


SECTION A9
SCALE: 0 4'-0" 8'-0"

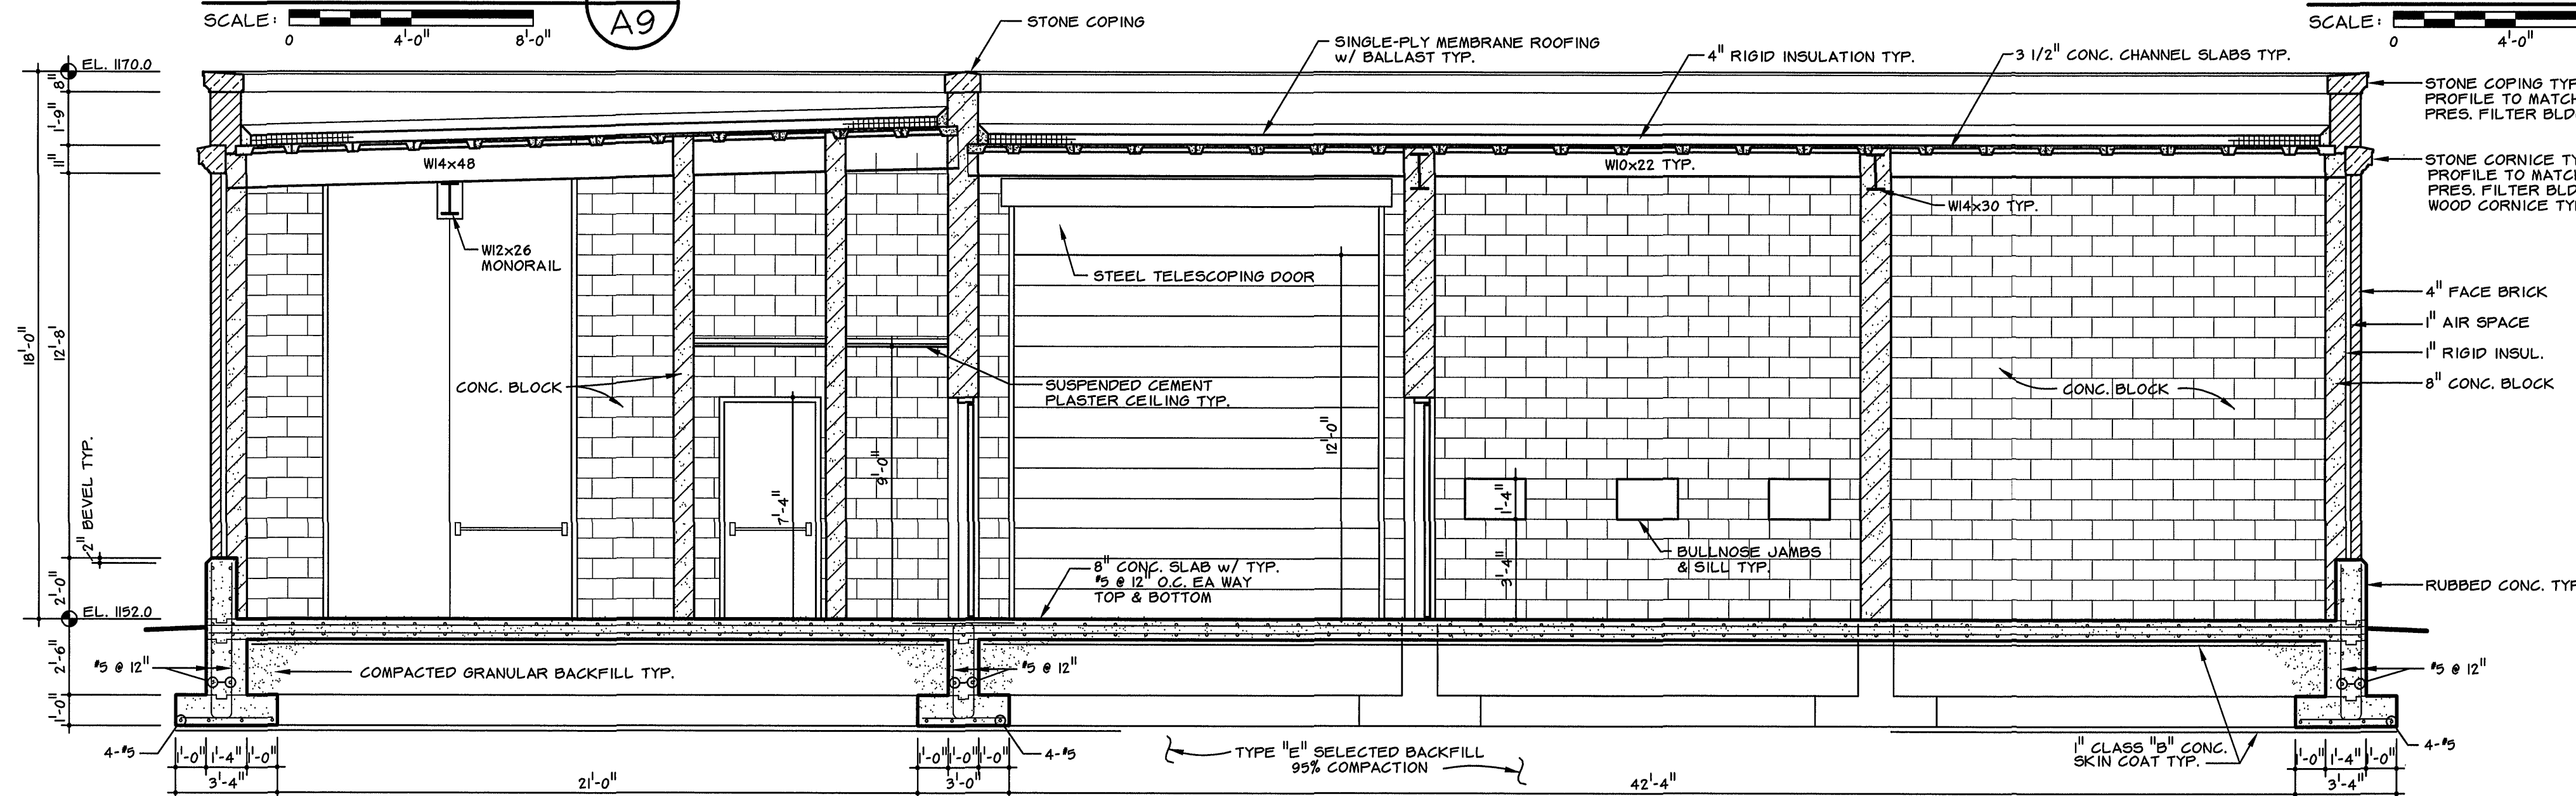


SECTION C
SCALE: 0 4'-0" 8'-0"

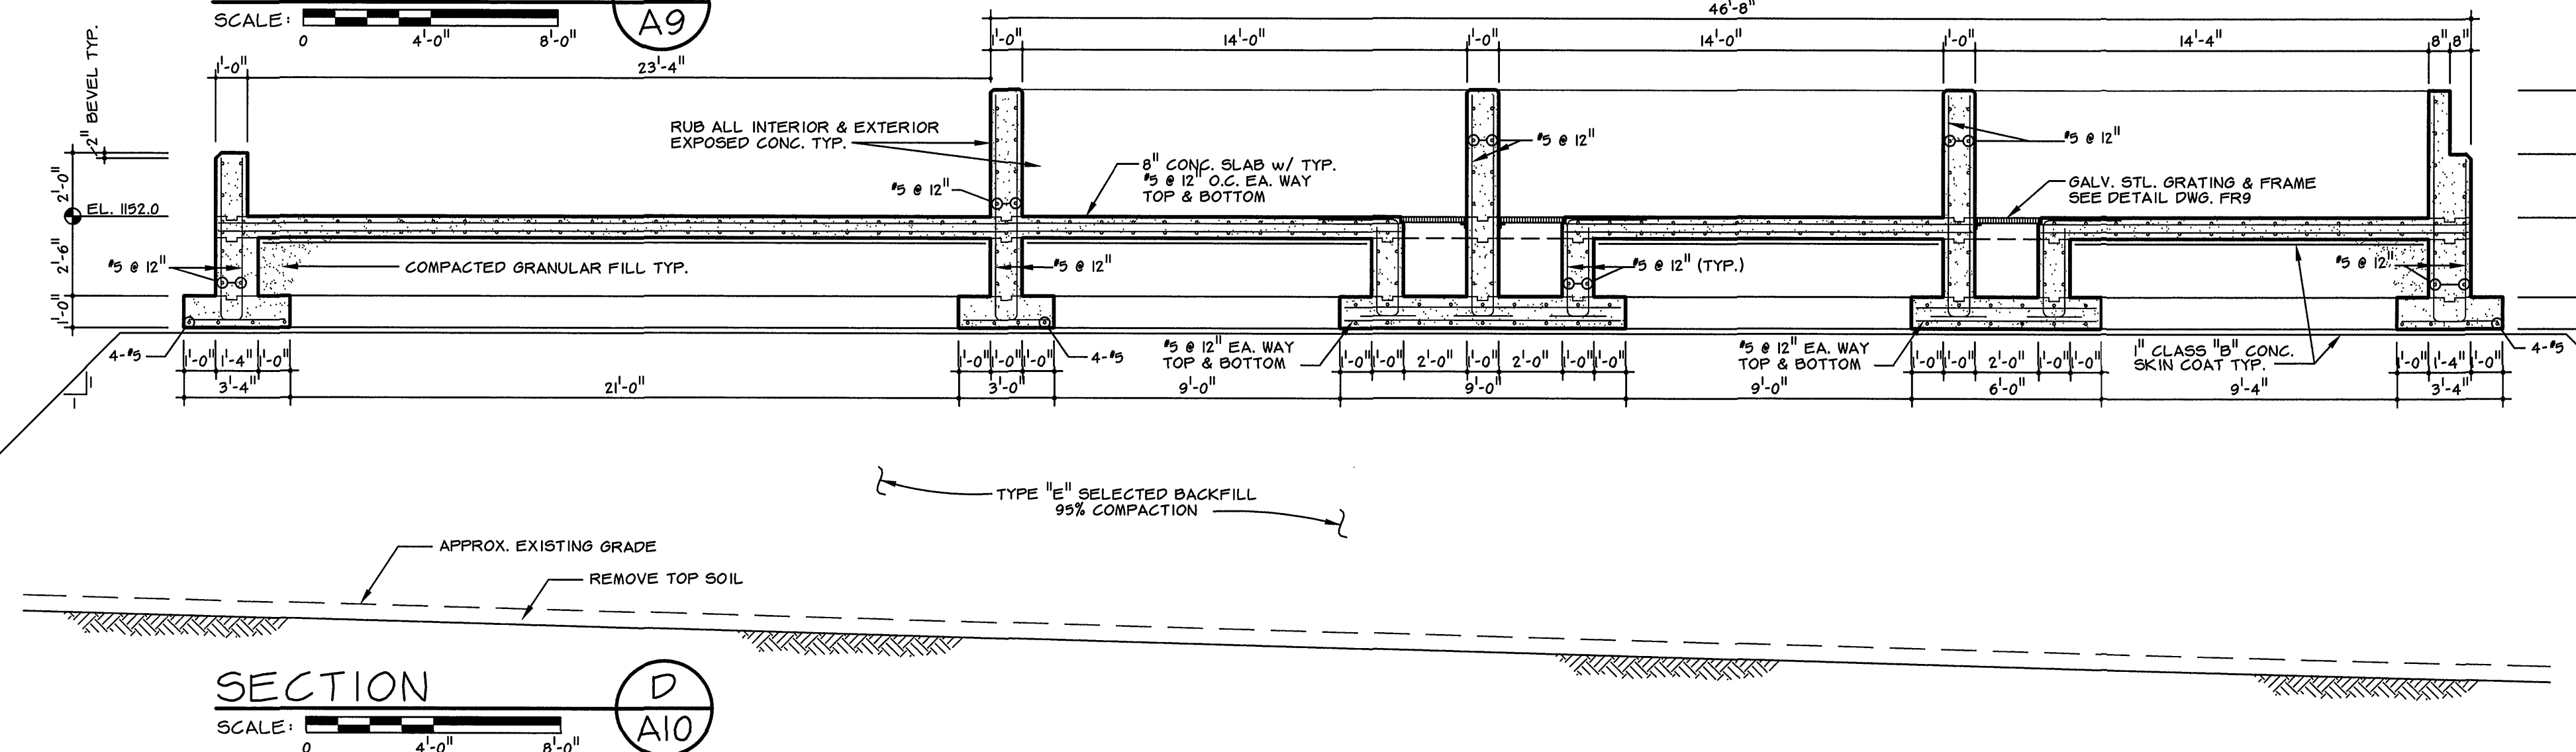

SECTION D
SCALE: 0 4'-0" 8'-0"

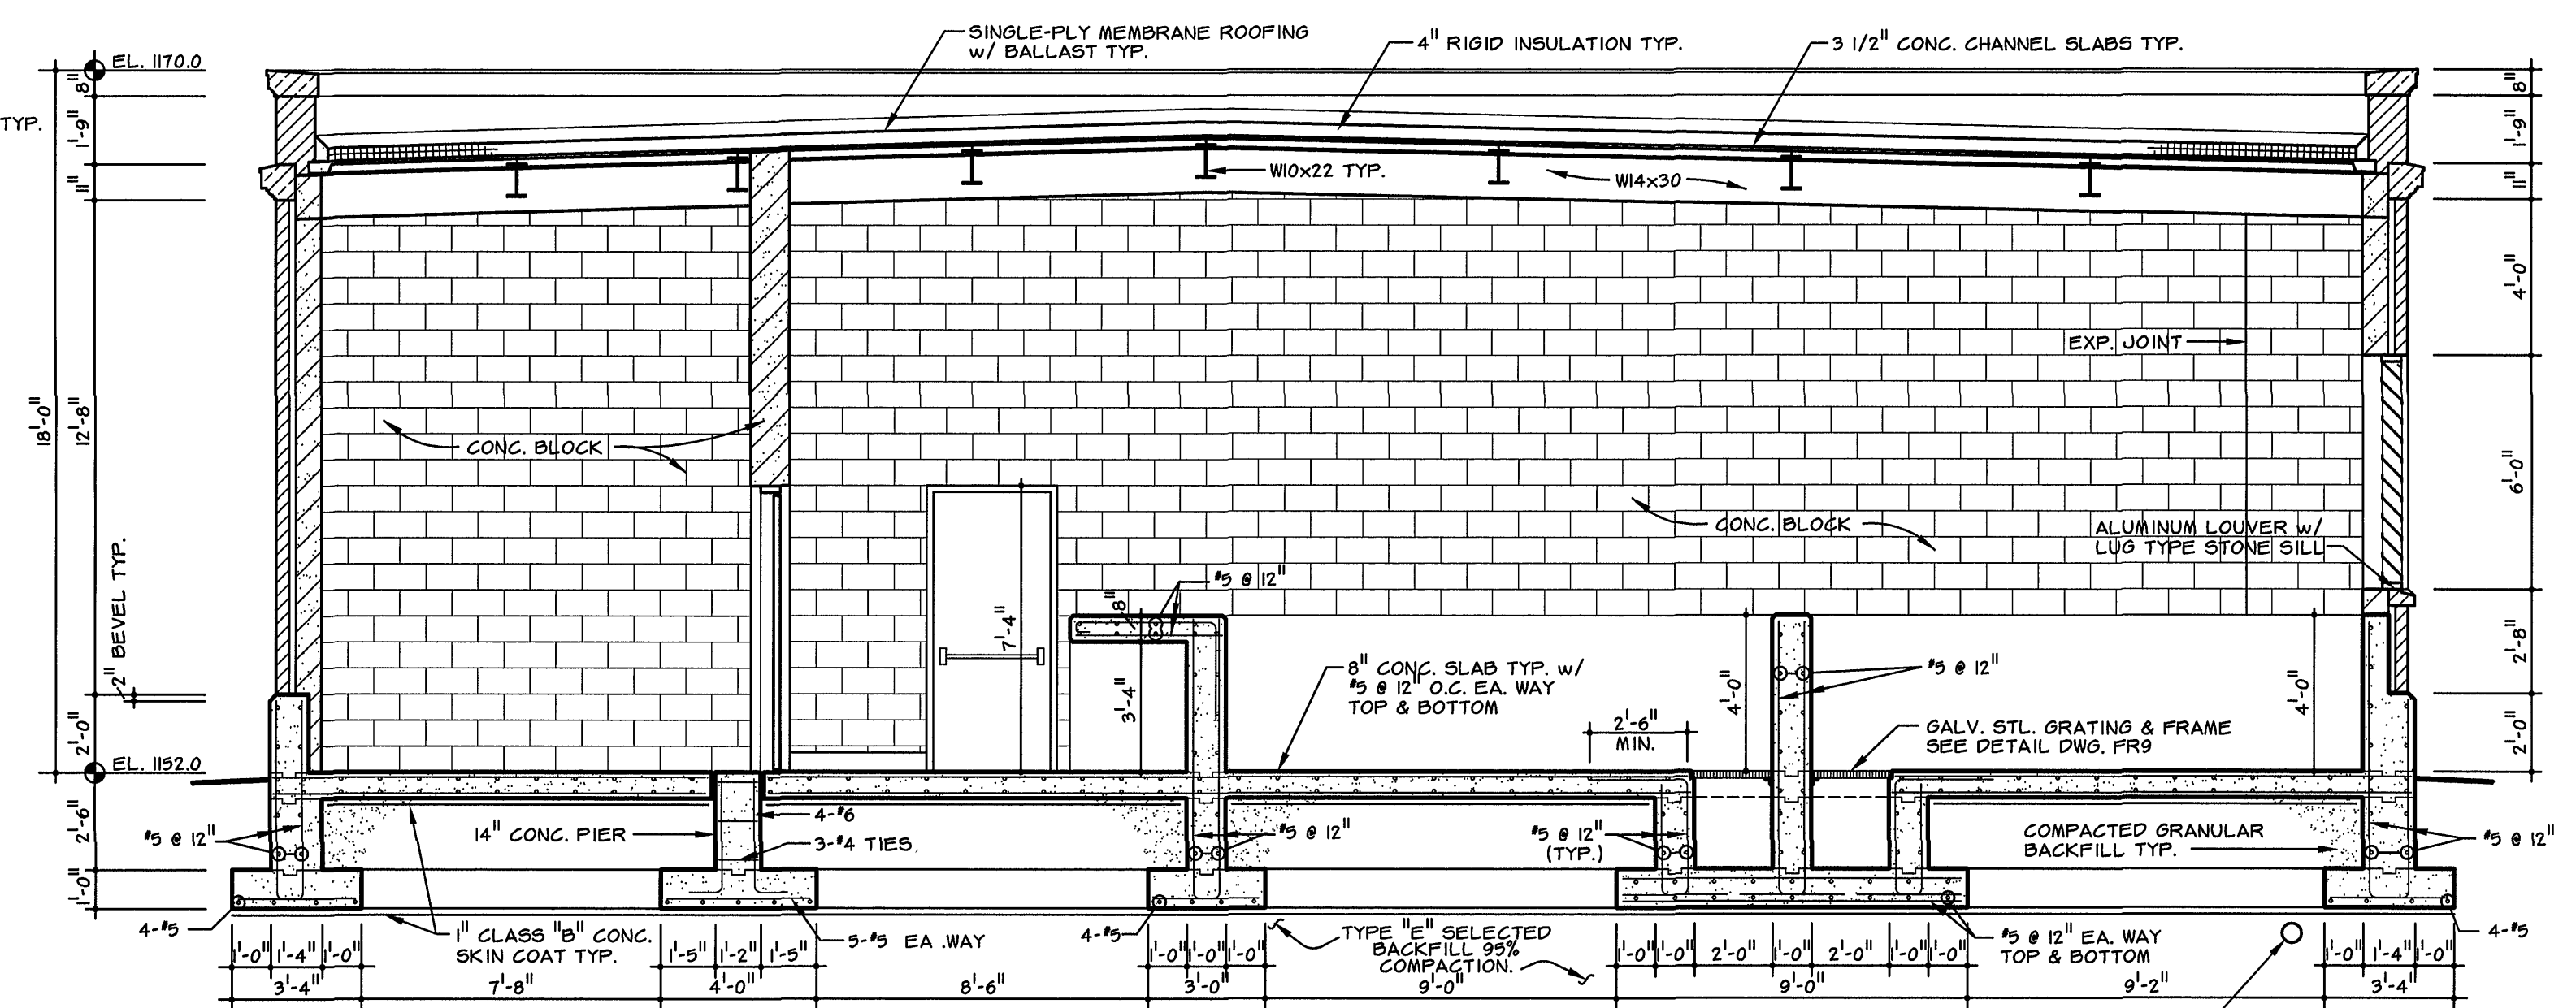


SECTION B
SCALE: 0 4'-0" 8'-0"

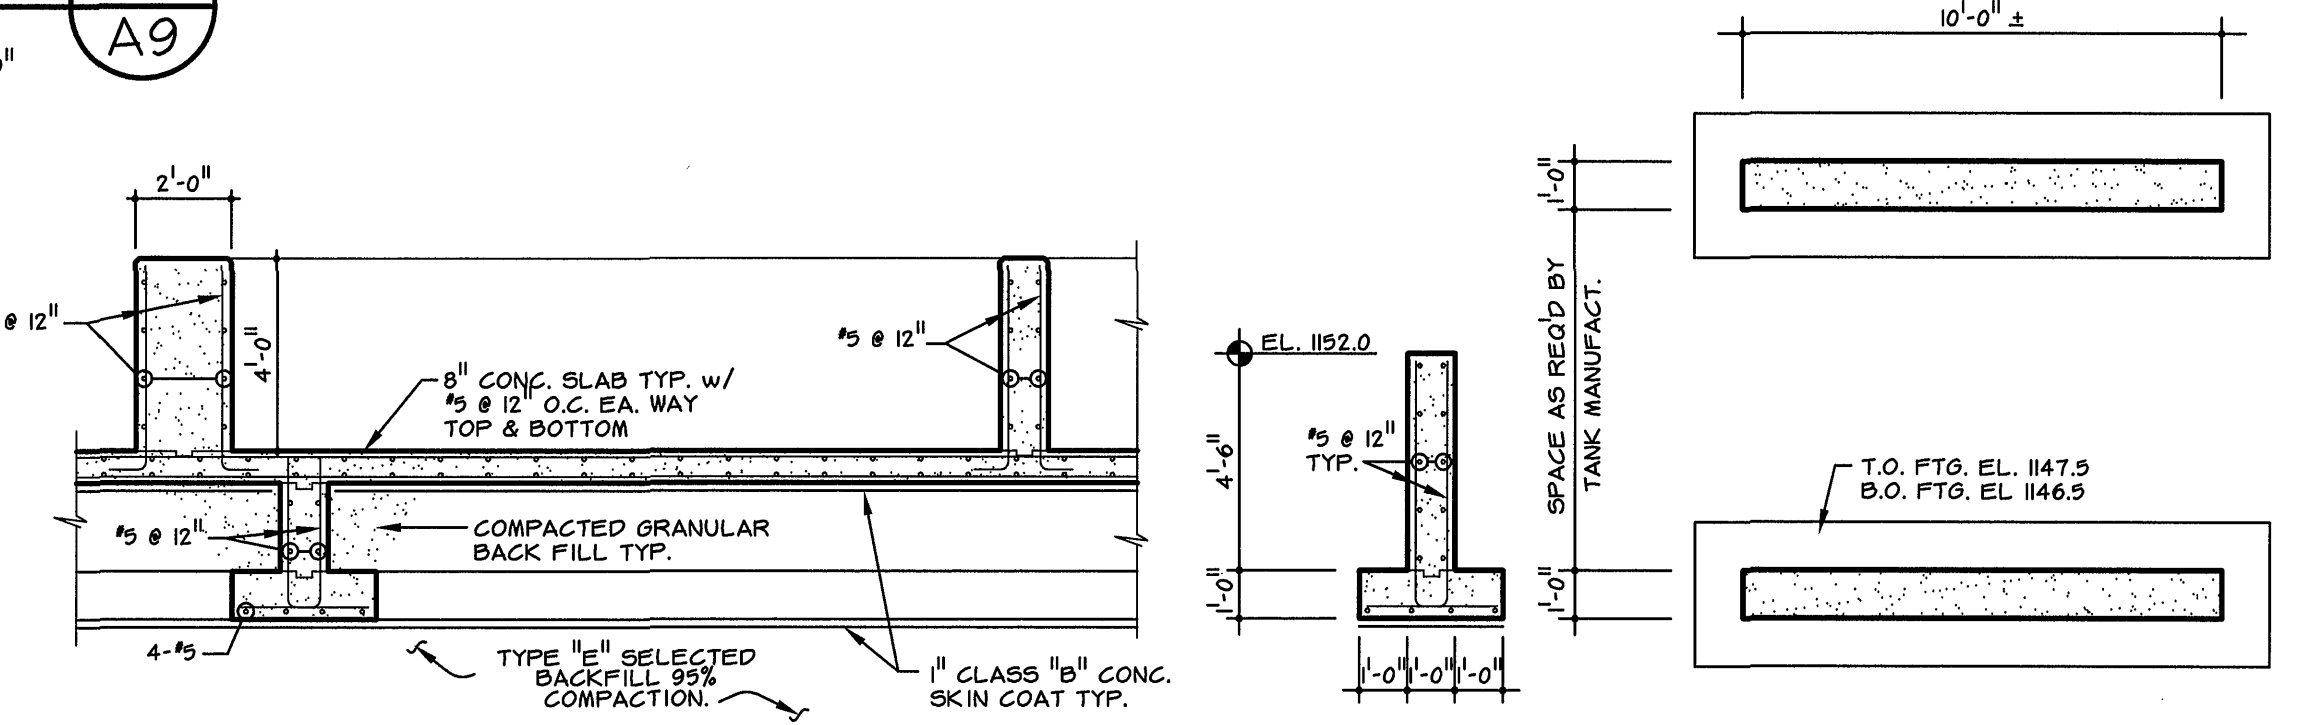


SECTION E
SCALE: 0 4'-0" 8'-0"

TANK SUPPORT DETAILS
SCALE: 0 4'-0" 8'-0"

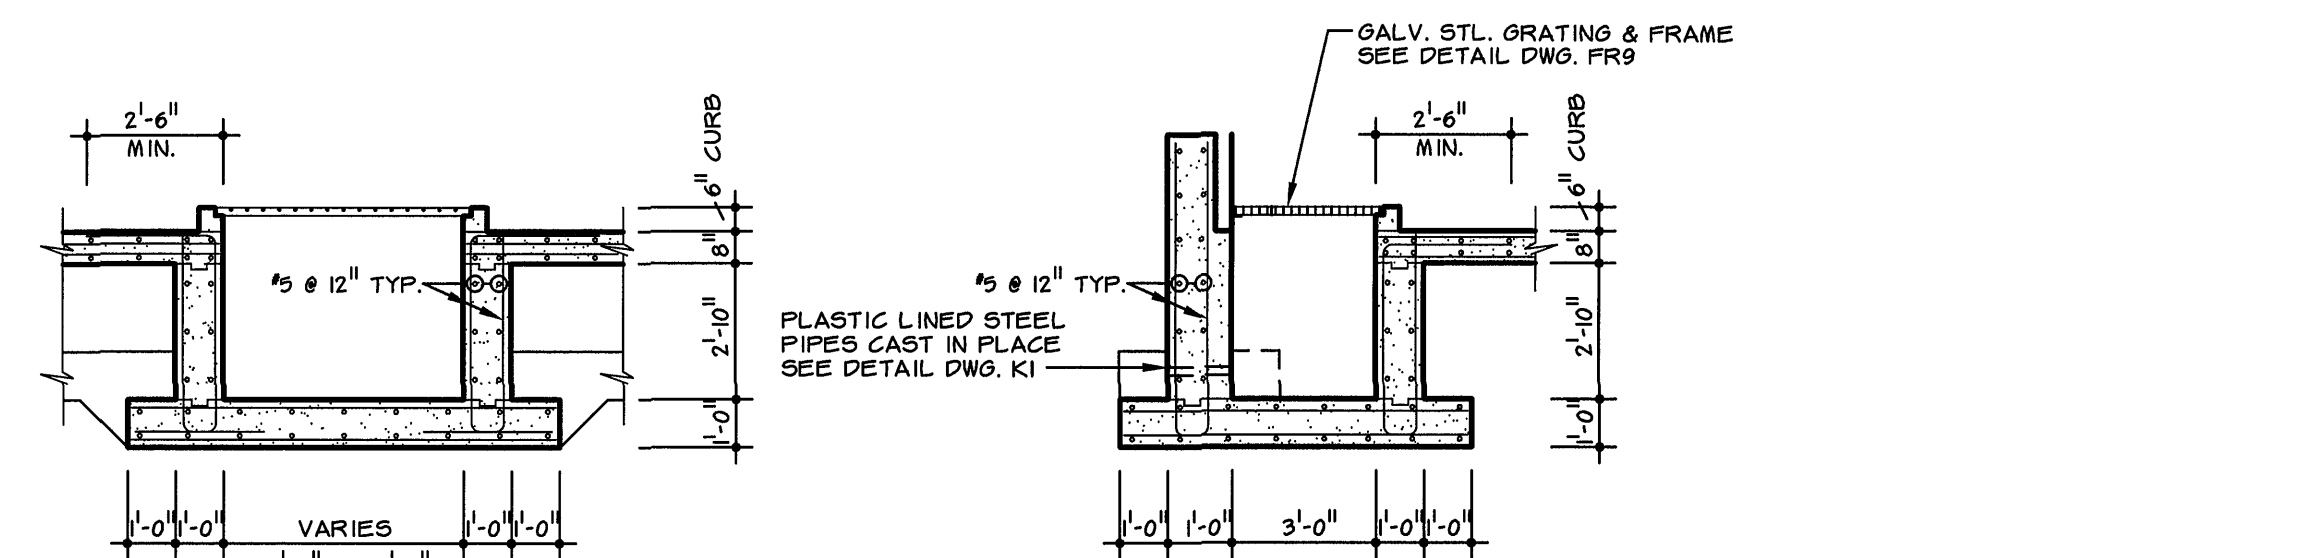

SECTIONS F
SCALE: 0 4'-0" 8'-0"

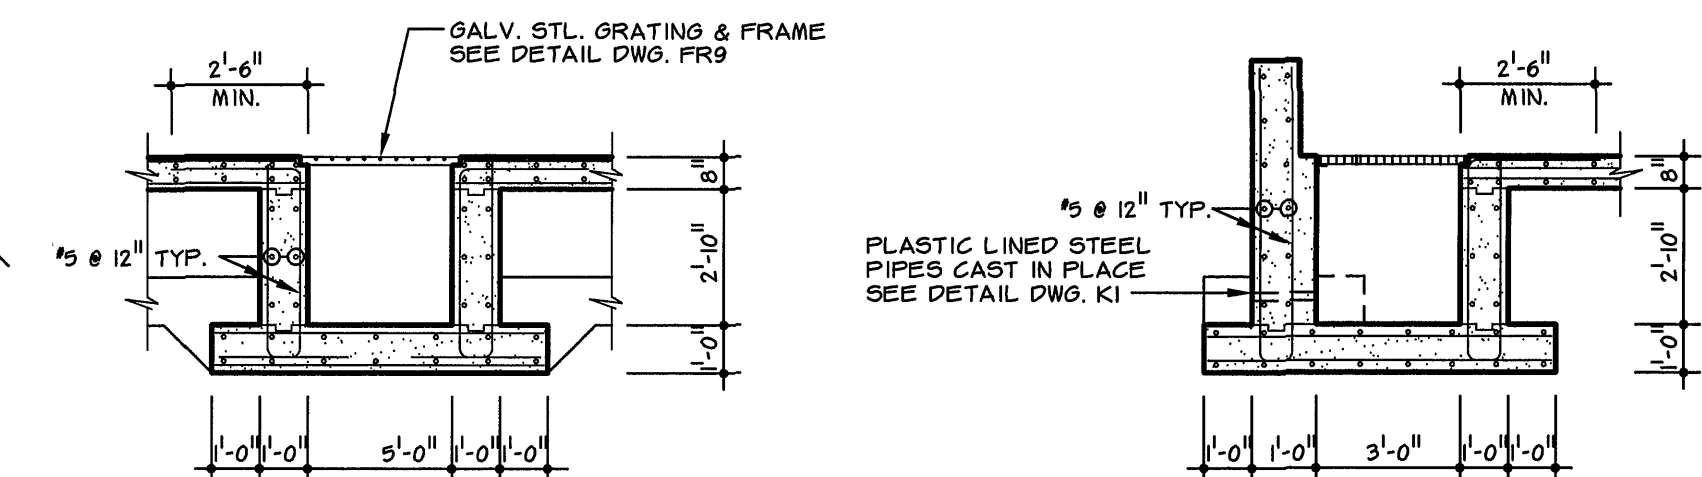


SECTIONS G
SCALE: 0 4'-0" 8'-0"

DRAWING OF RECORD
DATE: SEP 30 1997

MATTEN & CRAIG
CONSULTING ENGINEERS • SURVEYORS
ROANOKE VIRGINIA

ALVORD, BURDICK & HOWSON
ENGINEERS CHICAGO

DESIGNED:
DRAWN:
CHECKED:

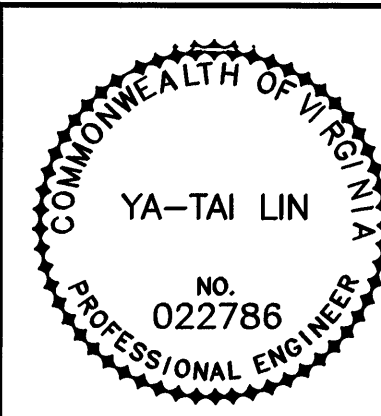

REV.	DATE	DESCRIPTION	BY	APP.

CARVINS COVE FILTER PLANT IMPROVEMENTS — PHASE I
ROANOKE, VIRGINIA

CHEMICAL BUILDING 1
SECTIONS & DETAILS

DATE
APRIL 1992

COMM. NO.
9130

SHEET
A11