



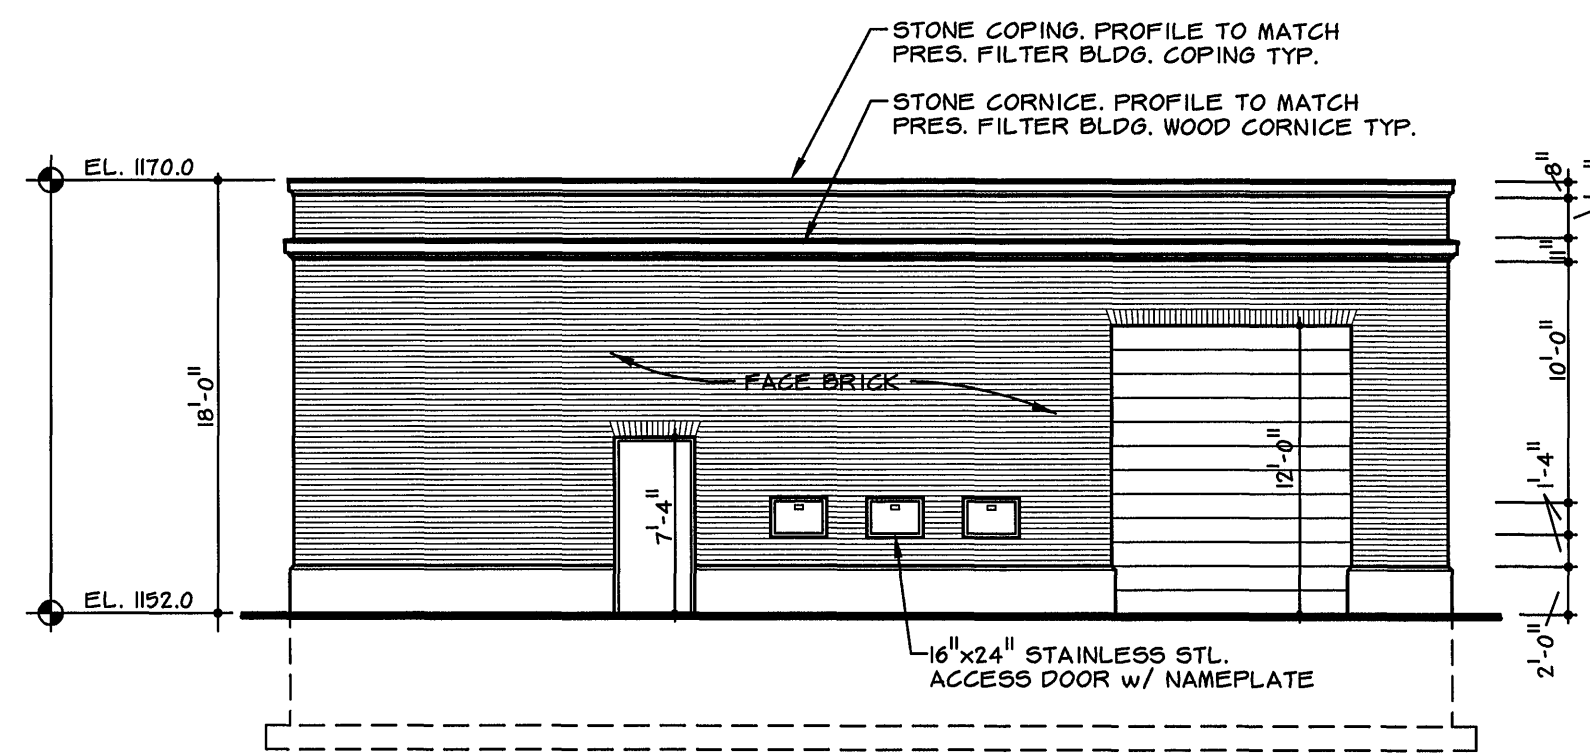


NORTHWEST ELEVATION

SCALE: 0 4'-0" 8'-0" 16'-0"

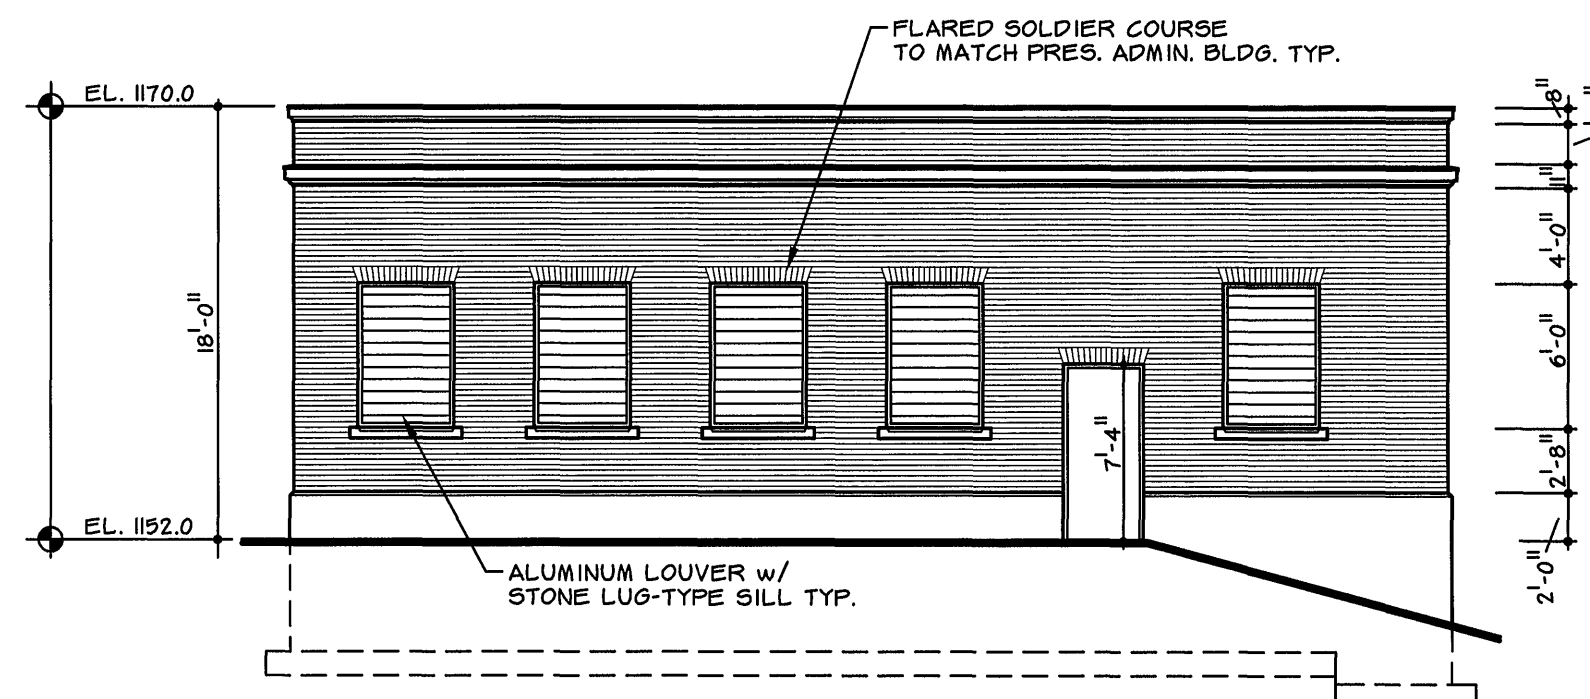


SOUTHEAST ELEVATION

SCALE: 0 4'-0" 8'-0" 16'-0"

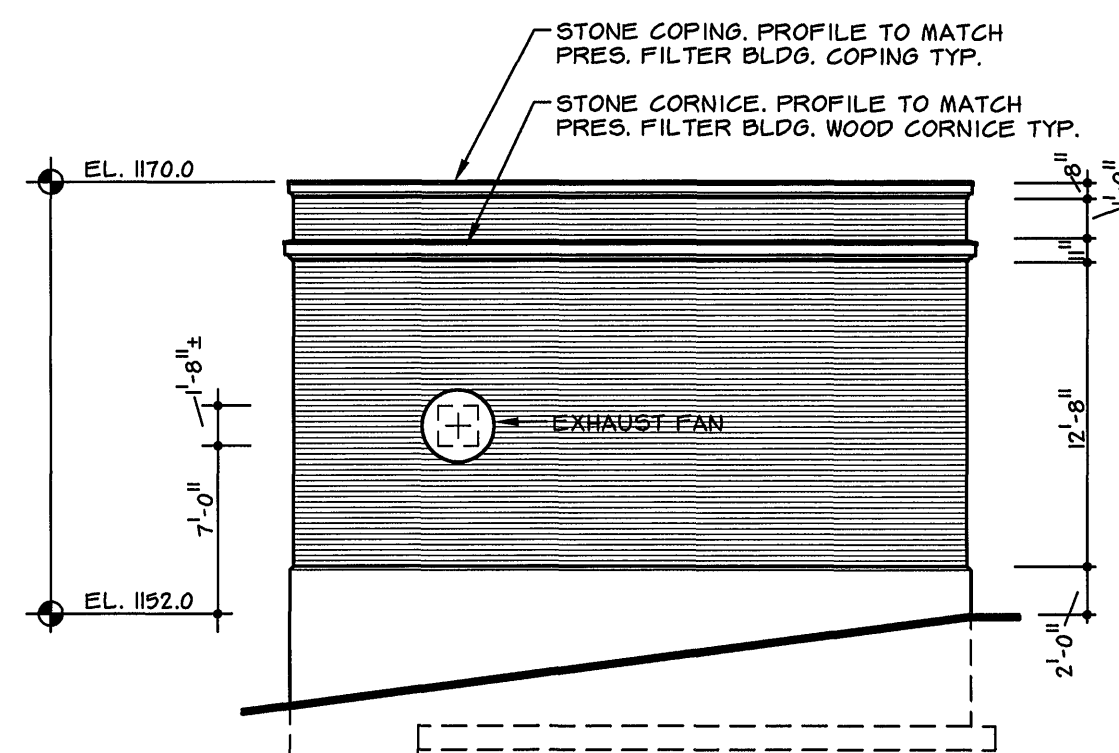


NORTHEAST ELEVATION

SCALE: 0 4'-0" 8'-0" 16'-0"

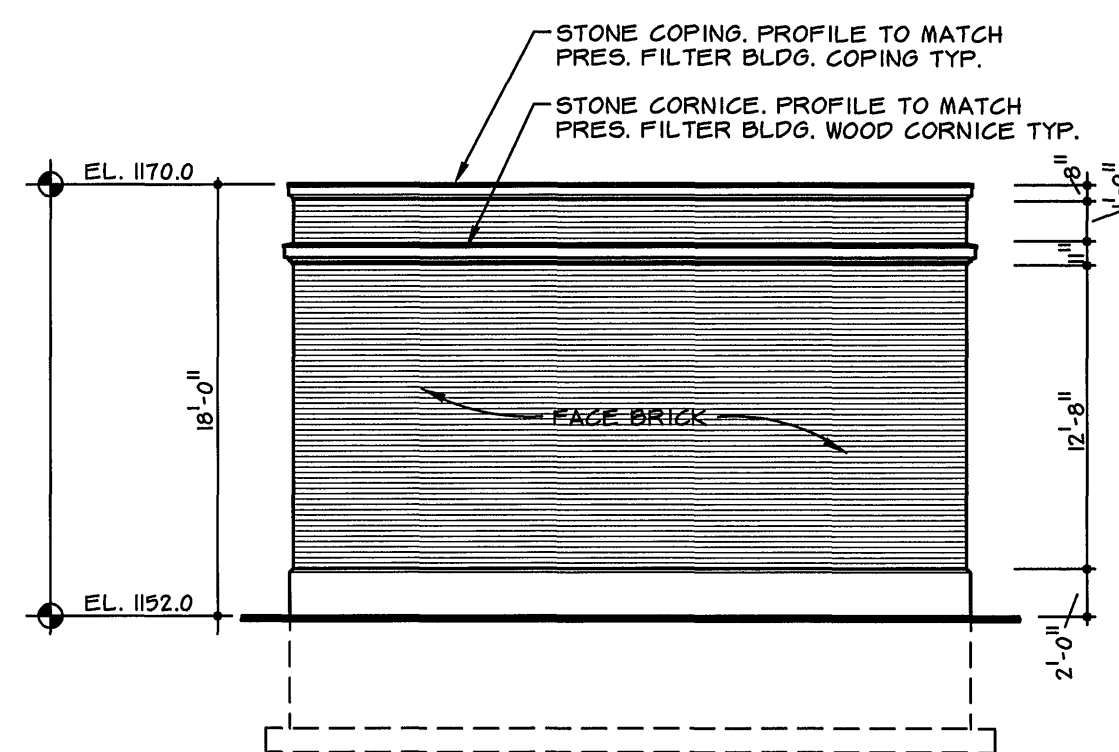


SOUTHWEST ELEVATION

SCALE: 0 4'-0" 8'-0" 16'-0"

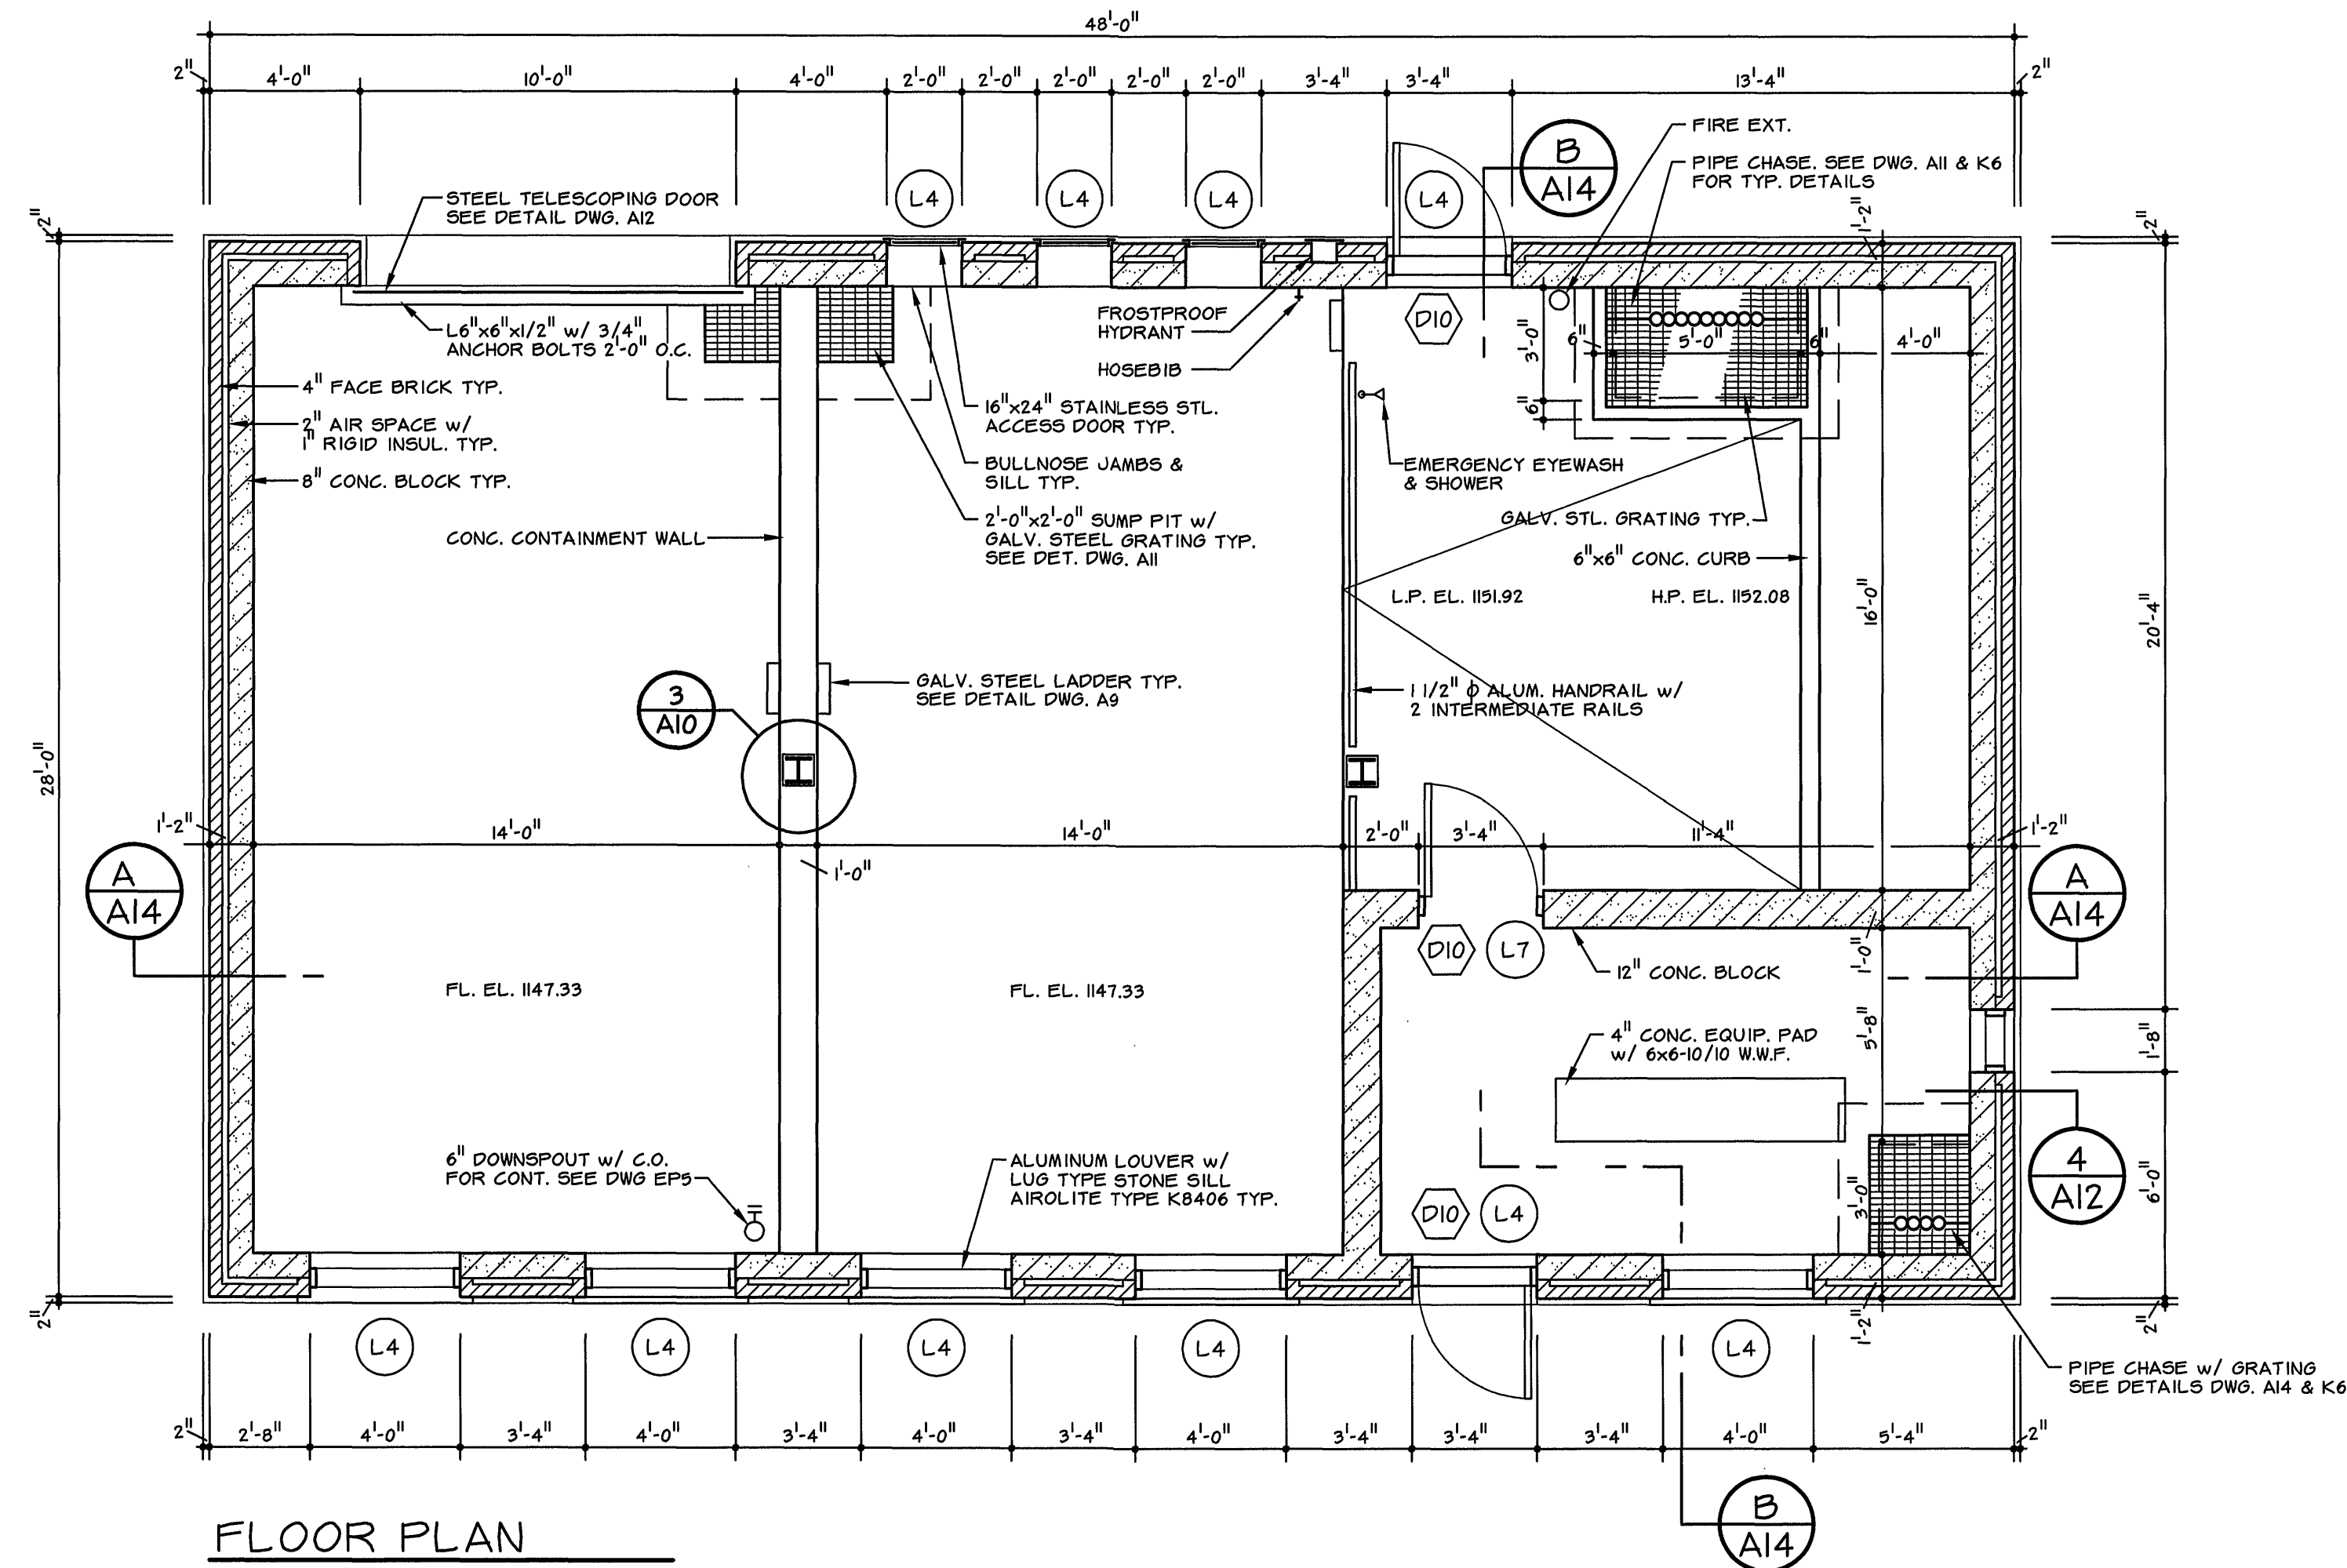


FLOOR PLAN

SCALE: 0 4'-0" 8'-0" 16'-0"

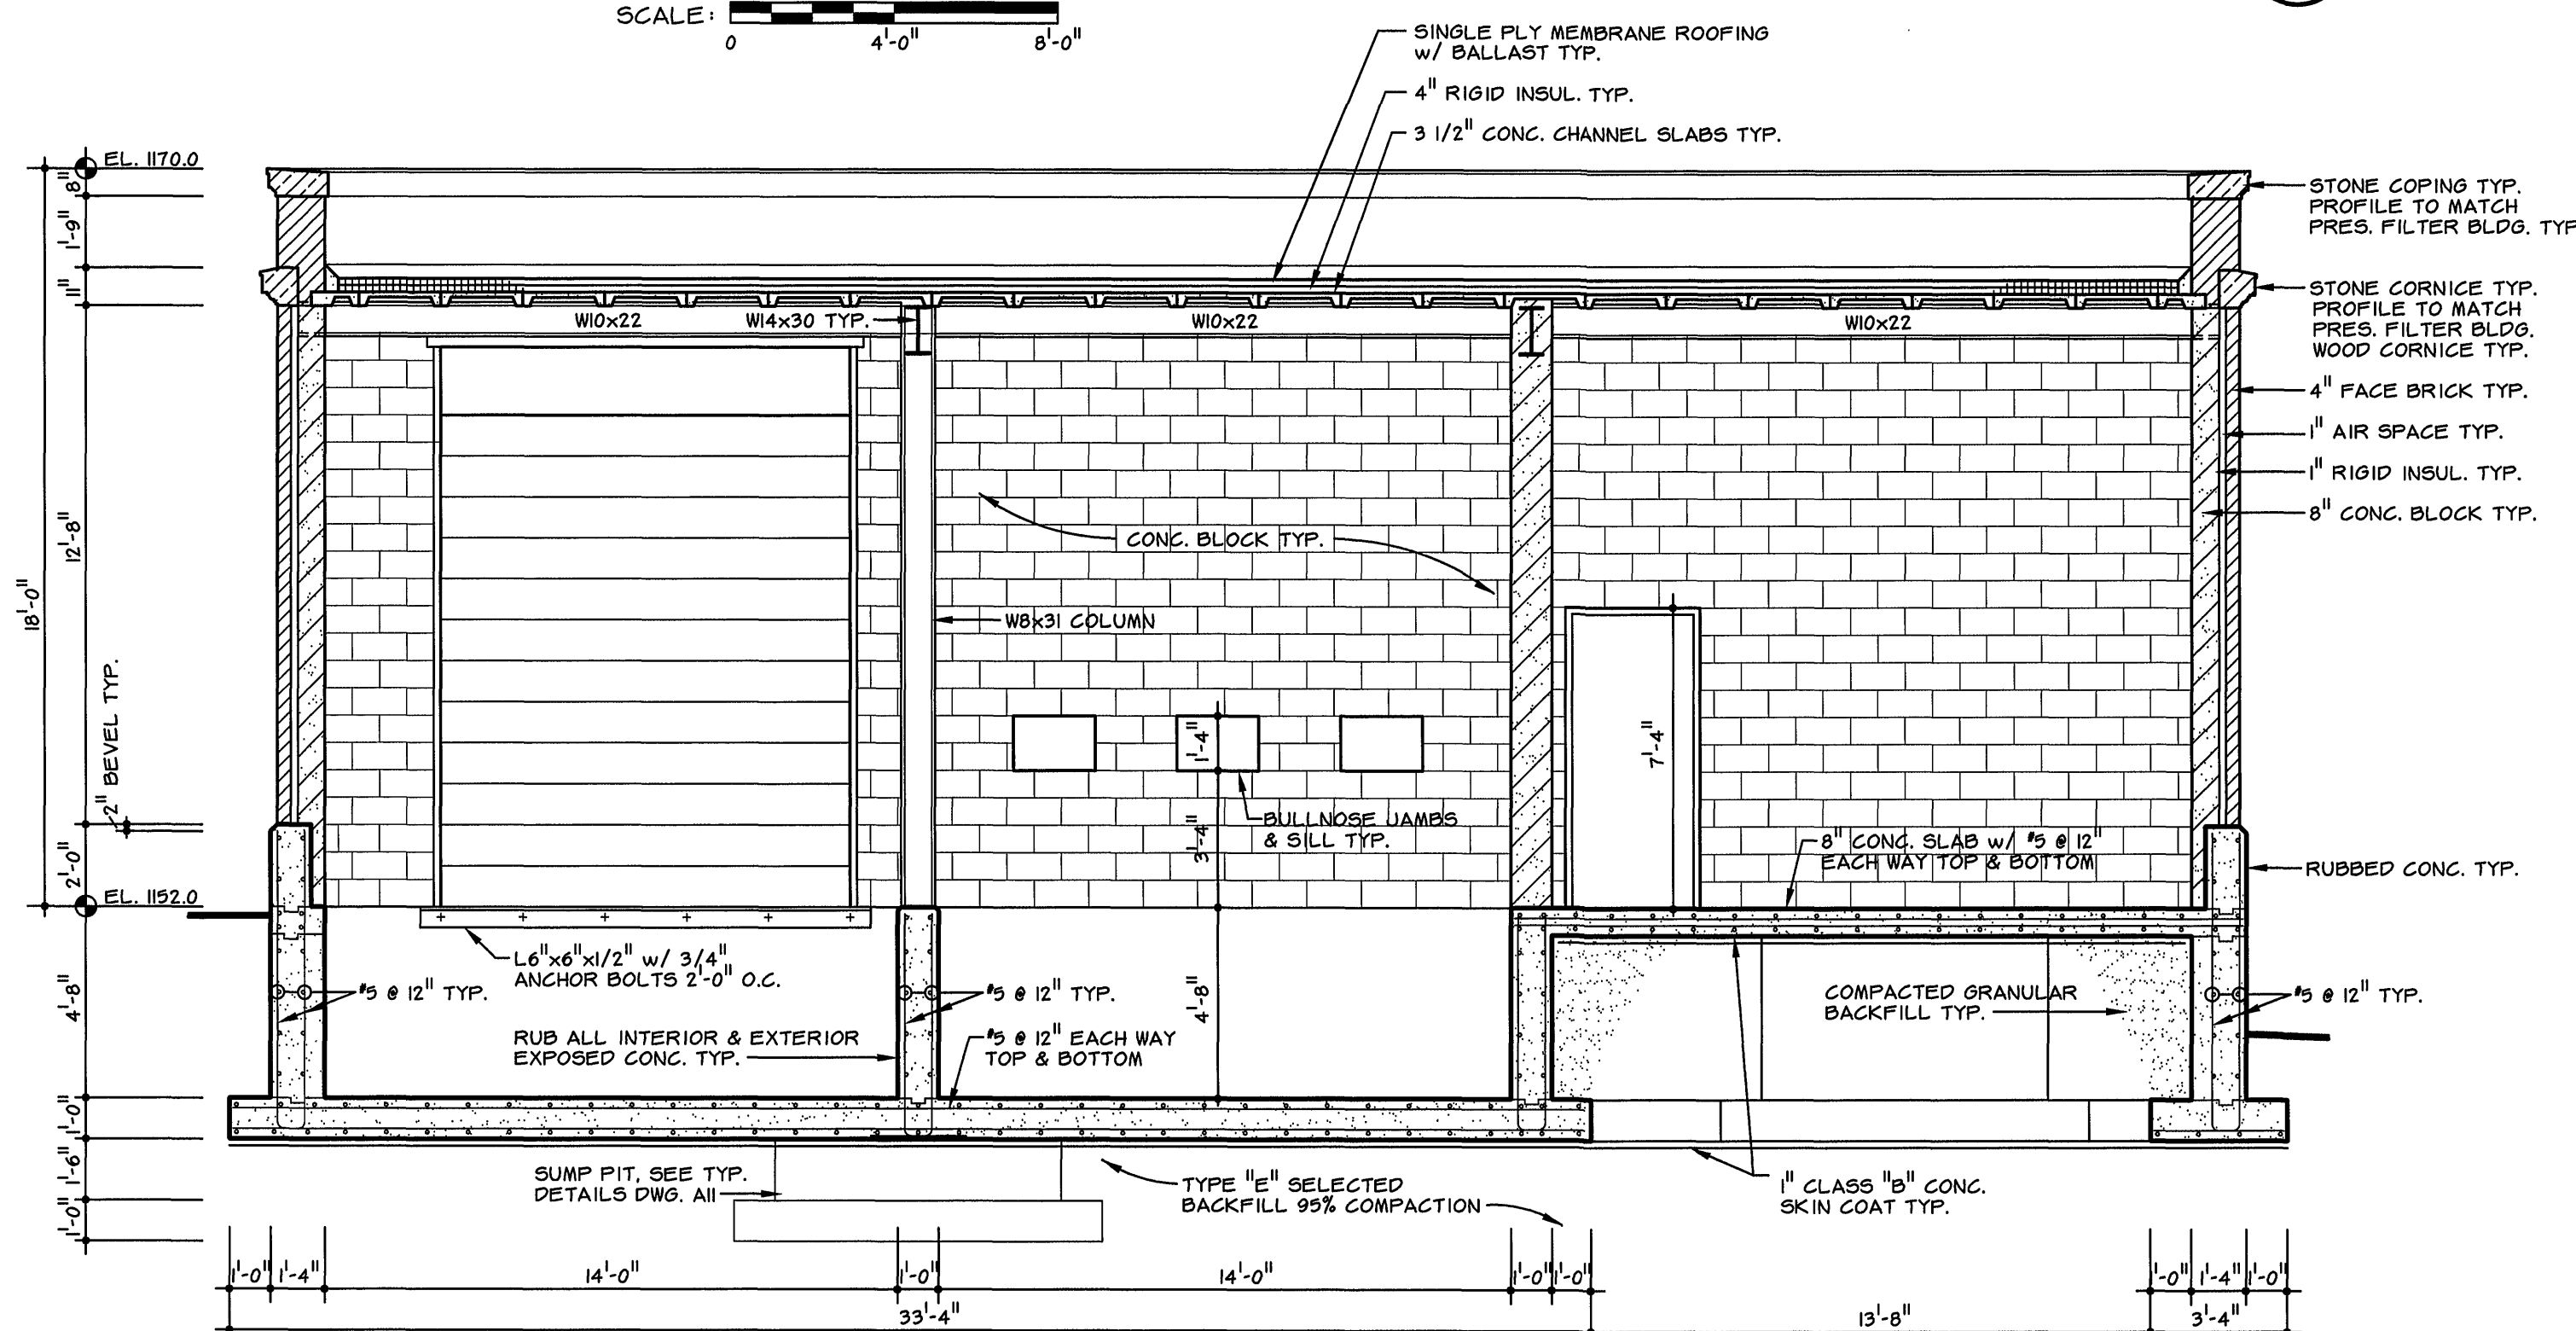


SECTION A - A

SCALE: 0 4'-0" 8'-0" 16'-0"

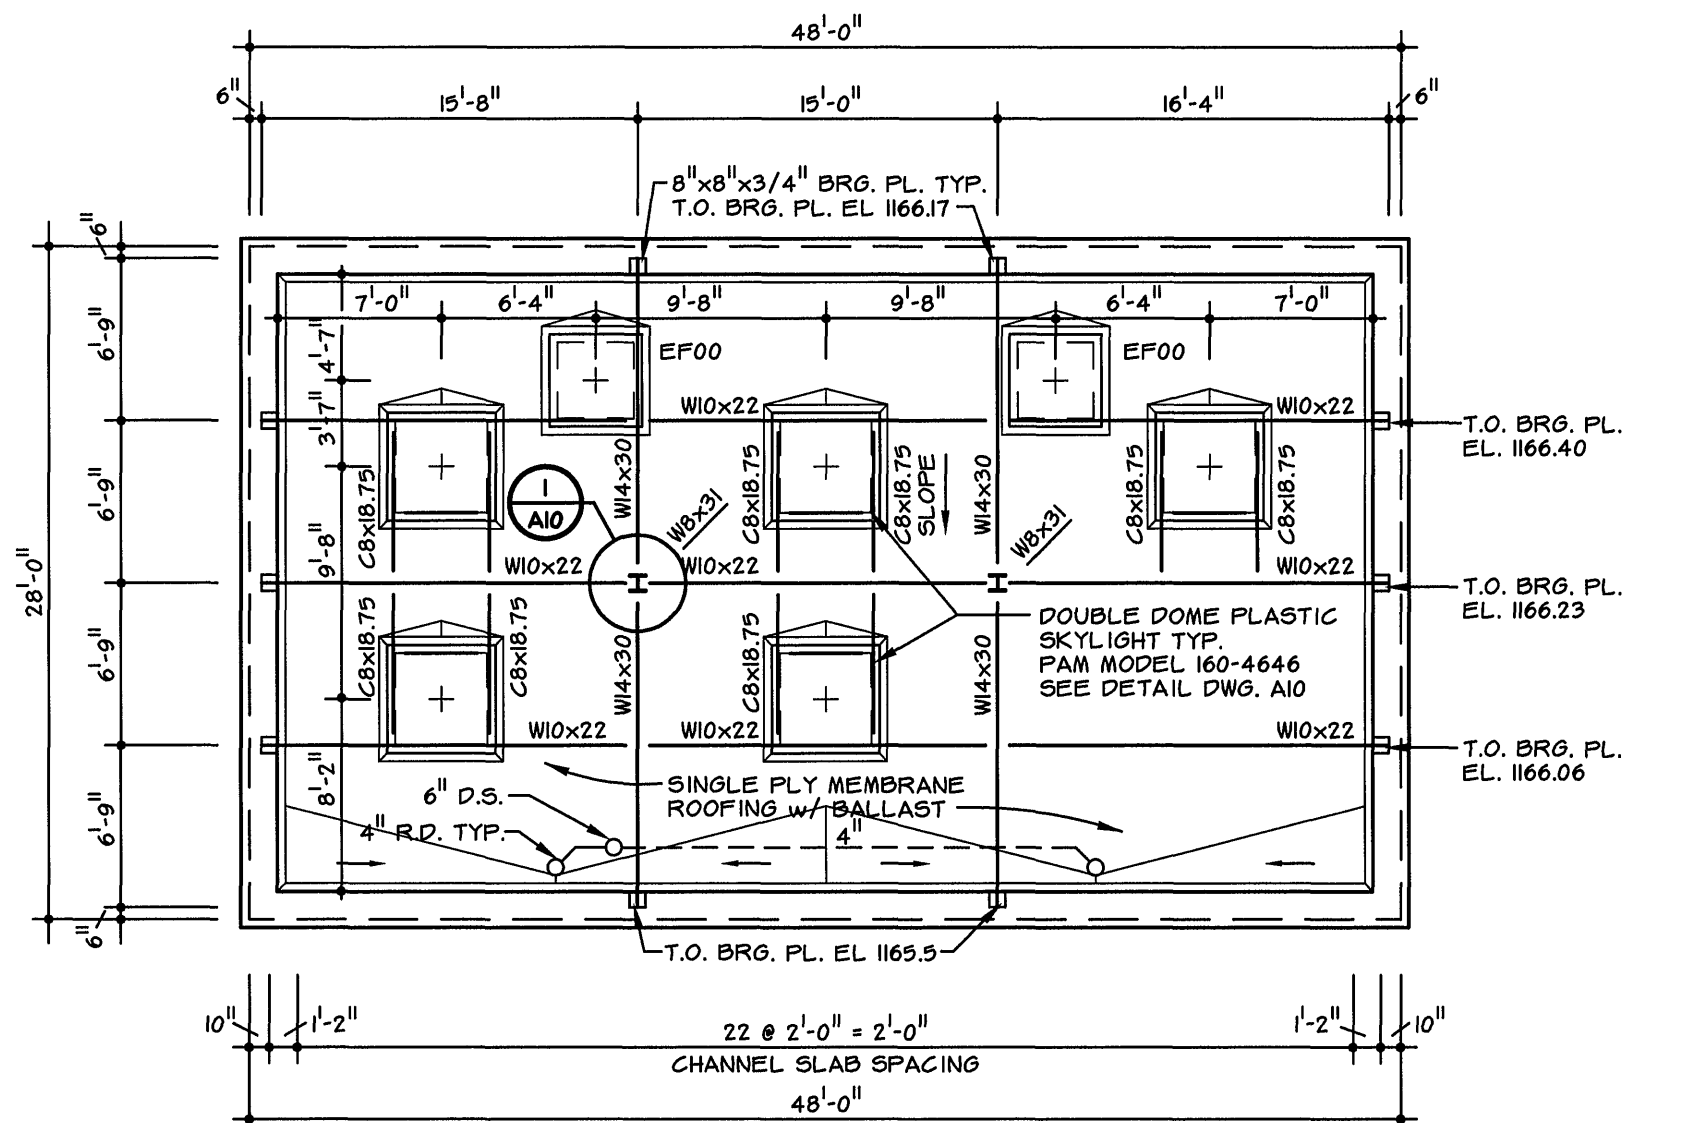


ROOF PLAN

SCALE: 0 4'-0" 8'-0" 16'-0"

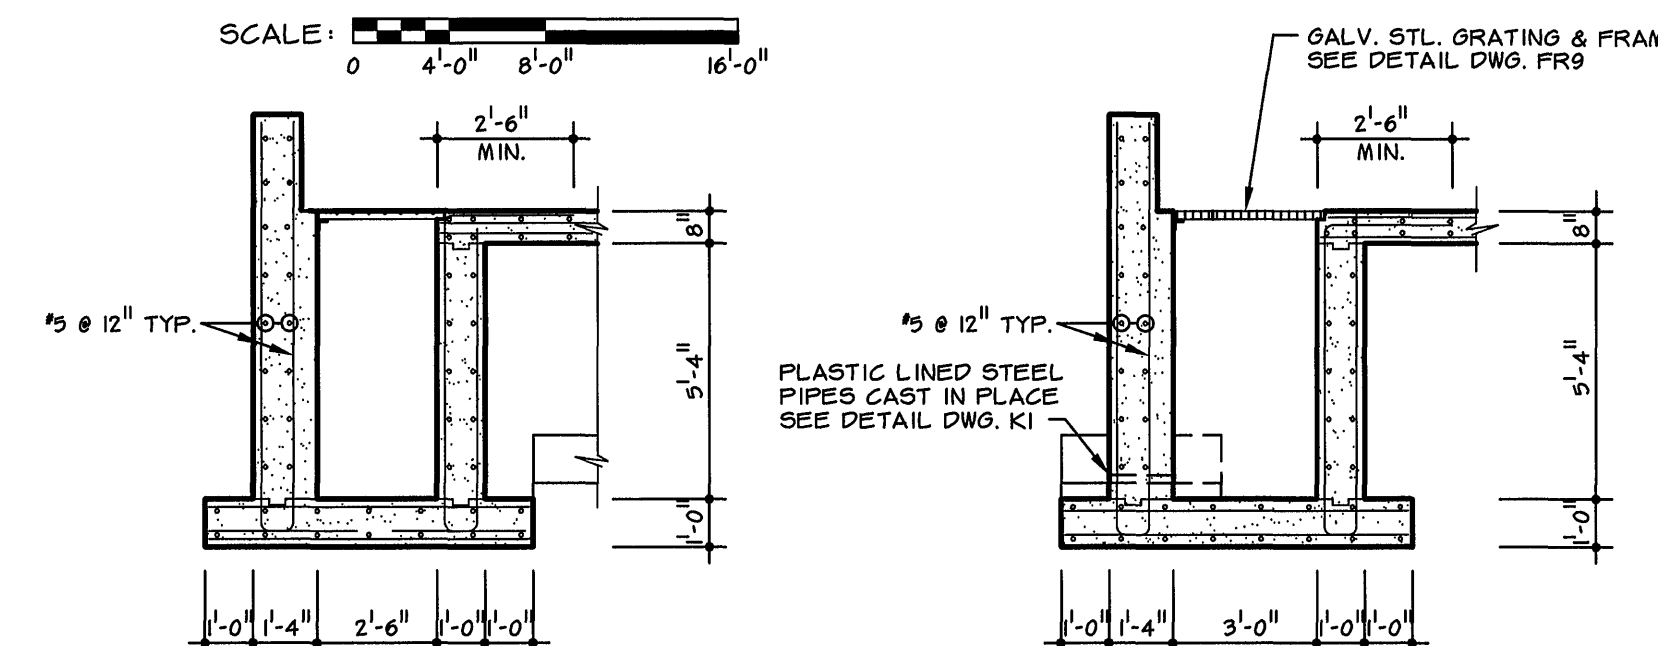

PIPE CHASE SECTIONS

SCALE: 0 4'-0" 8'-0" 16'-0"

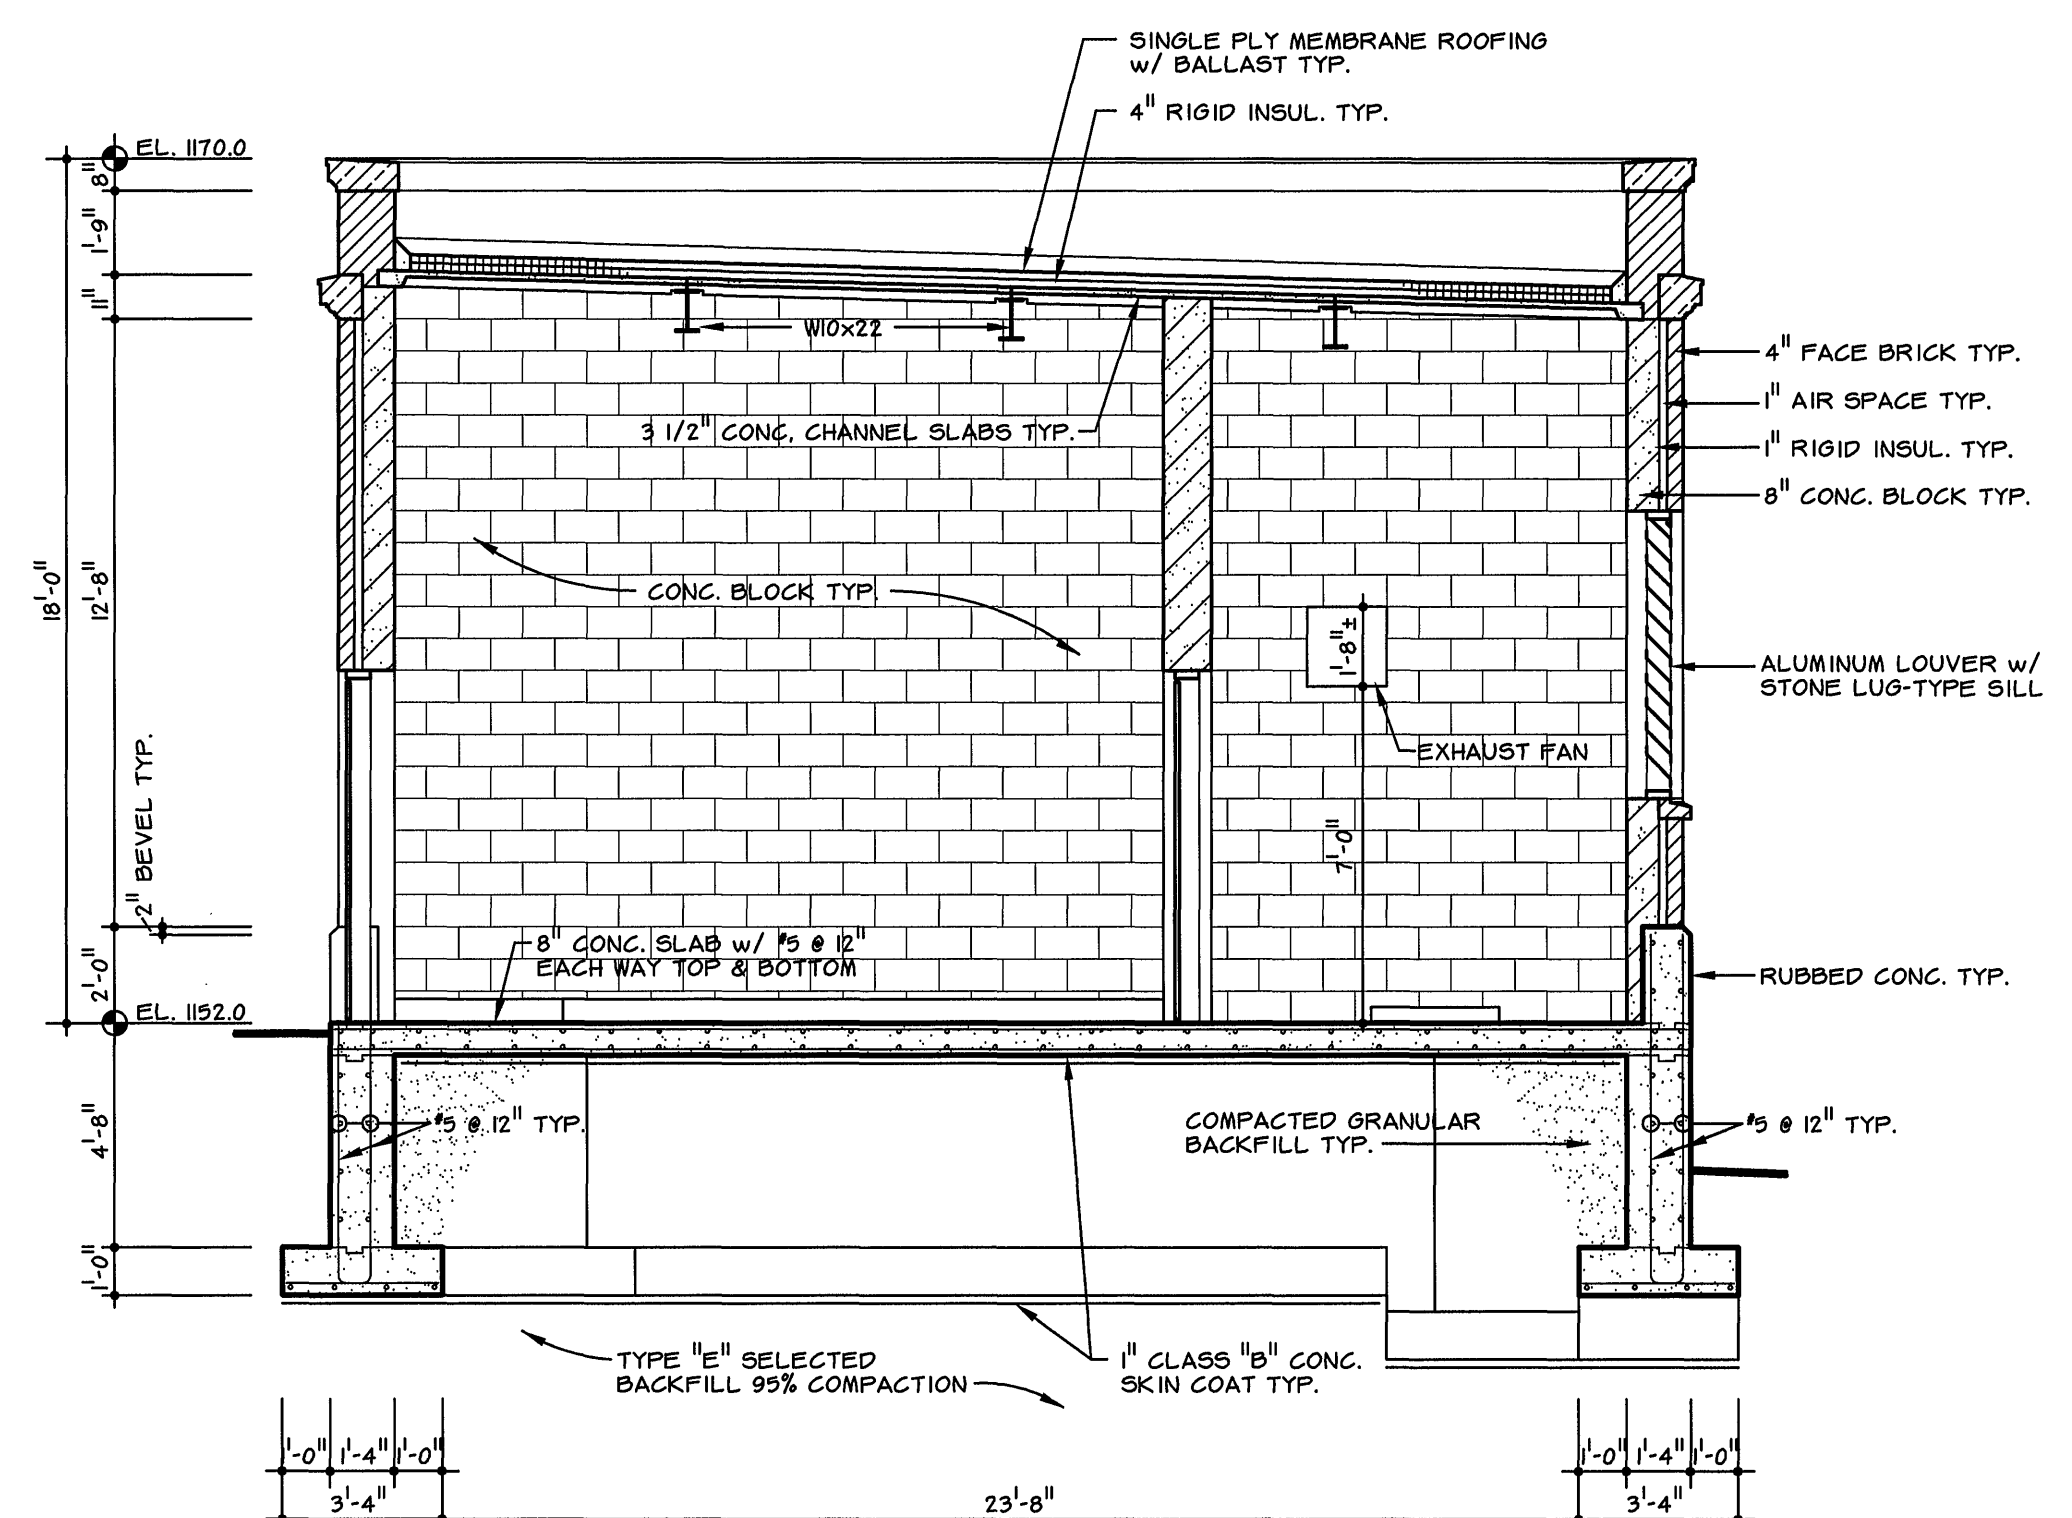

SECTION B - B

SCALE: 0 4'-0" 8'-0" 16'-0"

DRAWING OF RECORD

DATE: SEP 30 1997


MATTERN & CRAIG
CONSULTING ENGINEERS • SURVEYORS
ROANOKE VIRGINIA

ALVORD, BURDICK & HOWSON
ENGINEERS CHICAGO

DESIGNED:

DRAWN:

CHECKED:

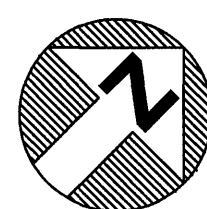

REV.	DATE	DESCRIPTION	BY	APP.

CARVINS COVE FILTER PLANT IMPROVEMENTS – PHASE I
ROANOKE, VIRGINIA

CHEMICAL BUILDING 2
ELEVATIONS, PLANS & SECTIONS

DATE
APRIL 1992
COMM. NO.
9130
SHEET
A14

PLAN NO. 6199