

DETAIL-A
SCALE: NONE

DETAIL-B
SCALE: NONE

DETAIL-C
SCALE: NONE

FRONT ELEVATION MCC-A

SCALE OF DRAWING 1/2" = 1'-0"

ELEV D-D
SCALE: NONE

DETAIL-E
SCALE: NONE

ELECTRICAL PLAN

SCALE OF DRAWING 1/4" = 1'-0"

LIGHTING PLAN


SCALE OF DRAWING 1/8" = 1'-0"

DRAWING OF RECORD


DATE: SEP 30 1997

NOTES:

1. L.T.G. FIXT. IN CHLORINE CYLINDER STGE. SHALL HAVE 12'-6" MTG. HTS.
2. L.T.G. FIXT. IN CHEMICAL STGE. AREA SHALL HAVE 12'-6" MTG. HT. THOSE IN TANK AREAS & ABOVE WALKWAYS SHALL BE 14'-6"
3. UNLESS OTHERWISE NOTED L.T.G. FIXT. MTG. HT. SHALL BE 8'-6"
4. RECP'S MARKED * SHALL BE MTD. 4'-6" ABOVE WALKWAY.
5. CONDUIT & WIRING SHOWN FOR ATP-1 & 2 IS TYP. FOR FTP-1 & 2, NaOHTP-1 & 2 AND WBP-1 & 2.
6. CONDUIT & WIRING SHOWN FOR AP-1,2,3 IS TYP. FOR FP-1,2,3
7. CONDUIT & WIRING SHOWN FOR NaOHP-1,2,3,4 & 5 IS TYPICAL FOR AP-1,2,3, FP-1,2,3.

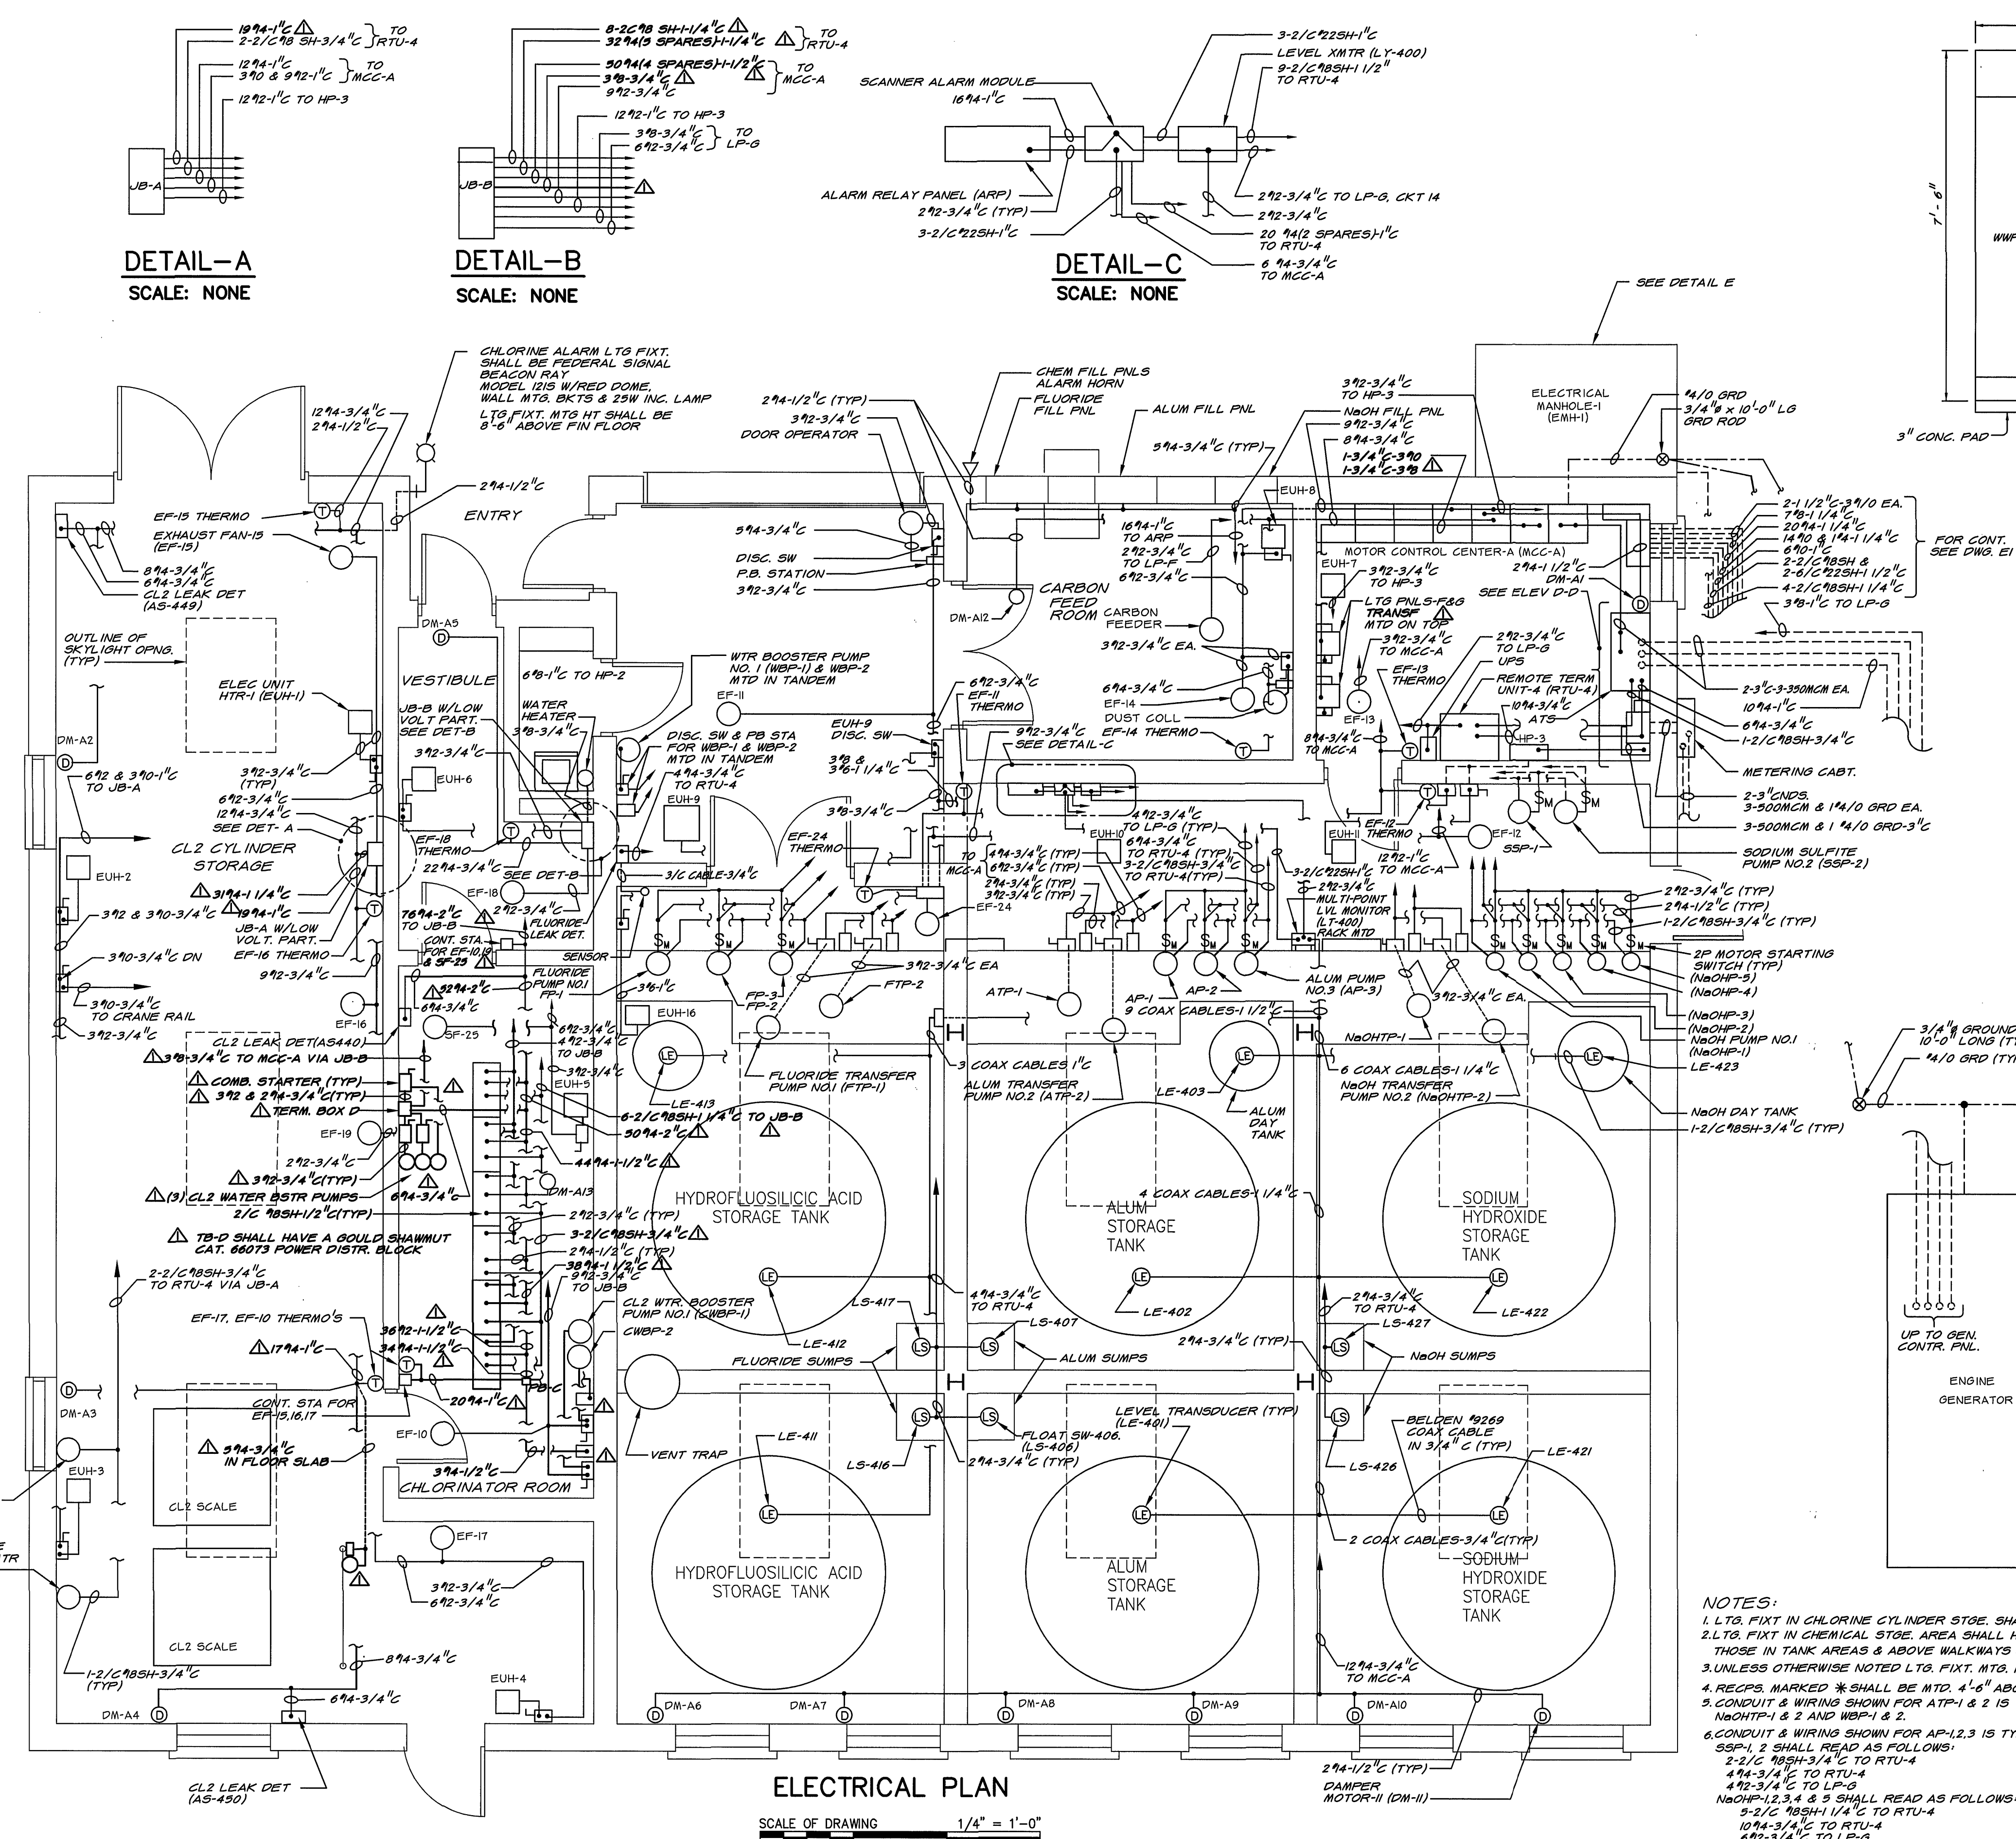

11'-8"				
WMP-1	WMP-2	NaOHTP-1	NaOHTP-2	NaOHTP-3
ATP-1	ATP-2	WBP-1	WBP-2	WBP-3
FTP-1	FTP-2	DUST COLLECTOR	DOOR OPNRS 2 & 3	SPARE SIZE 1
FTP-3	FTP-4	DOOR OPNRS 2 & 3	SPARE SIZE 1	SPARE SIZE 1
FTP-5	FTP-6	DOOR OPNRS 2 & 3	SPARE SIZE 1	SPARE SIZE 1
FTP-7	FTP-8	DOOR OPNRS 2 & 3	SPARE SIZE 1	SPARE SIZE 1
FTP-99	FTP-100	DOOR OPNRS 2 & 3	SPARE SIZE 1	SPARE SIZE 1

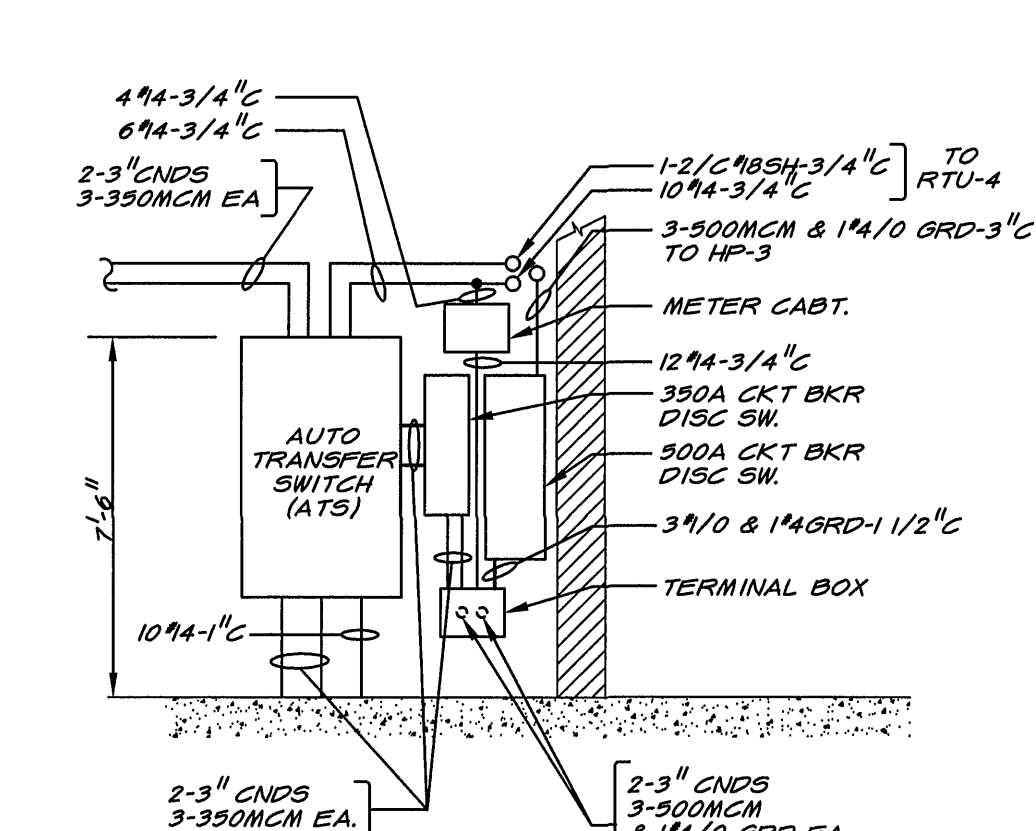

MATTEN & CRAIG
CONSULTING ENGINEERS • SURVEYORS
ROANOKE VIRGINIA

ALVORD, BURDICK & HOWSON
ENGINEERS
CHICAGO

DESIGNED: RRA
DRAWN: KGP
CHECKED: RRA

COMMONWEALTH OF VIRGINIA
YA-TAI LIN
NO. 022786
PROFESSIONAL ENGINEER

REV.	DATE	DESCRIPTION	BY	APP.
1	9-12-92	ADDED EQUIPMENT FOR PRECHLORINATION SYSTEM	KGP	

CARVINS COVE FILTER PLANT IMPROVEMENTS - PHASE I
ROANOKE, VIRGINIA

CHEMICAL BUILDING - ELECTRICAL PLANS

DATE
APRIL 1992

COMM. NO.
9130

SHEET
E12