


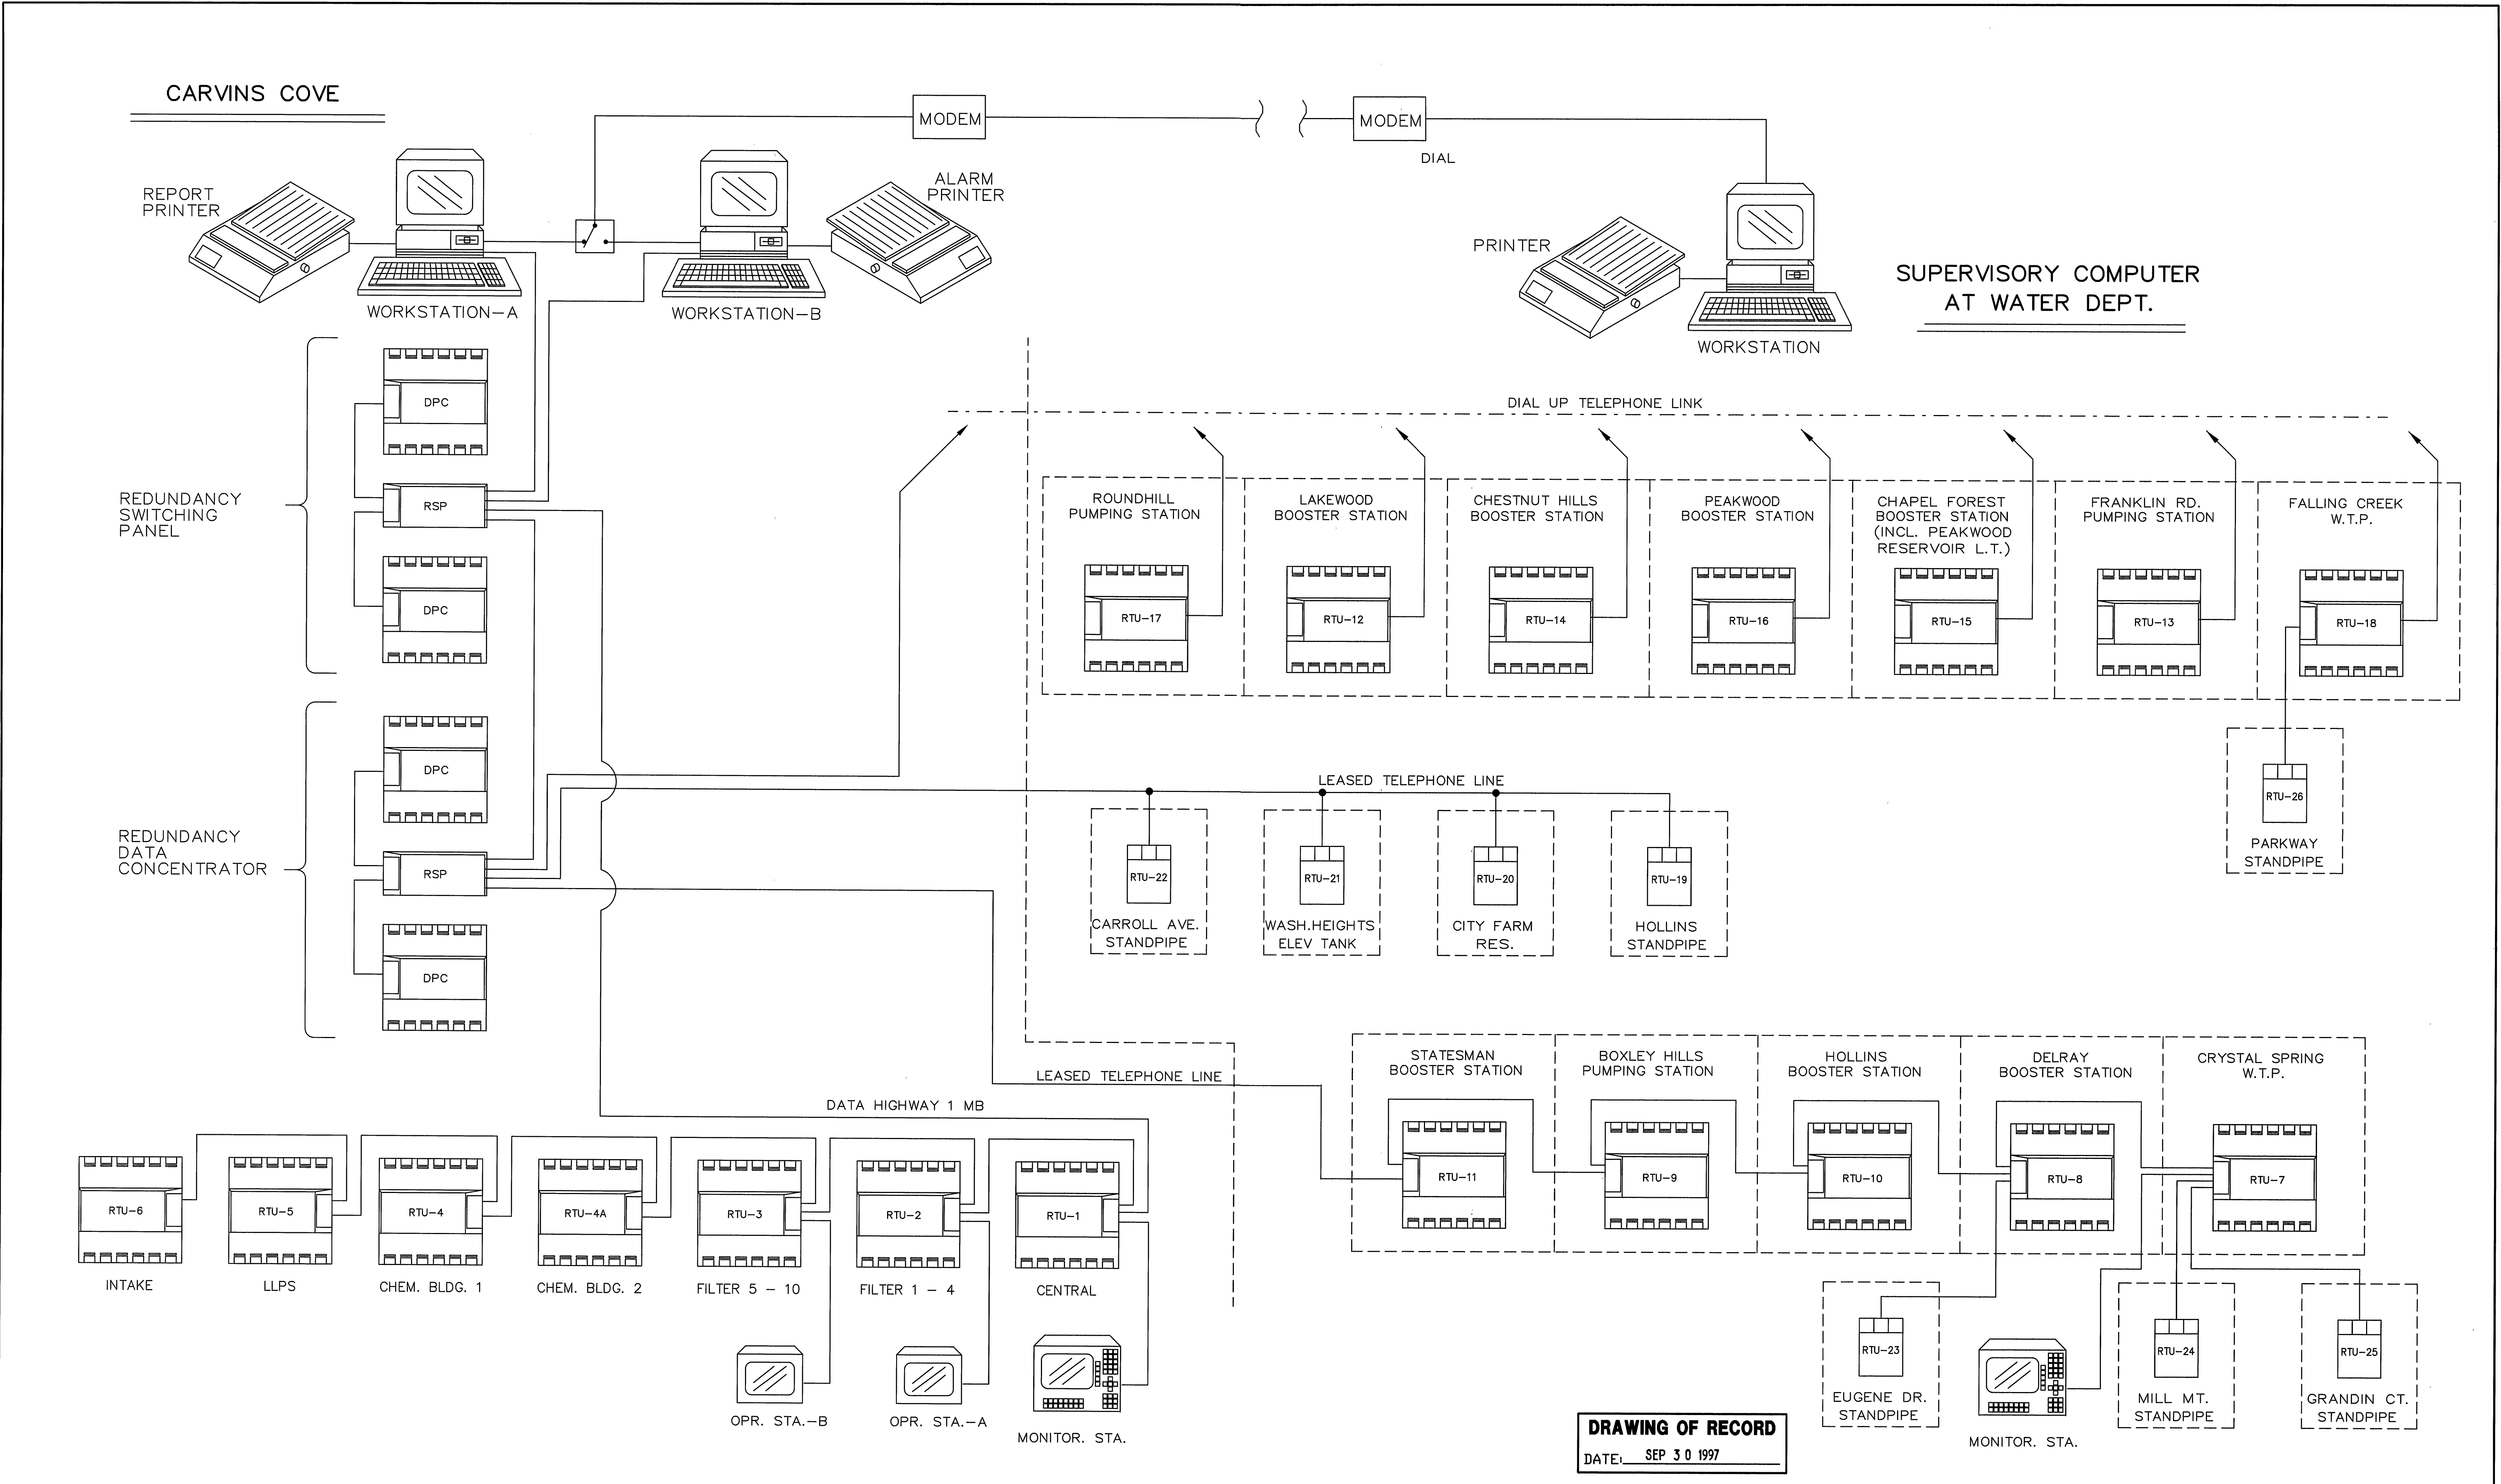

DRAWING OF RECORD
DATE: SEP 30 1997

MATTERN & CRAIG CONSULTING ENGINEERS • SURVEYORS ROANOKE VIRGINIA ALVORD, BURDICK & HOWSON ENGINEERS CHICAGO	DESIGNED: KCC	COMMONWEALTH OF VIRGINIA YA-TAI LIN NO. 022786 PROFESSIONAL ENGINEER	REV.	DATE	DESCRIPTION	BY	APP.	CARVINS COVE FILTER PLANT IMPROVEMENTS – PHASE I ROANOKE, VIRGINIA SCADA SYSTEM BLOCK DIAGRAM	DATE APRIL 1992
	DRAWN: KGP								COMM. NO. 9130
	CHECKED: KCC								SHEET E17