


- [illegible]


SCALE OF DRAWING $1/4" = 1'-0"$

SCALE OF DRAWING $1/2" = 1'-0"$

FOR CONTINUATION
SEE DWG. K5

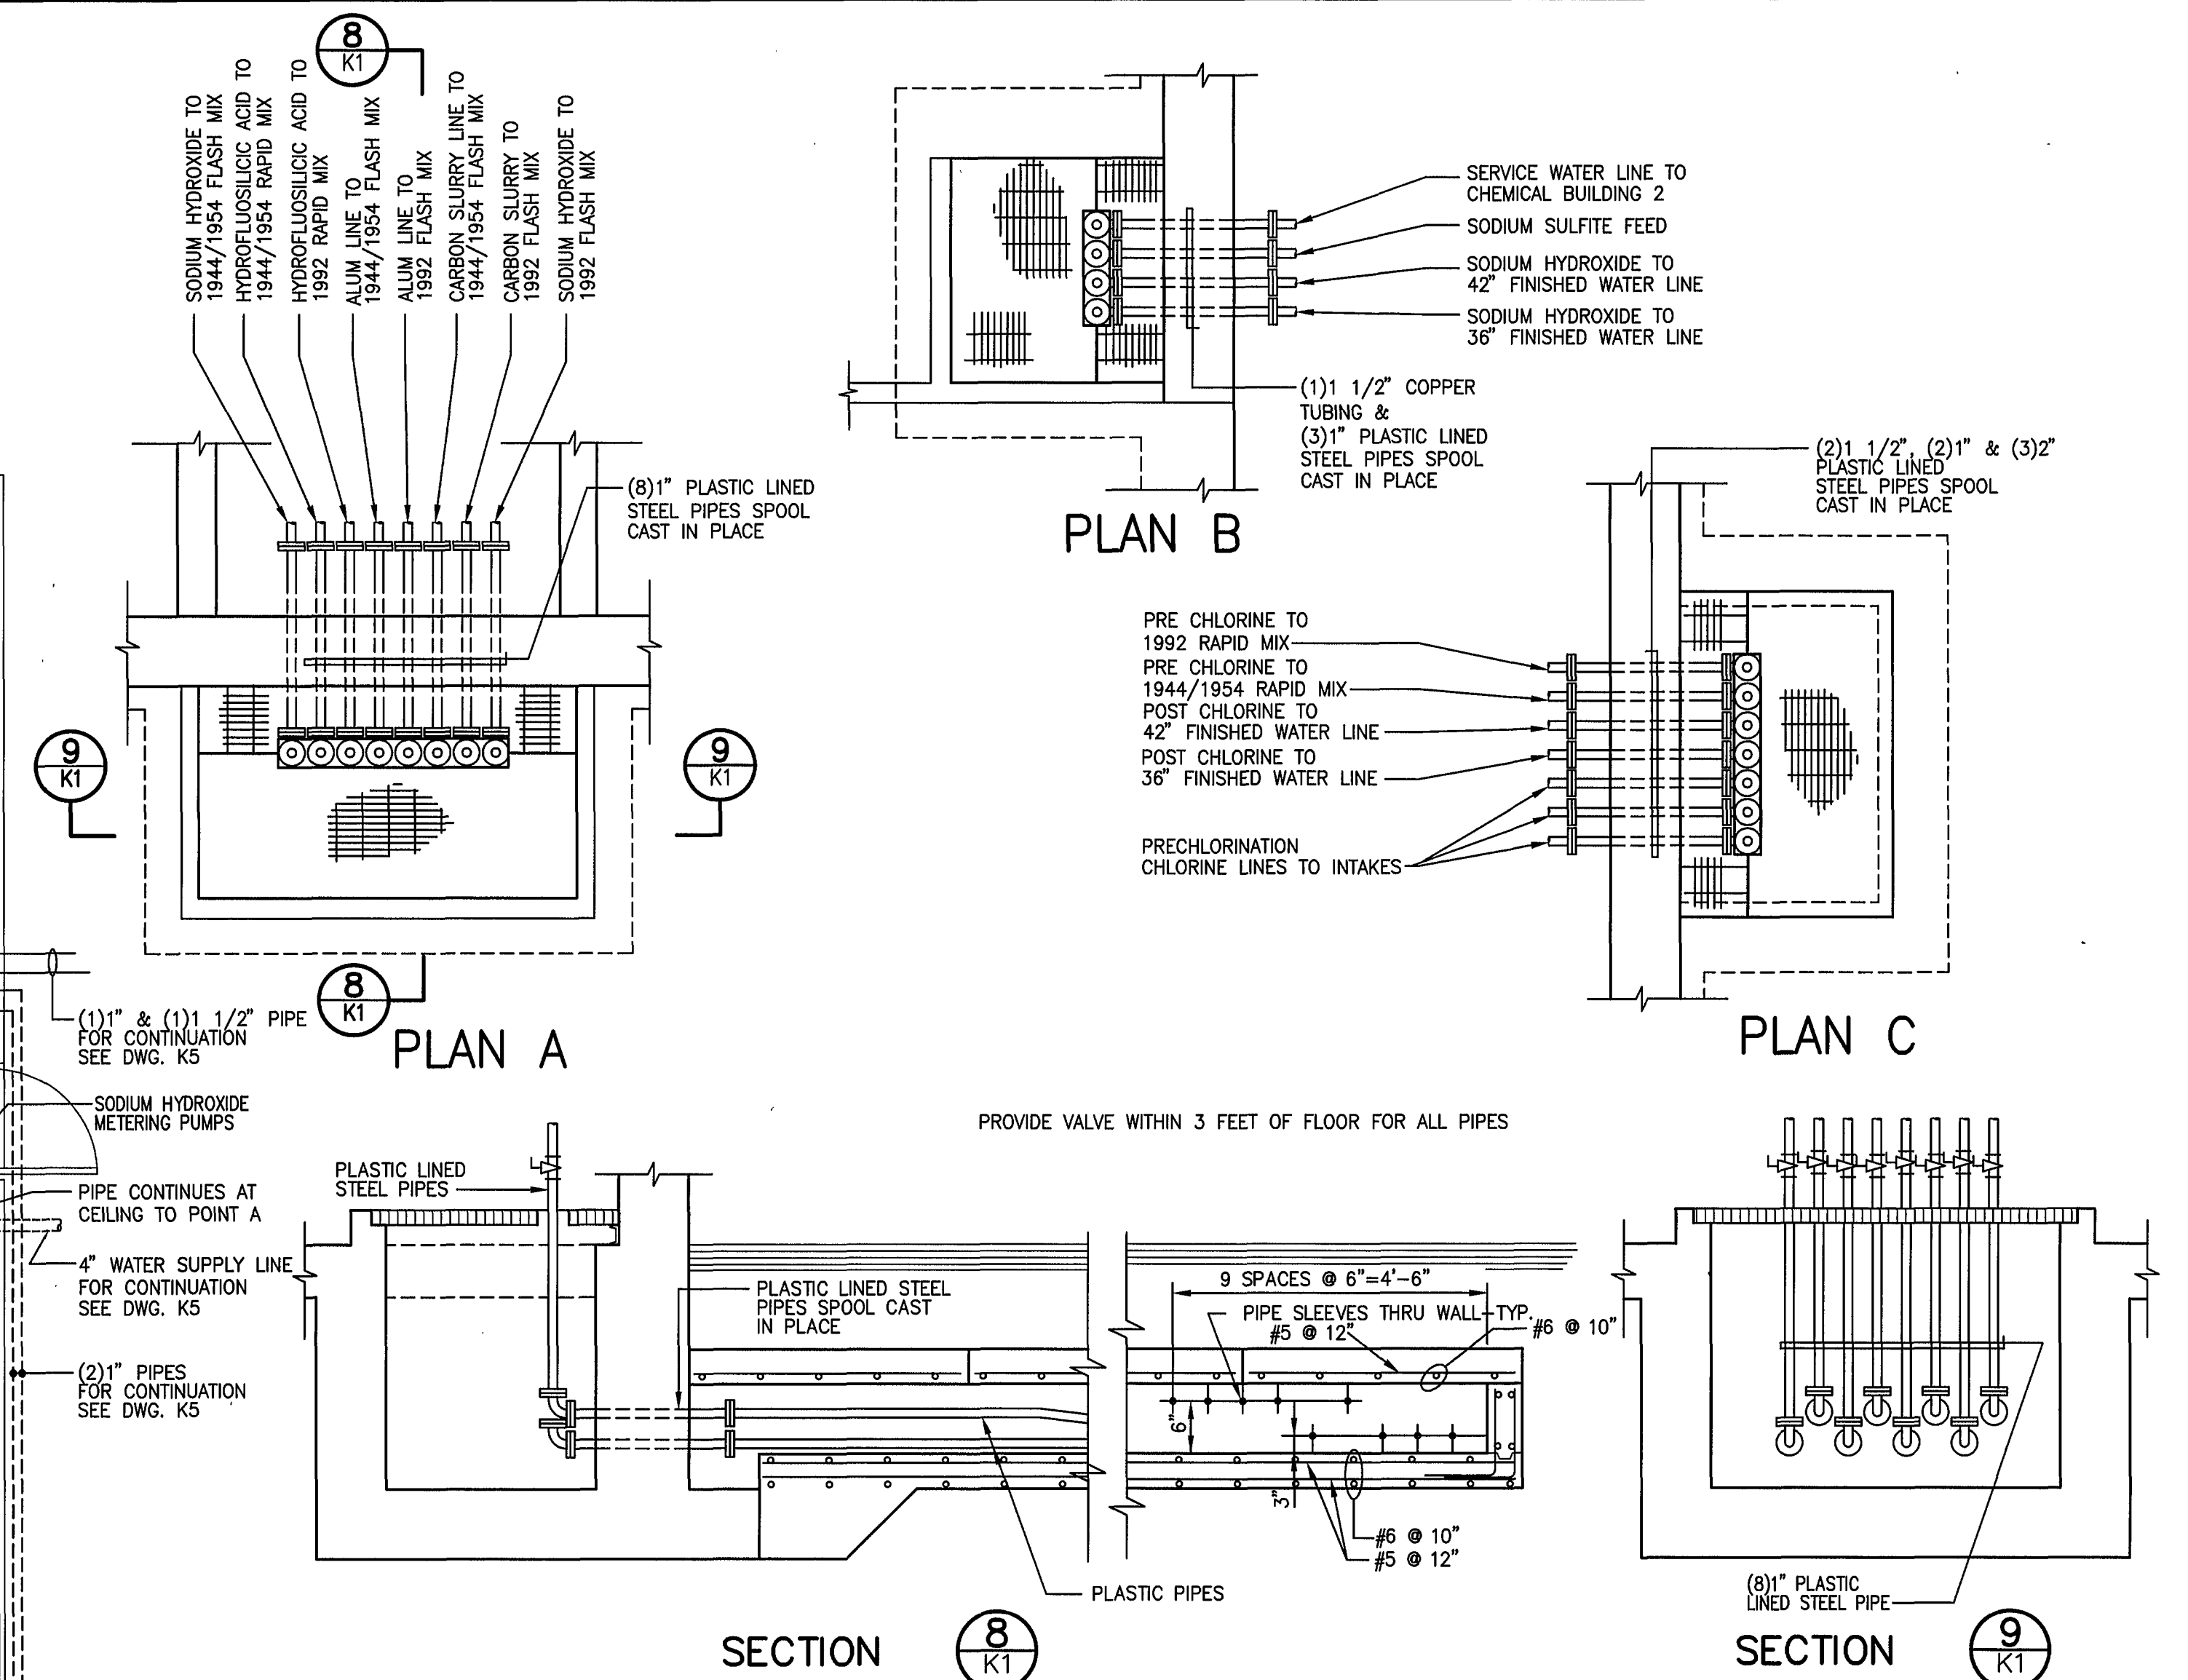

SCALE: 1/2"=1'-0"

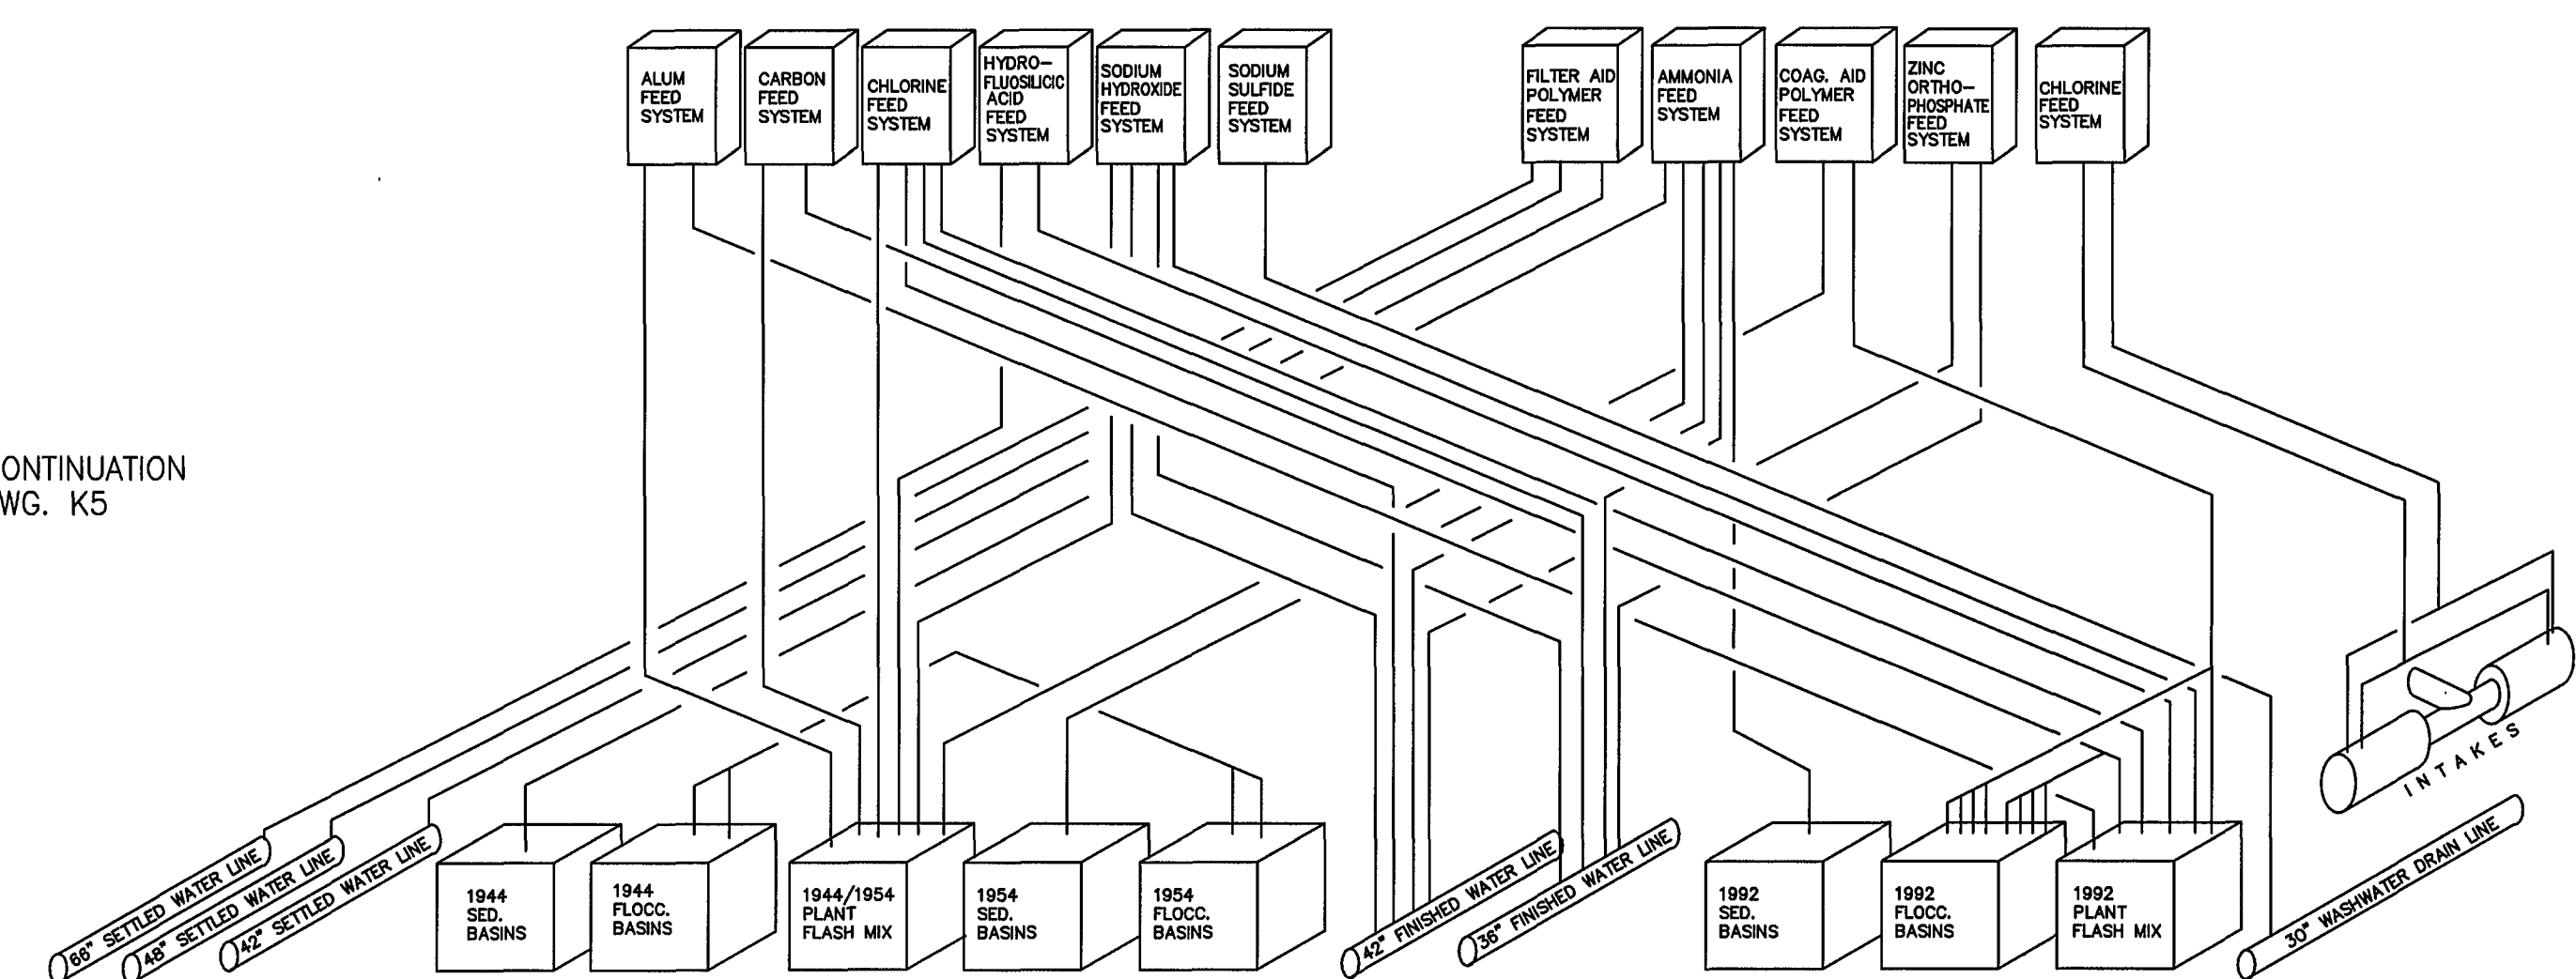

NOTE: FOR AMMONIA POLYMER &
ZINC ORTHOPHOSPHATE FEED
SYSTEMS SEE DWGS. K6 THRU K7.

DATE: **SEP 30 1997**



REV.	DATE	DESCRIPTION	BY	APP.
1	5/12/93	ADD PRECHLORINATION SYSTEM	KHC	

DATE	DEC 1992
COMM. NO. ,	0130
SHEET	K1