




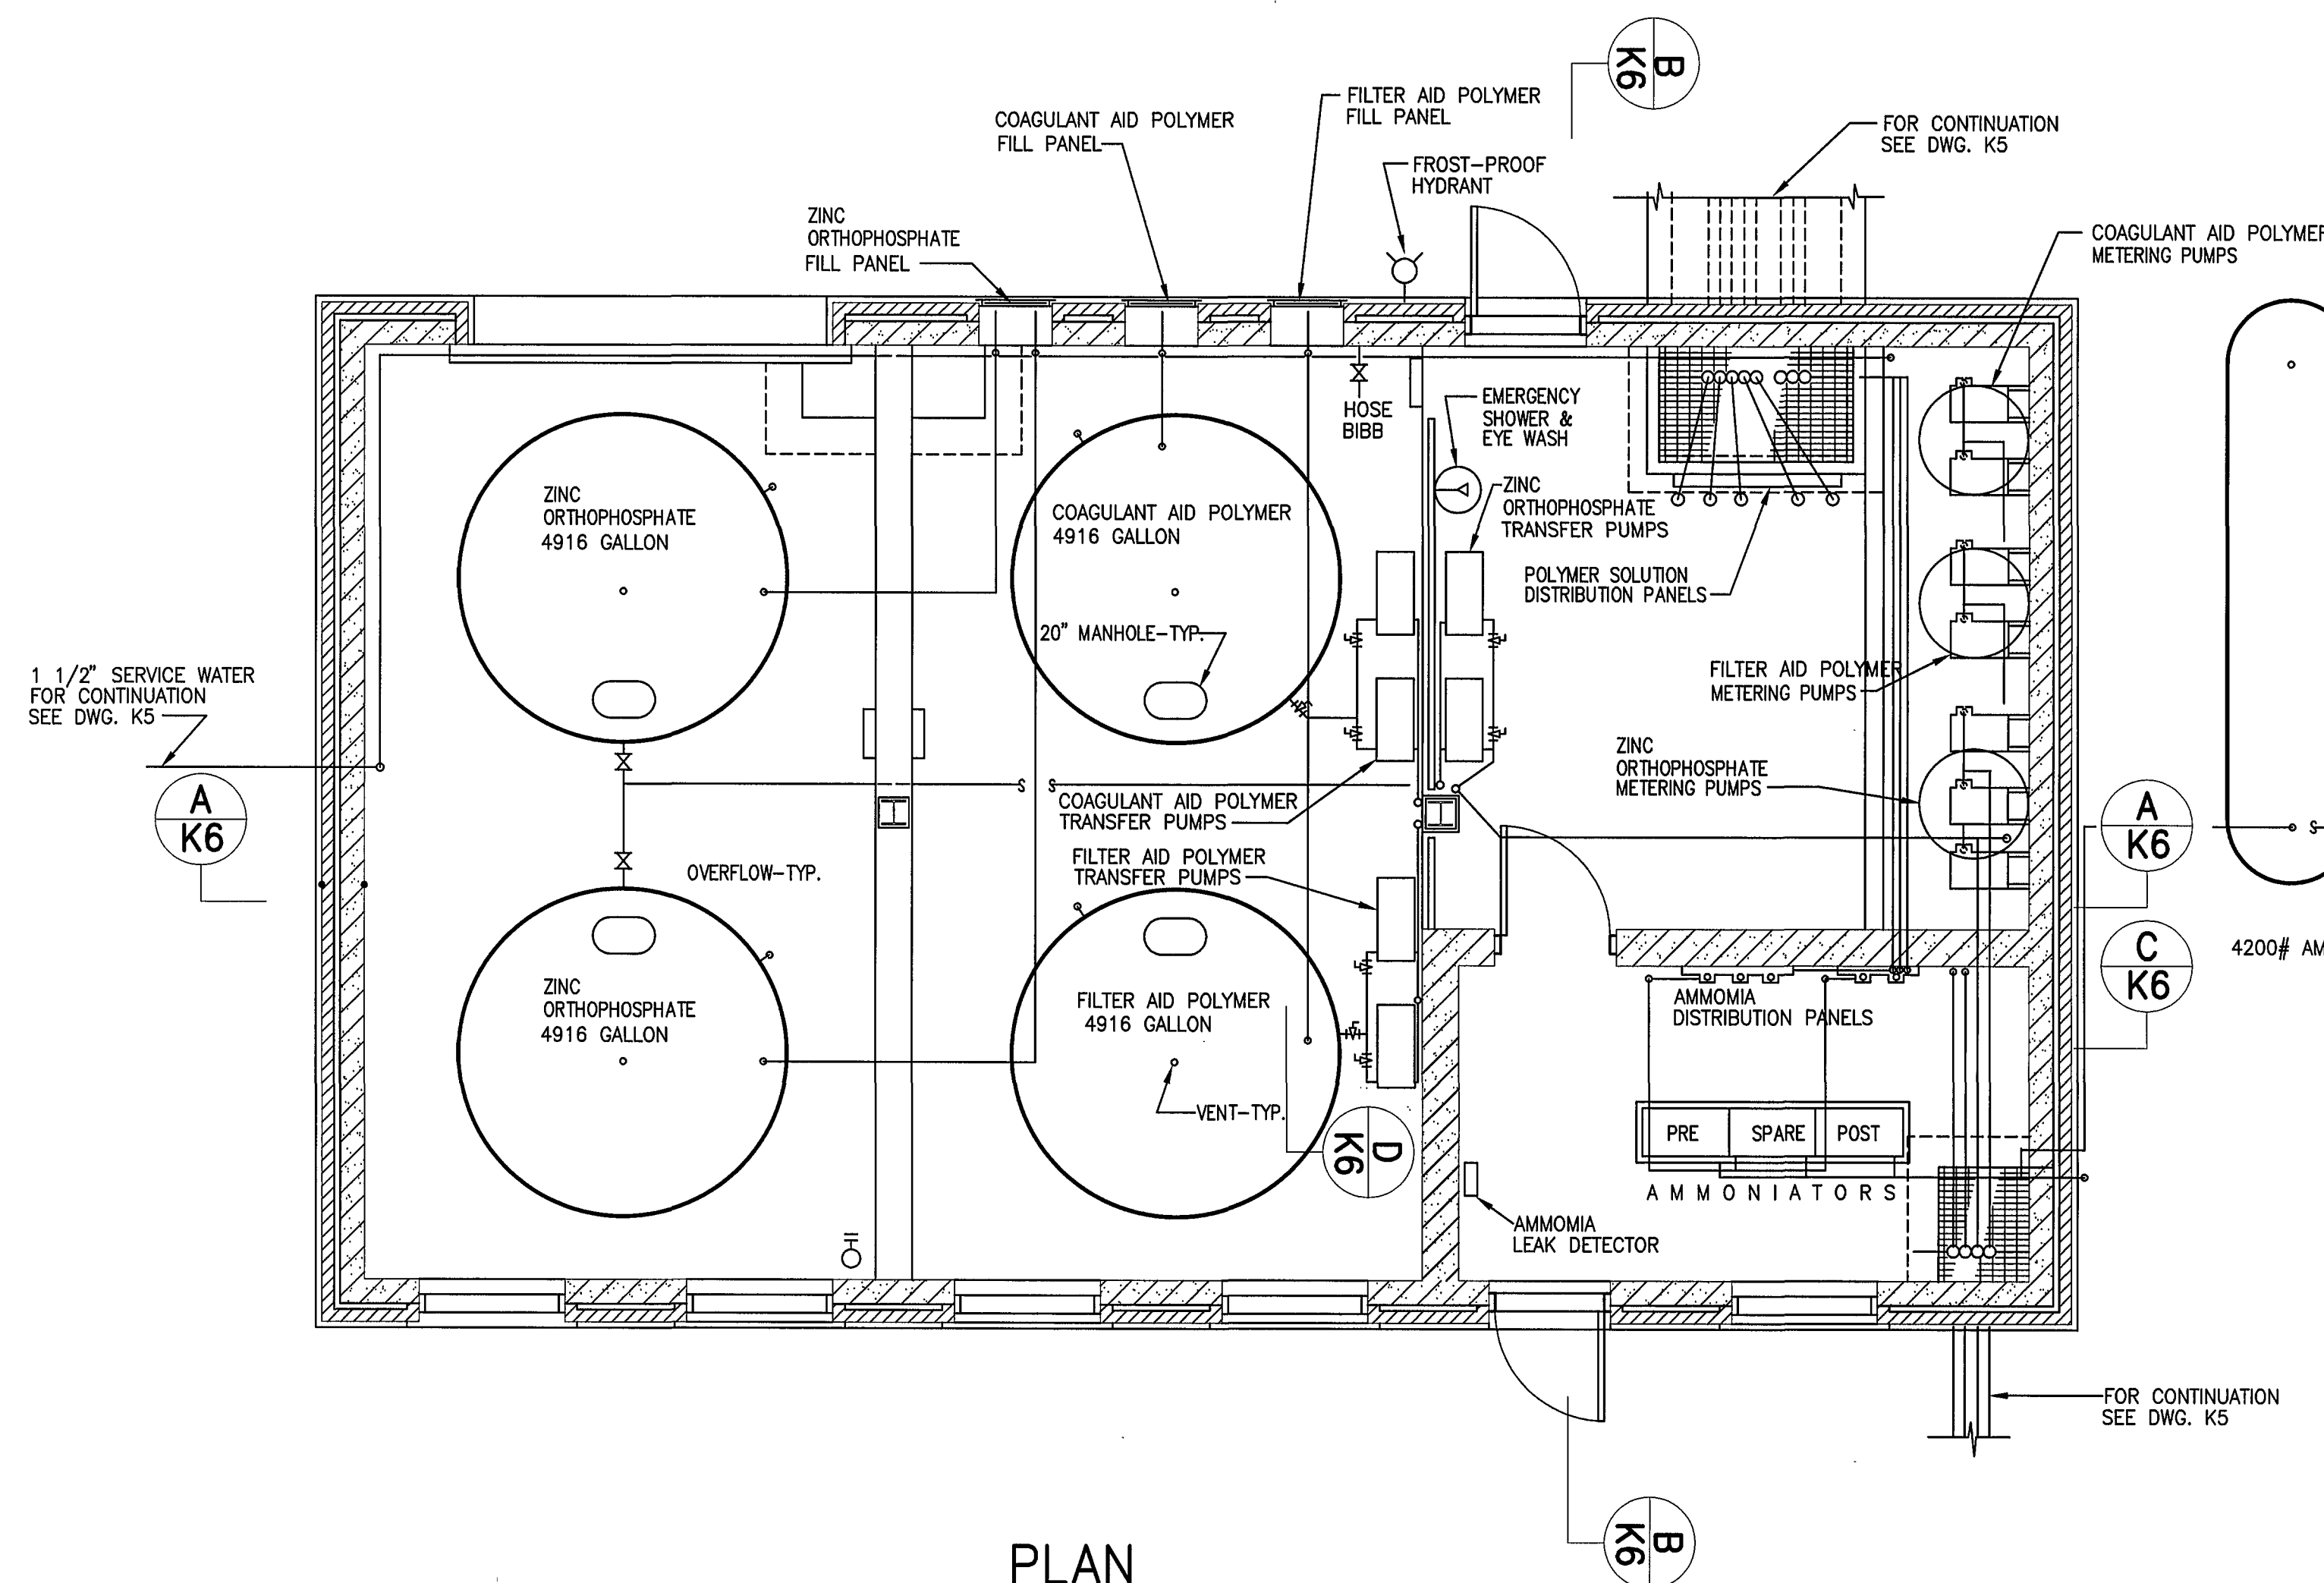


PLAN

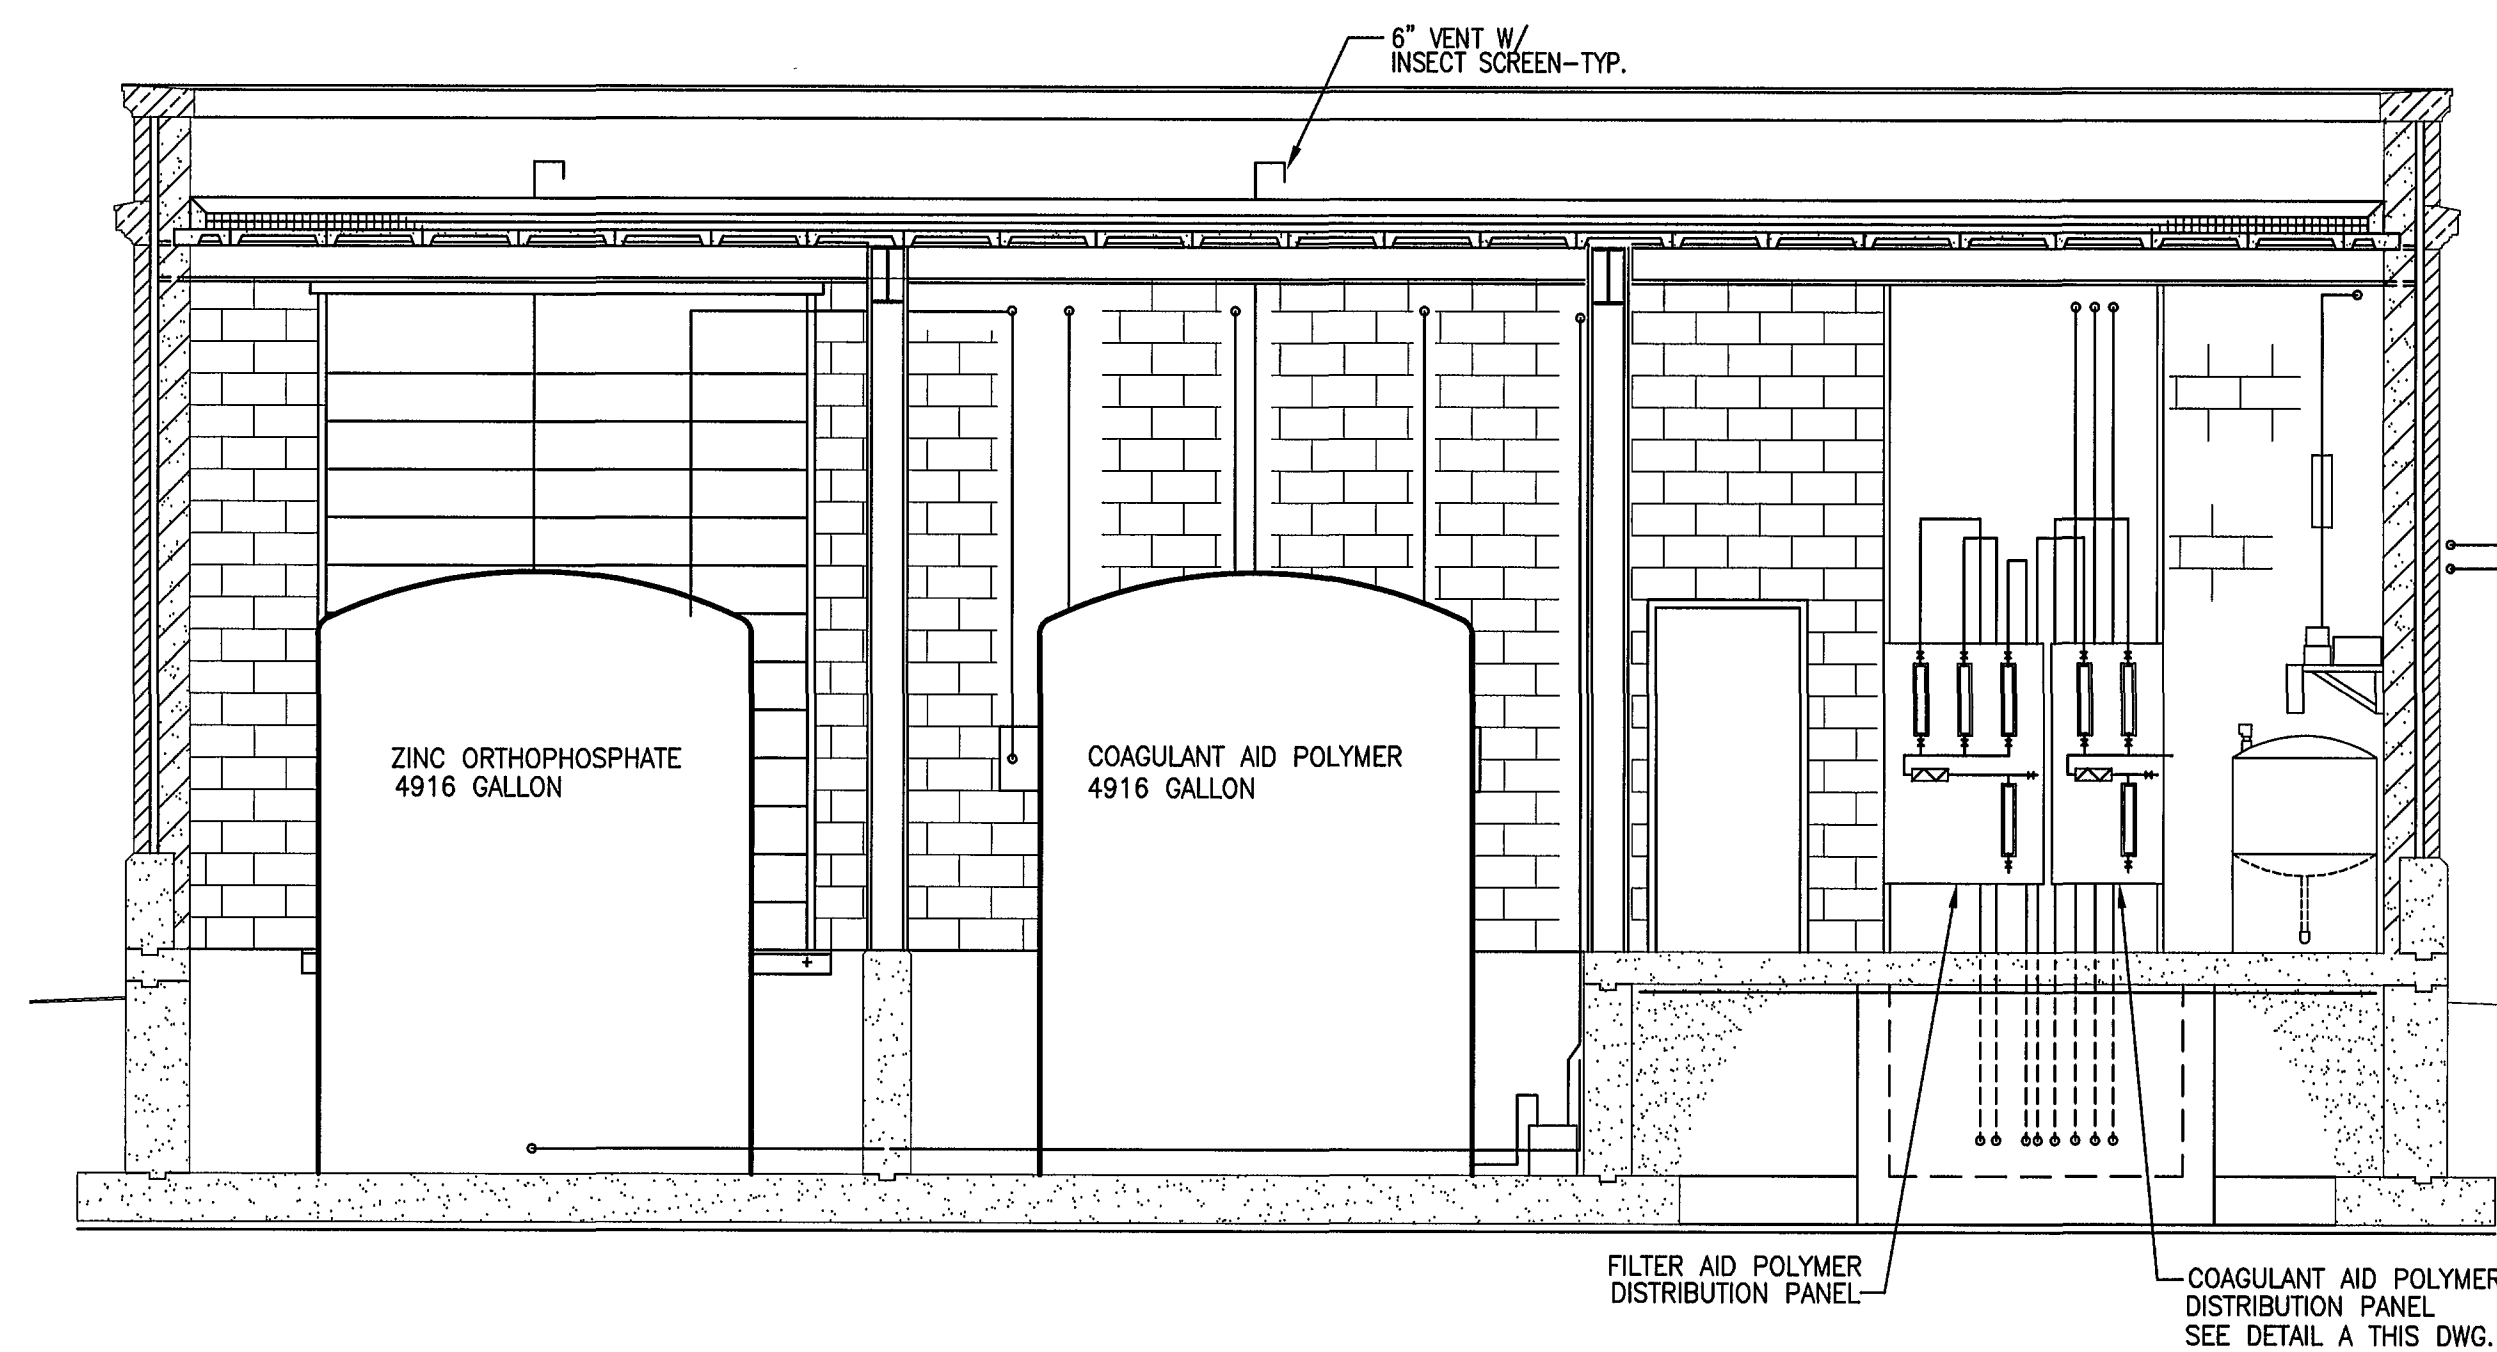

SECTION A K6

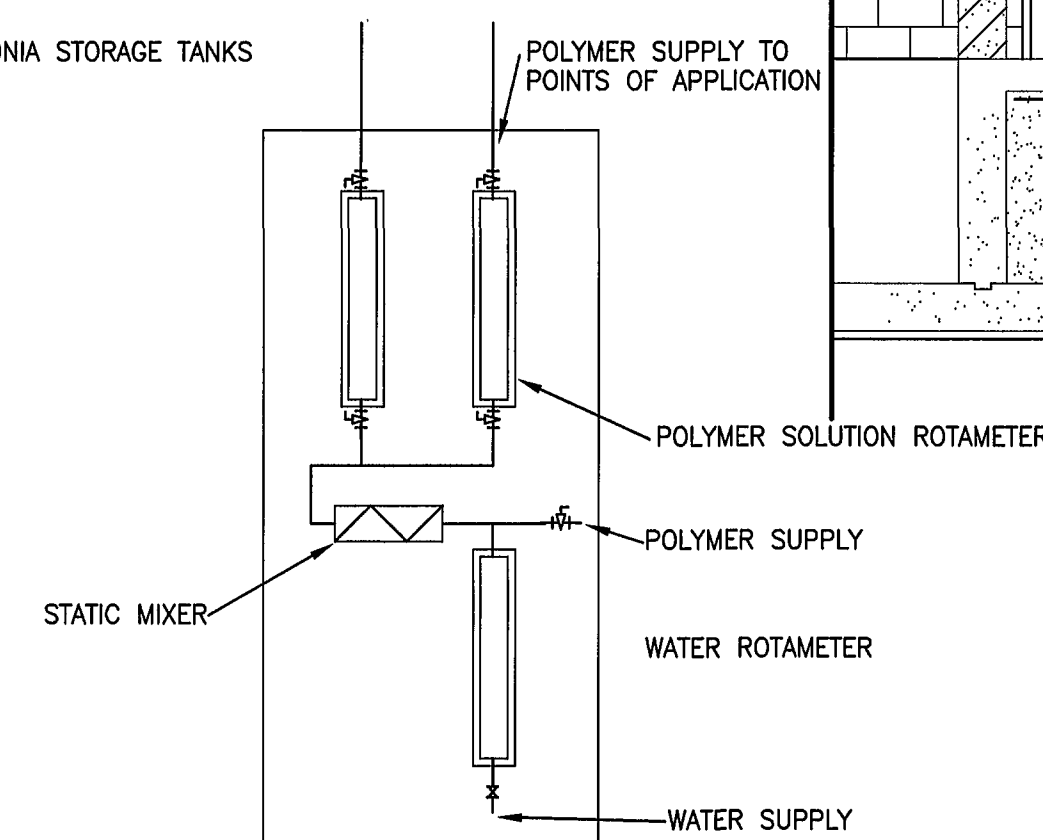


DETAIL A

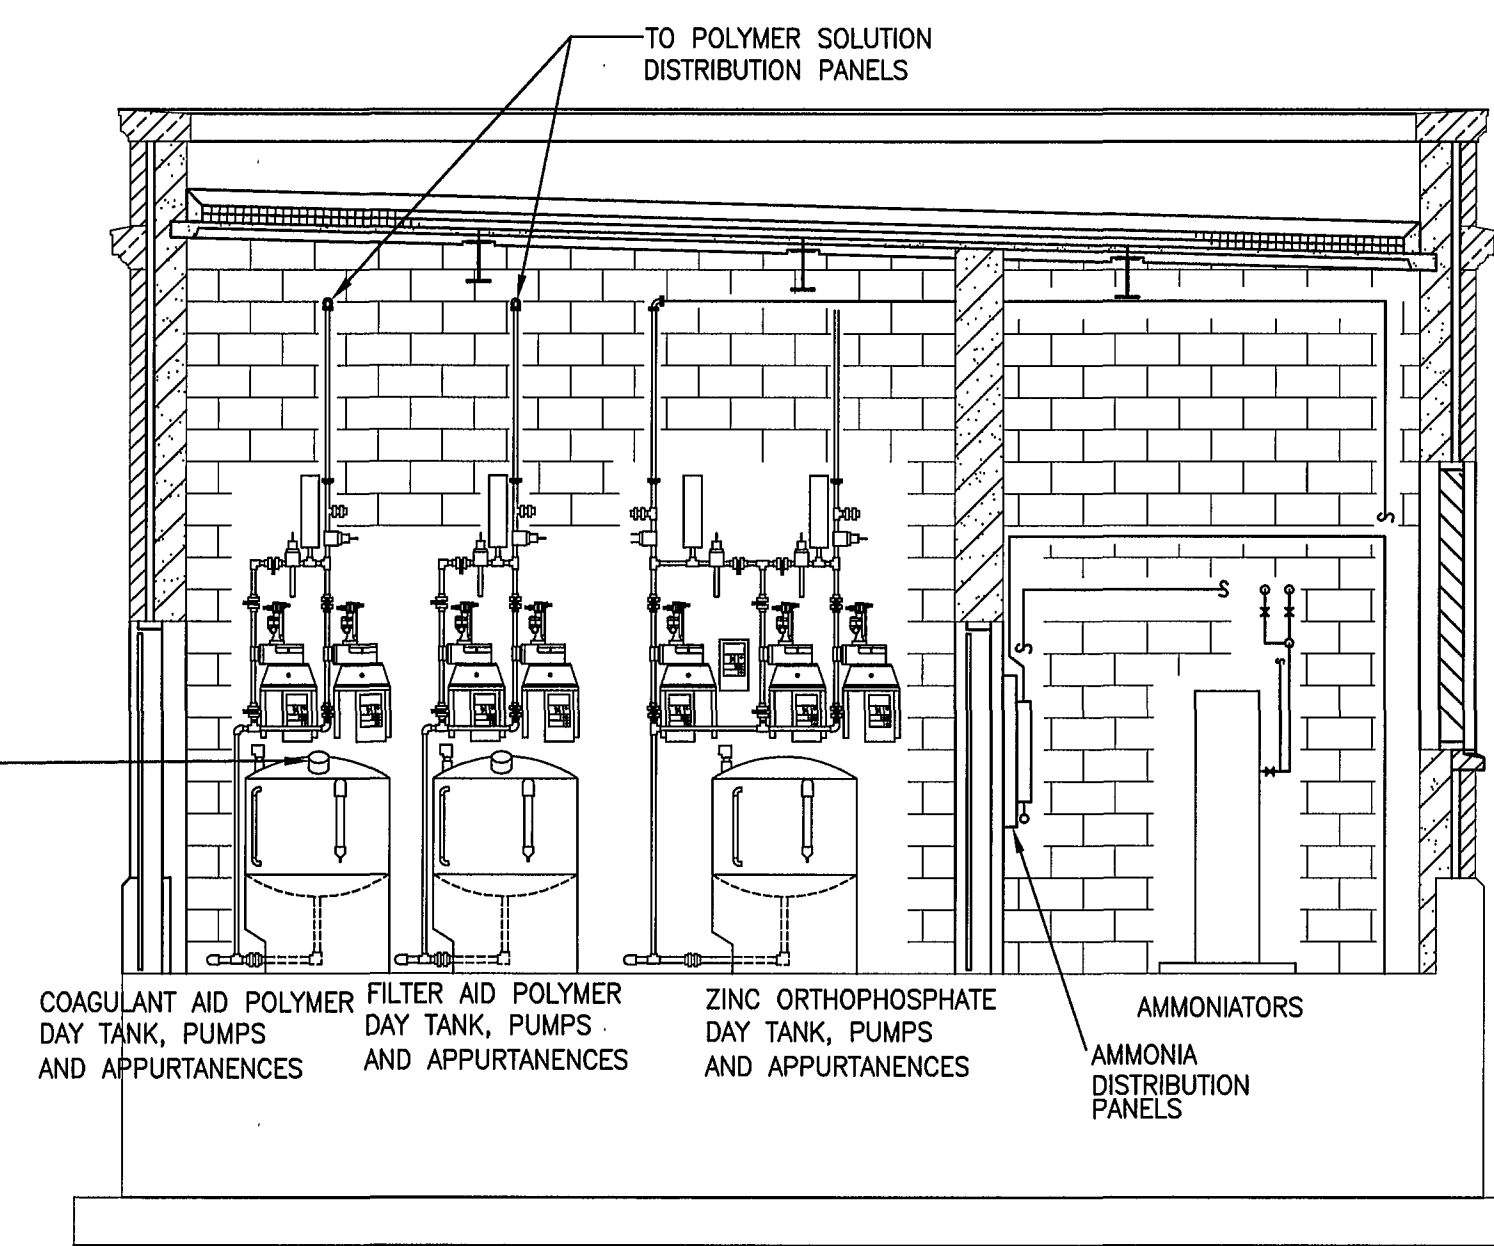


SECTION B K6

SEE SECTION 6 SHEET K4 FOR DETAILS OF PUMP SYSTEM COMPONENTS.

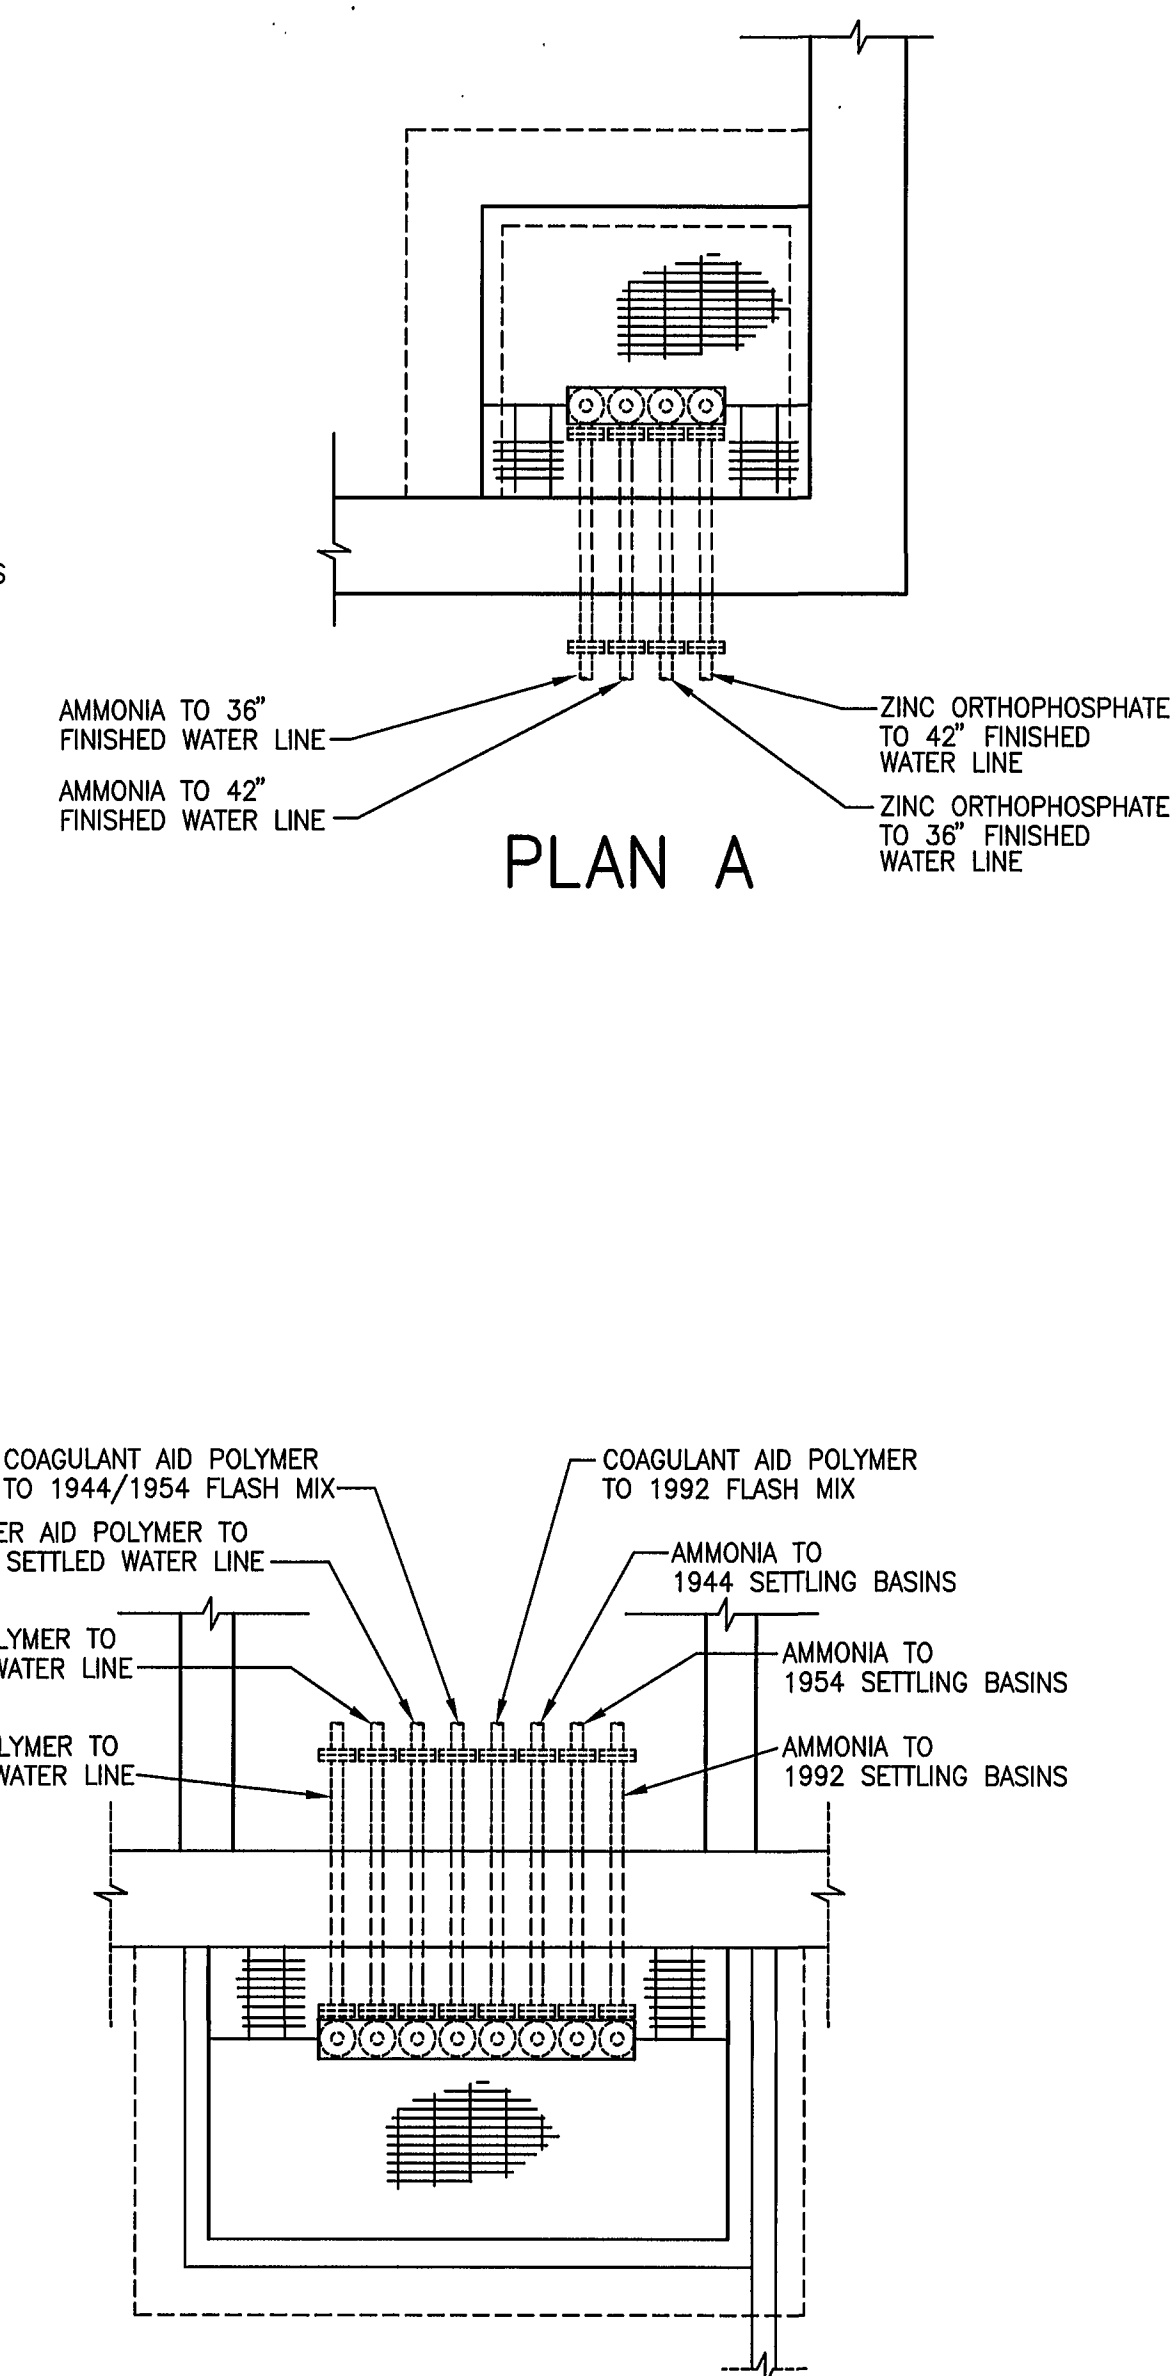

PLAN B

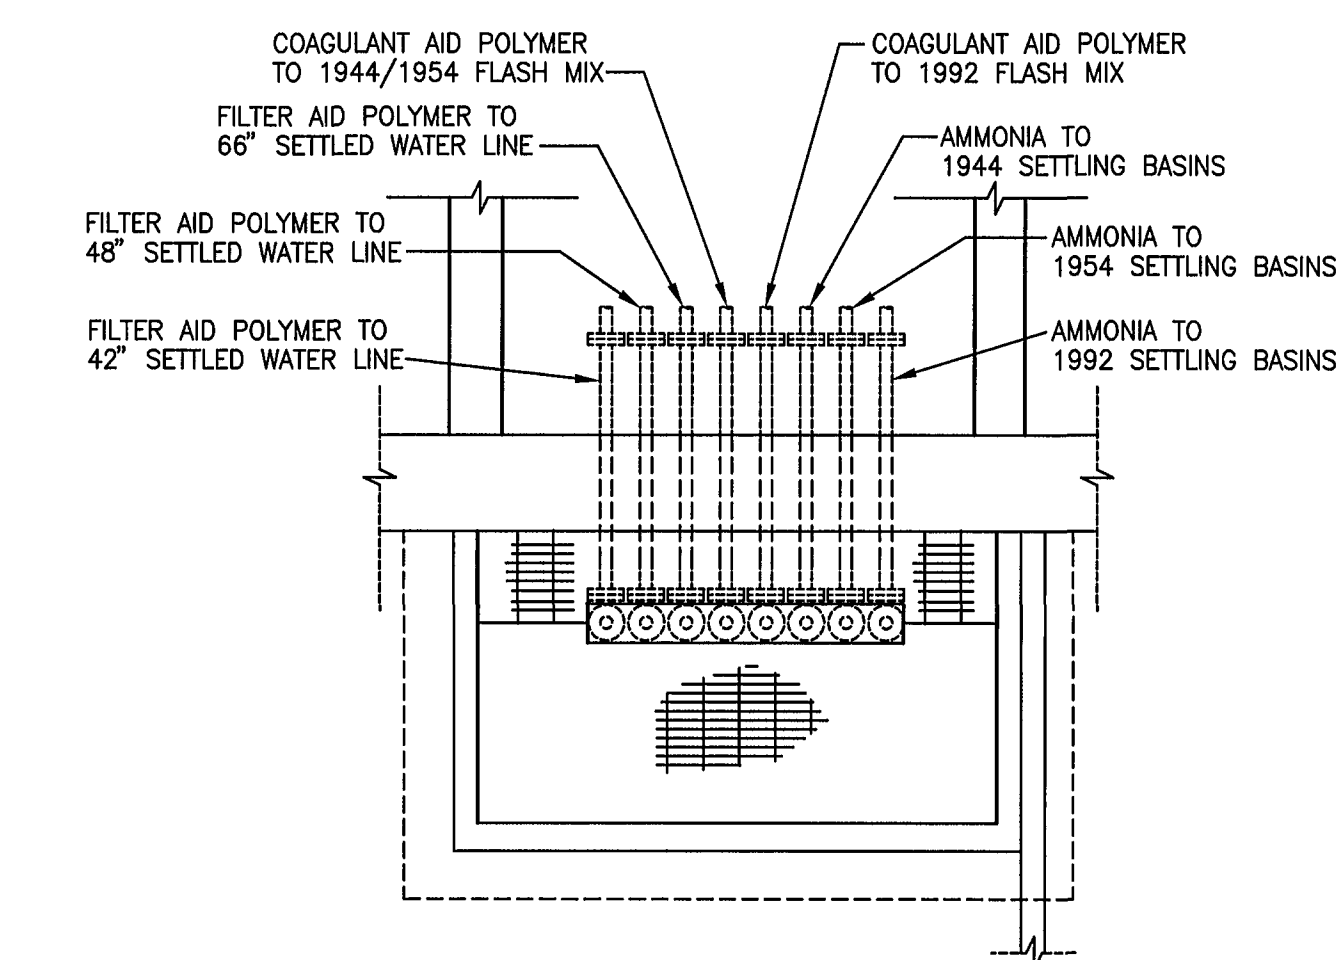

ELEVATION D K6

NOTES: FOR PIPING SIZE SEE SHEET K7.
FOR PIPING MATERIAL SEE SPECIFICATIONS, SECTION 15500.

DRAWING OF RECORD
DATE: SEP 30 1997

MATTERN & CRAIG CONSULTING ENGINEERS • SURVEYORS ROANOKE VIRGINIA	DESIGNED: C.L.		REV.	DATE	DESCRIPTION	BY	APP.	CARVINS COVE FILTER PLANT IMPROVEMENTS – PHASE I ROANOKE, VIRGINIA	DATE JULY 1992
	DRAWN: R.T.								
ALVORD, BURDICK & HOWSON ENGINEERS CHICAGO	CHECKED: Y.T.L.								CHEMICAL BUILDING 2 – PLAN & DETAILS