
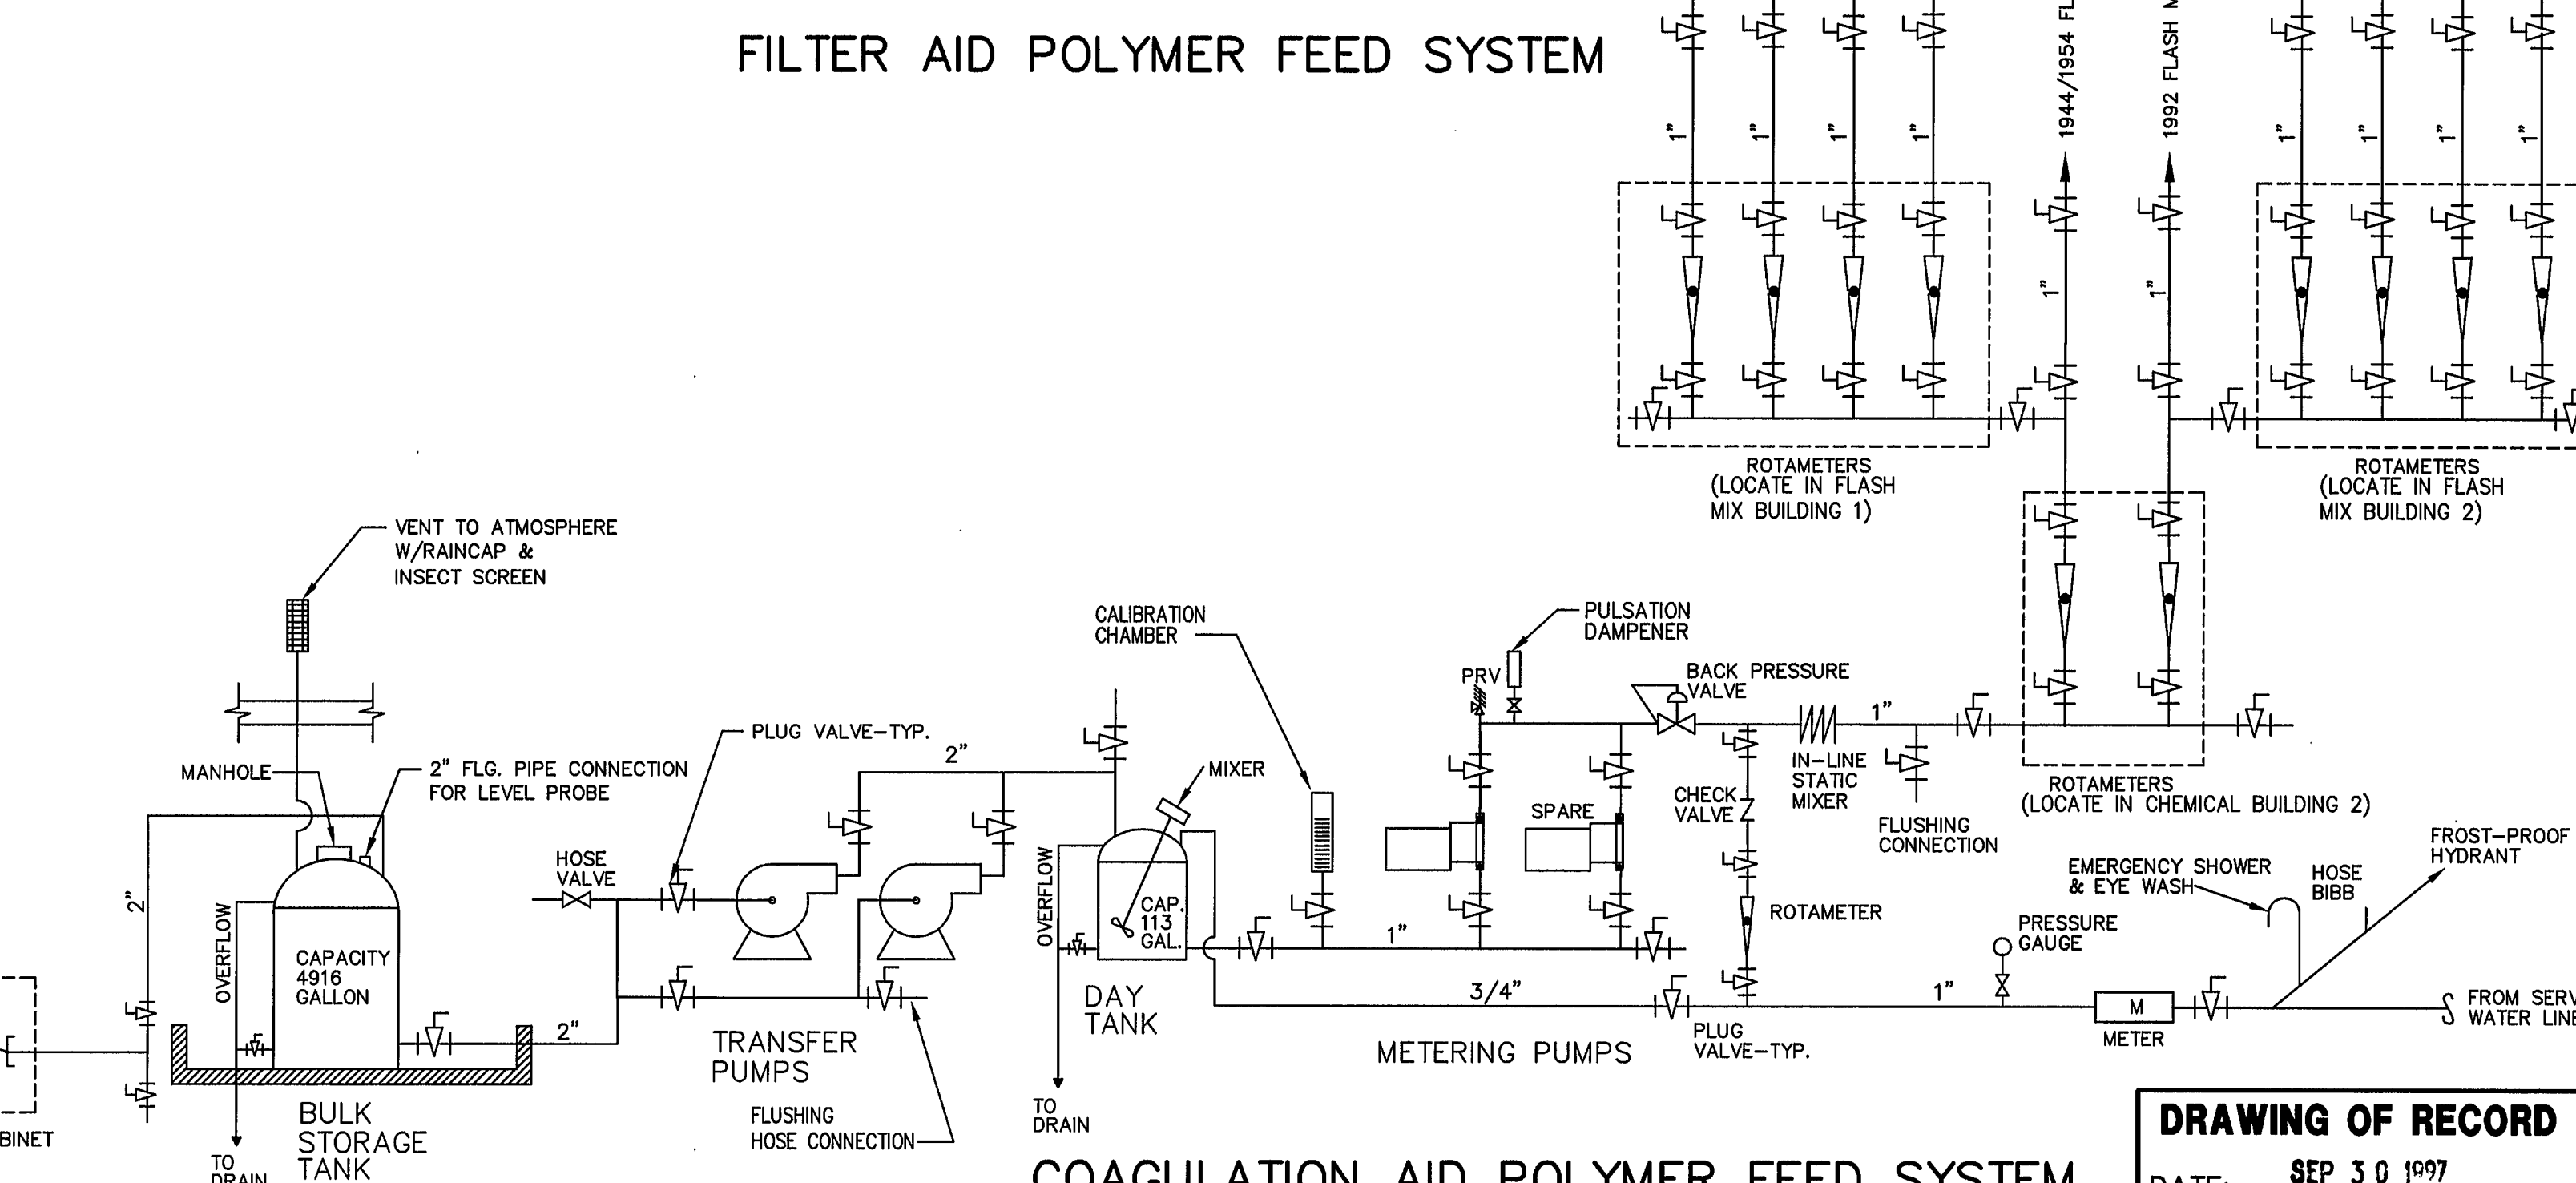
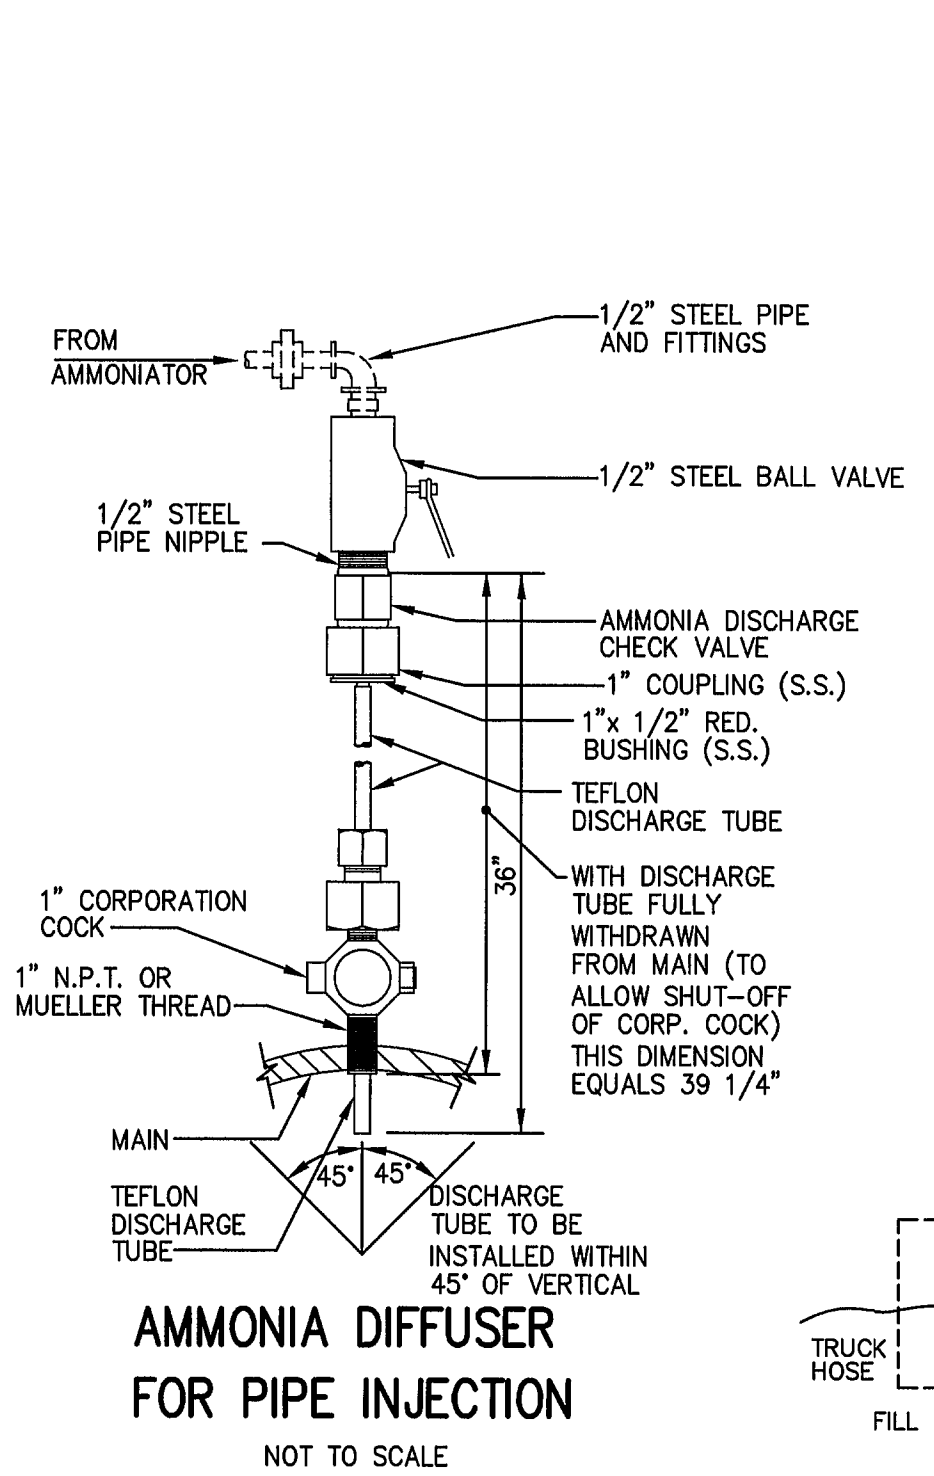
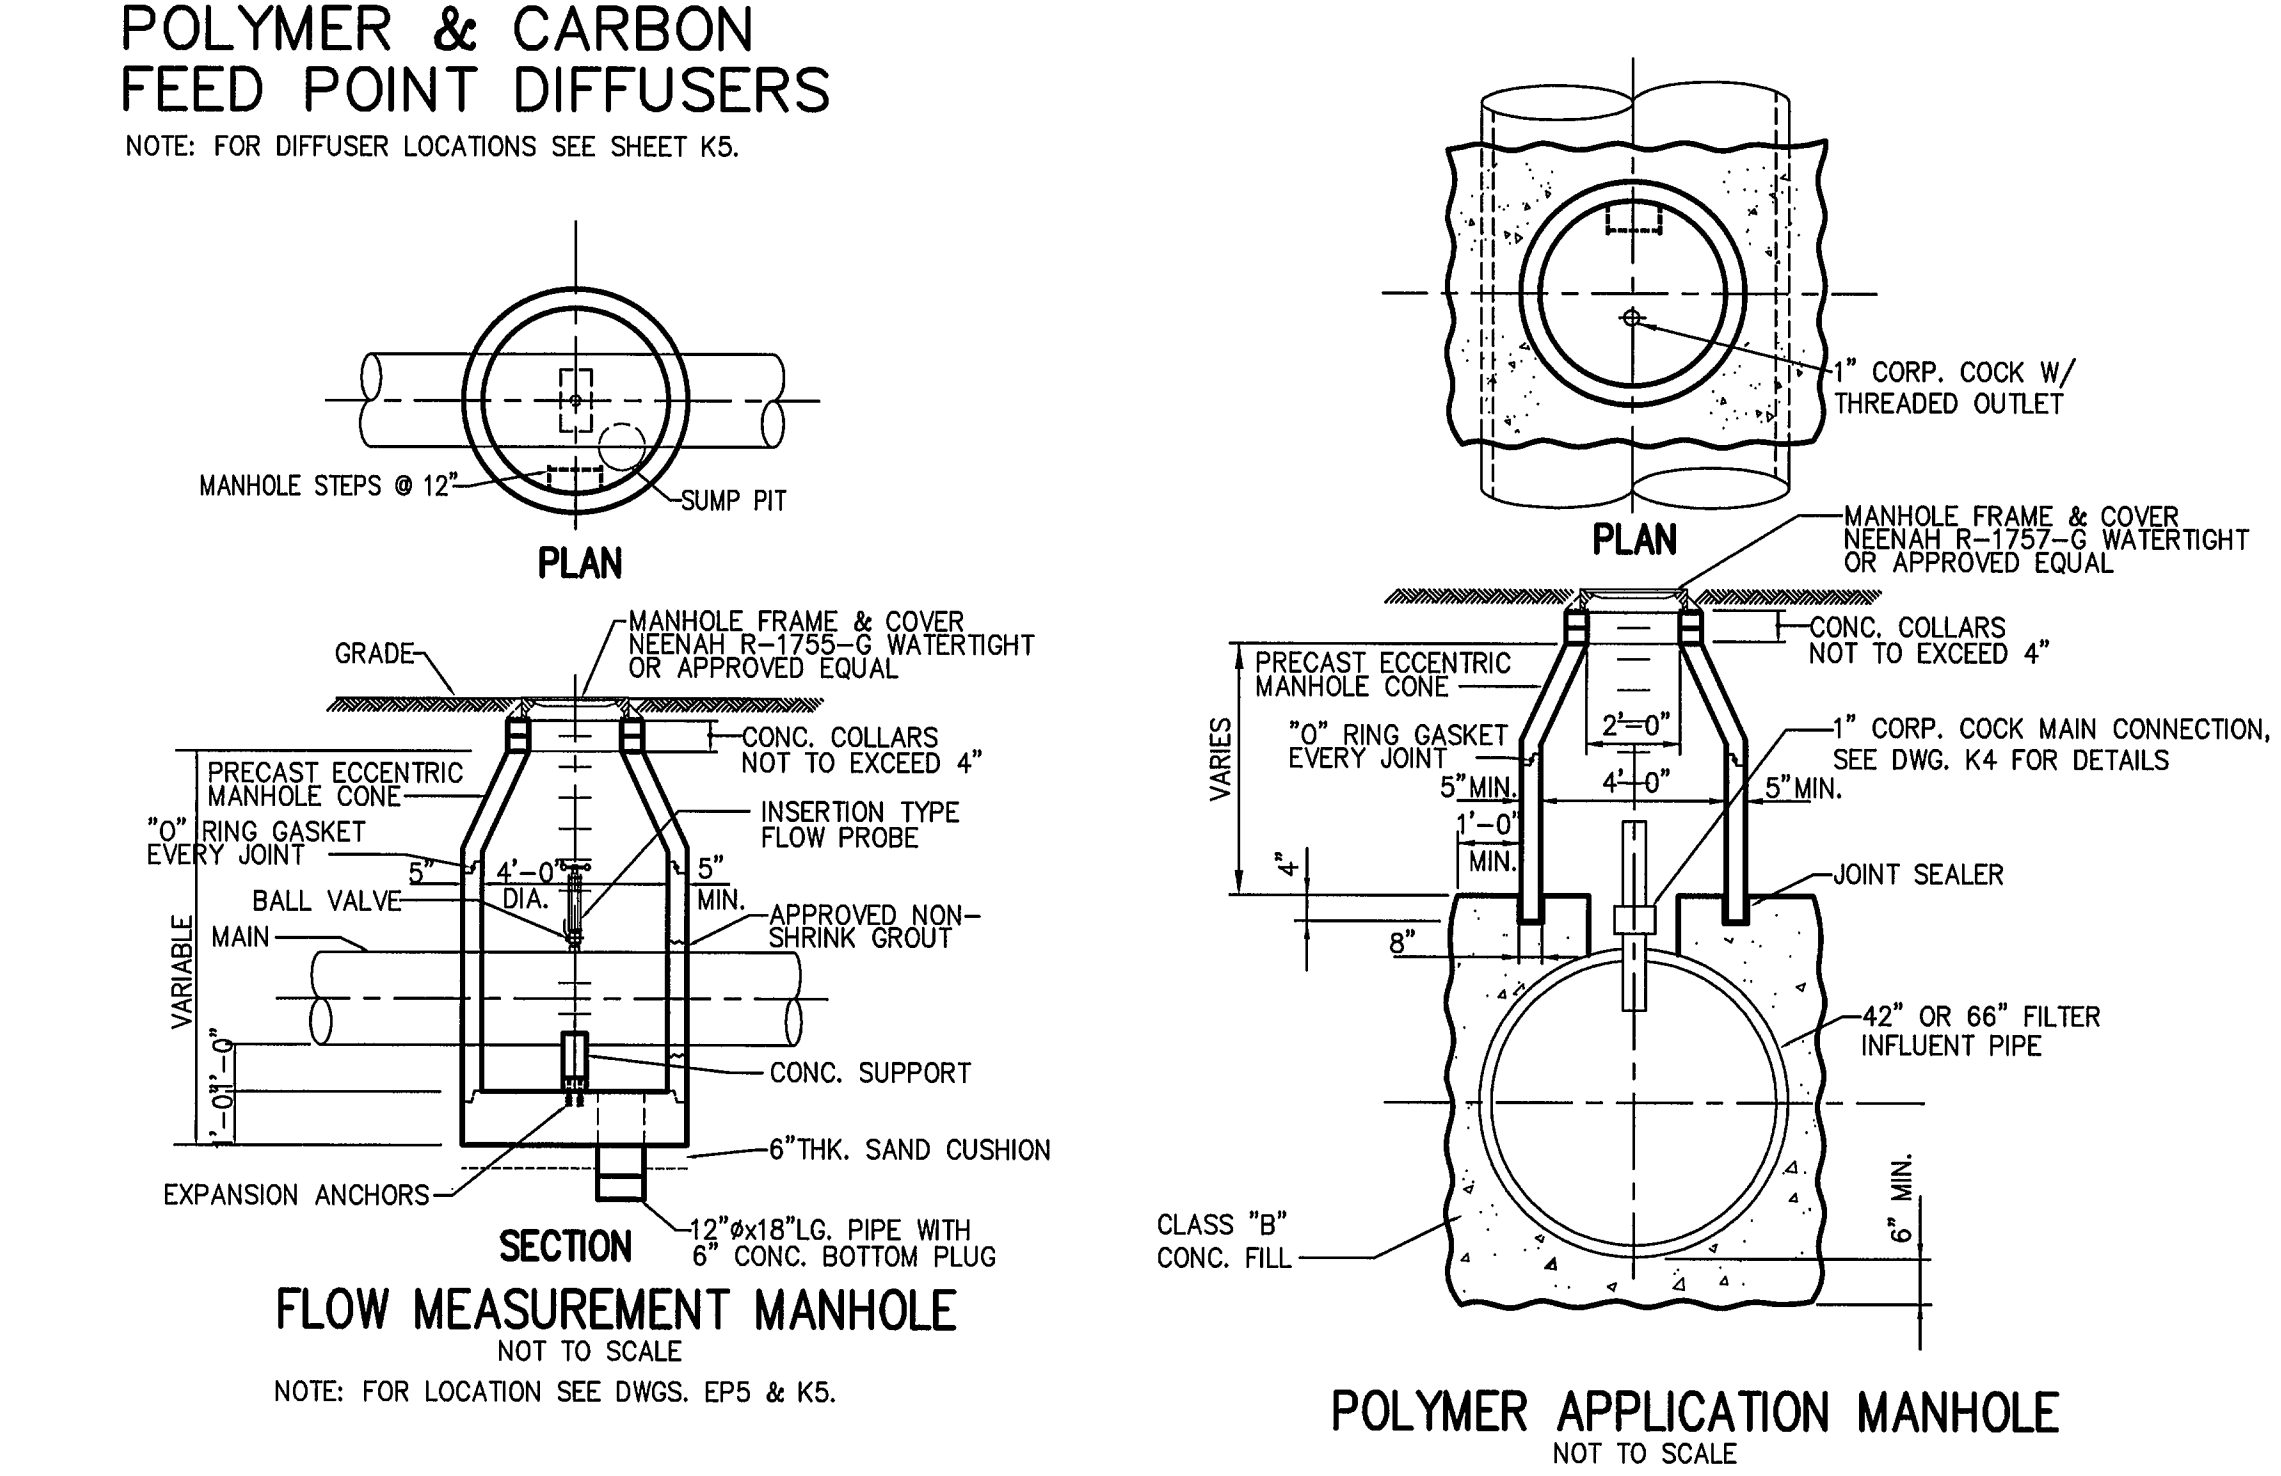
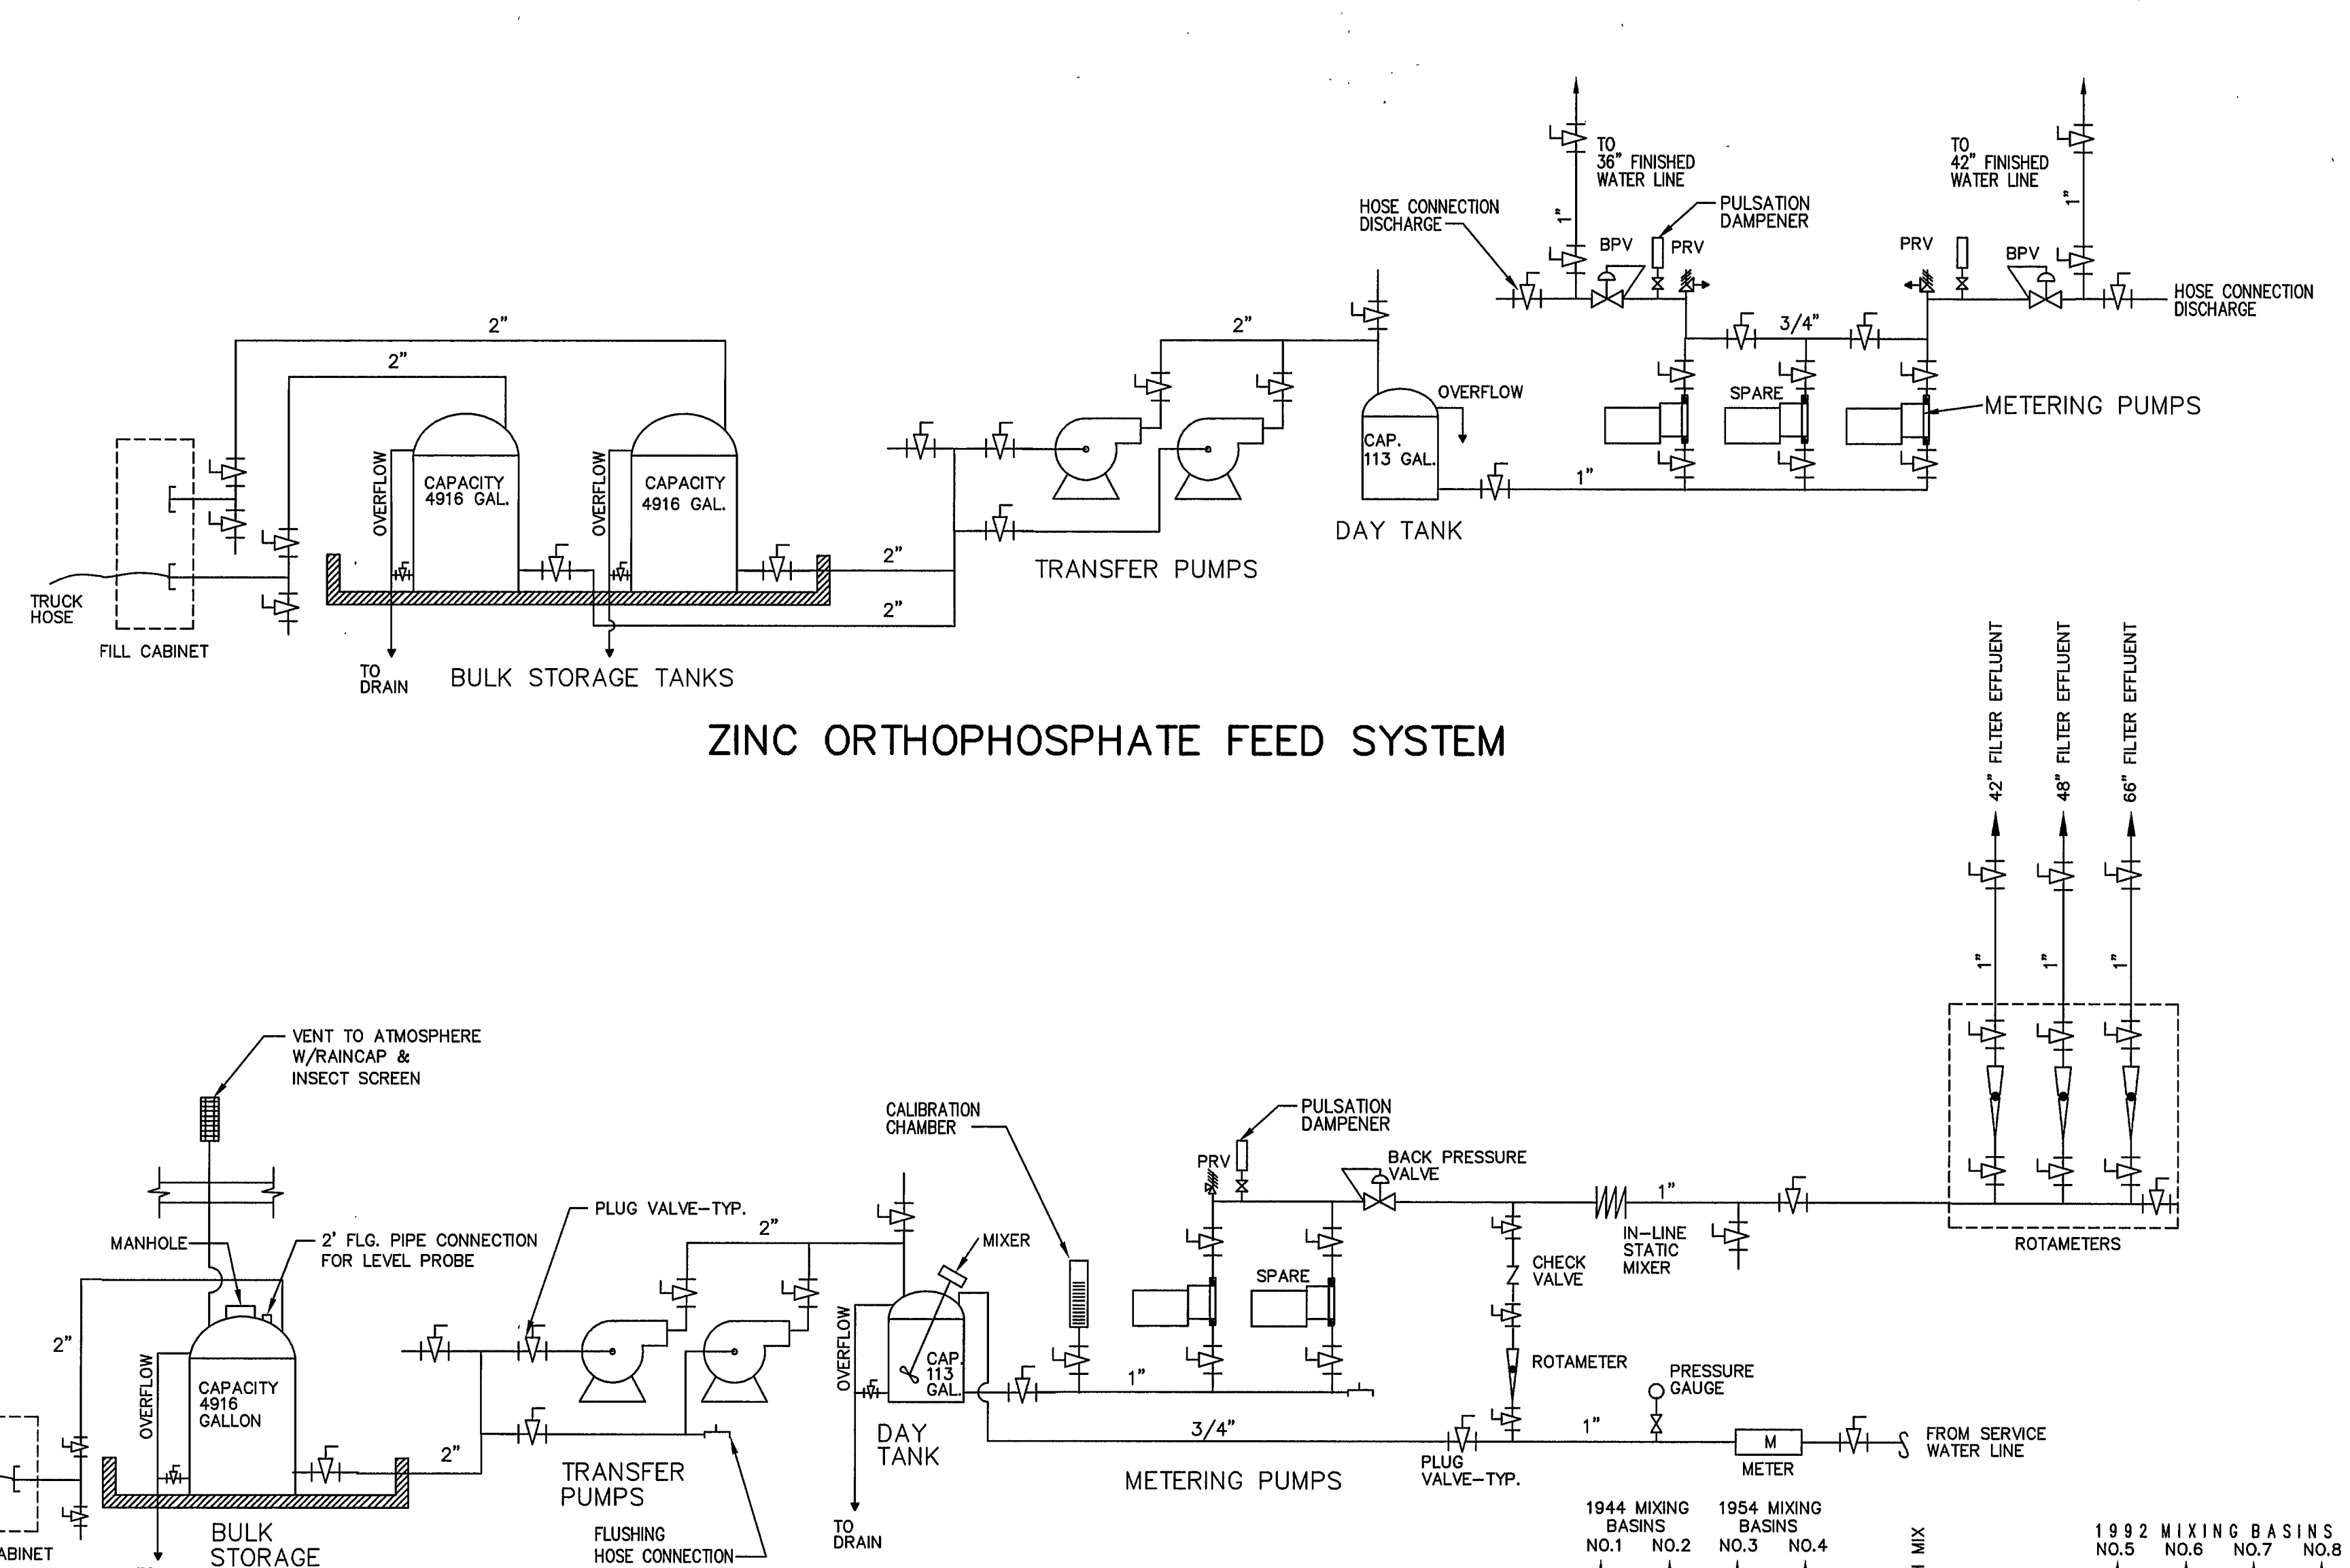


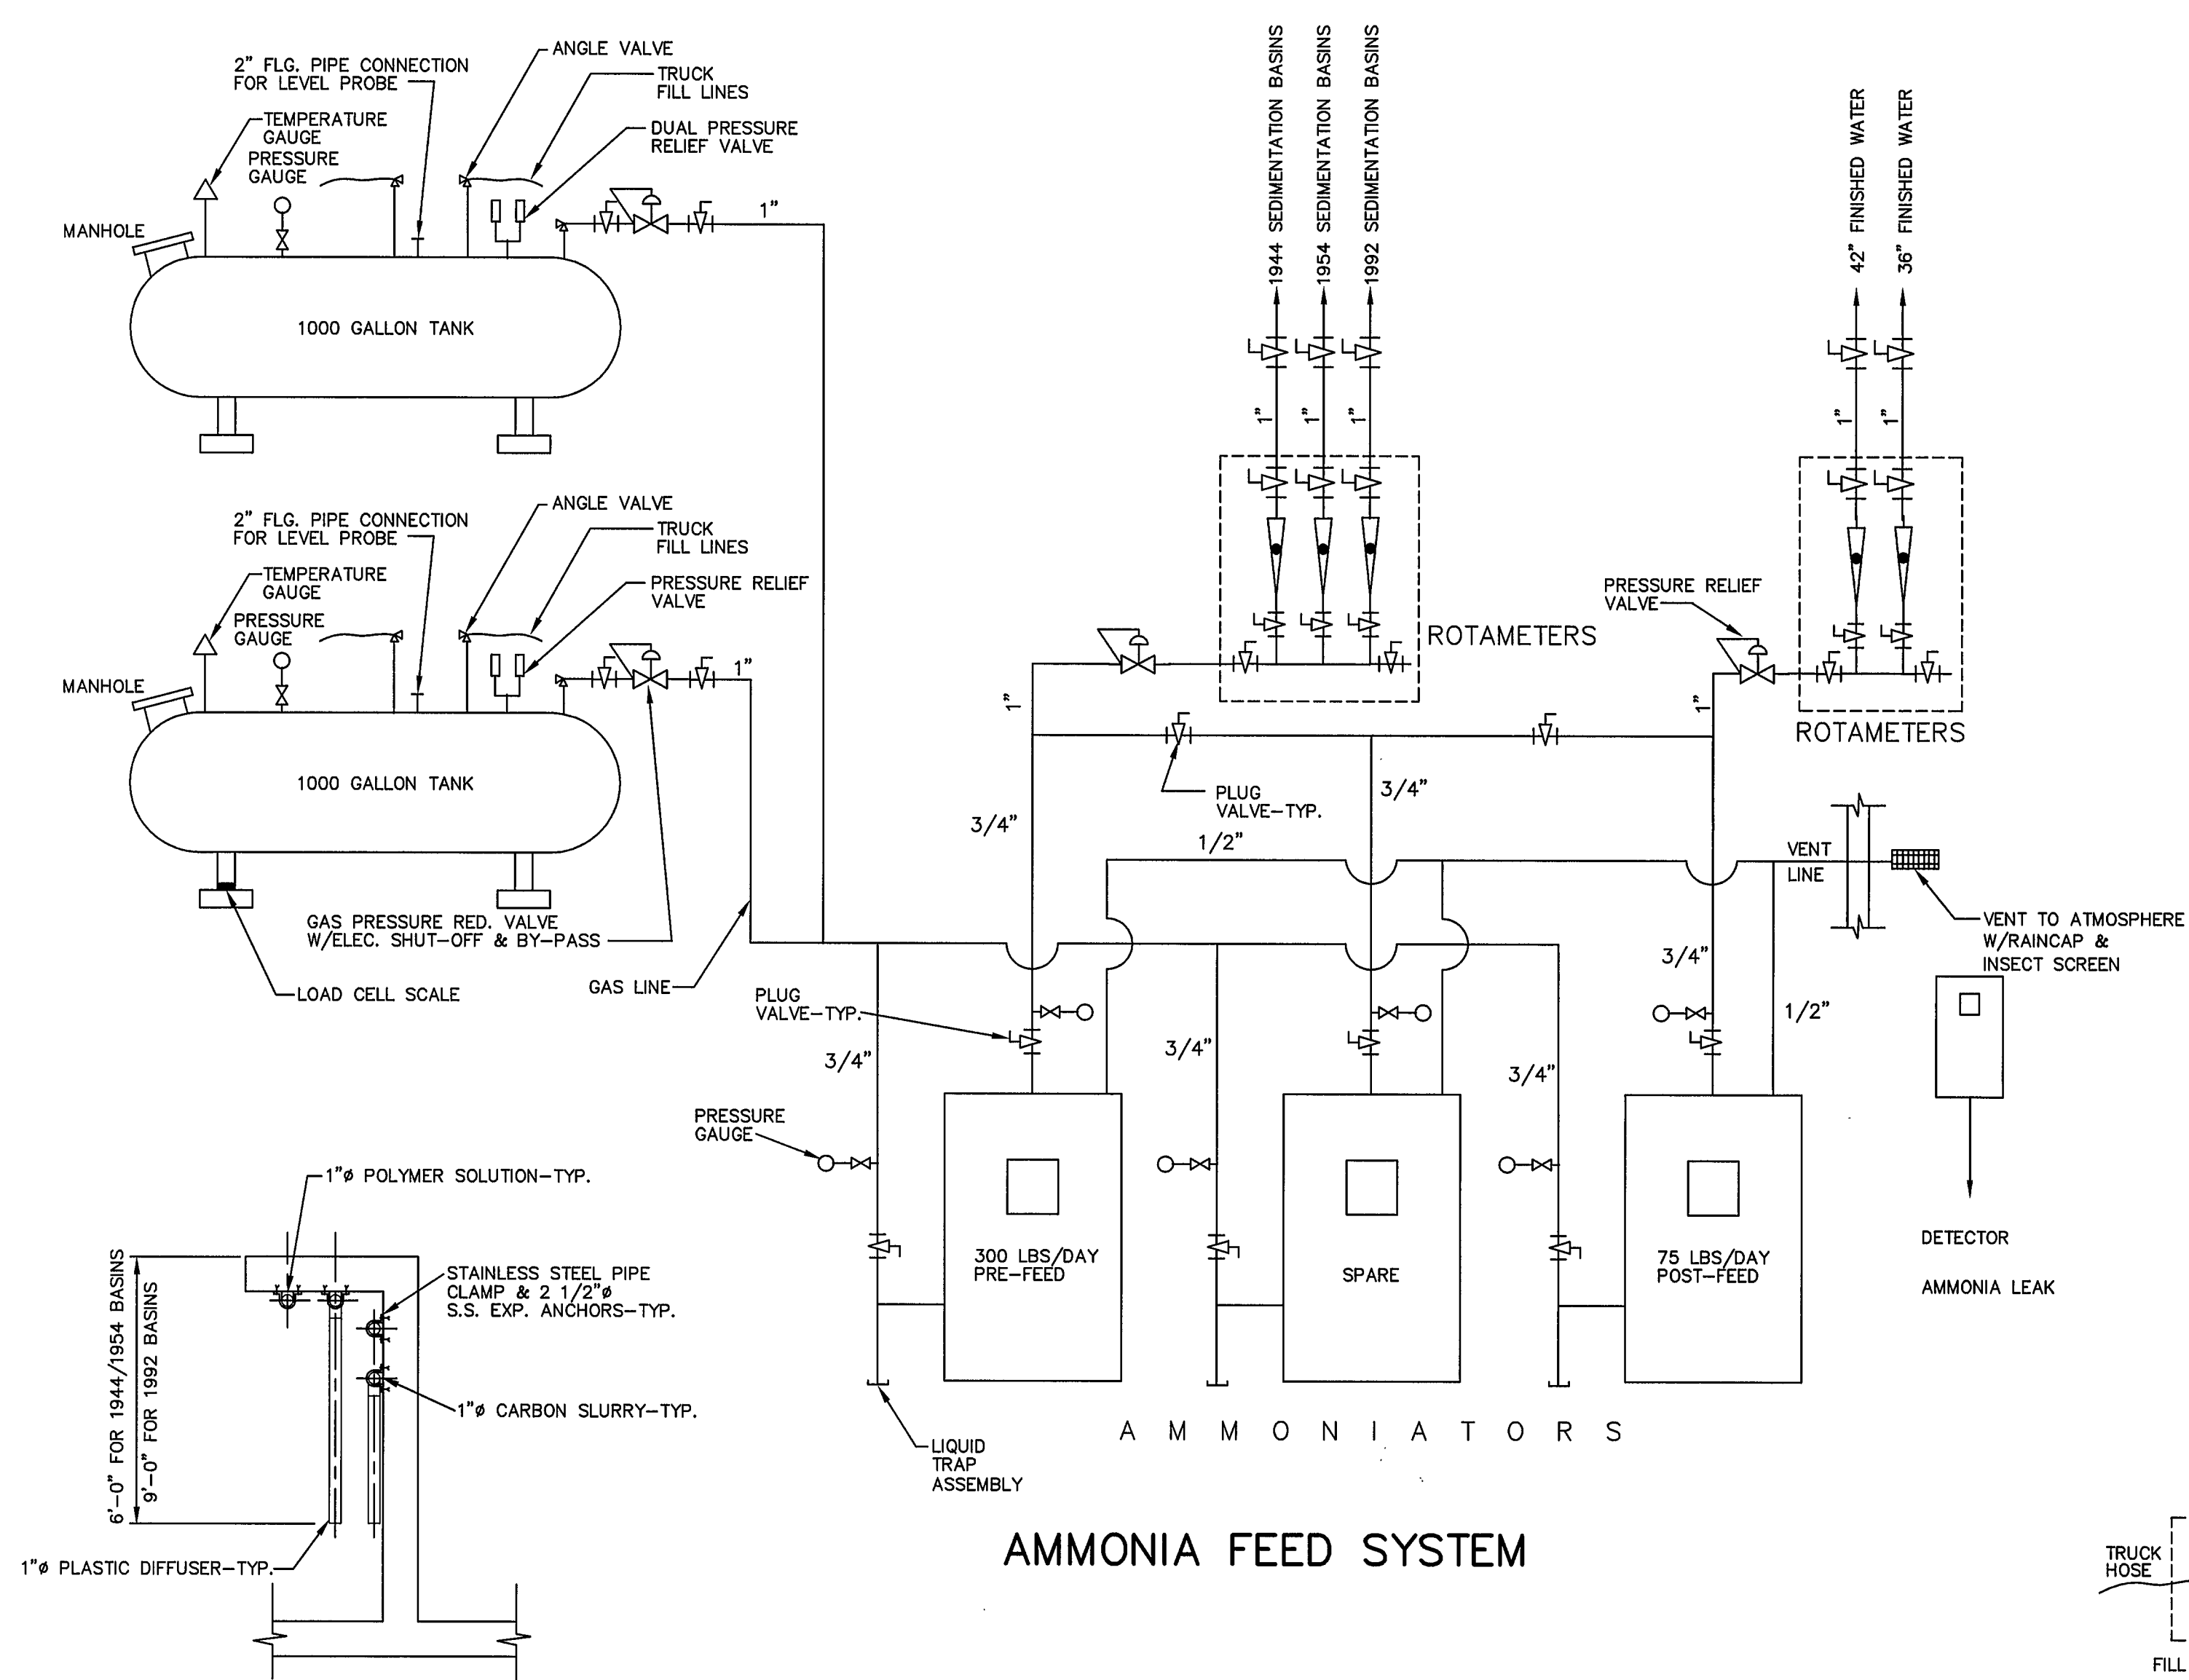

DRAWING OF RECORD
DATE: SEP 30 1997

MATTEN & CRAIG CONSULTING ENGINEERS • SURVEYORS ROANOKE VIRGINIA		DESIGNED: C.L. K.H.C. DRAWN: H.F. R.T. CHECKED: Y.T.L.	COMMONWEALTH OF VIRGINIA YA-TAI LIN NO. 022786 PROFESSIONAL ENGINEER	<table><tr><th>REV.</th><th>DATE</th><th>DESCRIPTION</th><th>BY</th><th>APP.</th></tr><tr><td> </td><td> </td><td> </td><td> </td><td> </td></tr><tr><td> </td><td> </td><td> </td><td> </td><td> </td></tr><tr><td> </td><td> </td><td> </td><td> </td><td> </td></tr><tr><td> </td><td> </td><td> </td><td> </td><td> </td></tr><tr><td> </td><td> </td><td> </td><td> </td><td> </td></tr></table>	REV.	DATE	DESCRIPTION	BY	APP.																										CARVINS COVE FILTER PLANT IMPROVEMENTS – PHASE I ROANOKE, VIRGINIA CHEMICAL BUILDING 2 – SCHEMATICS	DATE JULY 1992 COMM. NO. 9130 SHEET K7
REV.	DATE	DESCRIPTION	BY	APP.																																