


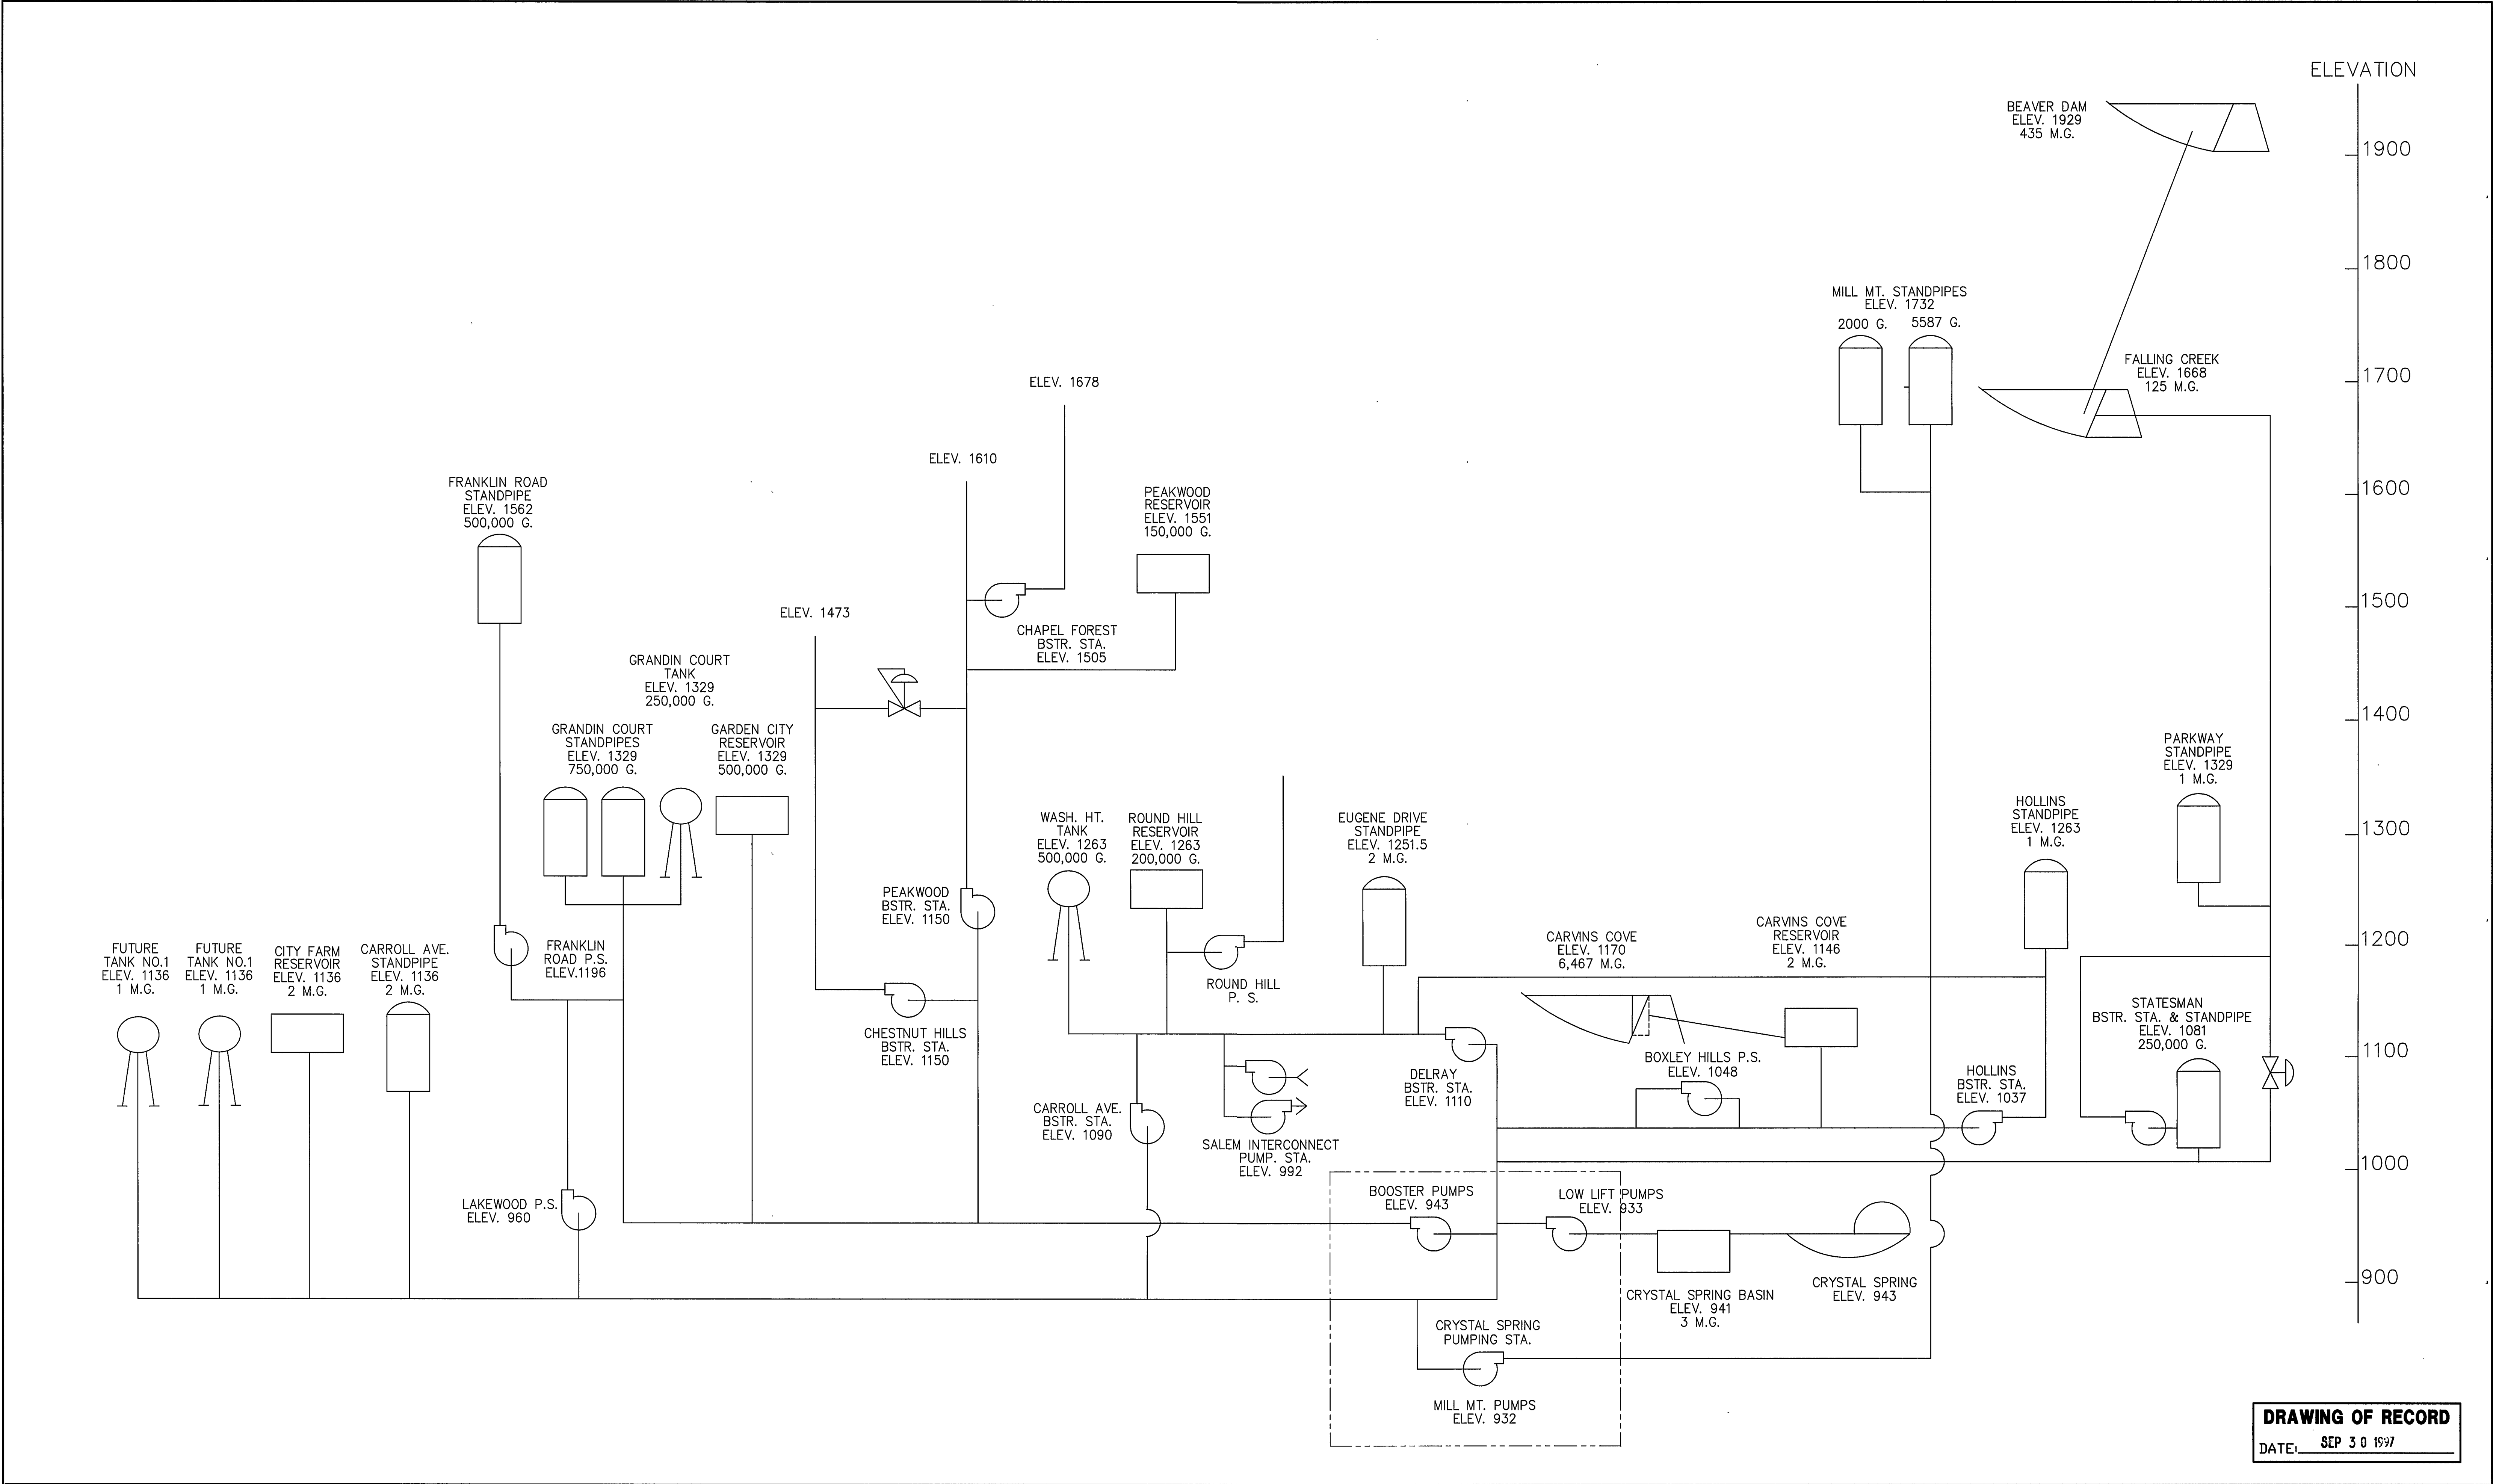

DRAWING OF RECORD
DATE: SEP 30 1997

MATTERN & CRAIG CONSULTING ENGINEERS • SURVEYORS ROANOKE VIRGINIA	DESIGNED: KCC/RRA		REV.	DATE	DESCRIPTION	BY	APP.	CARVINS COVE FILTER PLANT IMPROVEMENTS – PHASE I ROANOKE, VIRGINIA		DATE APRIL 1992
	DRAWN: KGP									COMM. NO. 9130
ALVORD, BURDICK & HOWSON ENGINEERS CHICAGO	CHECKED: RRA							WATER SYSTEM SCHEMATIC		SHEET SR2