



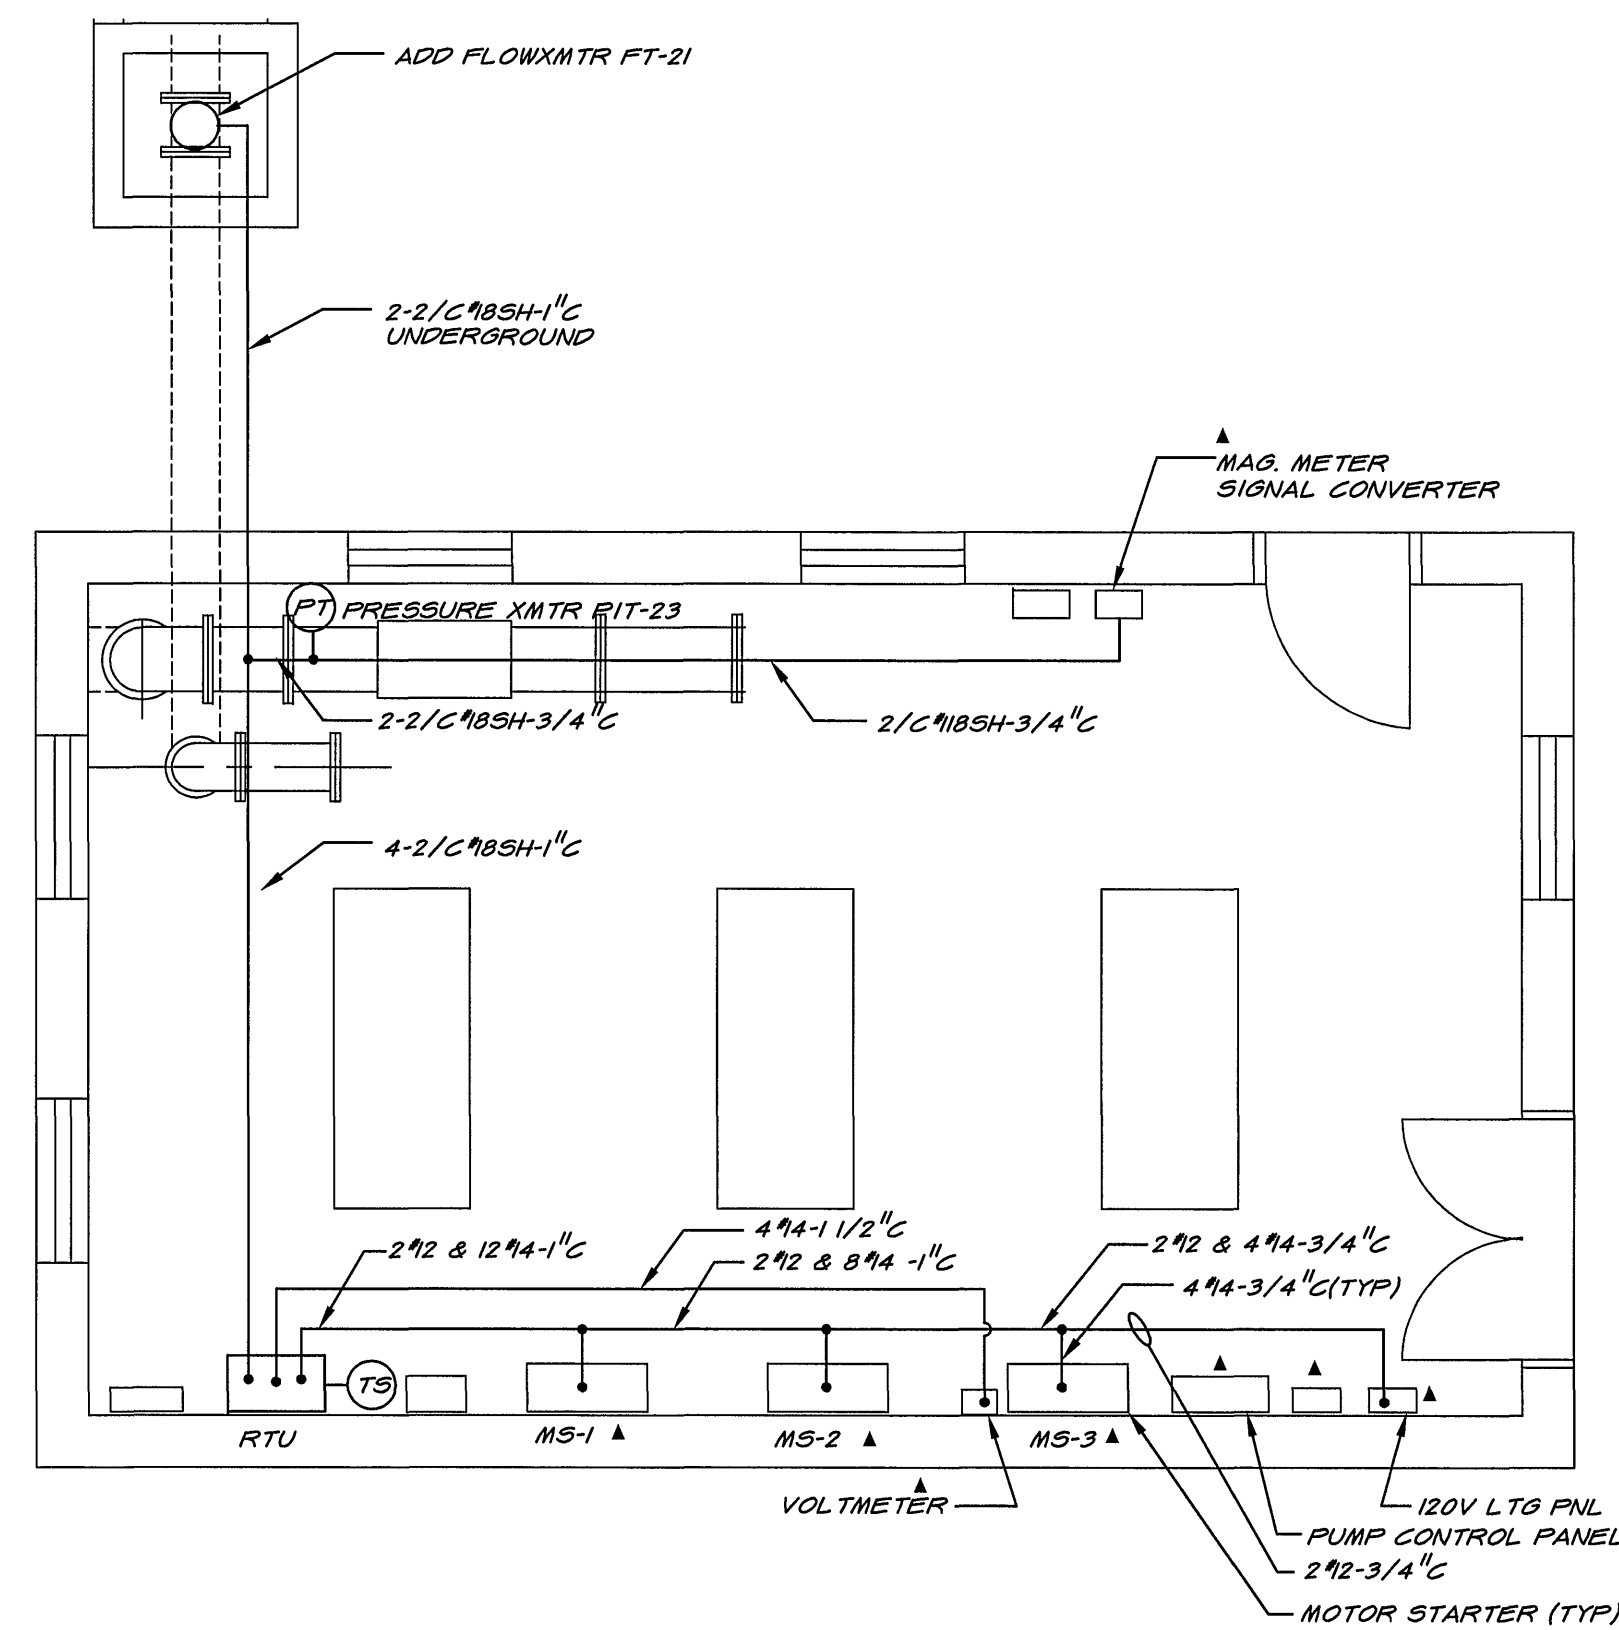

PLAN OF DELRAY PUMPING STATION


SCALE OF DRAWING 1/4" = 1'-0"

▲ DENOTES EXISTING EQUIPMENT

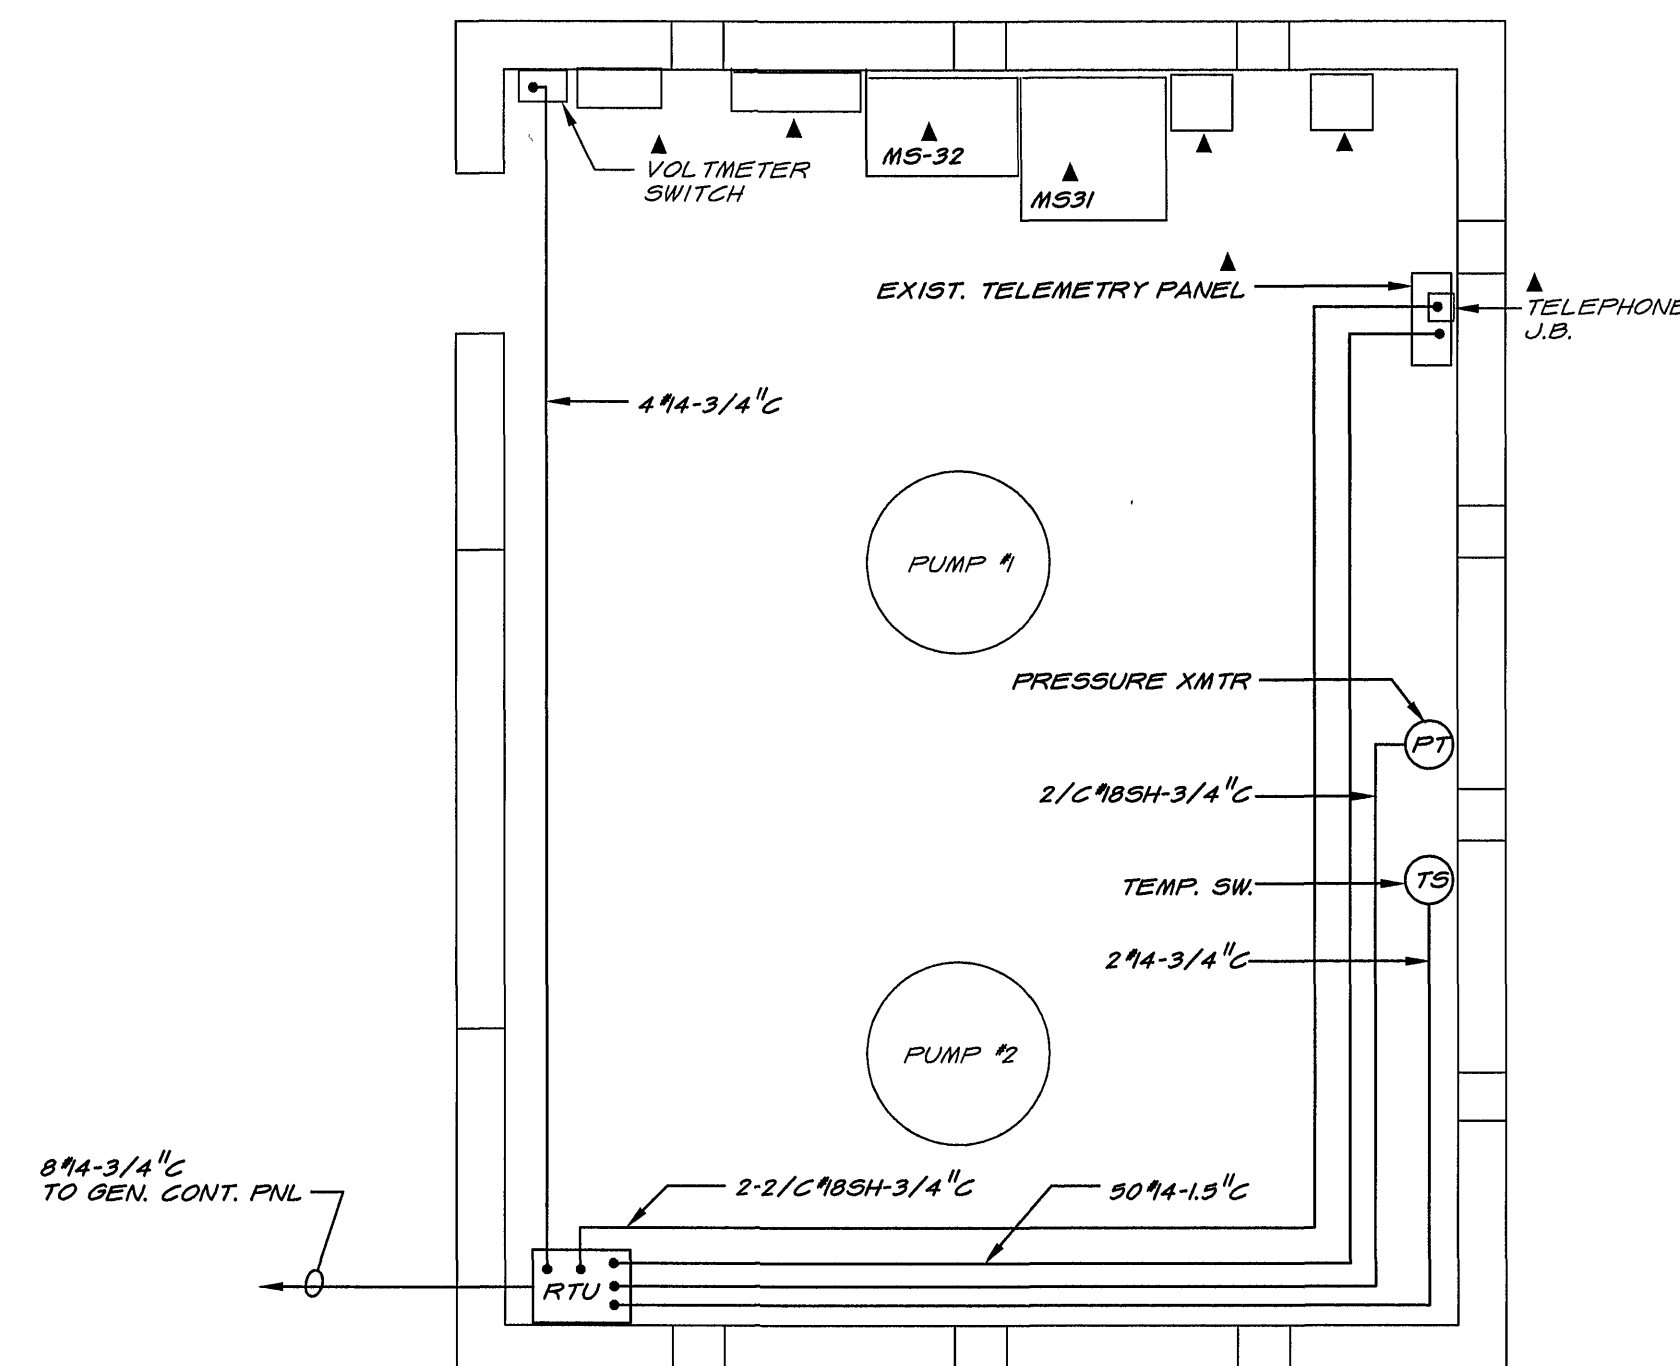


BOXLEY HILLS PUMPING STATION

SCALE OF DRAWING 1/4" = 1'-0"

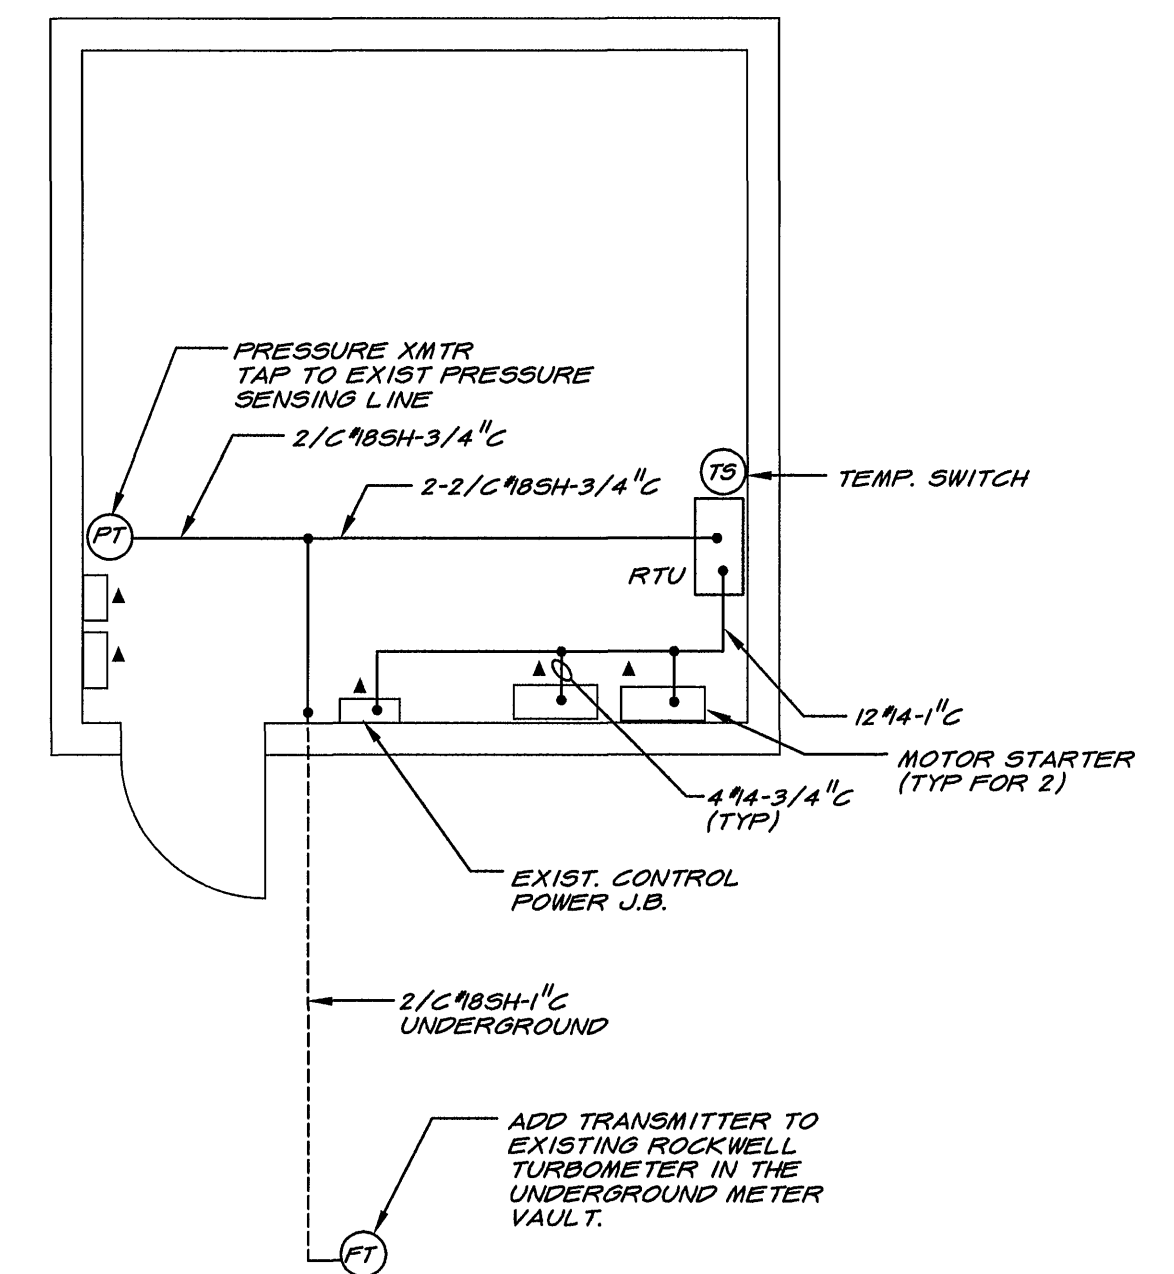


HOLLINS BOOSTER STATION


SCALE OF DRAWING 1/4" = 1'-0"

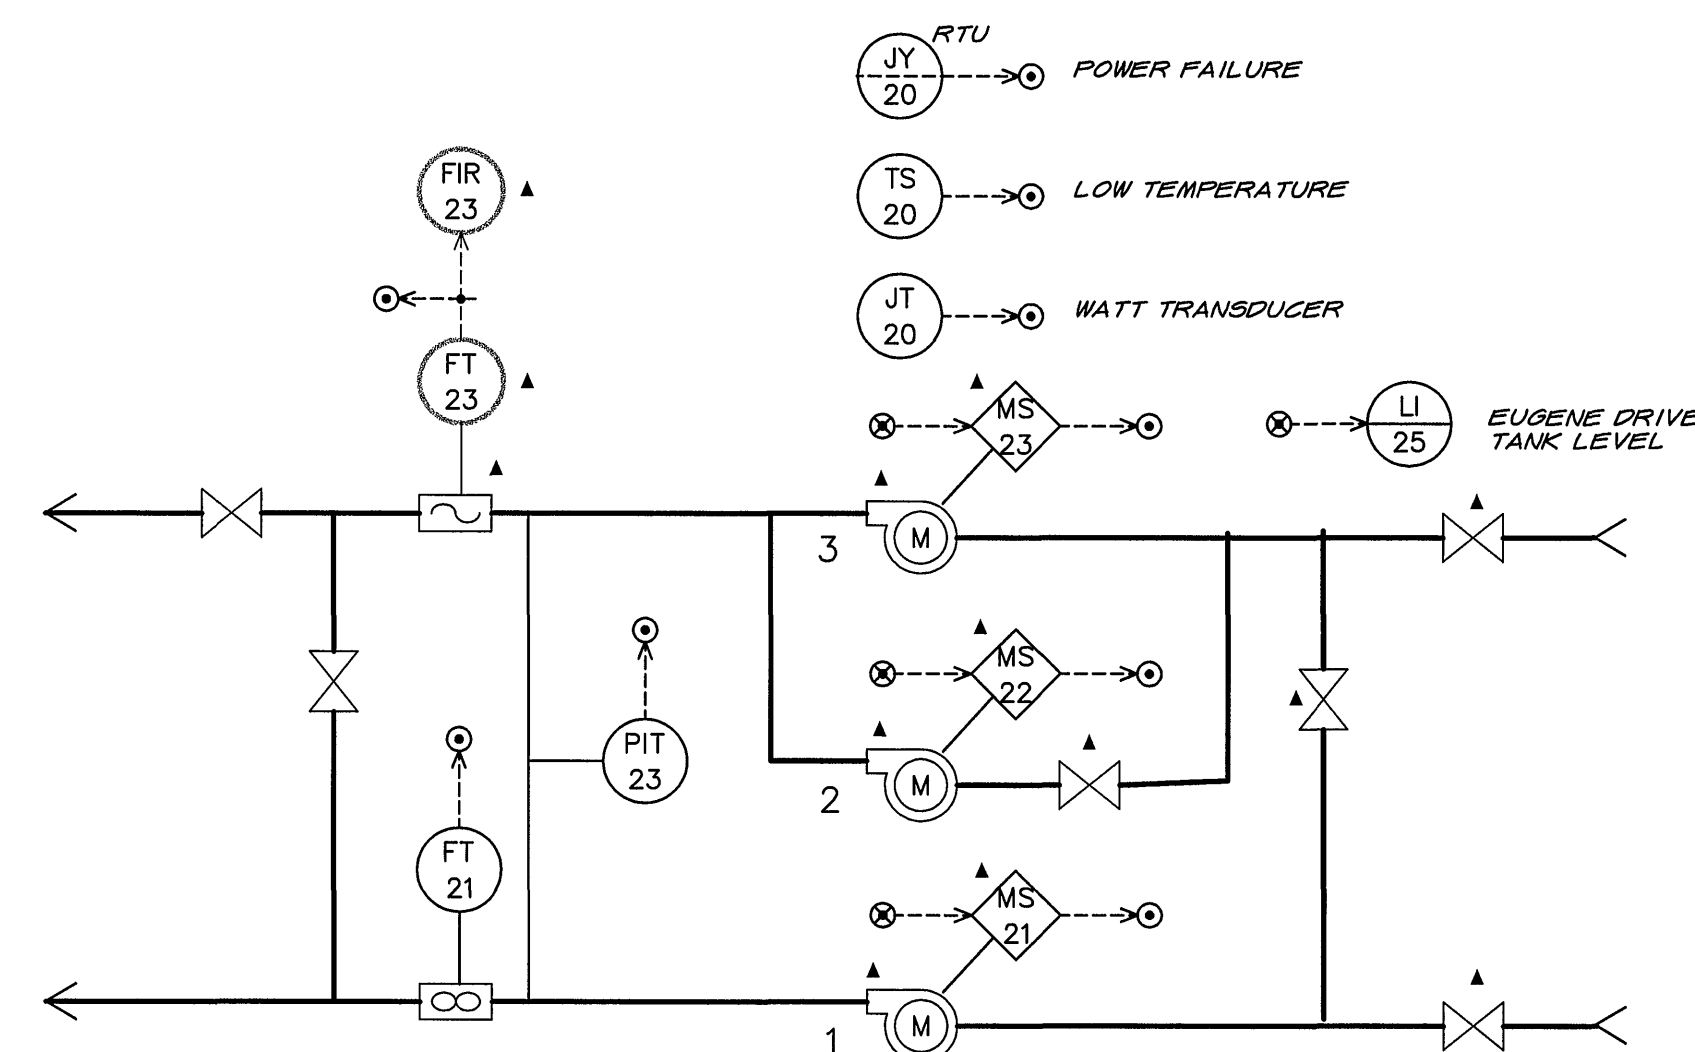

DELRAY BOOSTER STATION

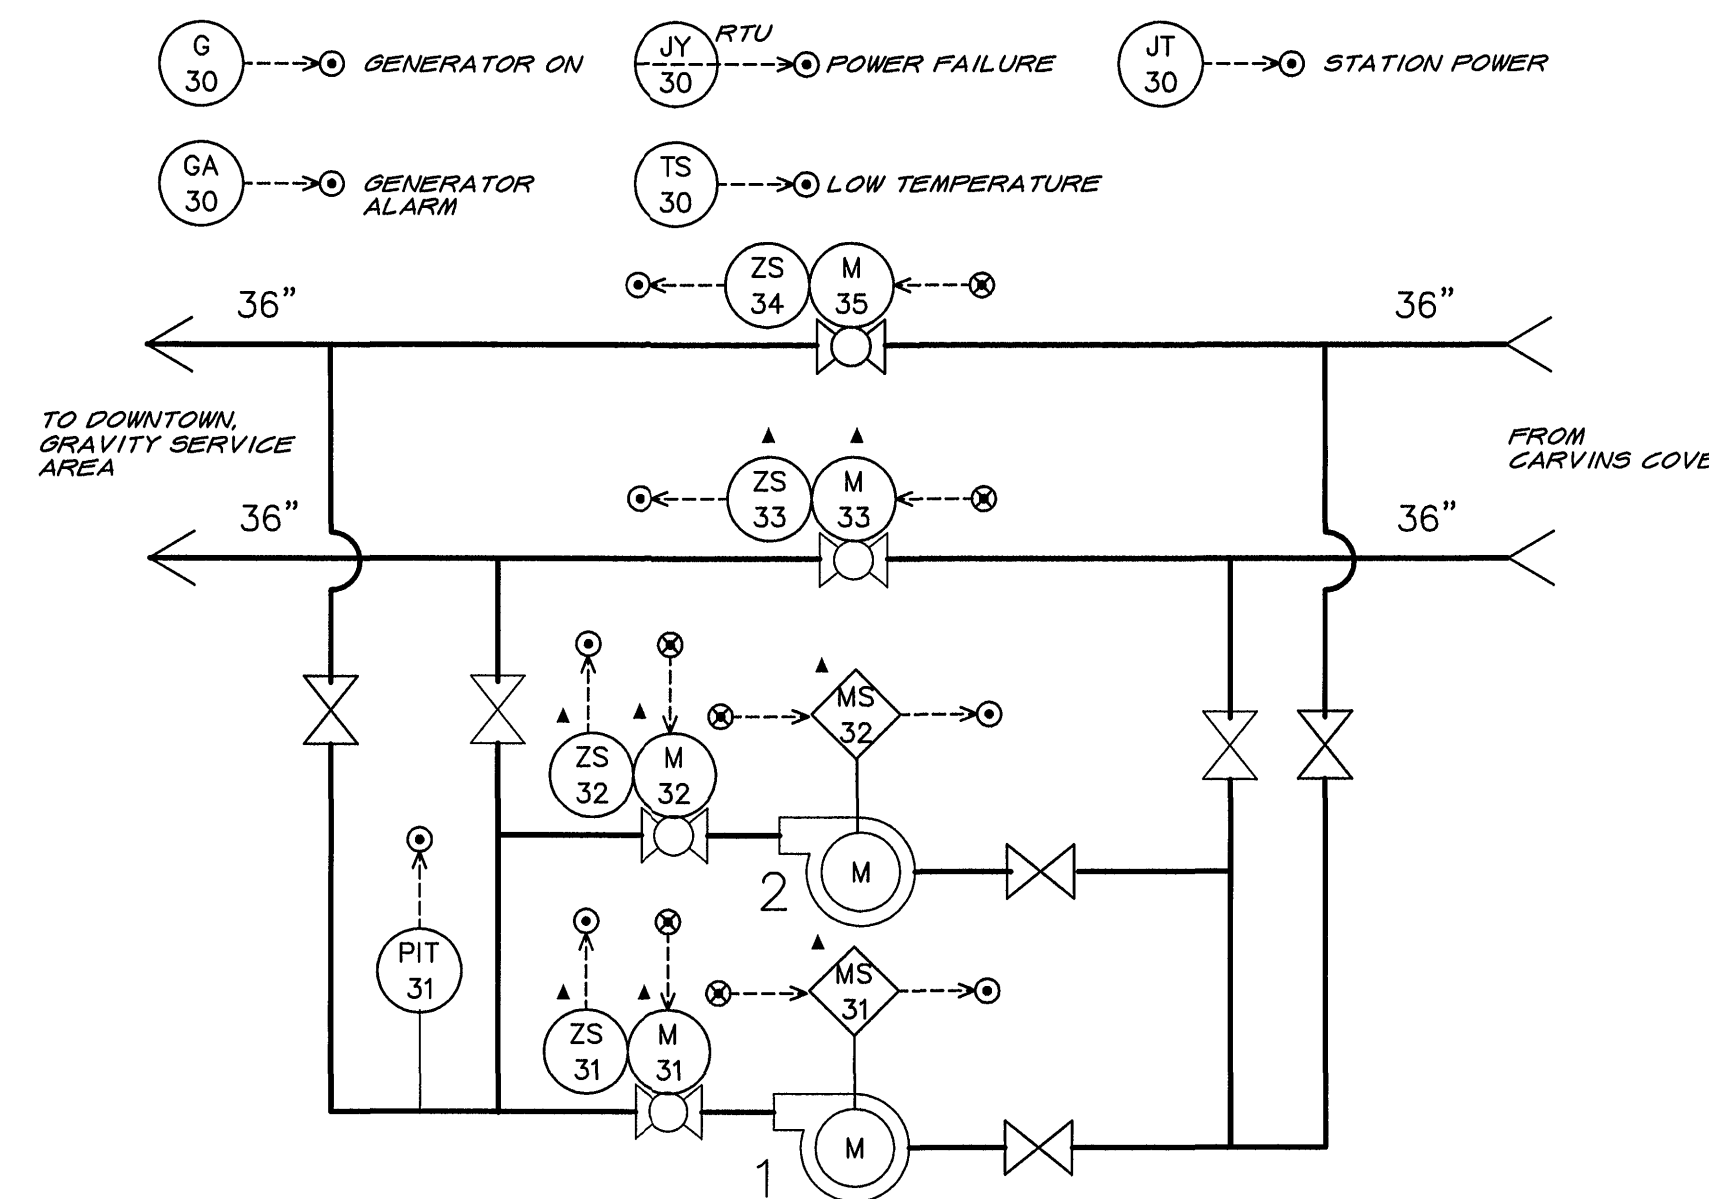

BOXLEY HILLS PUMPING STATION

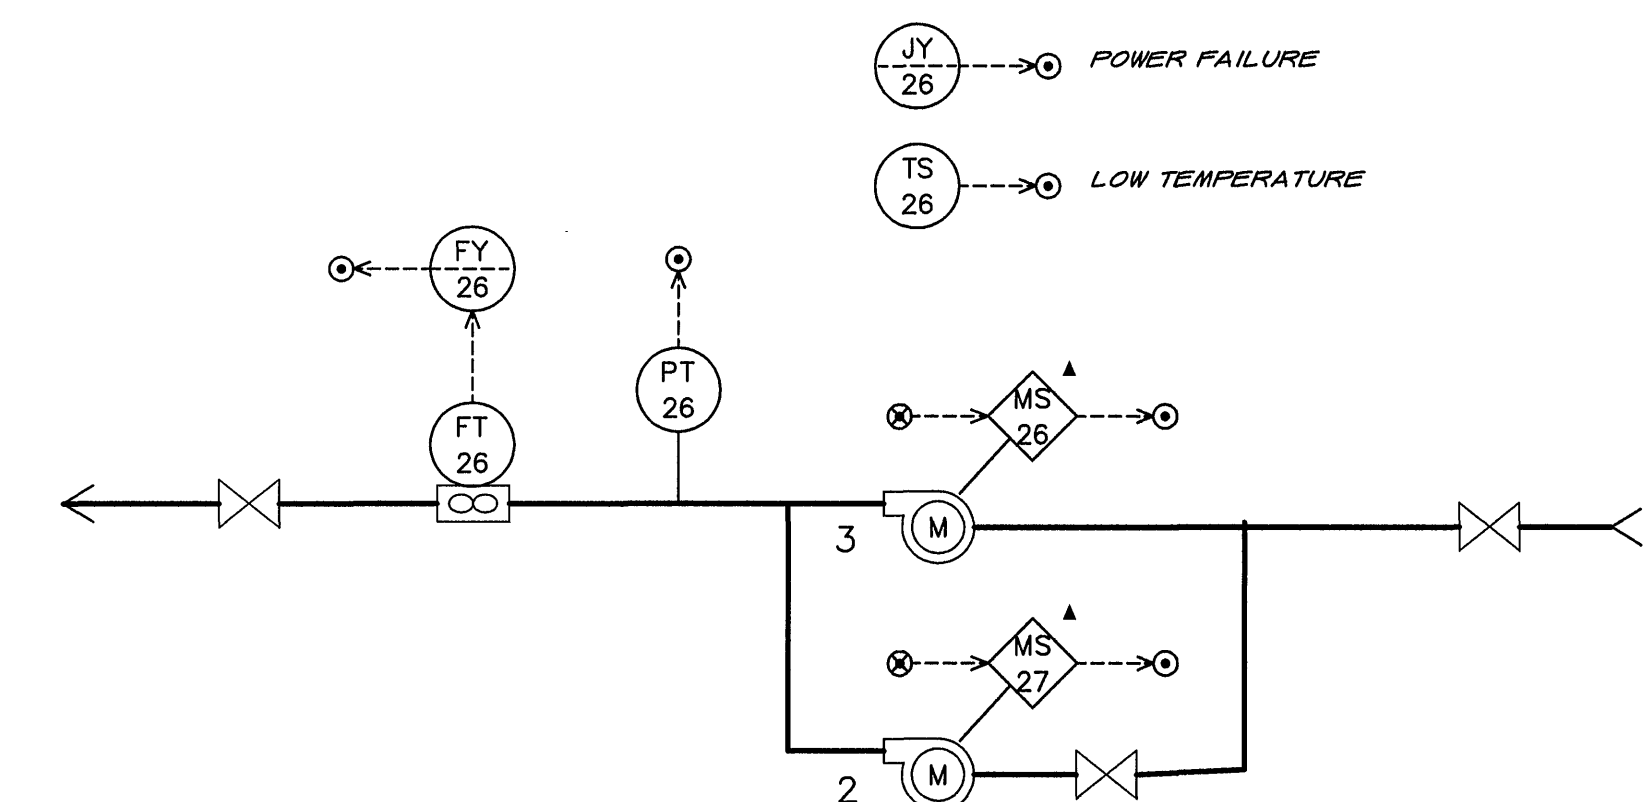

HOLLINS BOOSTER STATION

DRAWING OF RECORD
DATE: SEP 30 1997

MATTERN & CRAIG
CONSULTING ENGINEERS • SURVEYORS
ROANOKE VIRGINIA

DESIGNED: KCC

DRAWN: KCC

CHECKED: KCC



REV.	DATE	DESCRIPTION	BY	APP.

CARVINS COVE FILTER PLANT IMPROVEMENTS – PHASE I
ROANOKE, VIRGINIA

BOXLEY HILLS, DELRAY & HOLLINS PUMPING STATIONS

DATE
APRIL 1992
COMM. NO.
9130
SHEET
SR4