
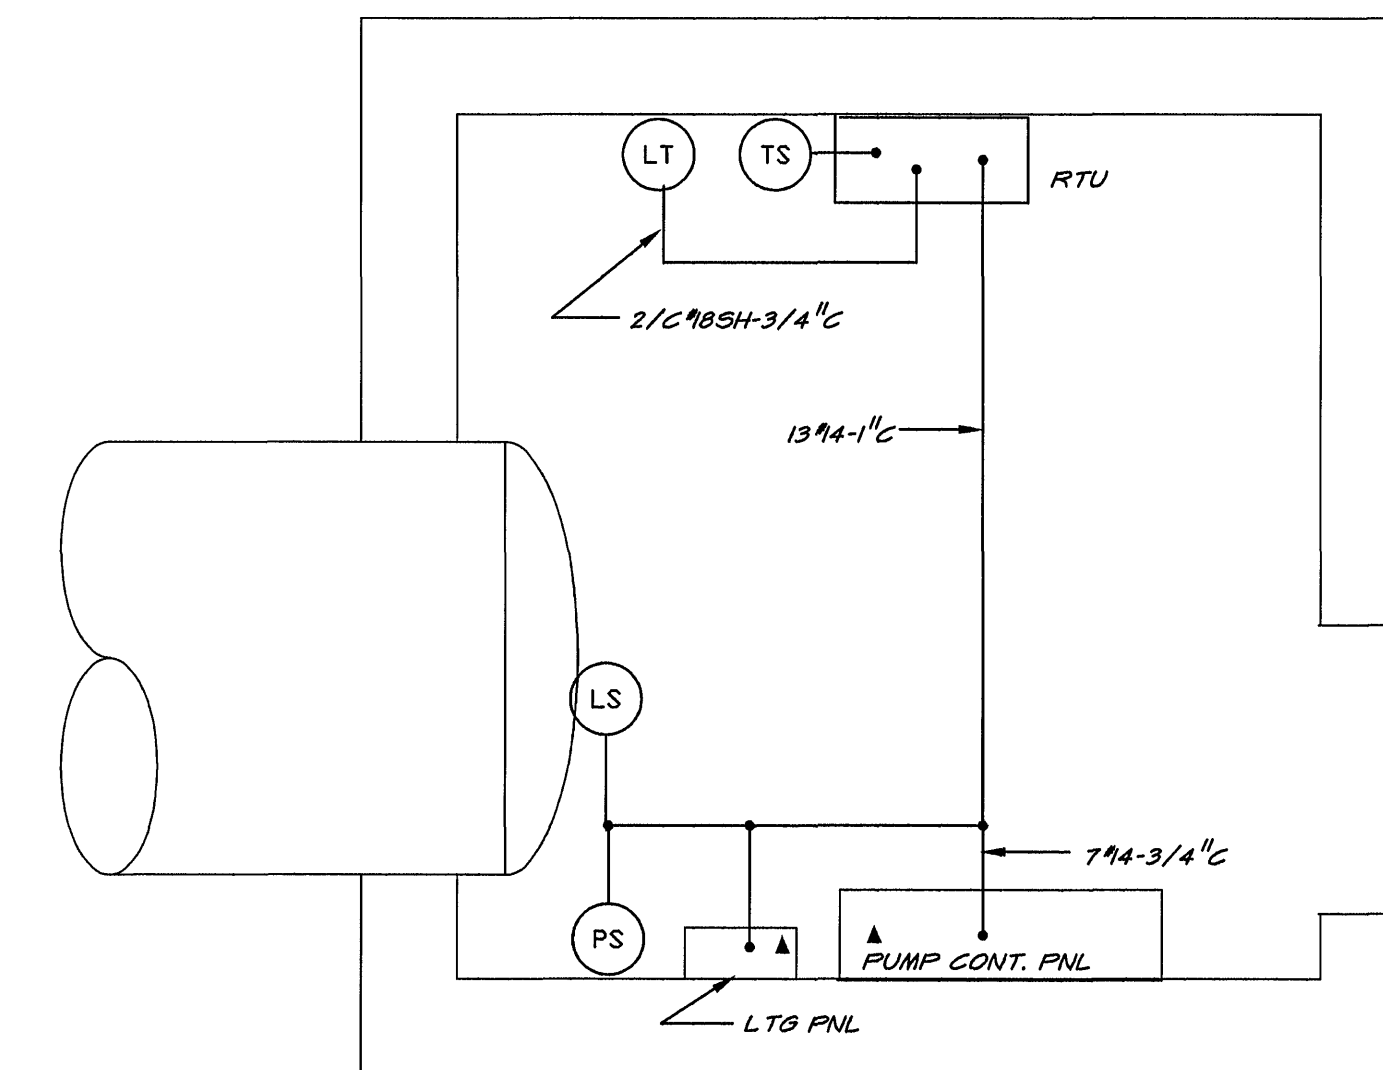
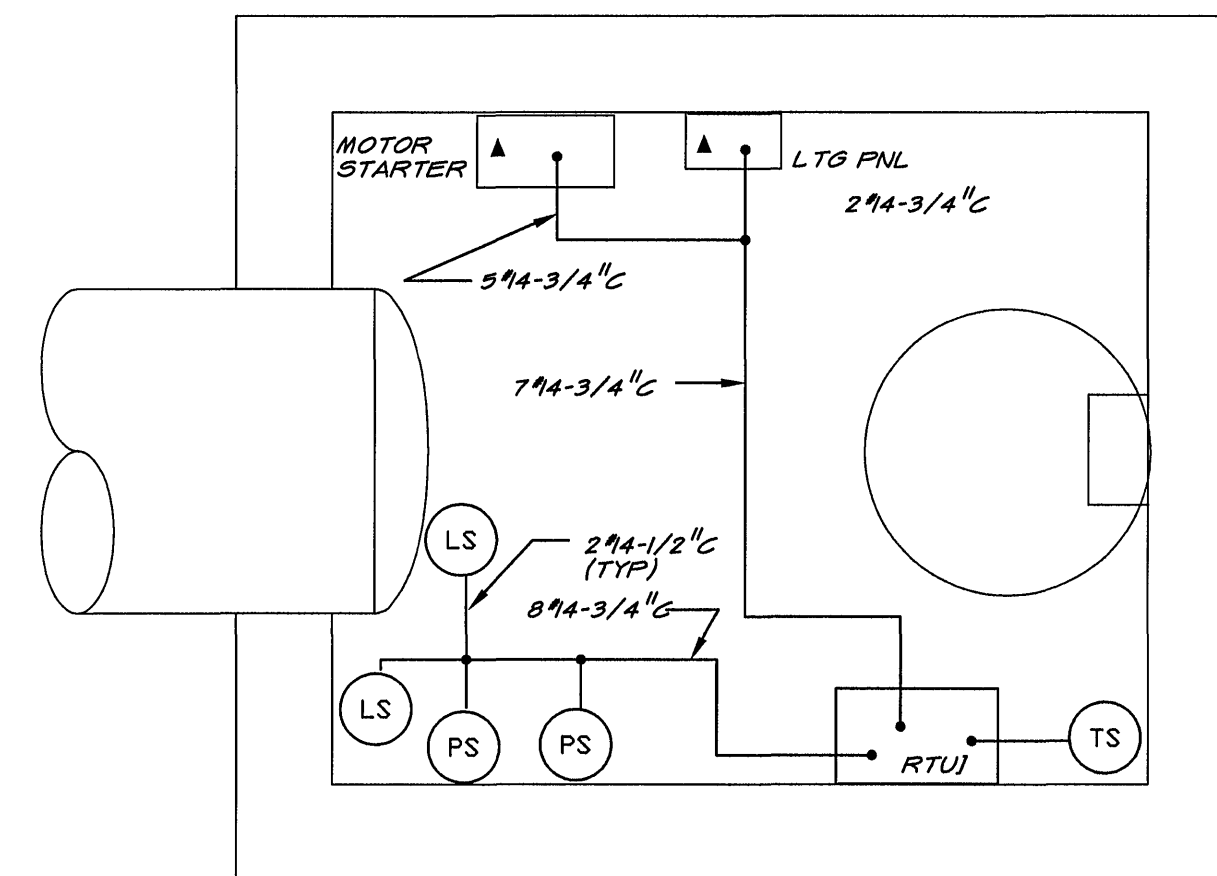


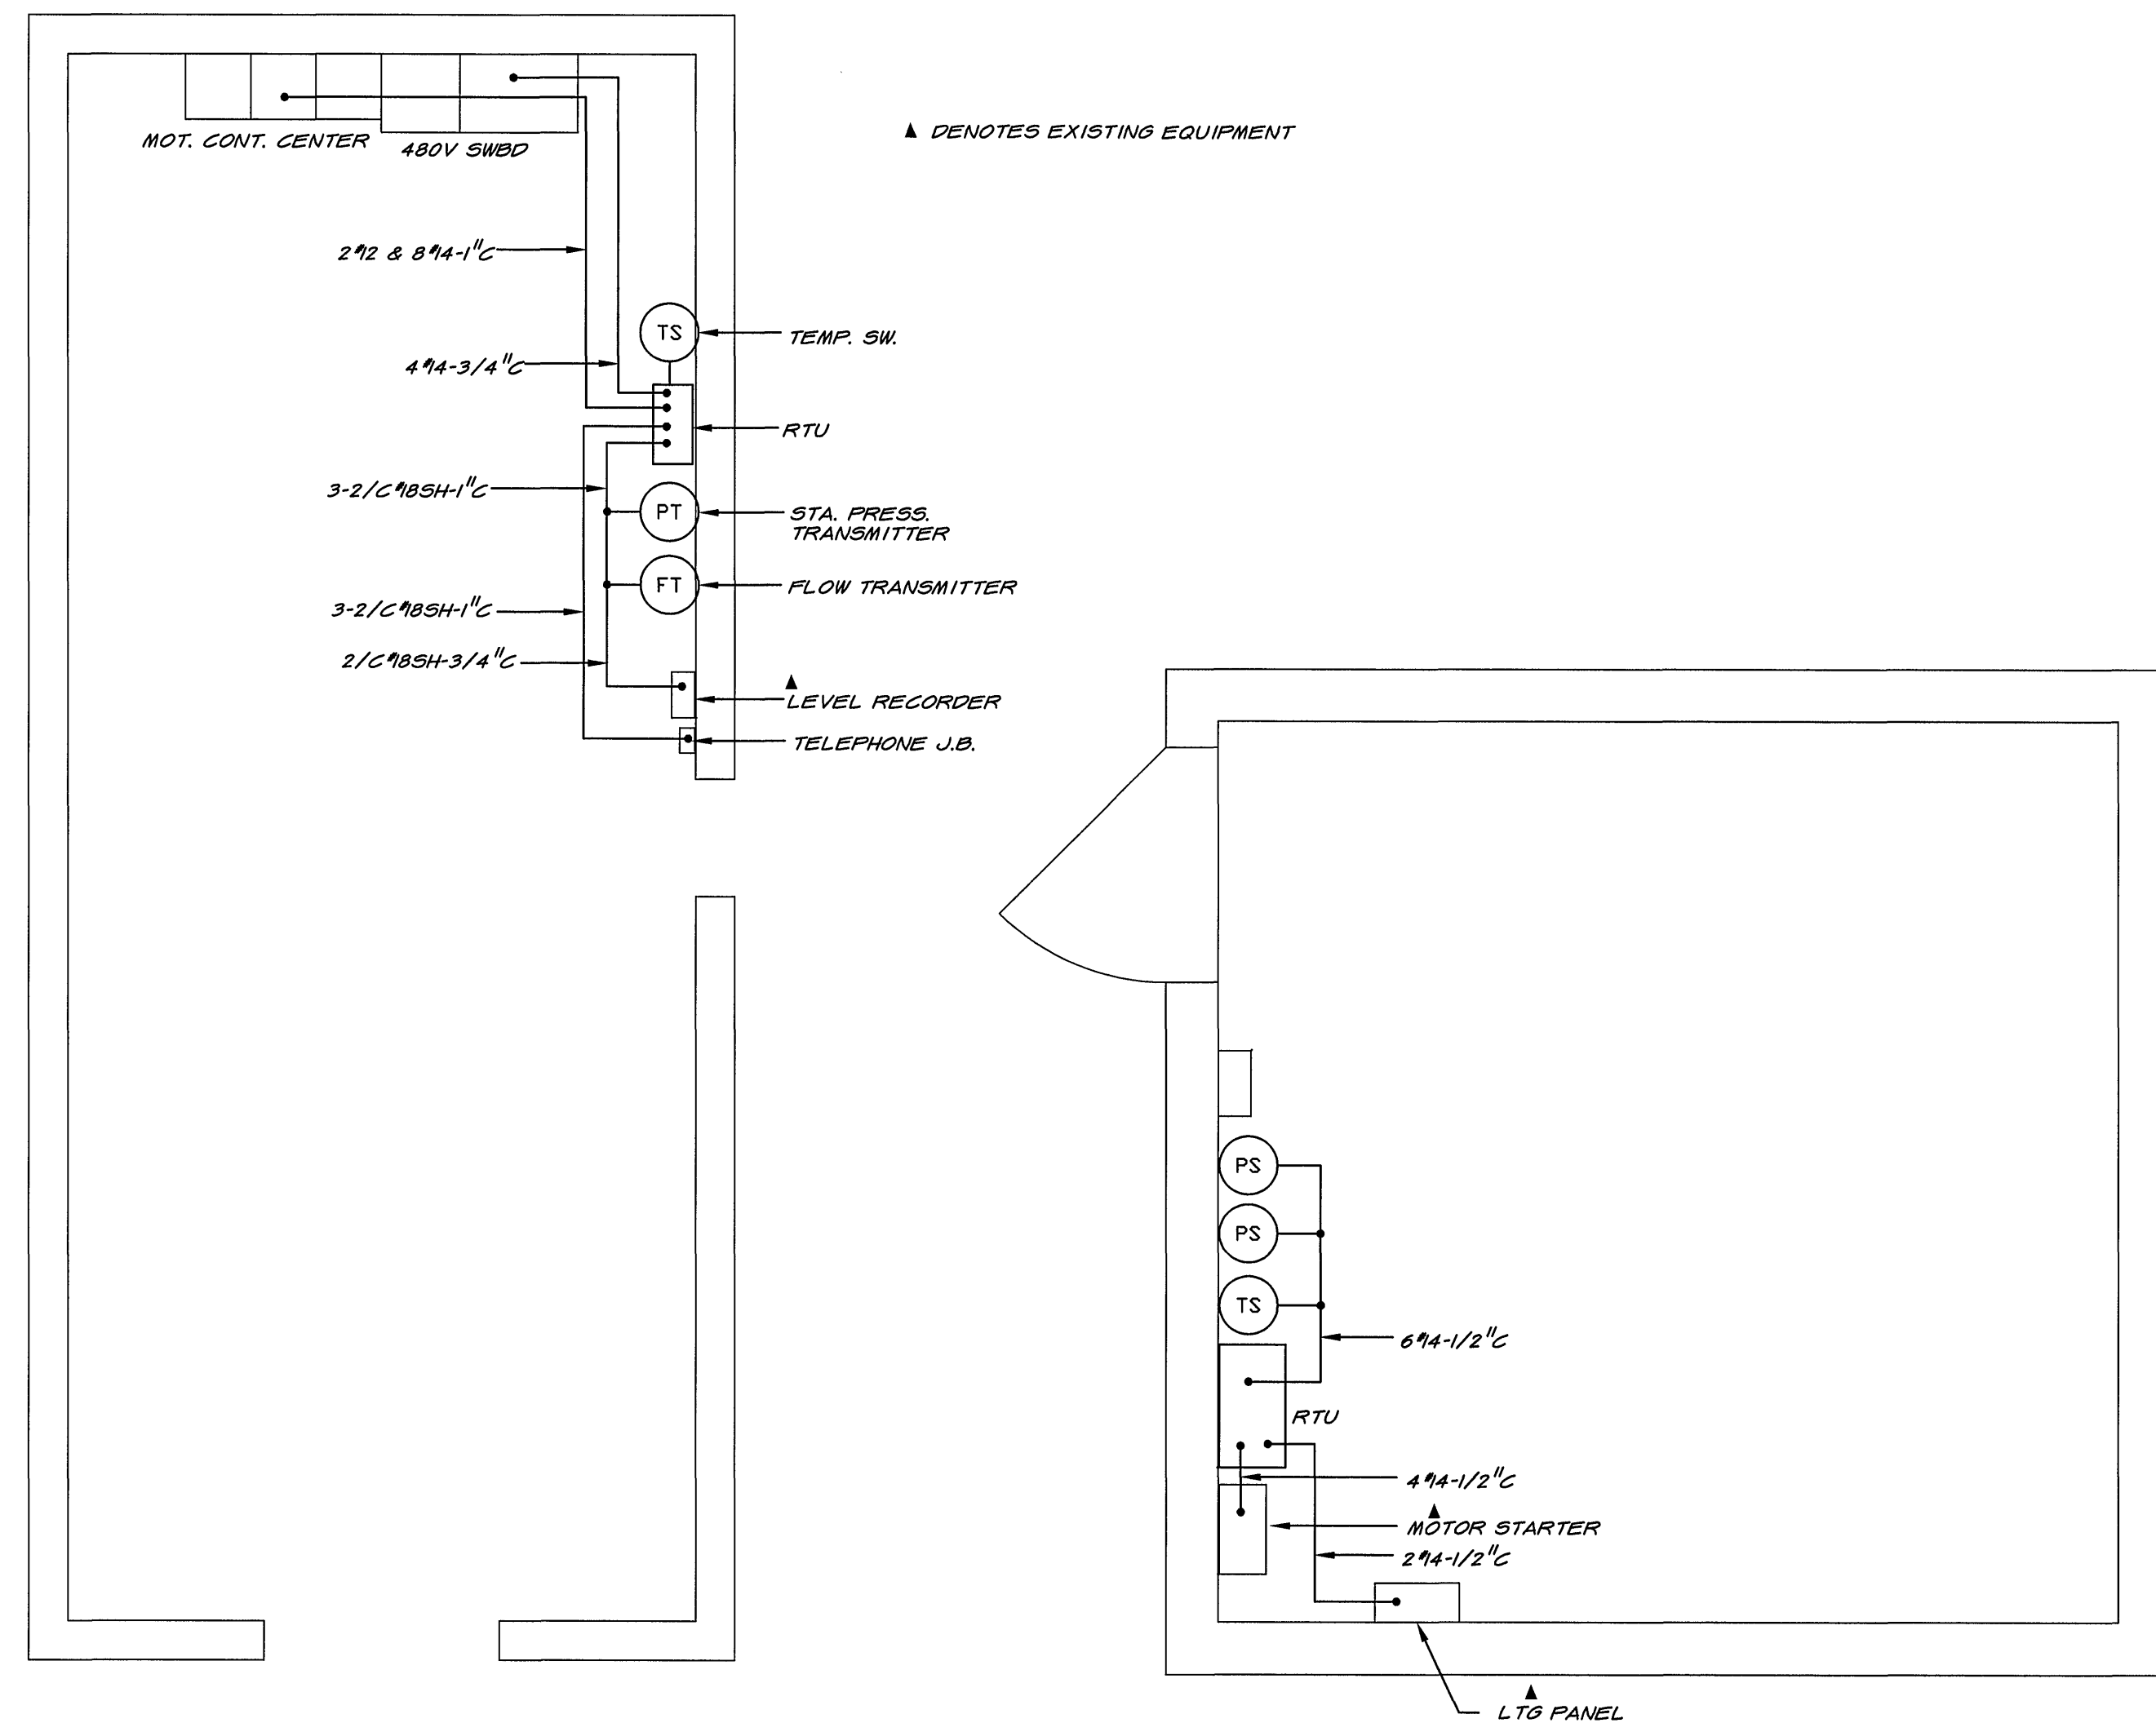

PLAN - FRANKLIN ROAD PUMPING STATION

PLAN - LAKEWOOD BOOSTER STATION

PLAN - CHESTNUT HILLS BOOSTER STATION





PLAN - ROUND HILL PUMPING STATION

SCALE OF DRAWING 1/4" = 1'-0"
4' 3' 2' 1' 0' 4' 8'

SCALE OF DRAWING 1/2" = 1'-0"
2' 1' 0' 2' 4'

SCALE OF DRAWING 3/4" = 1'-0"
1' 0' 3'

SCALE OF DRAWING 1/2" = 1'-0"
2' 1' 0' 2' 4'

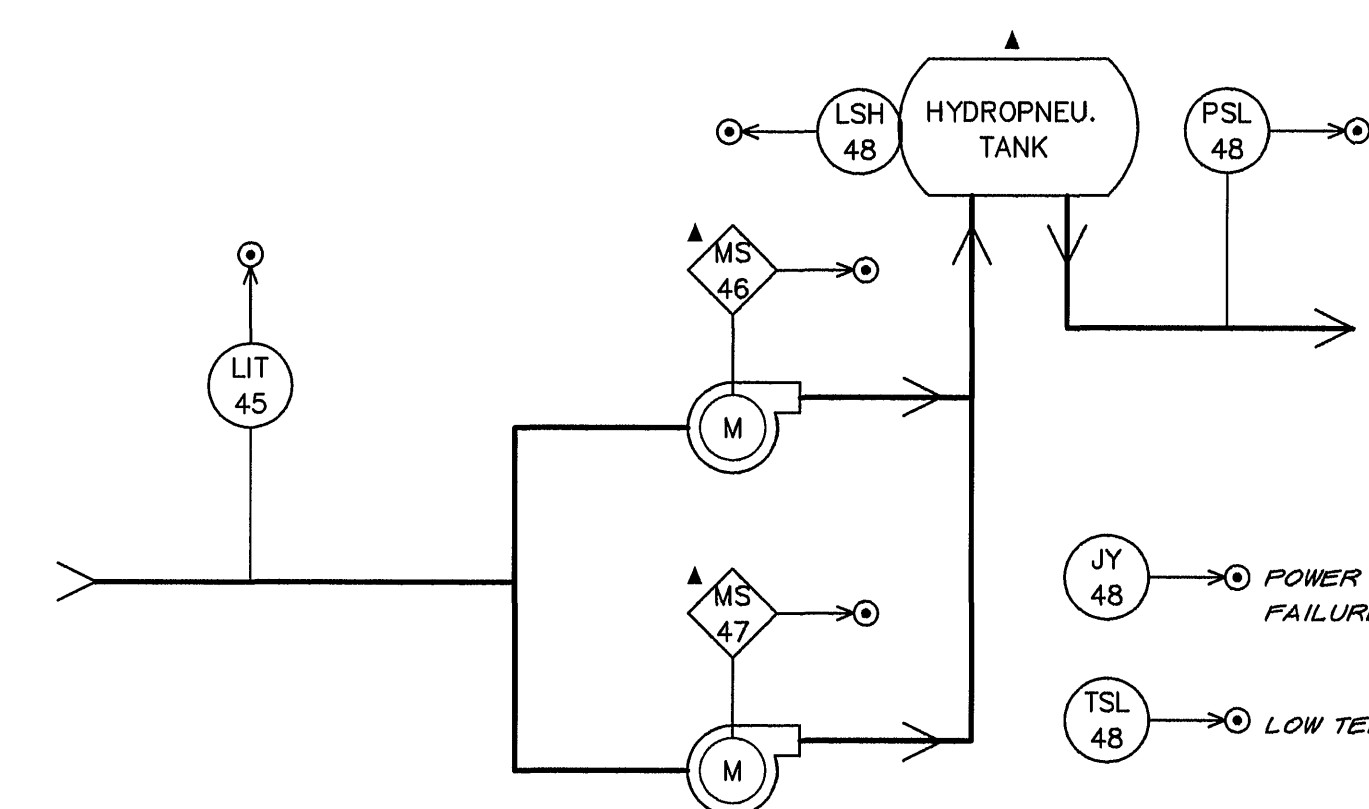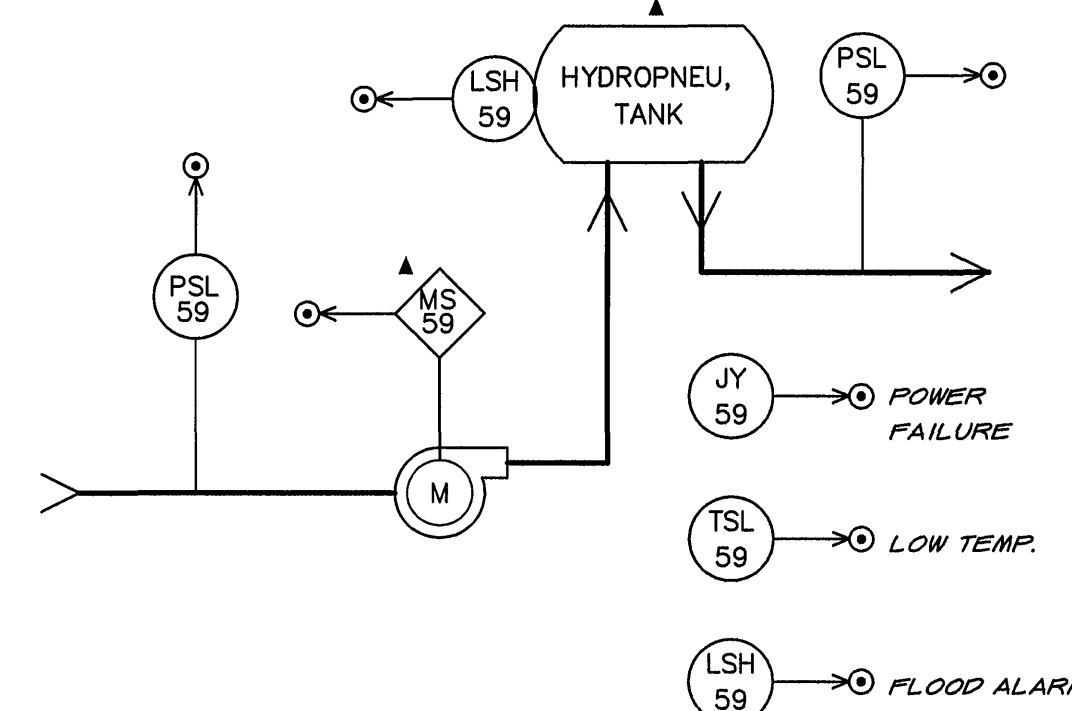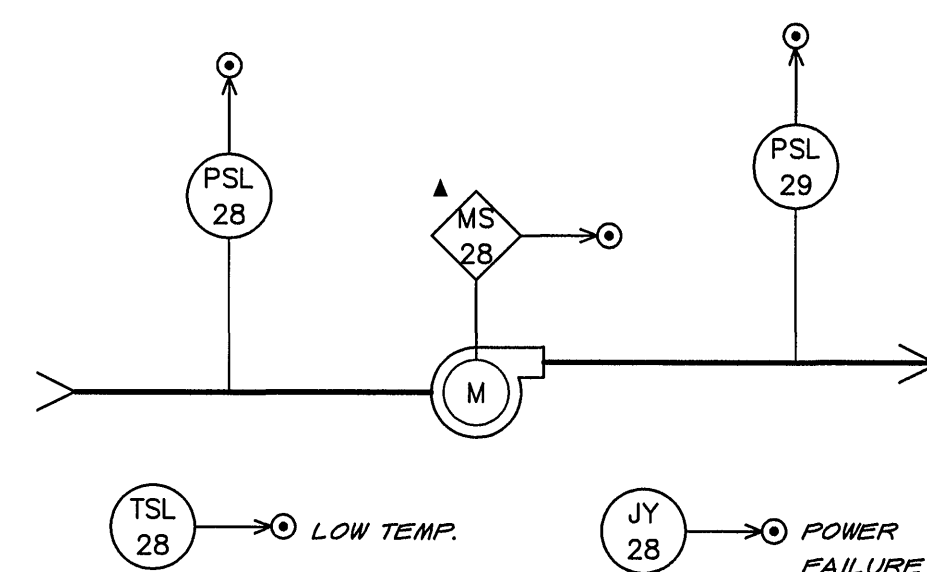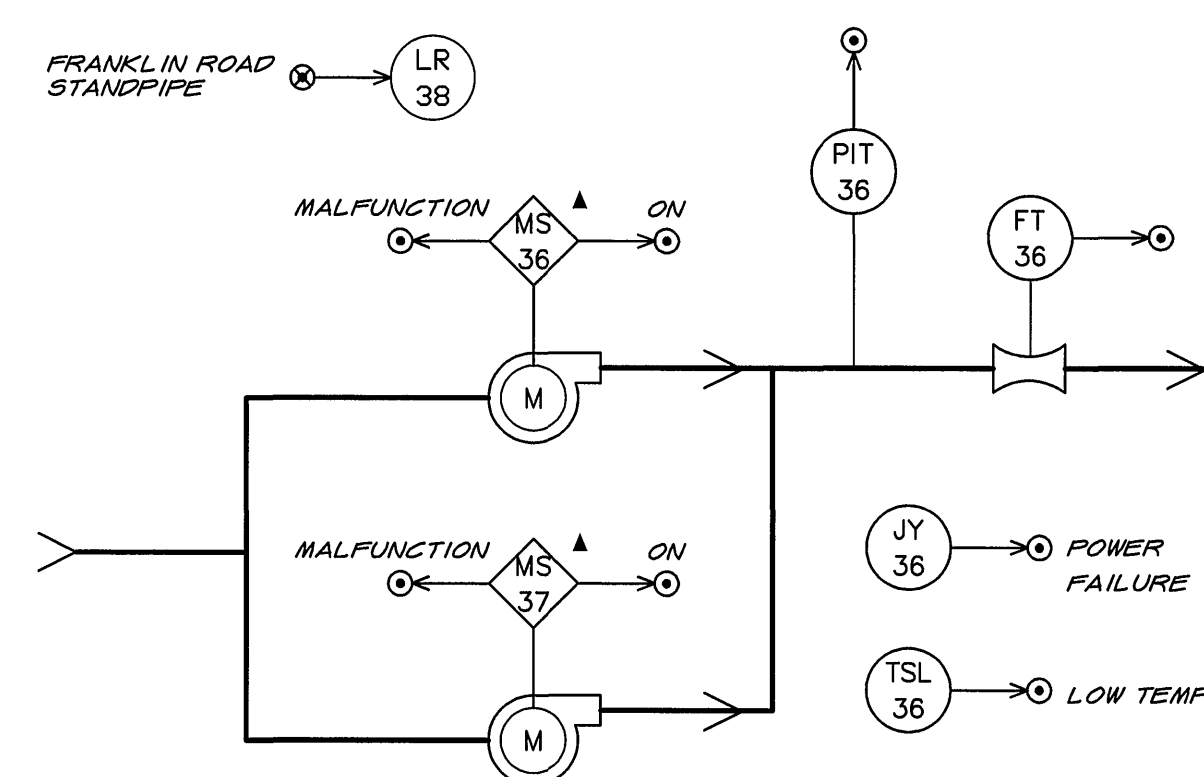


DRAWING OF RECORD
DATE: SEP 30 1997

FRANKLIN ROAD PUMPING STATION

LAKEWOOD BOOSTER STATION

CHESTNUT HILLS BOOSTER STATION

ROUND HILL PUMPING STATION

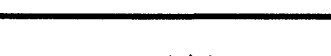MATTERN & CRAIG CONSULTING ENGINEERS • SURVEYORS ROANOKE VIRGINIA	DESIGNED: KCC			REV.	DATE	DESCRIPTION	BY	APP.	CARVINS COVE FILTER PLANT IMPROVEMENTS – PHASE I ROANOKE, VIRGINIA	DATE APRIL 1992
	DRAWN: KCC									
ALVORD, BURDICK & HOWSON ENGINEERS CHICAGO	CHECKED: KCC								CHESTNUT HILLS, FRANKLIN ROAD, LAKEWOOD & ROUND HILL PUMPING STATIONS	SHEET SR6