


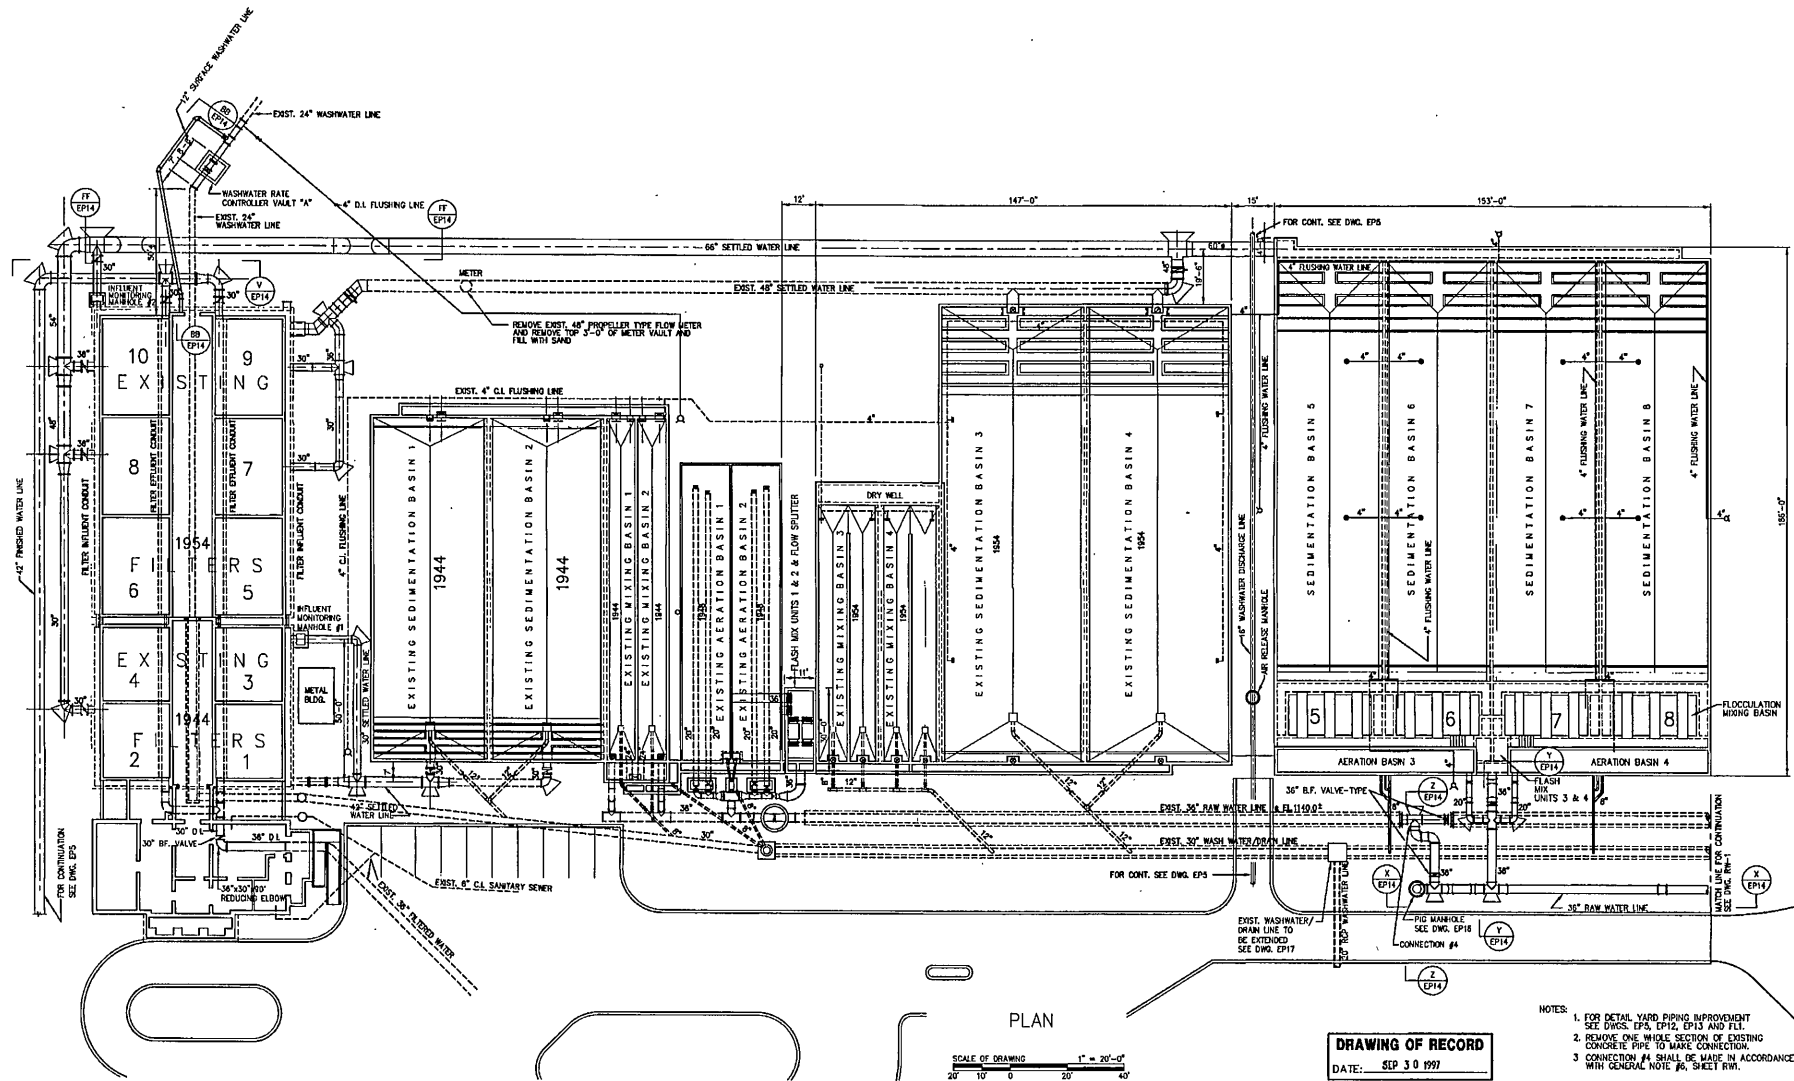

DRAWING OF RECORD
DATE: SEP 30 1997

- NOTES:
1. FOR DETAIL YARD PIPING IMPROVEMENT SEE DWGS. EP18, EP19, EP20 AND F.I.I.
 2. REMOVE ONE WHOLE SECTION OF EXISTING CONCRETE PIPE TO MAKE CONNECTION.
 3. CONNECTION #4 SHALL BE MADE IN ACCORDANCE WITH GENERAL NOTE #6, SHEET R.W.

CARVINS COVE FILTER PLANT IMPROVEMENTS - PHASE I
ROANOKE, VIRGINIA

NEW PLANT LAYOUT

DATE
APRIL 1992
COMM. NO.
9130
SHEET
EP3

PLAN NO. 6199


MATTER & CRAIG
CONSULTING ENGINEERS • SURVEYORS
ROANOKE VIRGINIA

ALVORD, BURDICK & HOWSON
ENGINEERS CHICAGO

DESIGNED:

DRAWN: H.F.
R.T.

CHECKED: Y.T.L.

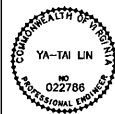

REV.	DATE	DESCRIPTION	BY	APP.