
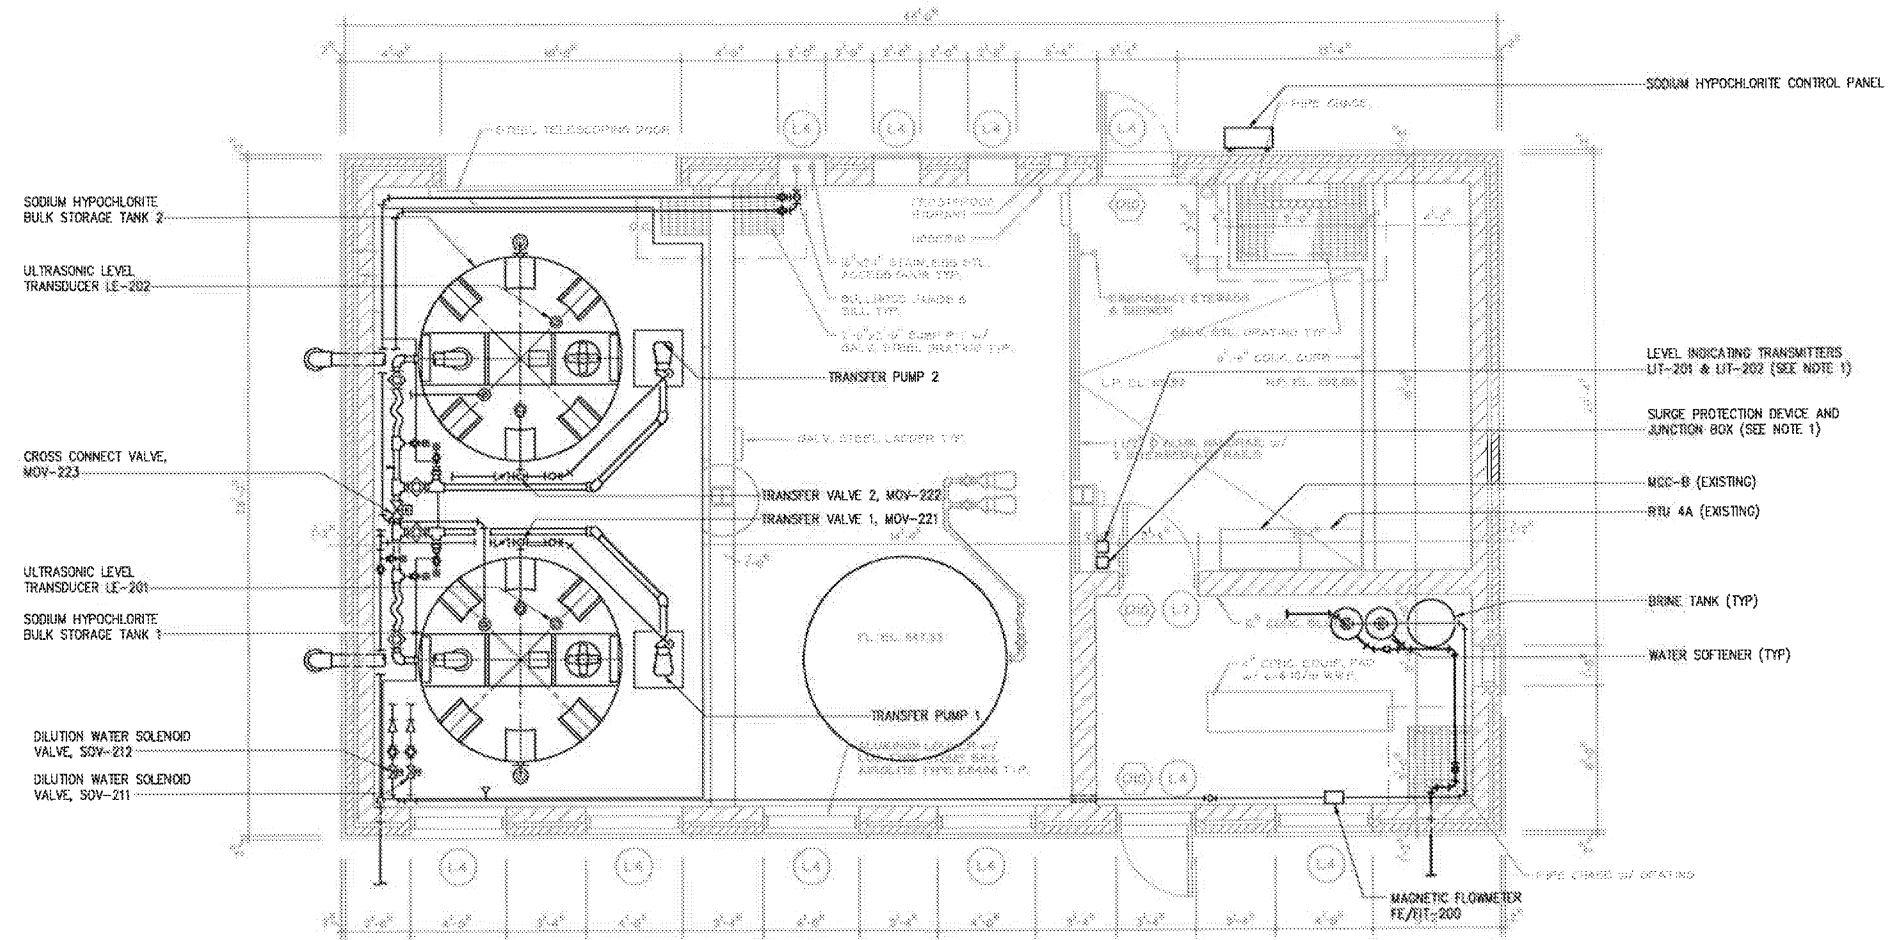


1. MOUNT TWO NEW LEVEL INDICATING TRANSMITTERS, ONE NEW SURGE PROTECTION DEVICE AND NEW JUNCTION BOX ABOVE THE EXISTING MILLTRONICS AIRRANGER XPL LEVEL MEASUREMENT SYSTEM.
2. ALL CONDUIT SHALL BE SCHEDULE 80 PVC. CONDUIT SHALL BE LISTED TO UL-651.


$$1/4'' = 1' - 0''$$

File = D:\31197--rel\31197-000\drawings\DEE\229C Saved by kmurphy Save date = 4/6/2015 3:00 PM

2	RECORD DRAWINGS	04/2015	ALS	DESIGNED	JAD
3	FINAL DESIGN	09/2014	ALS	DRAWN	JAD
				CHECKED	
				PROJ ENGR	ALS
NO.	ISSUED FOR	DATE	BY	APPROVED	

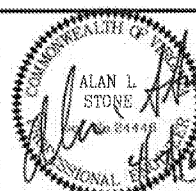

RECORD DRAWING
THIS DRAWING HAS BEEN
MODIFIED TO REFLECT FI
CHANGES REPORTED BY
THE CONTRACTOR OR
ANOTHER PARTY, BUT N
VERIFIED BY THE
CERTIFYING ENGINEER

THIS DOCUMENT
ORIGINALLY ISSUED
FOR CONSTRUCTION
AND SEALED BY
JASON A. DAVIS,
LIC NUMBER 052009

HAZEN AND SAWYER
Environmental Engineers & Scientists
4011 WestChase Boulevard, Suite 500
Raleigh, North Carolina 27607
License No. : C-0381

WESTERN VIRGINIA WATER AUTHORITY
ROANOKE, VIRGINIA

CARVINS COVE WATER TREATMENT FACILITY DISINFECTION IMPROVEMENTS

ELECTRICAL
CHEMICAL BUILDING 2 PLAN

THE SCALE BAR SHOWN BELOW MEASURES ONE INCH LONG ON THE ORIGINAL DRAWING. 	DATE OCTOBER 2014	
	H&S JOB NUMBER 31197-000	
	CONTRACT NUMBER 1	DRAWING NUMBER E200

RECORD DRAWINGS