




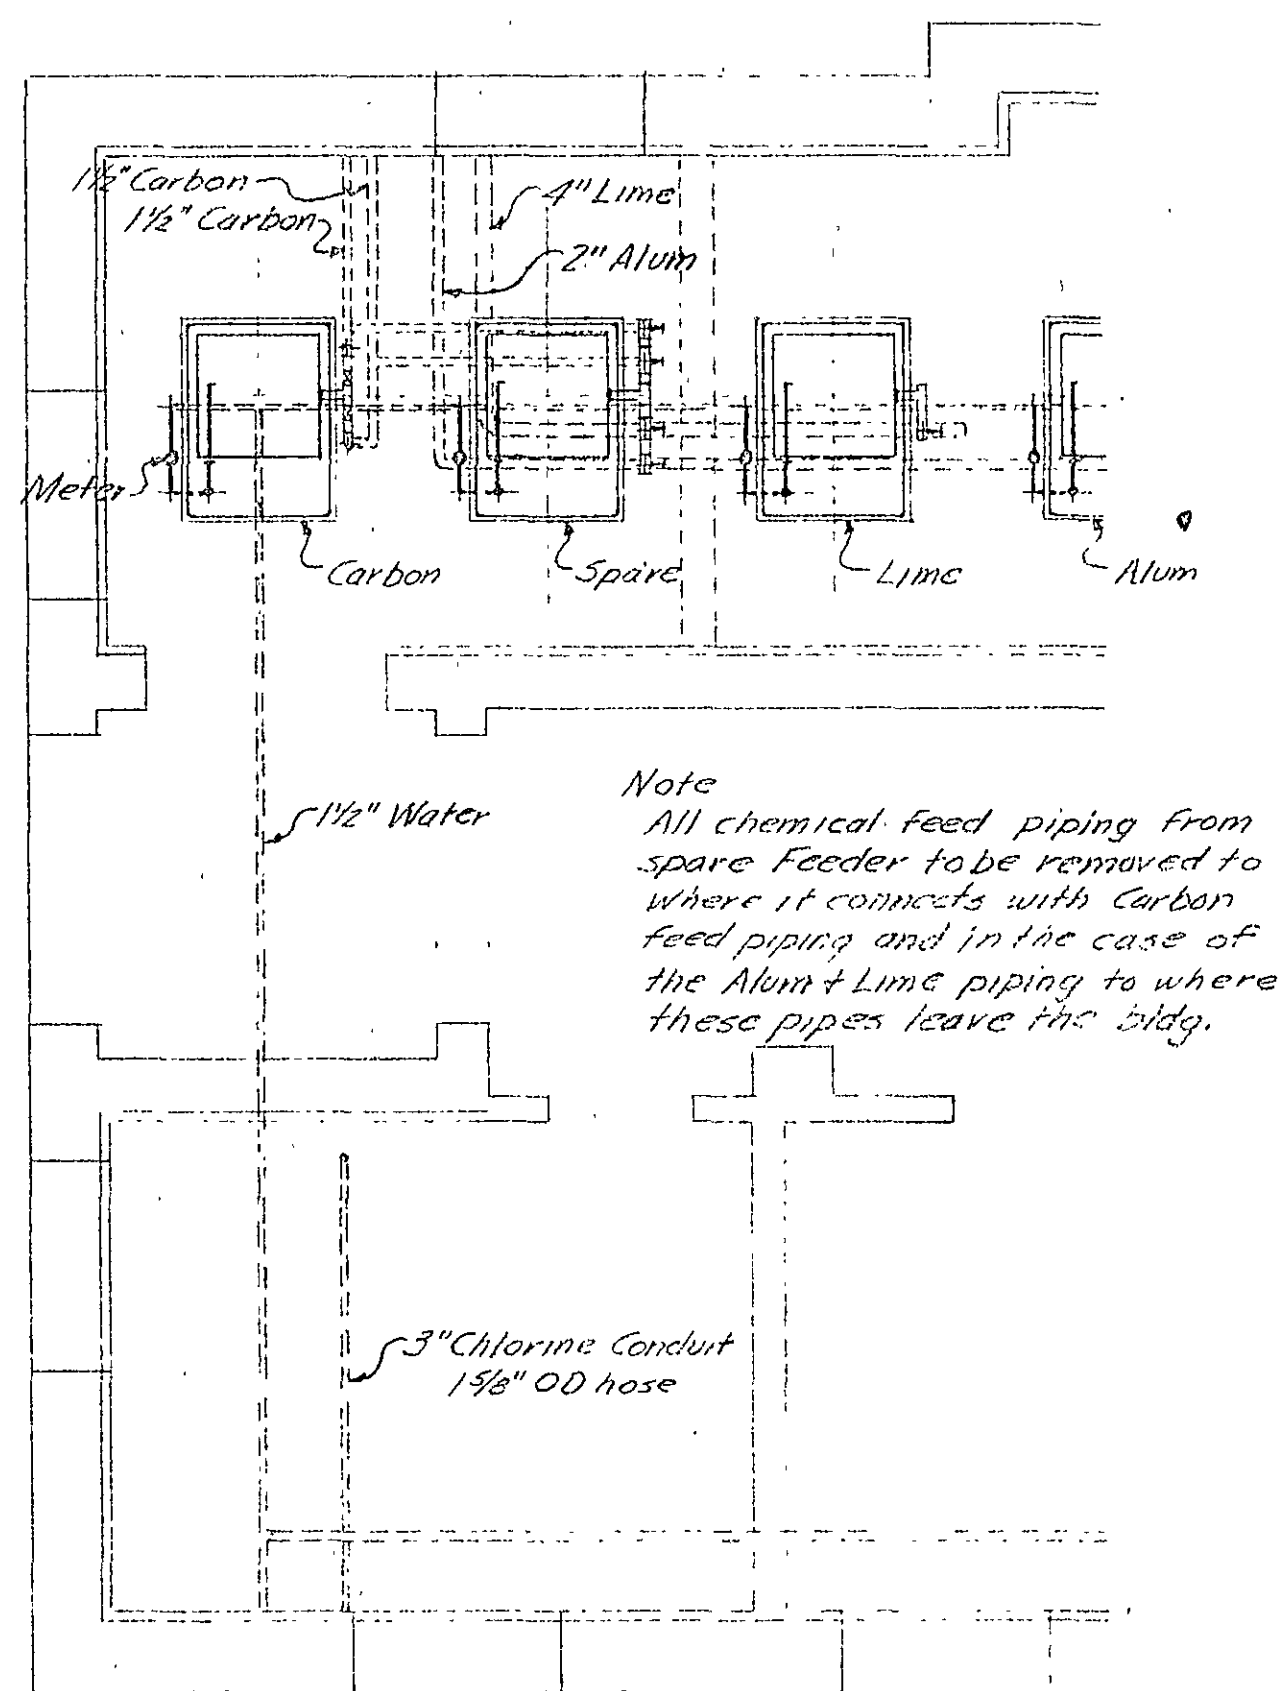

PLAN - NORTHEAST WING OF
FILTER BLDG SHOWING
CHEMICAL PIPING AS IS
Scale 1/4"=1'-0"

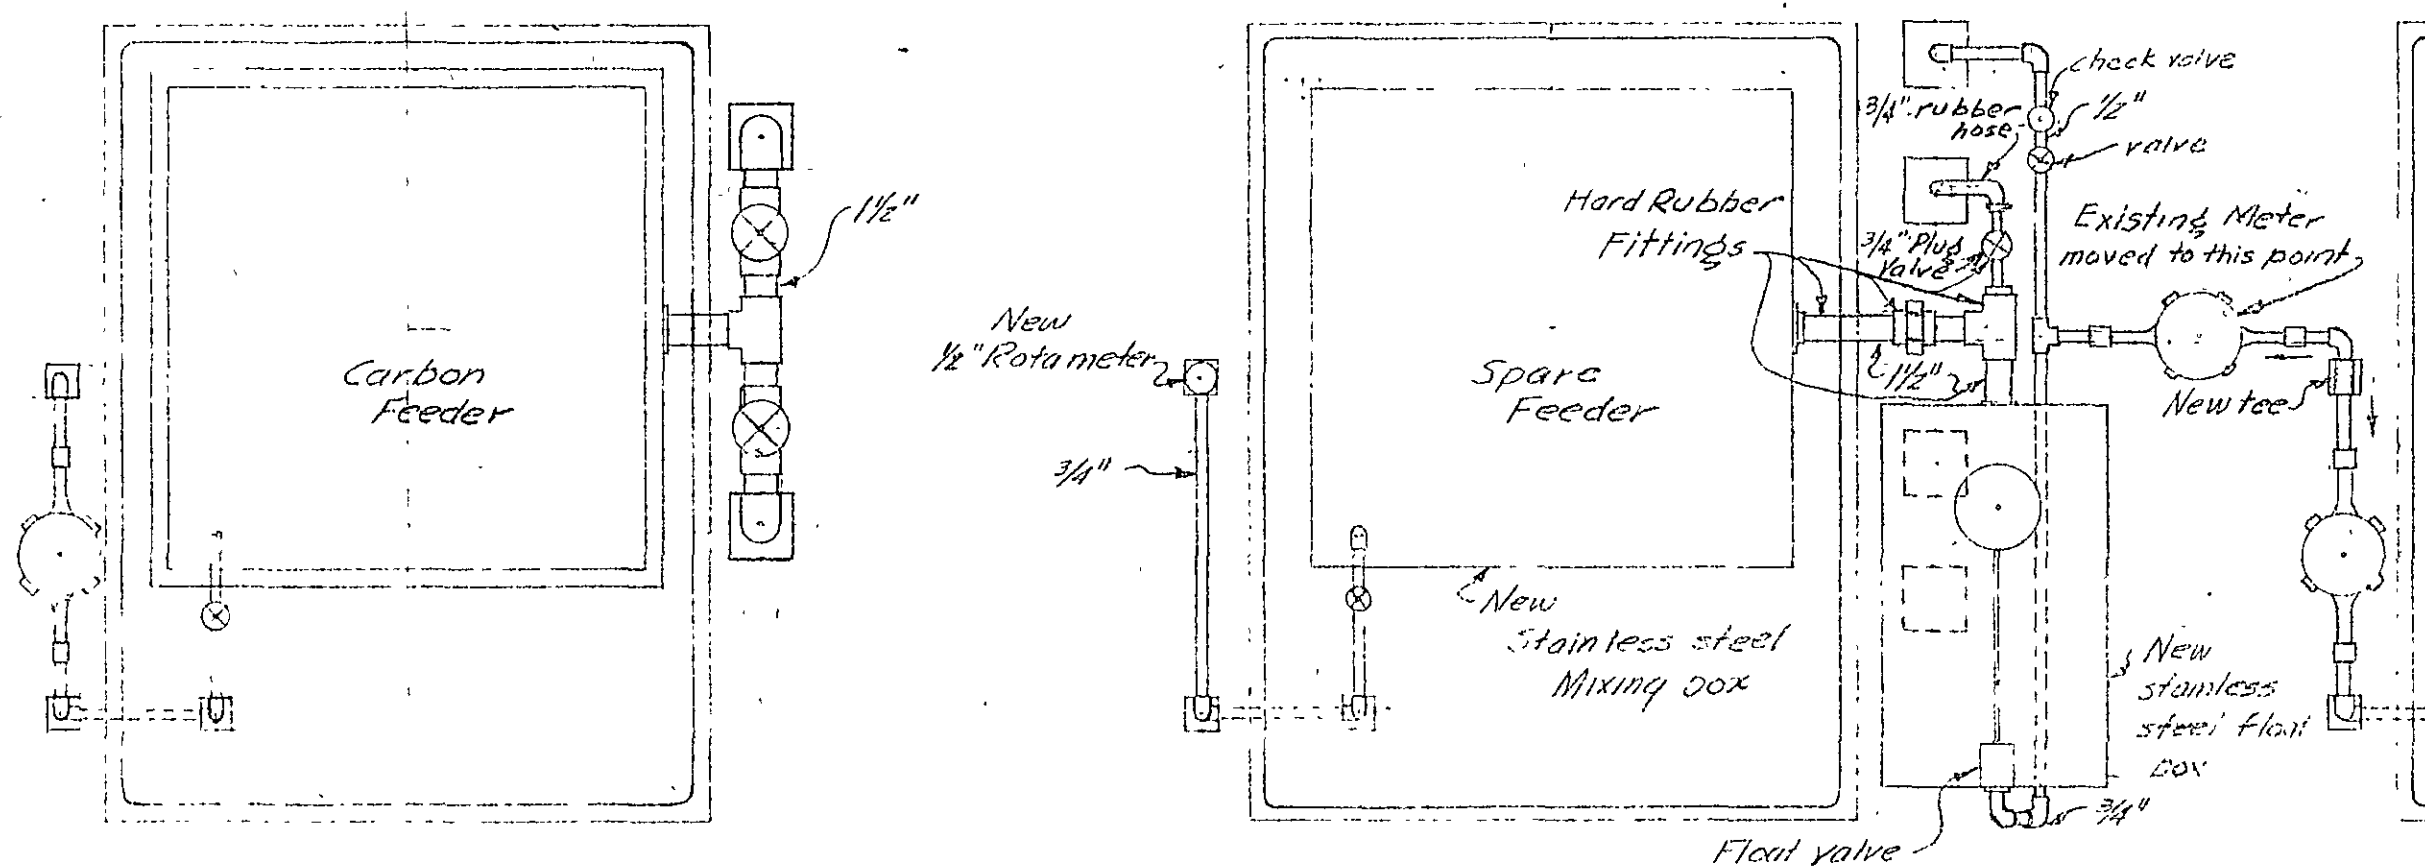

SECTIONAL PLAN ABOVE FLOOR SLAB
SHOWING PIPING REVISIONS

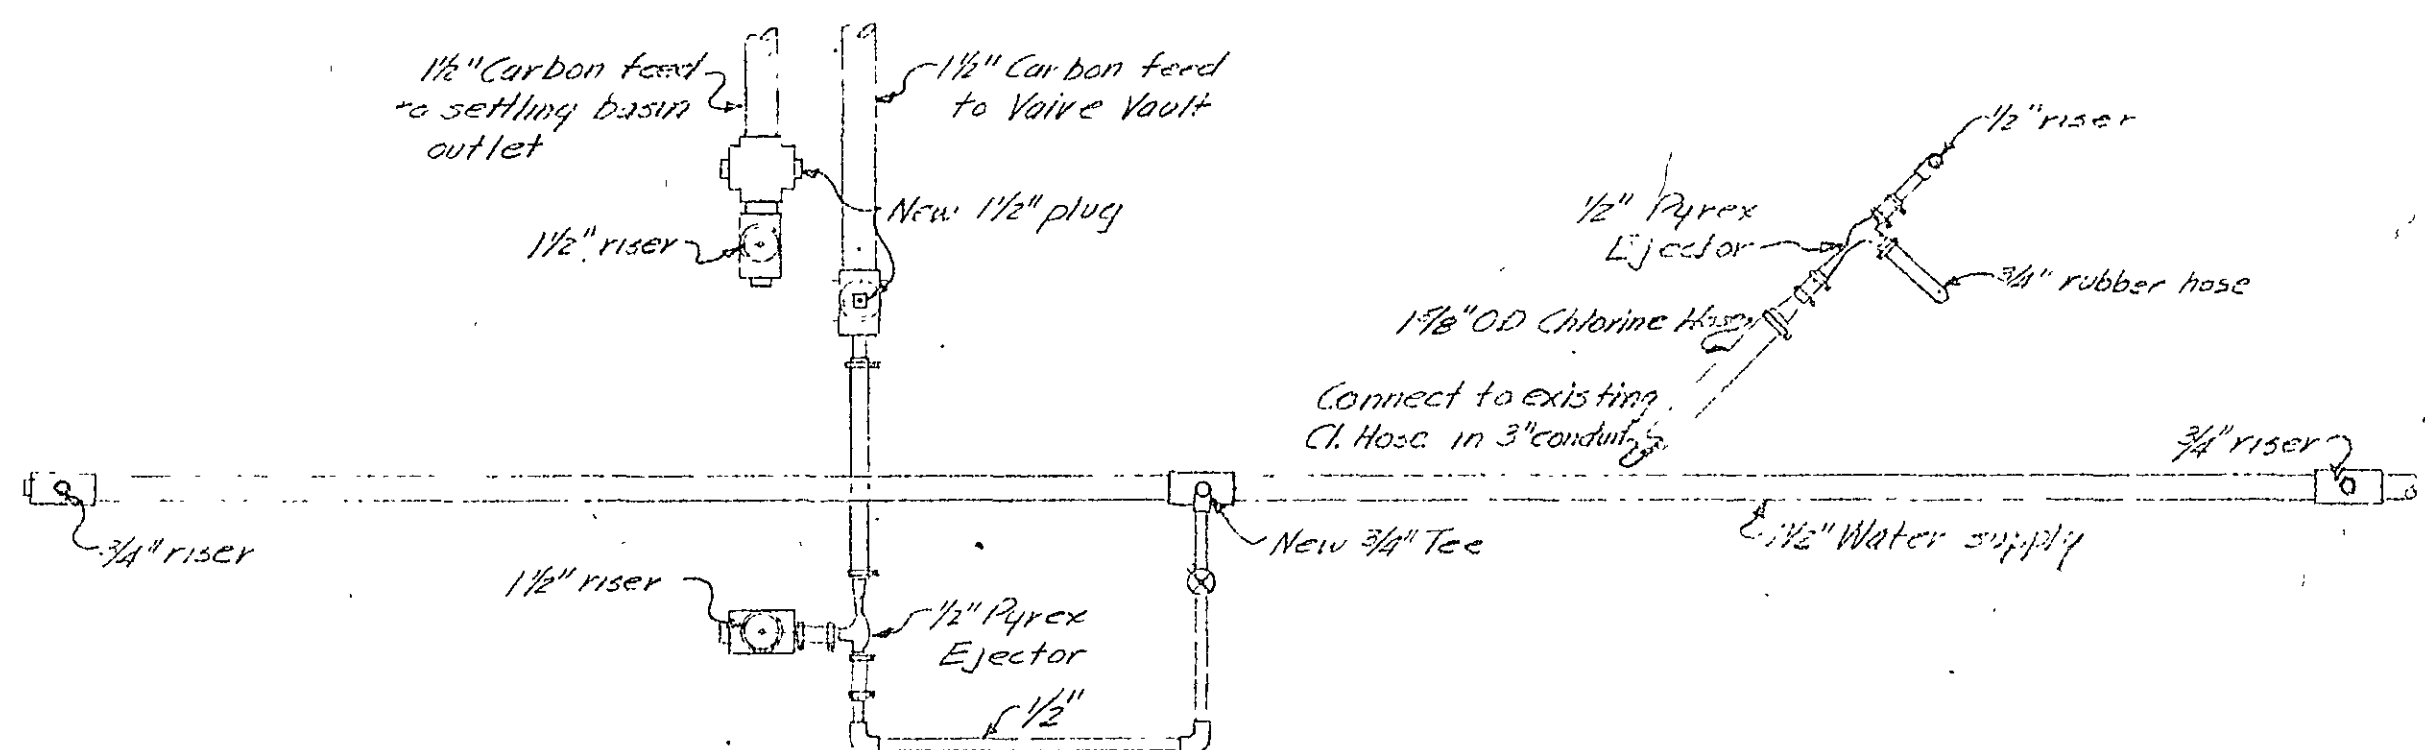

SECTIONAL PLAN JUST BELOW FLOOR SLAB
SHOWING PIPING REVISIONS
Scale 1"=1'-0"

ROANOKE WATER DEPARTMENT
ROANOKE, VA.
CARVIN COVE WATER SUPPLY
REVISION
OF CHEMICAL FEEDERS