

Designed By: JGR

Drawn By: RRB


Checked By: JGR

Date: 09/08/05

Scale: 1/4" = 1'-0"

Plan #: 00-00

Sheet: 1 OF

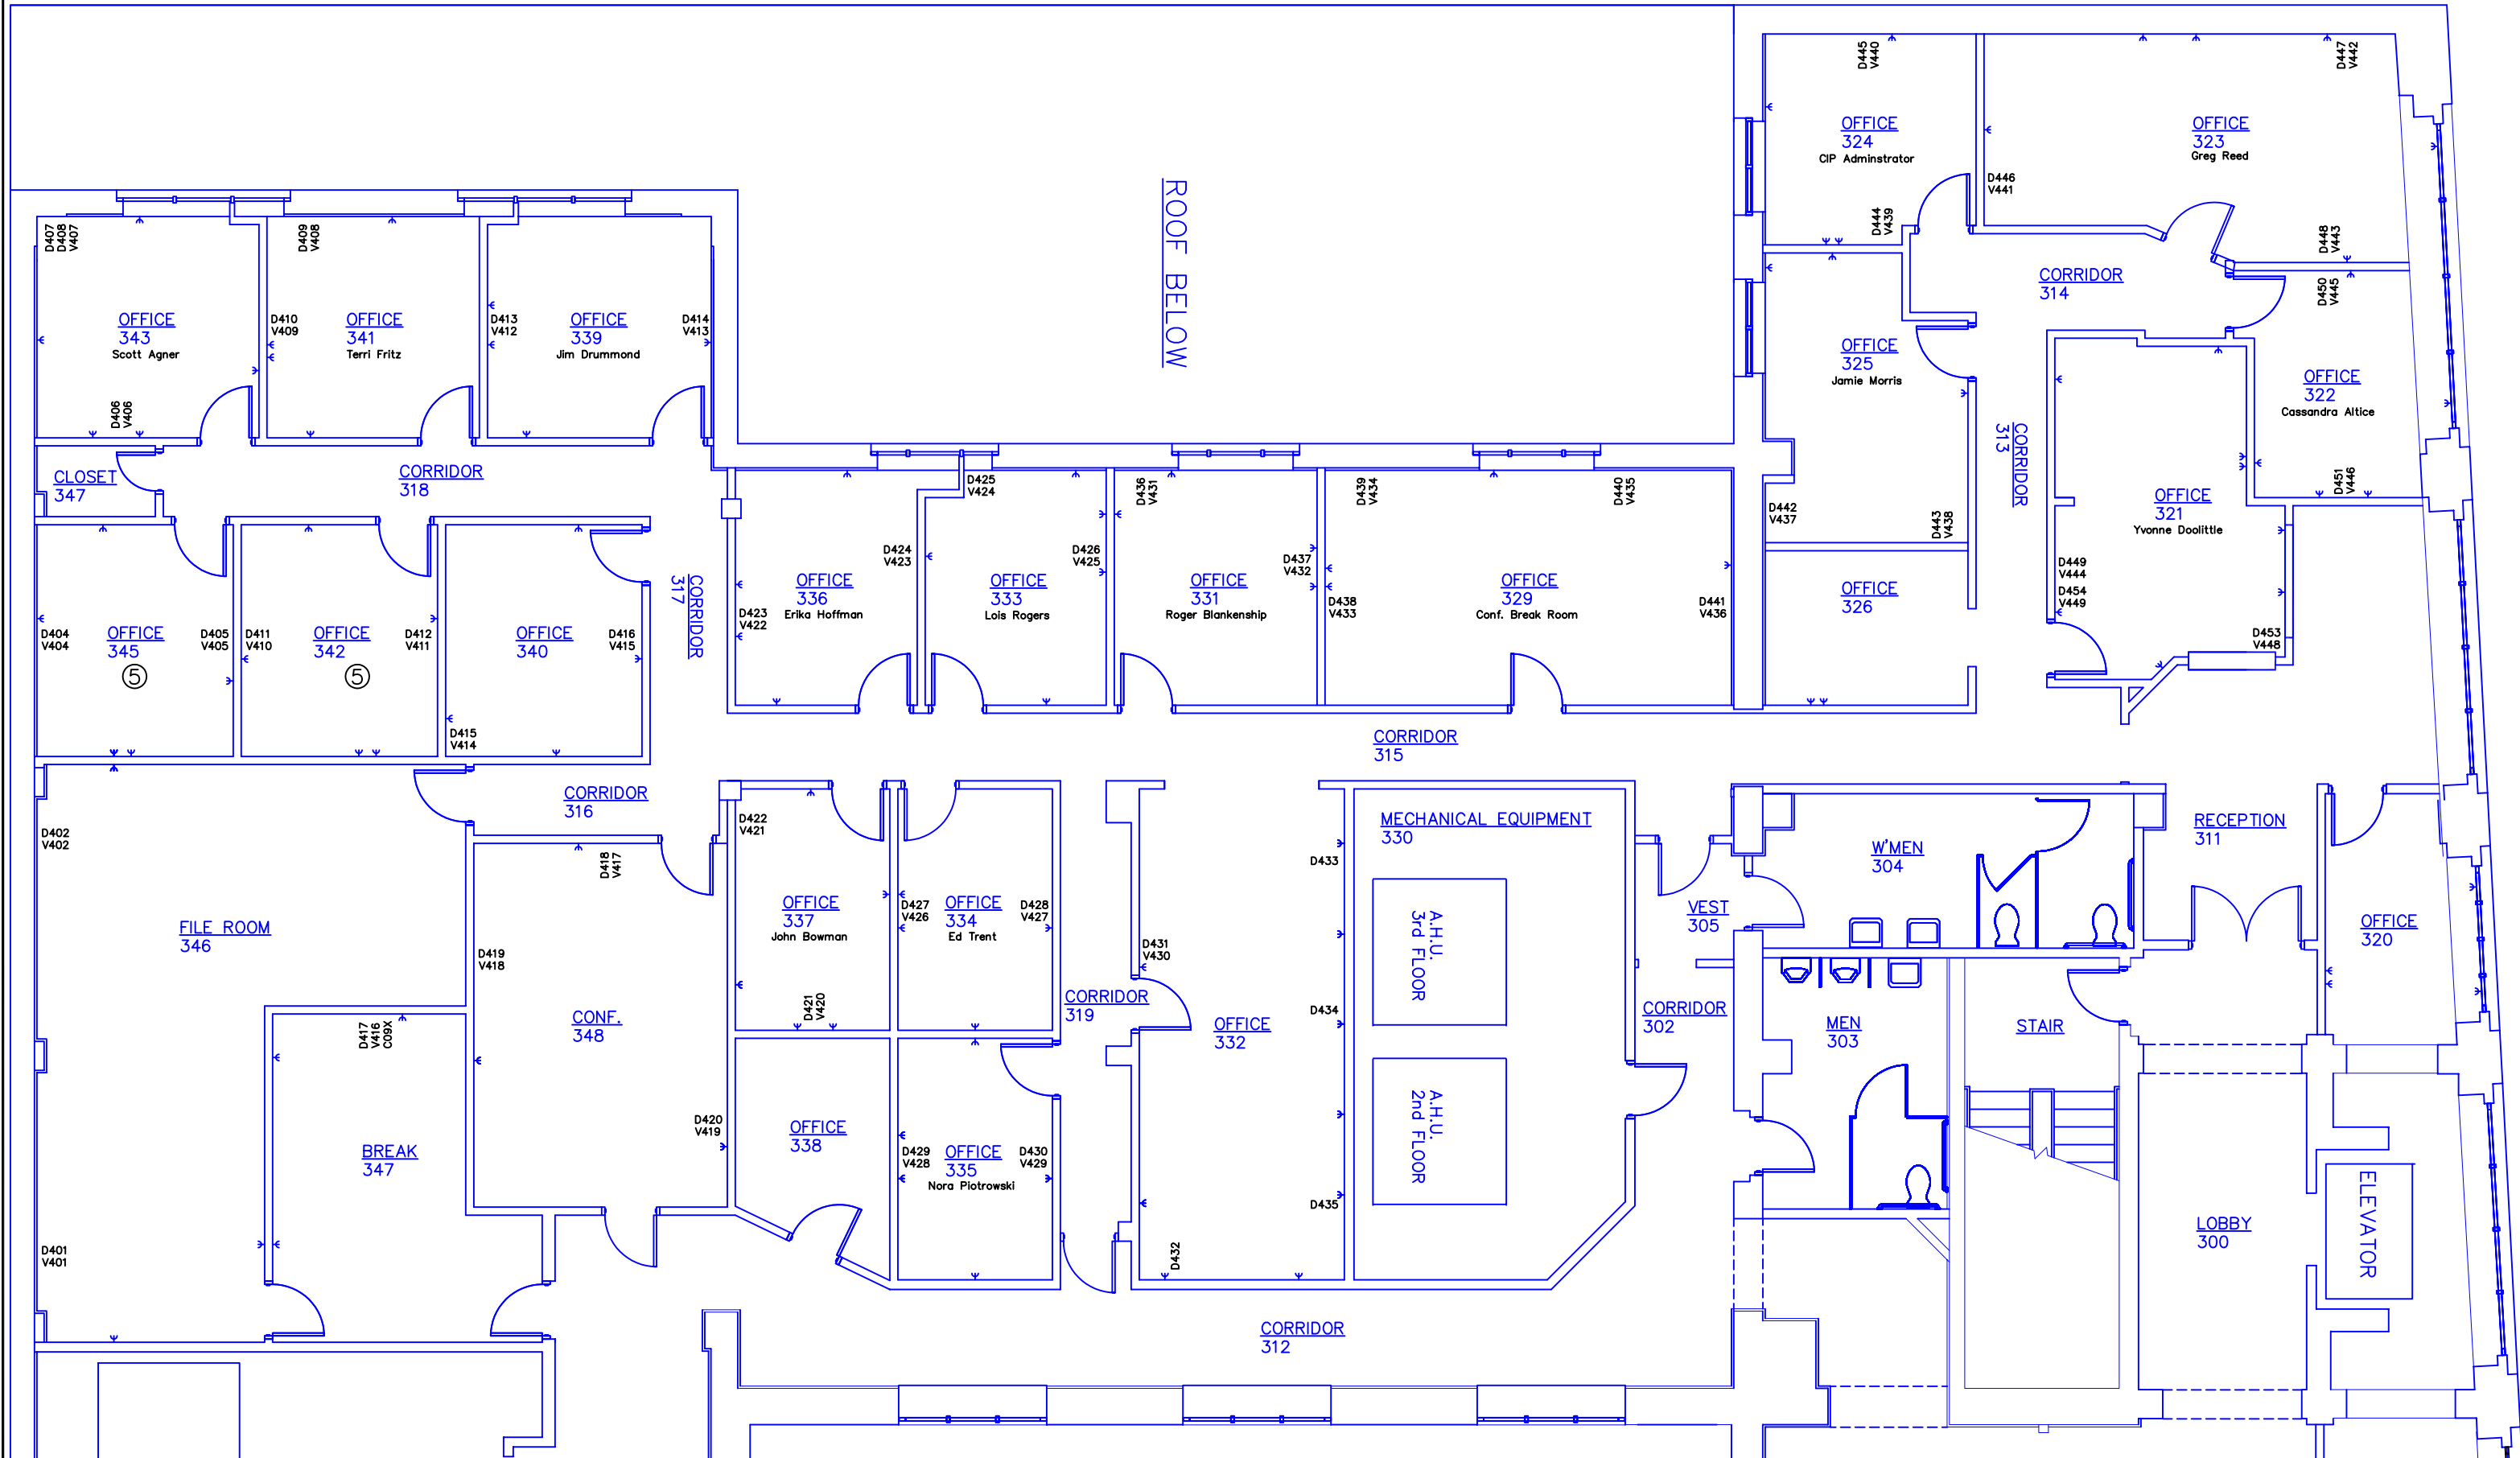

THIRD FLOOR PLAN

SCALE: 1/4" = 1'-0"