


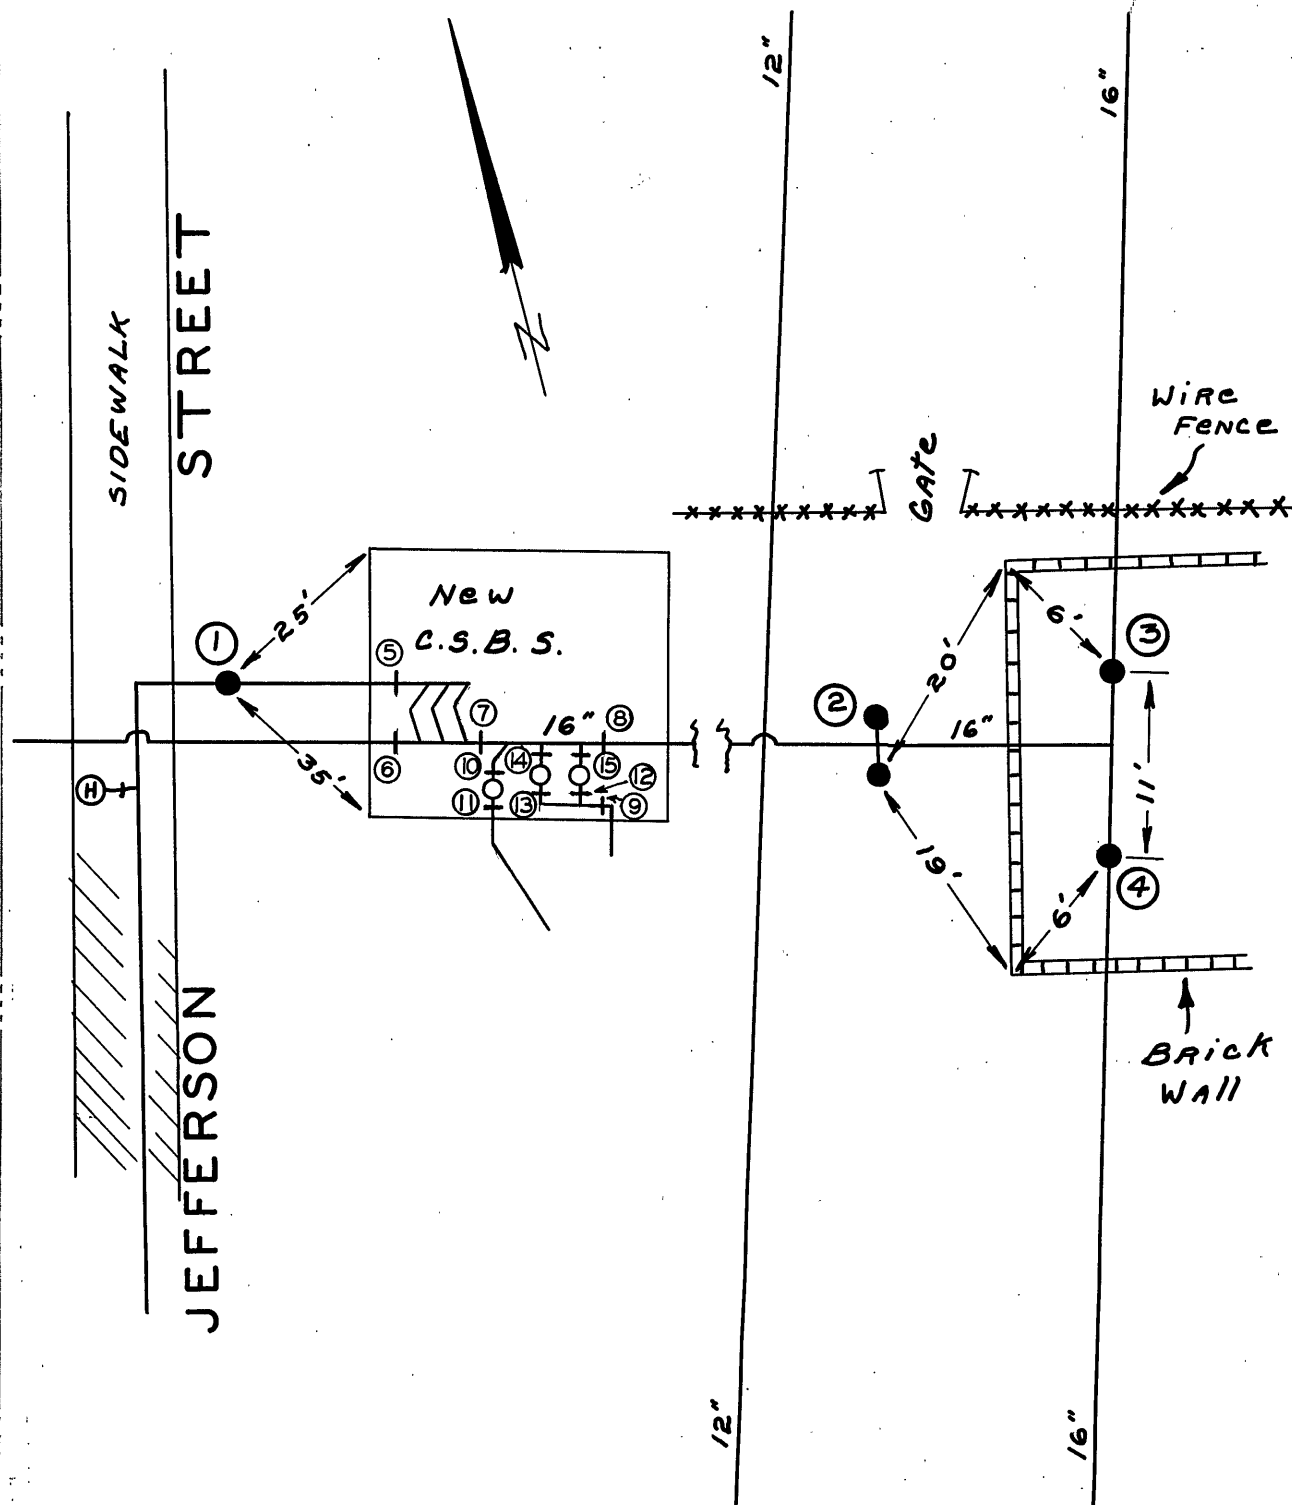

DATE	NO.	SIZE	W A K E	OPEN	TURNS
	1	12"	MUELLER	R	38
	2	16"			
	3	16"			
	4	16"			
	5	12"	M & H	L	
	6	16"	M & H	L	
	7	16"	M & H	L	
	8	16"	M & H	L	
	9	20"	MUELLER	L	
	10	2 1/2"	DARLING	R	
	11	2"	DARLING	L	
	12	10"	MUELLER	L	
	13	12"	MUELLER	L	
	14		BUTTERFLY		
	15		BUTTERFLY		

CITY OF ROANOKE - WATER DEPT.	
VALVE DIAGRAM	
JEFFERSON STREET	
AT C. S. BOOSTER STA.	
S. E. OR S. W.	
SEC. MAP 406	
DATE	PAGE NO.