


RECORD DRAWING - JUNE 2021
 RECORD DRAWINGS PREPARED BASED ON MARKUPS
 PROVIDED BY THE CONTRACTOR

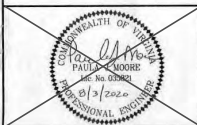

WRA
 Whitman, Reardon & Associates, LLP
 1700 Kraft Dr., Suite 1200, Blacksburg, VA 24060

WESTERN VIRGINIA WATER AUTHORITY
 601 South Jefferson Street, Suite 300
 Roanoke, Virginia 24011

DES: PJM
 DRAWN: JES
 CHECK: GWP
 DATE: 1/24/20

SCALE: AS SHOWN
 HORIZ: 1" = 20'
 VERT: 1" = 5'

CRYSTAL SPRING
 PUMP STATION RELOCATION

WATER MAIN PLAN

DRAWING
 C1.02

SHEET
 5

- NOTES:
1. ALL WATER MAIN JOINTS AND FITTINGS SHALL BE RESTRAINED.
 2. WMAV TO REMOVE WATER METER PRIOR TO DEMOLITION.
 3. RESTORE EXISTING STREET SECTION IN ACCORDANCE WITH THE CITY OF ROANOKE RIGHT-OF-WAY EXCAVATION AND RESTORATION STANDARDS.
 4. REPAIR AND OVERLAY EXISTING PARKING LOT IN ACCORDANCE WITH DETAIL G-15, DRAWING C4.01.


PROPOSED 4" SANITARY SEWER LATERAL "F"
 SEE PLUMBING PLAN, DRAWING P1.01.
 SEE SANITARY SEWER PROFILE, DRAWING C1.06.
 SEE DETAIL G-15, DRAWING C4.01.

PROPOSED 20" D.I. WATER MAIN "C"
 SEE WATER MAIN PROFILE, DRAWING C1.05.
 SEE DETAIL G-15, DRAWING C4.01.

PROPOSED 24" D.I. WATER MAIN "B"
 SEE WATER MAIN PROFILE, DRAWING C1.04.
 SEE DETAIL G-15, DRAWING C4.01.

PROPOSED 20" D.I. WATER MAIN "A"
 SEE WATER MAIN PROFILE, DRAWING C1.04.
 SEE DETAIL G-15, DRAWING C4.01.

GRAPHIC SCALES

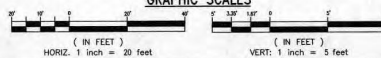

REV	DATE	DESCRIPTION
4	8/3/20	CONSTRUCTION REVISION #2
1	3/10/20	ADDENDUM #1