


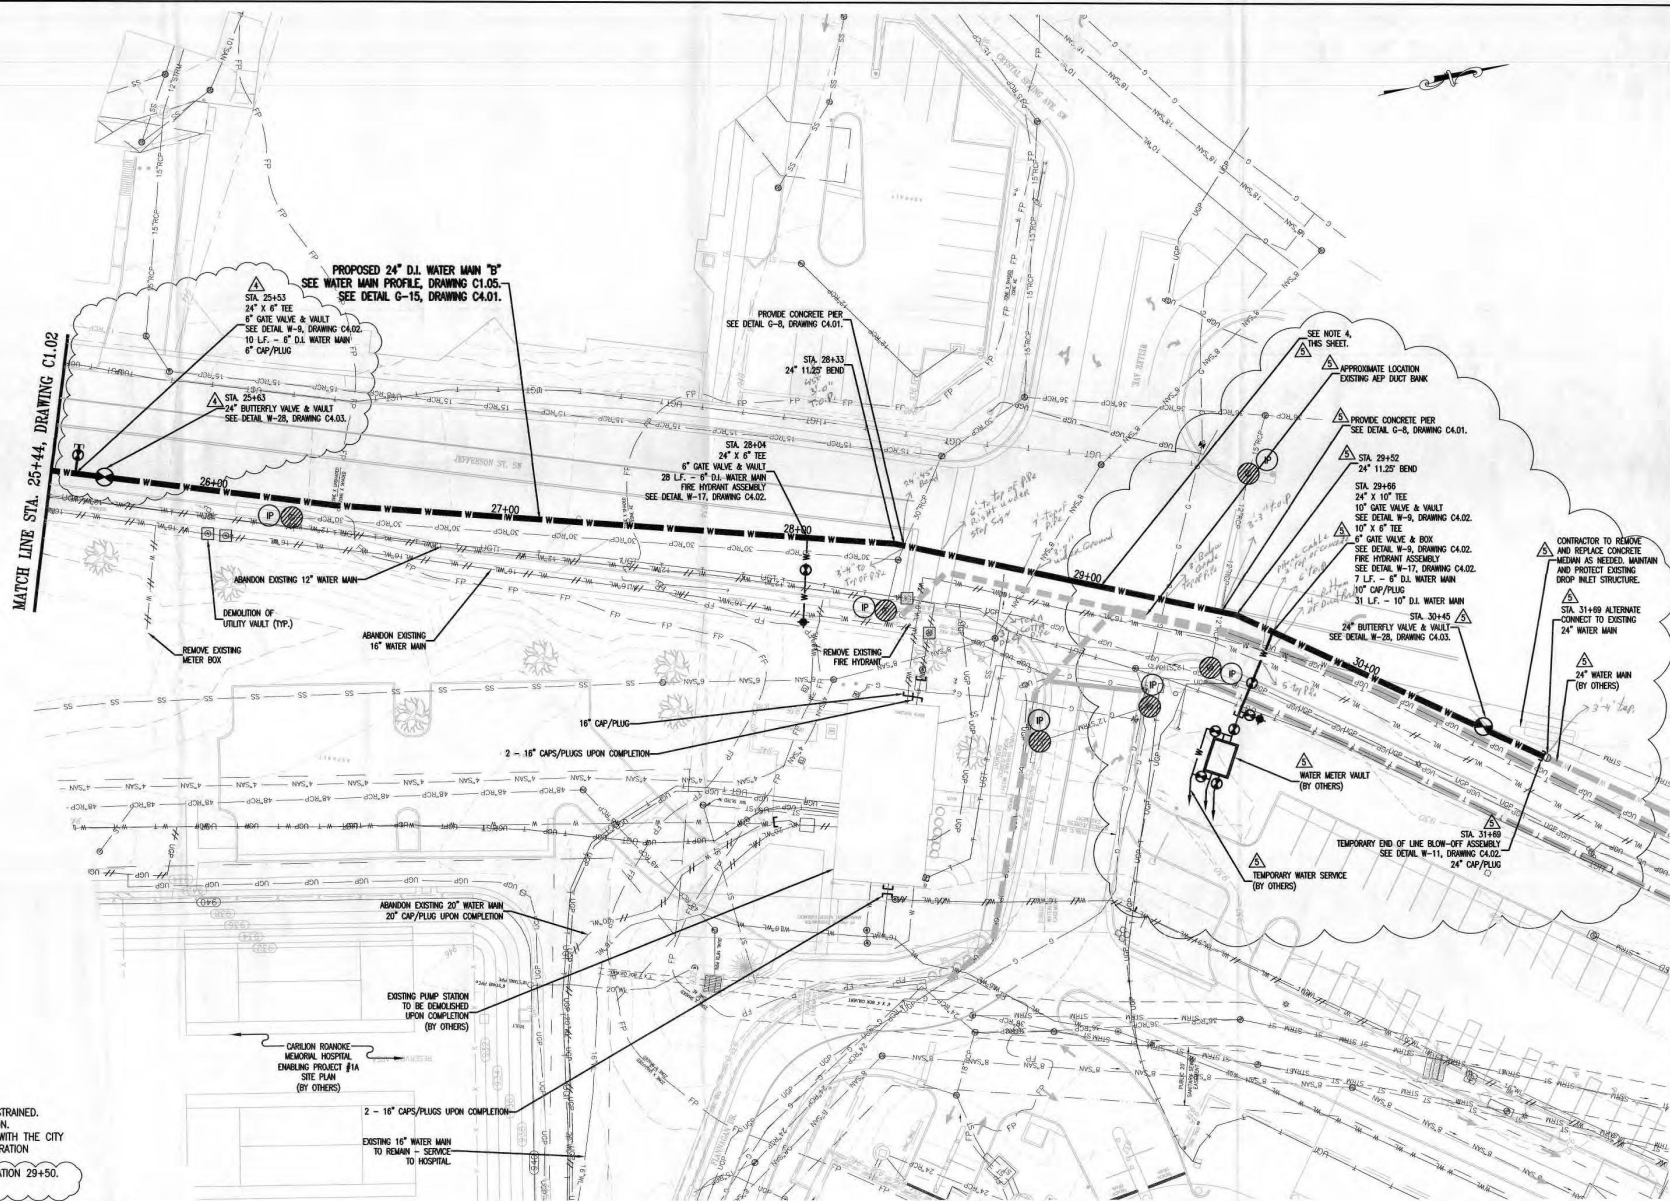

RECORD DRAWING - JUNE 2021
 RECORD DRAWINGS* PREPARED BASED ON MARKUPS
 PROVIDED BY THE CONTRACTOR

- NOTES:
1. ALL WATER MAIN JOINTS AND FITTINGS SHALL BE RESTRAINED.
 2. WYWA TO REMOVE WATER METER PRIOR TO DEMOLITION.
 3. RESTORE EXISTING STREET SECTION IN ACCORDANCE WITH THE CITY OF ROANOKE RIGHT-OF-WAY EXCAVATION AND RESTORATION STANDARDS.
 4. NIGHT WORK REQUIRED FROM STATION 28+50 TO STATION 29+50. SEE FIGURE 3, DRAWING H12.04.

PAUL A. MOORE
No. 101038
VIRGINIA

WRA
 Whitman, Reardon & Associates, LLP
 1700 Kraft Dr., Suite 1200, Blacksburg, VA 24060

WESTERN VIRGINIA WATER AUTHORITY 601 South Jefferson Street, Suite 300 Roanoke, Virginia 24011		DES: PJM DRAWN: JBS CHECK: GWP DATE: 1/24/20	SCALE: AS SHOWN HORIZ: 1" = 20' VERT: 1" = 5'	CRYSTAL SPRING PUMP STATION RELOCATION	WATER MAIN PLAN	5 10/1/20 4 8/9/20 REV DATE	CONSTRUCTION REVISION #3 CONSTRUCTION REVISION #2 DESCRIPTION	DRAWING C1.03	SHEET 6
--	--	---	---	---	-----------------	-----------------------------------	---	------------------	------------