

GENERAL SHEET NOTES


1. SEE S0.01 AND S0.02 FOR GENERAL STRUCTURAL NOTES.
2. SEE S0.02 THROUGH S0.03 FOR TYPICAL STRUCTURAL DETAILS.
3. EXISTING CONDITIONS SHOWN ARE AS TAKEN FROM EXISTING ORIGINAL BUILDING RECORD DRAWINGS DATED MAY 1, 2003 AND MODIFICATION RECORD DRAWINGS DATED MAY 28, 2004. FIELD VERIFY EXISTING CONDITIONS AND NOTIFY THE OWNER'S REPRESENTATIVE AND ENGINEER OF DISCREPANCIES PRIOR TO COMMENCING THE WORK.
4. CONCRETE FLOOR CONSTRUCTION SHALL BE 10" THICK CONCRETE REINFORCED WITH #5@12 EACH WAY, TOP AND BOTTOM, TYPICAL.

SHEET KEYNOTES [X]


1. INTERIOR EQUIPMENT PAD. SEE TYPICAL DETAILS.
2. INTERIOR METAL STUD PARTITION WALL. SEE ARCHITECTURAL.
3. P-15-4 (2"x3/16") ALUMINUM GRATING OVER TRENCHES, TYPICAL.
4. EXTERIOR EQUIPMENT PAD. SEE TYPICAL DETAILS.
5. COORDINATE DUCTBANK TERMINATIONS WITH ELECTRICAL DRAWINGS AND CONCRETE FLOOR CONSTRUCTION.

LEGEND

SPAN → INDICATES SPAN DIRECTION OF METAL BAR GRATING

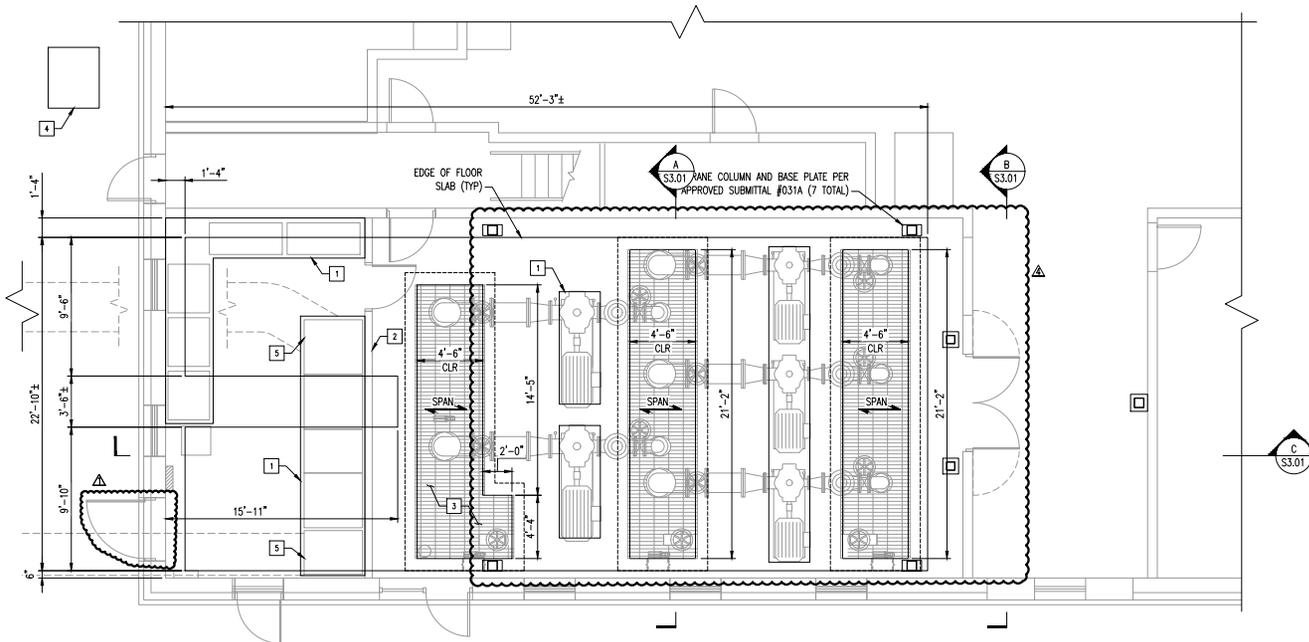

FIRST FLOOR PLAN
SCALE: 1/4" = 1'-0"

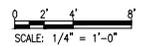

WESTERN VIRGINIA WATER AUTHORITY
601 South Jefferson Street, Suite 300
Roanoke, Virginia 24011

DES: BJK	SCALE: 1/4" = 1'-0"
DRAWN: BJK	HORIZ: N/A
CHECK: BAE	VERT: N/A
DATE: 1/24/20	

CRYSTAL SPRING
PUMP STATION RELOCATION

FIRST FLOOR AND BRIDGE CRANE
FRAMING PLANS

REV	DATE	DESCRIPTION	DRAWING	SHEET
4	1/15/21	CRANE FRAMING/DOOR REVISION	S1.02	24
1	3/10/20	ADDENDUM #1		

PLOT DATE: 1/24/20 10:58 AM PLOT SIZE: 11x17 INCHES PLOT SCALE: 1/4" = 1'-0" PLOT SHEET: 24 OF 24 PLOT FILE: C:\Users\bjk\OneDrive\Documents\Projects\Crystal Spring Pump Station Relocation\Drawings\1/24/20\1/24/20_11x17.dwg