


GENERAL SHEET NOTES


- FOR NEW WORK SEE A1.01 FOR ARCHITECTURAL PLANS.
- SEE A0.01 FOR ARCHITECTURAL ABBREVIATIONS AND LEGEND.
- SEE A6.01 ARCHITECTURAL DOOR SCHEDULE AND DETAILS.
- ALL EXISTING CONDITIONS SHOWN ARE TAKEN FROM EXISTING ORIGINAL BUILDING RECORD DRAWINGS DATED MAY 1, 2003 AND MODIFICATION RECORD DRAWINGS DATED MAY 28, 2004. FIELD VERIFY ALL EXISTING CONDITIONS AND NOTIFY THE OWNER'S REPRESENTATIVE AND ENGINEER OF ALL DISCREPANCIES PRIOR TO COMMENCING THE WORK.

SHEET KEYNOTES


- PROVIDE NEW EXTERIOR METAL DOOR AND FRAME WITH TRANSOM PANEL. ALIGN DOOR FRAME HEIGHT WITH ADJACENT DOOR.
- PROVIDE 2 NEW PAIRS OF INTERIOR DOORS, FRAME & REMOVABLE TRANSOM BAR W/PROVISION FOR A THRU-DOOR MONORAIL BEAM. COORDINATE WITH STRUCTURAL AND MECHANICAL.
- PROVIDE NEW LOUVERS OR GRILL AS SHOW ON DRAWINGS. COORDINATE WITH MECHANICAL.
- CAREFULLY REINSTALL SALVAGED BRICK MASONRY AND TOOTH INTO EXISTING.
- CAREFULLY REINSTALL CONCRETE MASONRY UNITS AND TOOTH INTO EXISTING.
- PROVIDE NEW DOWNSPOUT AND CONCRETE SPLASHBLOCK AS SHOWN.

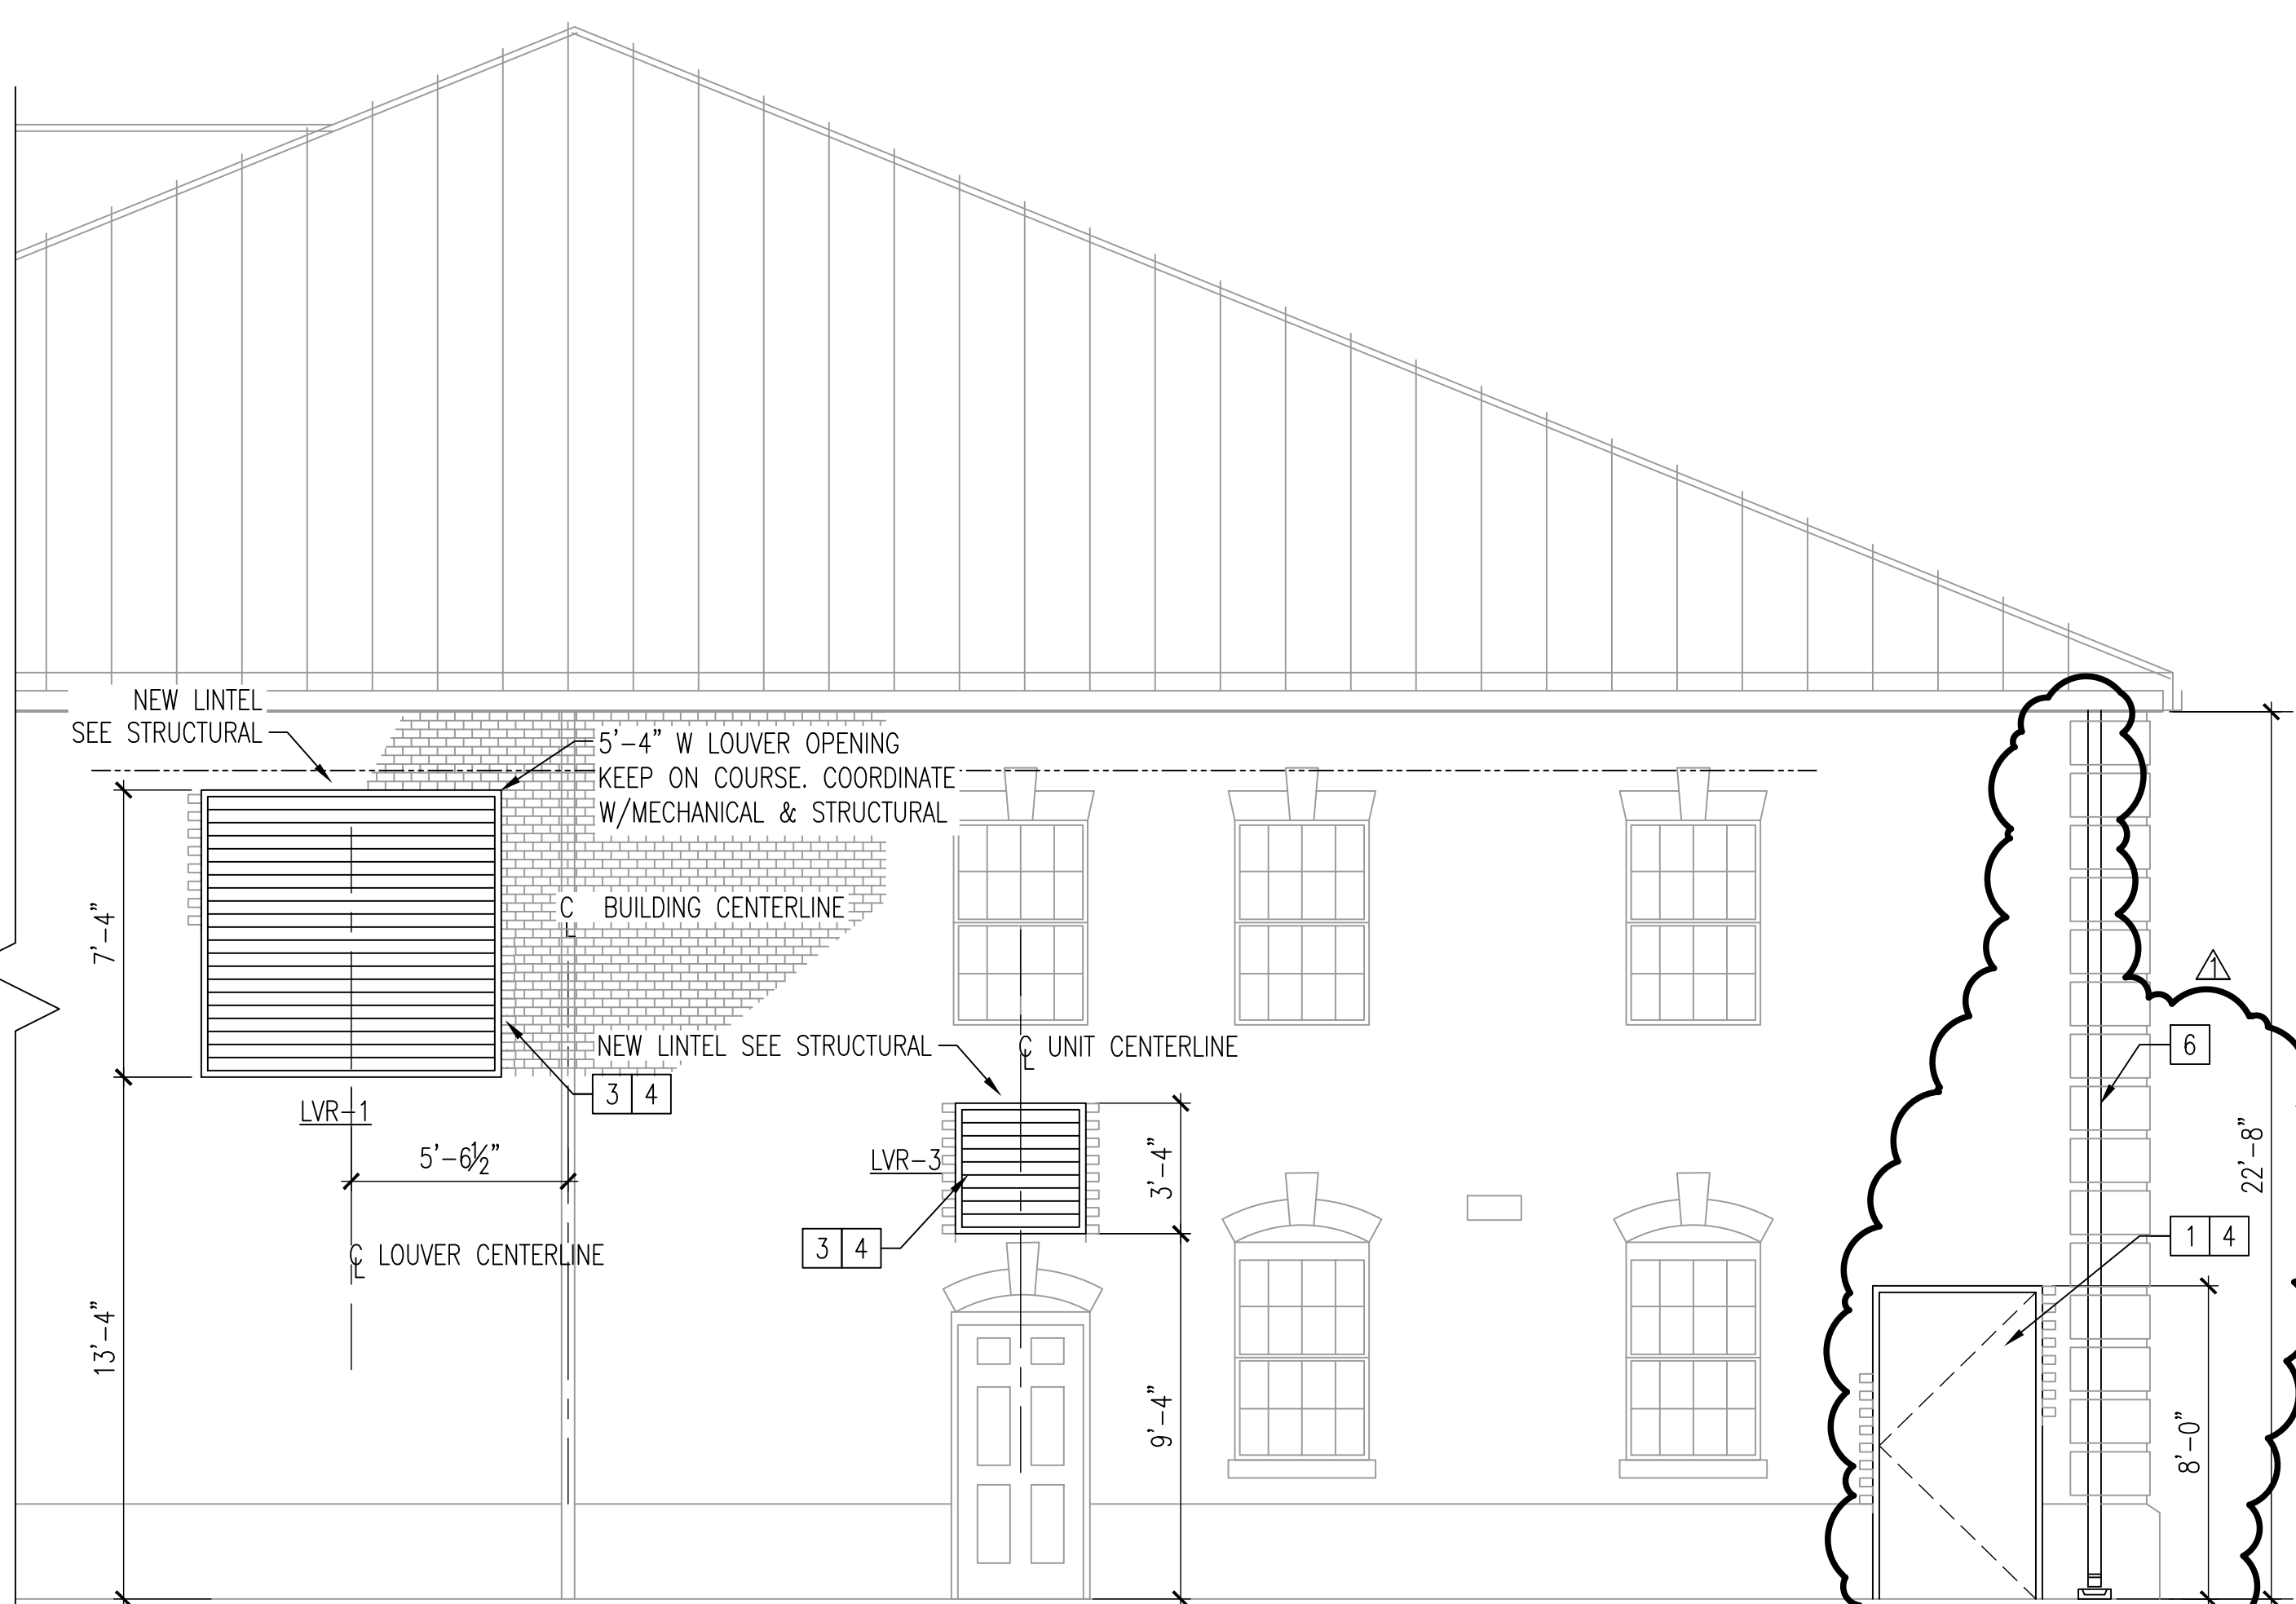


1 PARTIAL NORTH ELEVATION - NEW WORK
A1.02 SCALE: 1/4" = 1'-0"
REF: A1.01

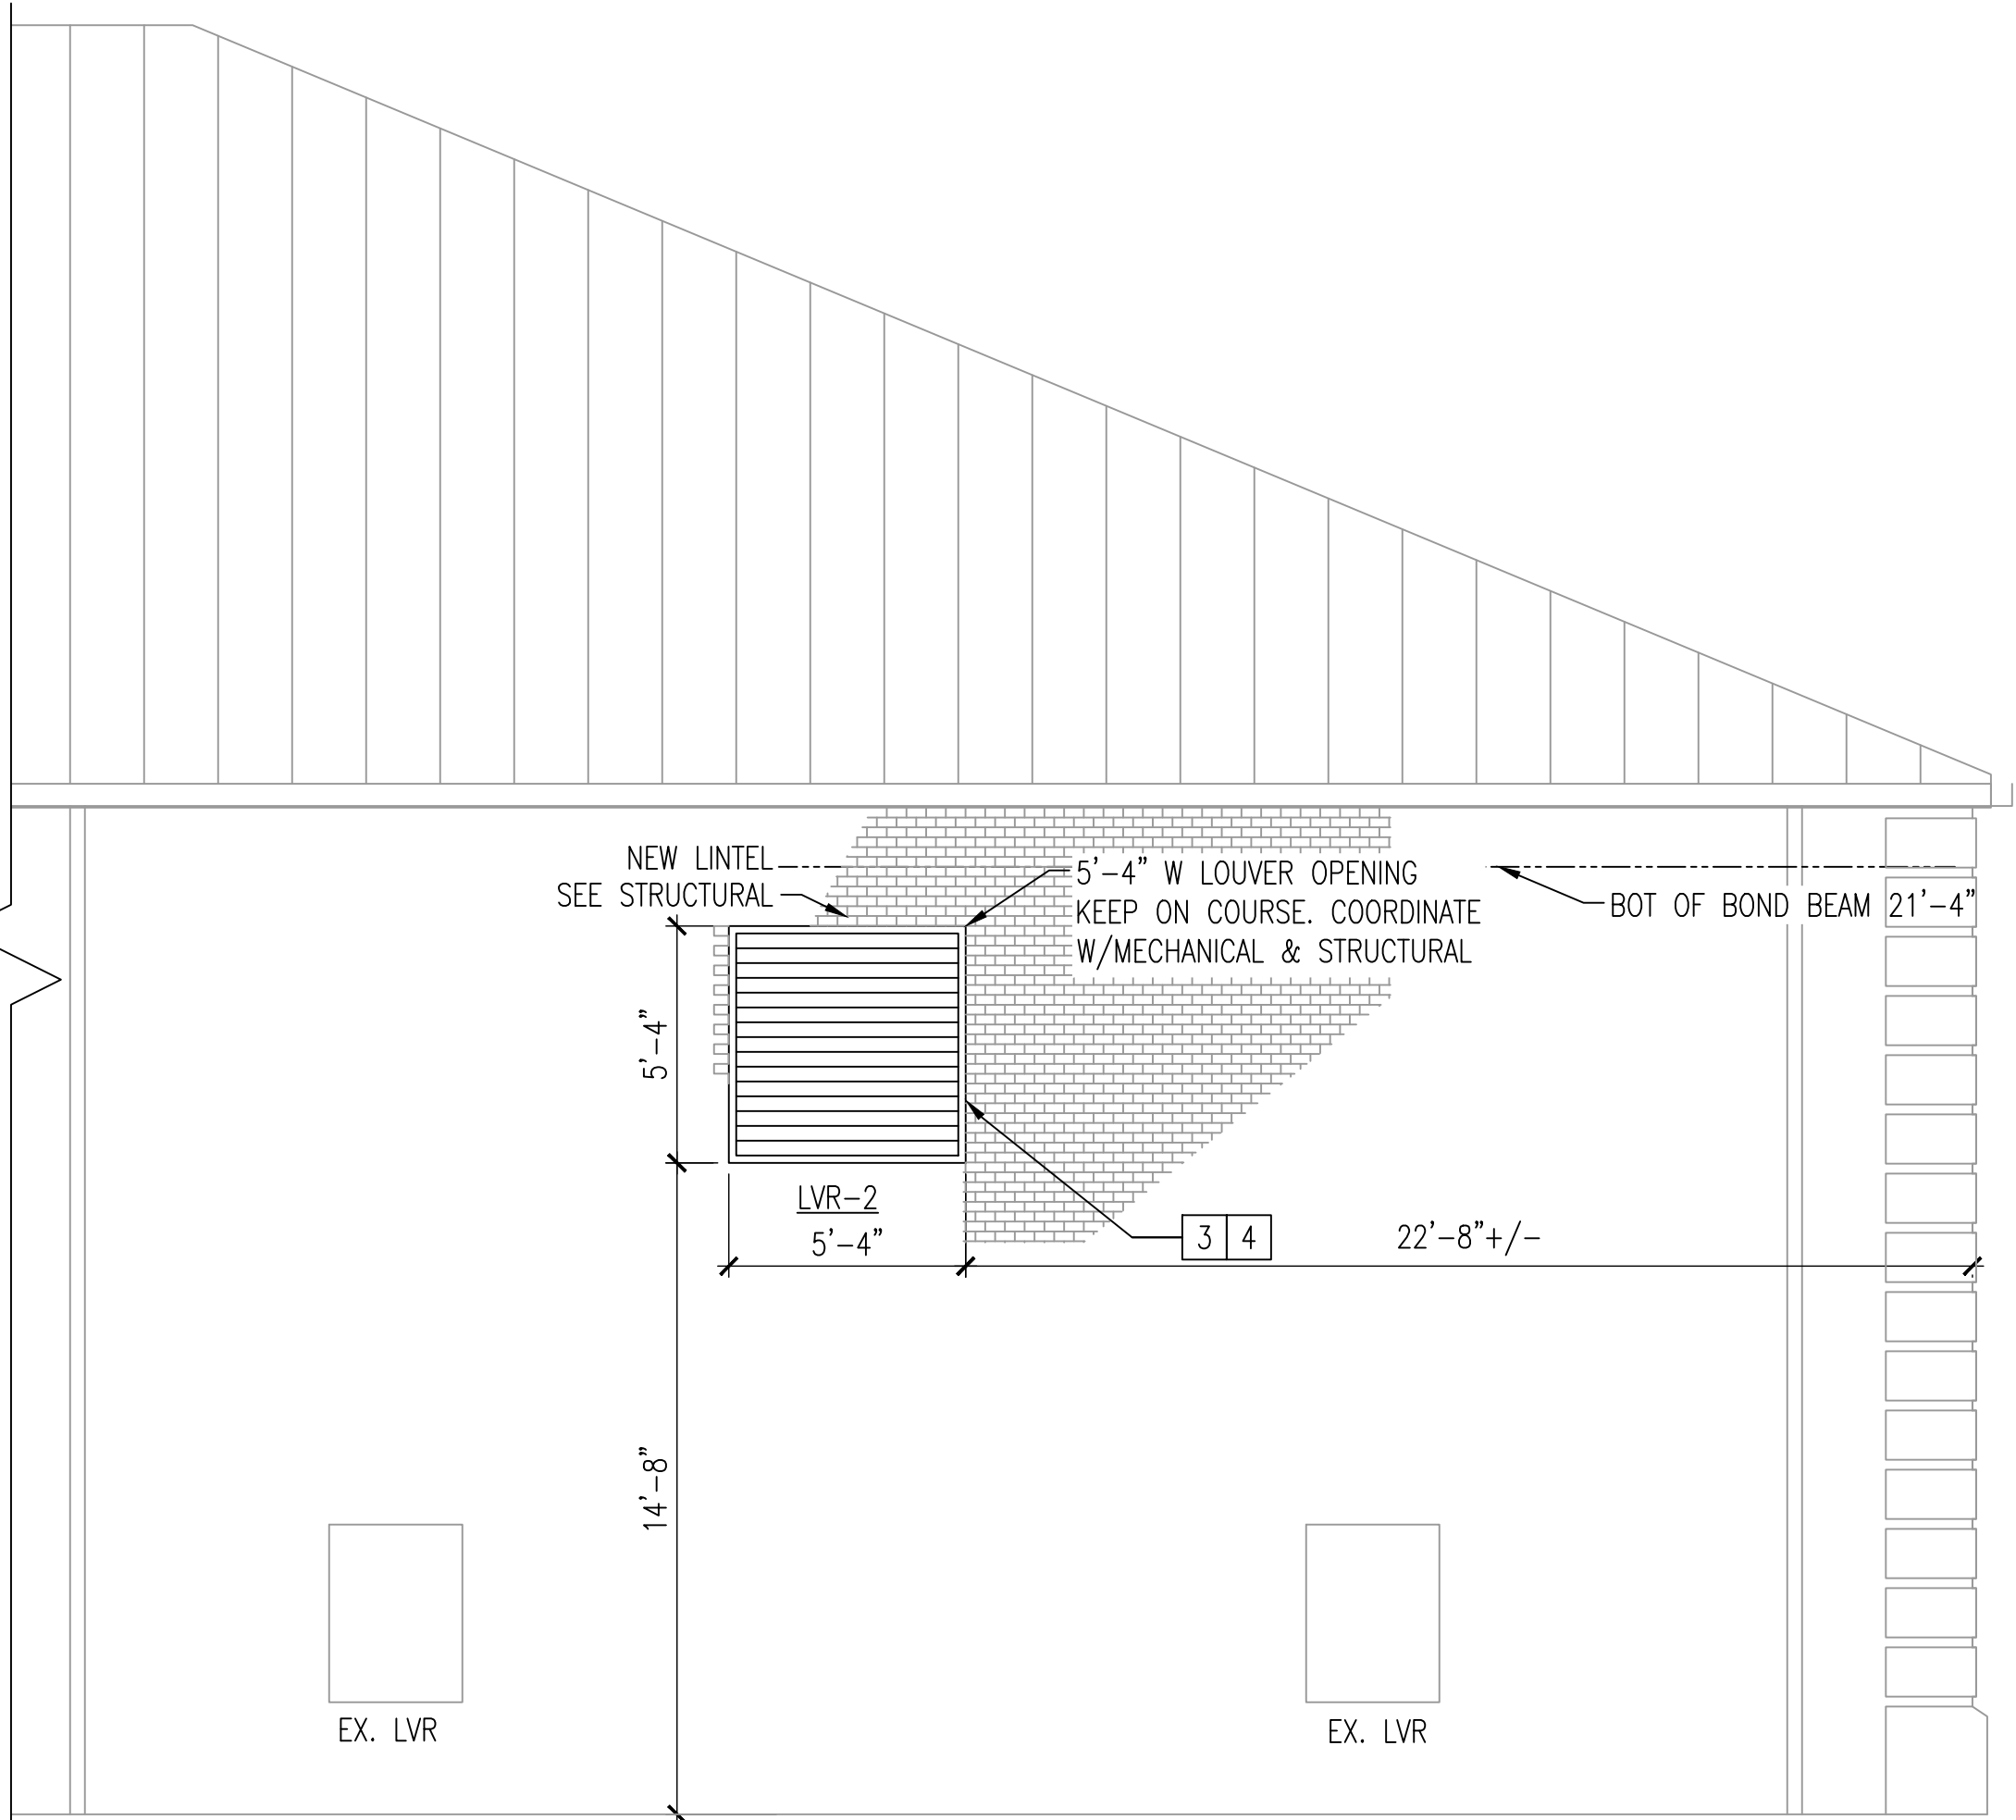

2 PARTIAL EAST ELEVATION - NEW WORK
A1.02 SCALE: 1/4" = 1'-0"
REF: A1.01

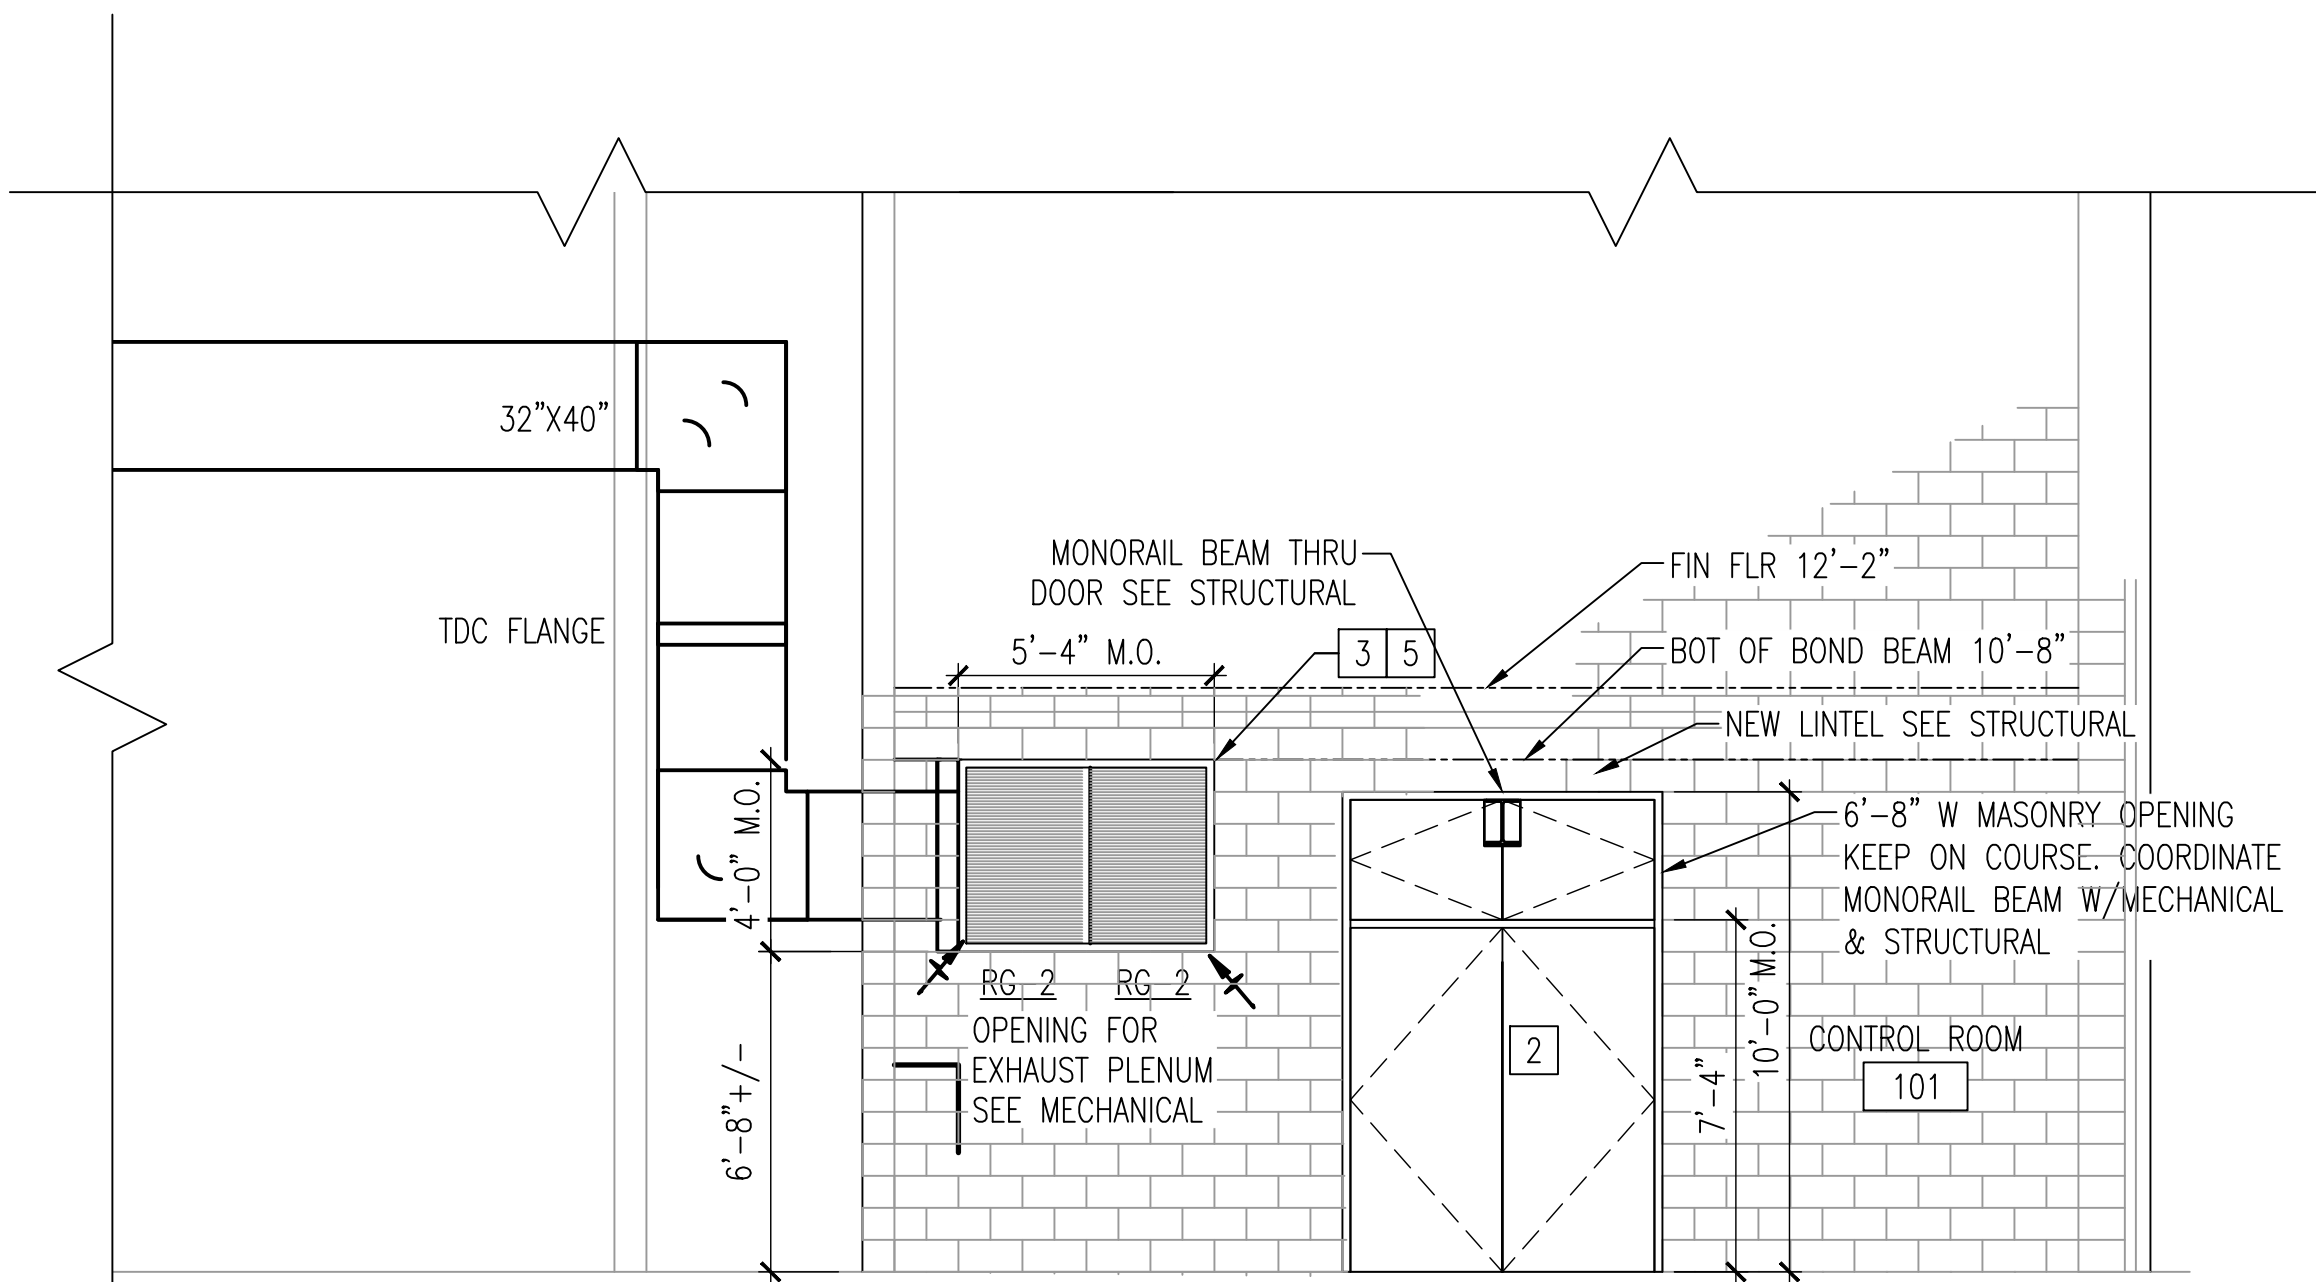

3 PARTIAL SOUTH INTERIOR ELEVATION - NEW WORK
A1.02 SCALE: 1/4" = 1'-0"
REF: A1.01

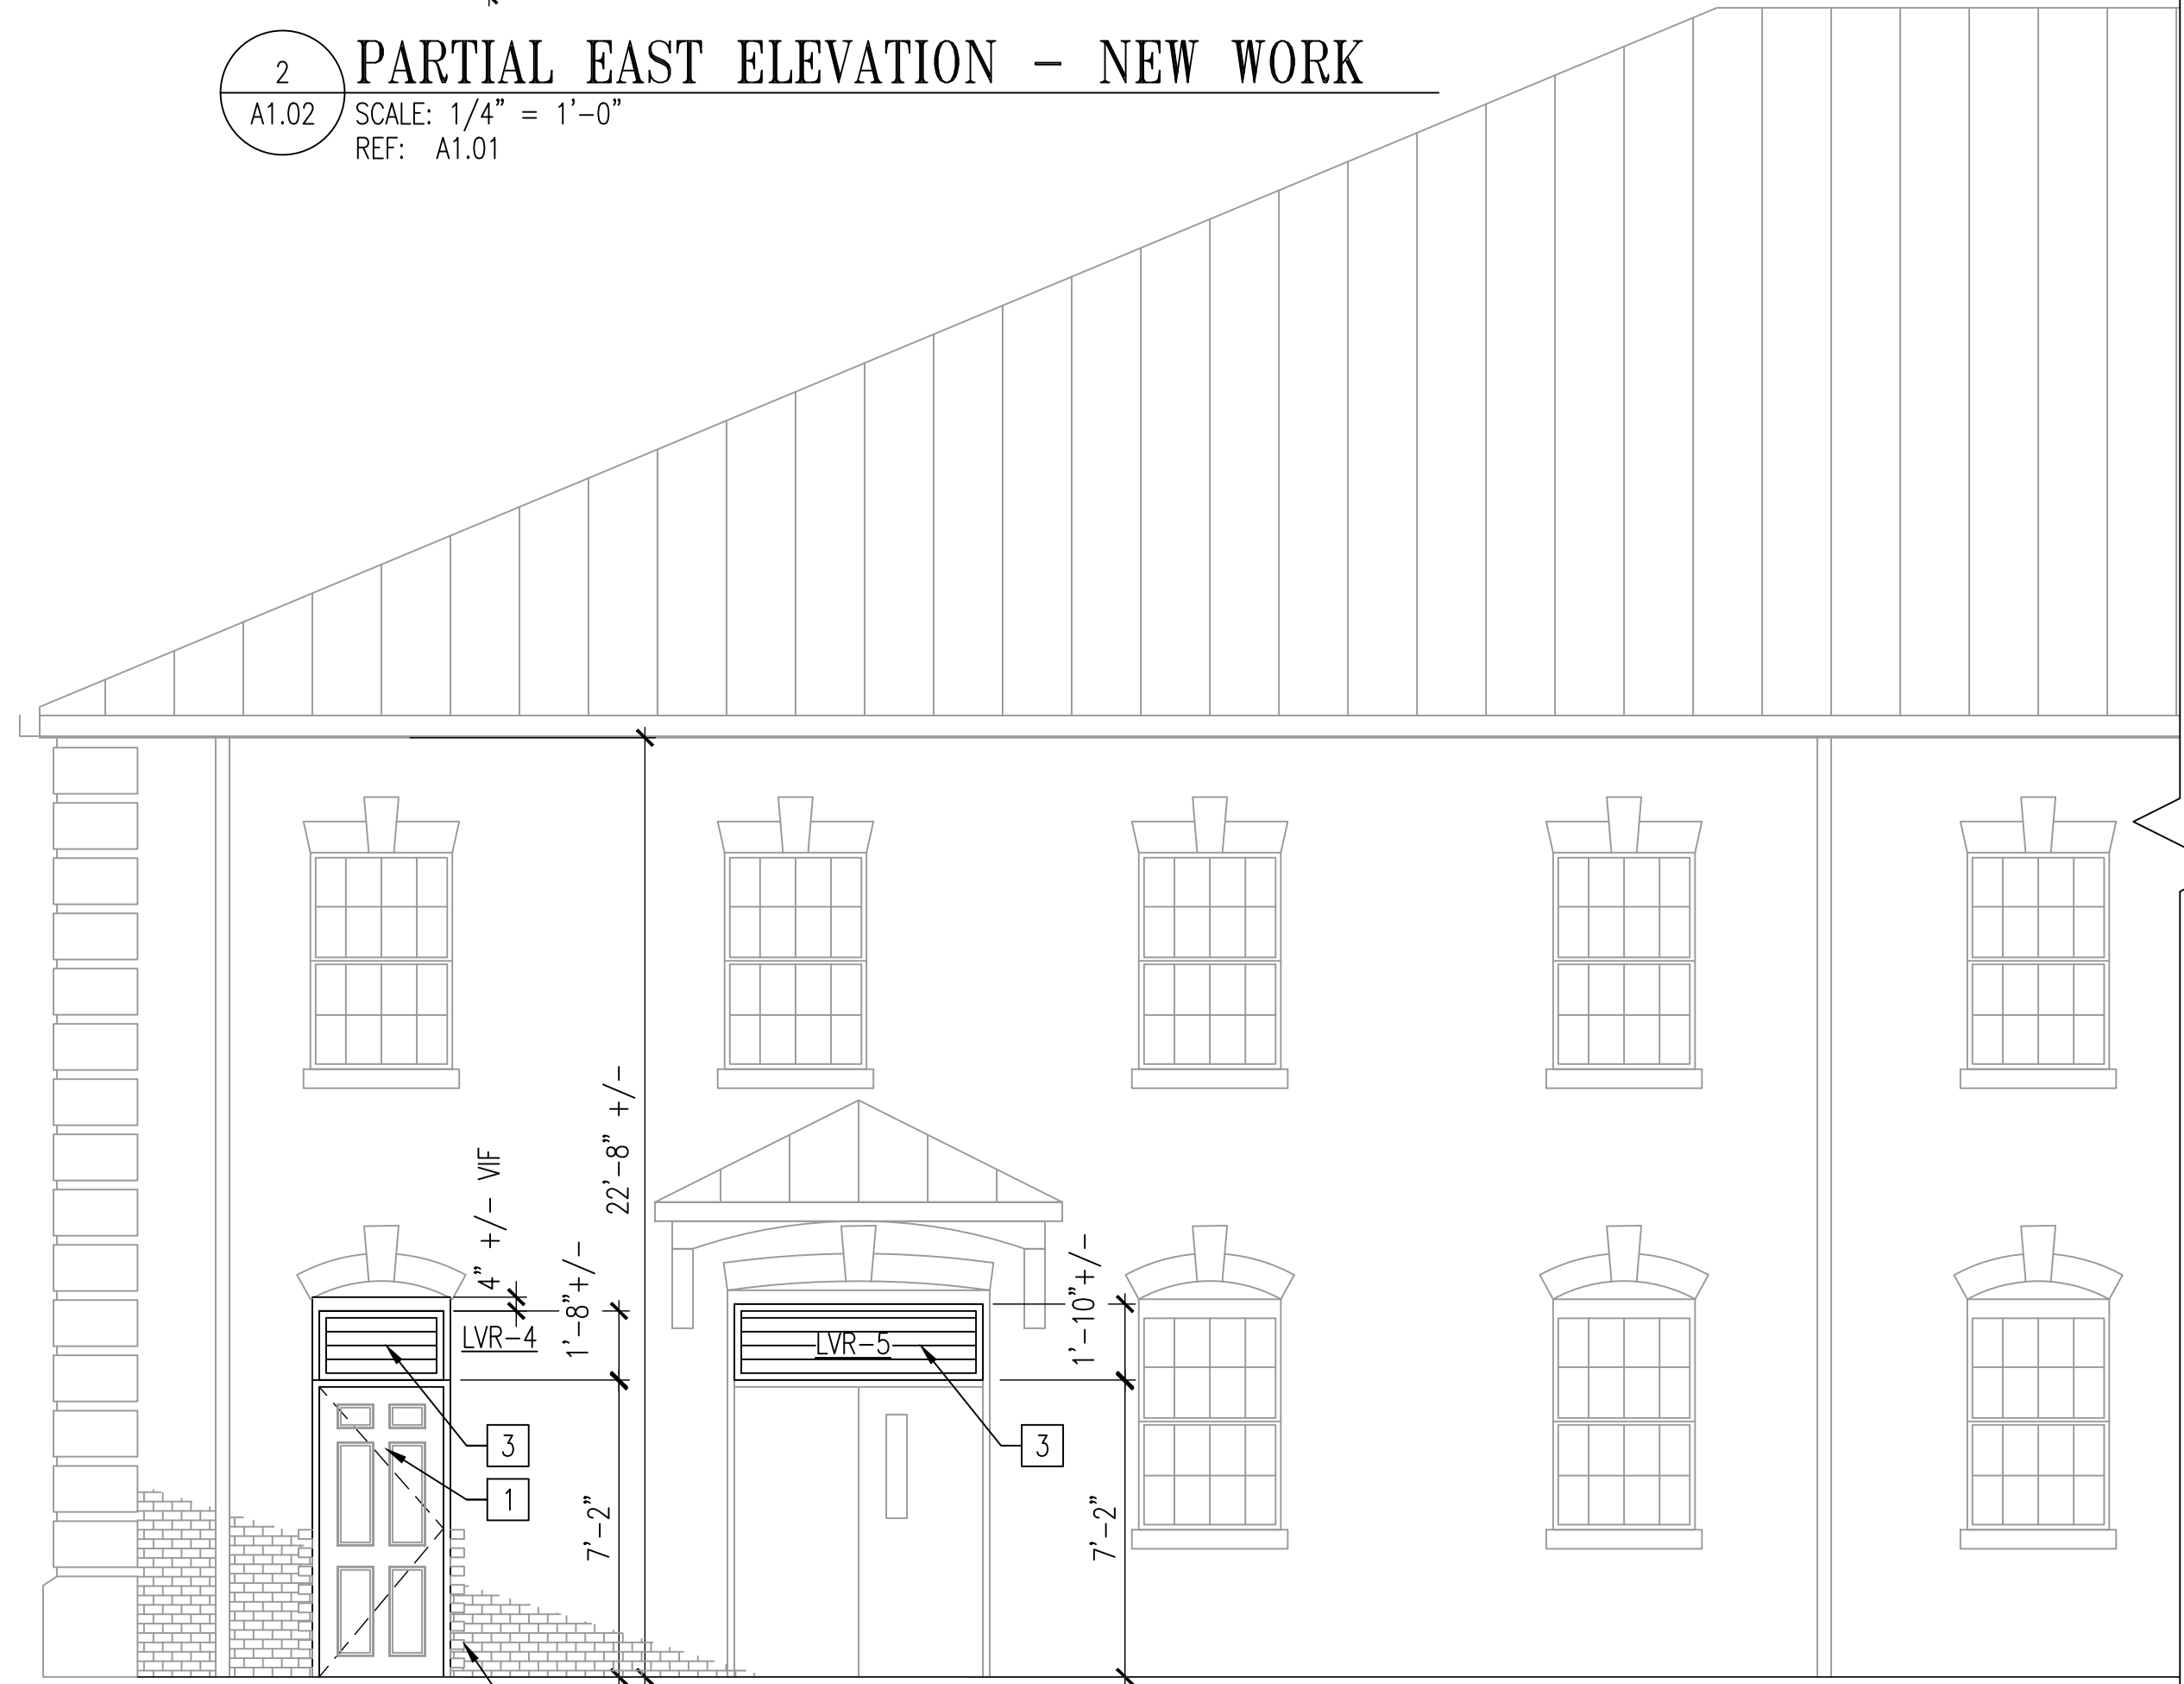

4 PARTIAL WEST ELEVATION - NEW WORK
A1.02 SCALE: 1/4" = 1'-0"
REF: A1.01

0 2' 4' 8'
SCALE: 1/4" = 1'-0"

REV	DATE	DESCRIPTION
1	3/10/20	ADDENDUM #1
DRAWING		SHEET
A1.02		32



WESTERN VIRGINIA WATER AUTHORITY
601 South Jefferson Street, Suite 300
Roanoke, Virginia 24011

DES: RK
DRAWN: PKI
CHECK: DAK
DATE: 1/24/20
SCALE: 1/4"
HORIZ: N/A
VERT: N/A

CRYSTAL SPRING
PUMP STATION RELOCATION

BUILDING ELEVATIONS - NEW WORK