


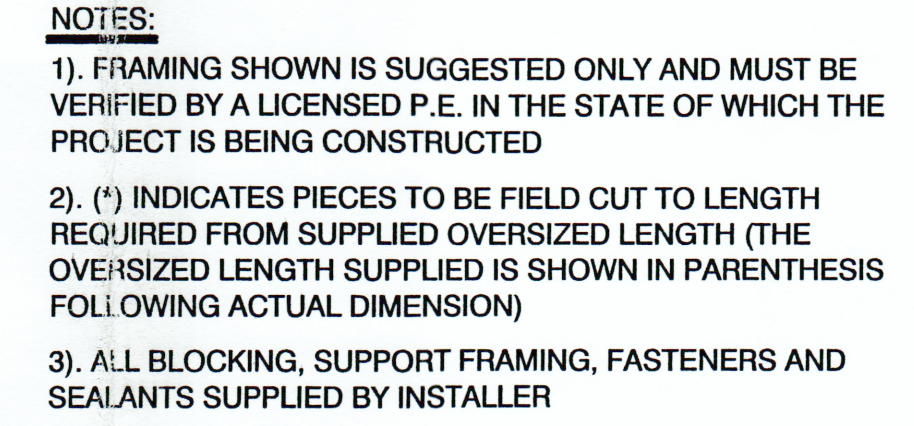

NOTE: THIS CONFIGURATION OCCURS (3) TIMES

APPROVED	REVISE & RESUBMIT
APPROVED AS NOTED	NOT APPROVED
SUBMITTAL NOT REQUIRED	

Checkmark is only for confirmation of receipt and compliance with the information given in the Contract Documents. Contractor is responsible for clarifications to be confirmed.

MAY 21 2002

formed and correlated as the job site; for information that pertains solely to the fabrication processes or to techniques of construction; and for coordination of the work with all trades.

WILEY & WILSON - Engineers-Architects-Planners

Lynchburg, Va. By *[Signature]*

[illegible]

RESTRICTIVE NOTICE

THE INFORMATION, PLANS, SPECIFICATIONS AND DESIGNS CONTAINED IN THESE DRAWINGS ARE CONFIDENTIAL. THE RECIPIENT ACKNOWLEDGES THAT THE DRAWINGS AND THEIR CONTENTS ARE THE PROPERTY OF EDON CORPORATION, AND THAT THEY SHALL NOT BE DISCLOSED TO OTHERS, USED OR REPRODUCED IN WHOLE OR IN PART, FOR ANY REASON, WITHOUT PRIOR WRITTEN CONSENT OF EDON CORPORATION. COPYRIGHT BY EDON CORP. ALL RIGHTS RESERVED.

fiberglass

EDON CORP.

1180 EASTON RD.
HORSHAM, PA 19044
215/672-8050
(OUTSIDE PA 800/523-2539
FAX 215/672-3014
EMAIL: edon@edon.com
WEIT US @ www.edon.com

EDON



SHEET TITLE	CORNICE LAYOUT ELEVATIONS
PROJECT TITLE	CRYSTAL SPRING WATER TREATMENT PLANT
CLIENT	MID EASTERN BUILDERS, INC.

DWG NO.	REV. NO.
5205-1	