
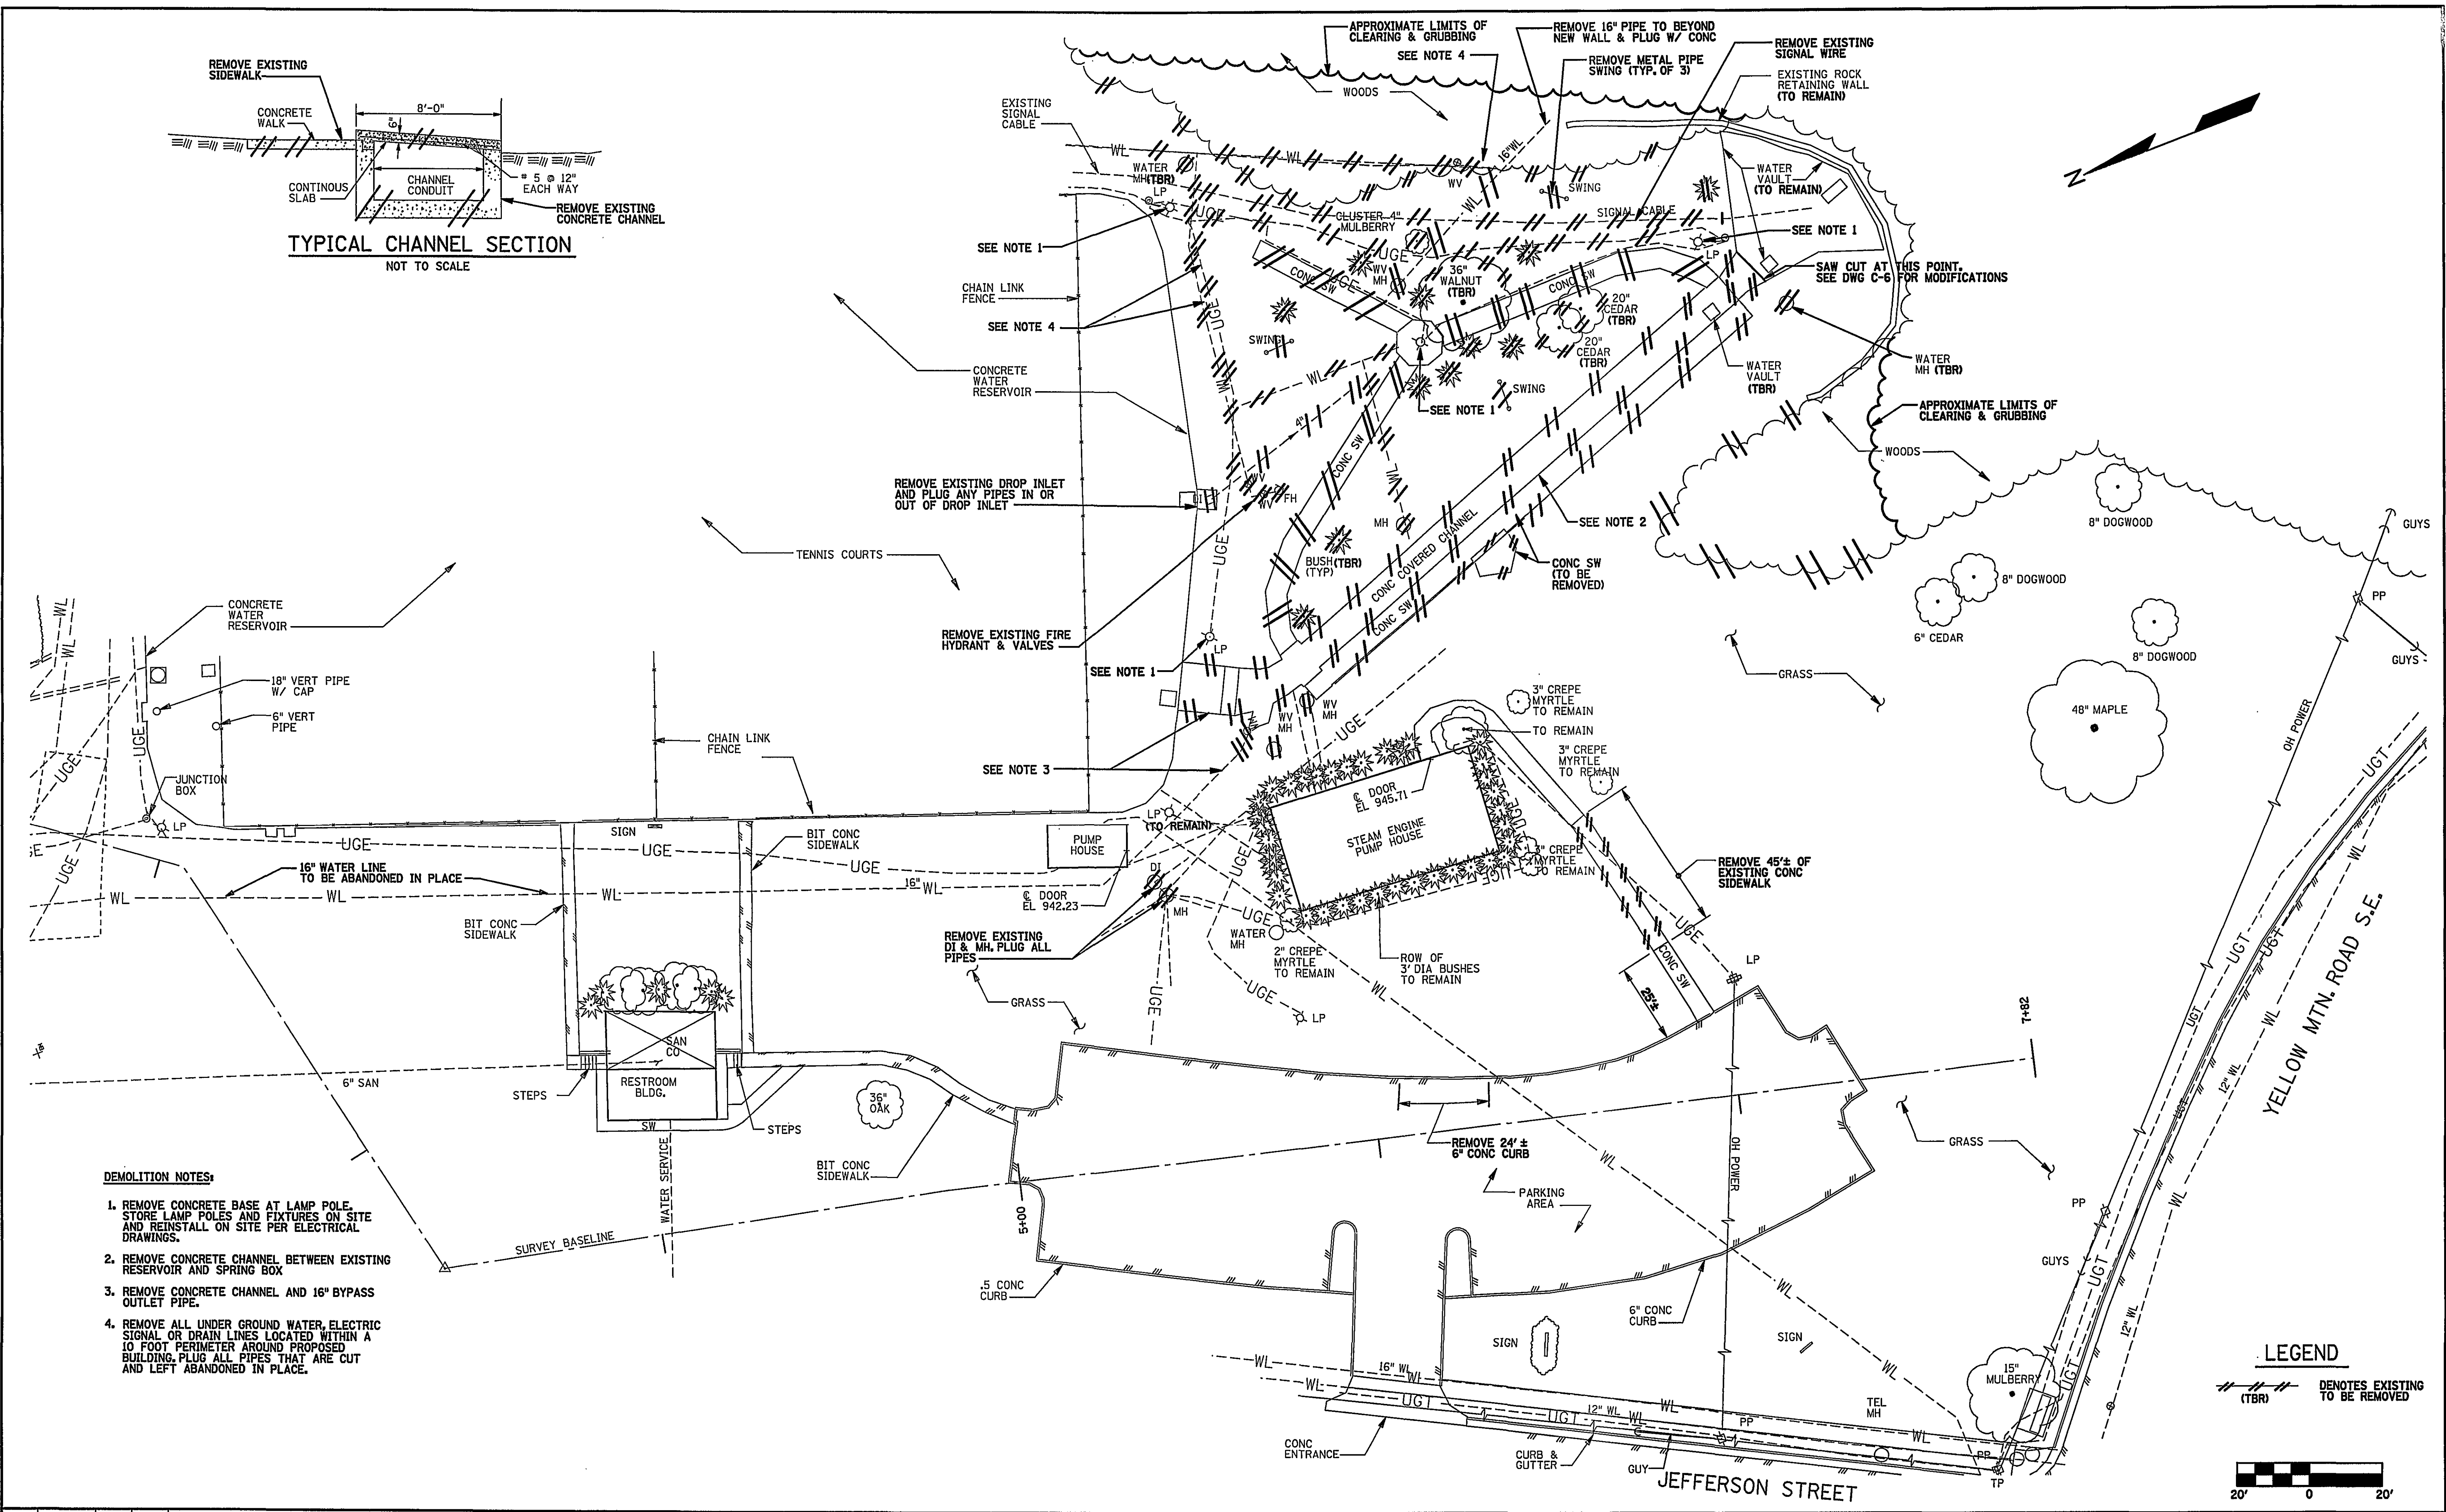


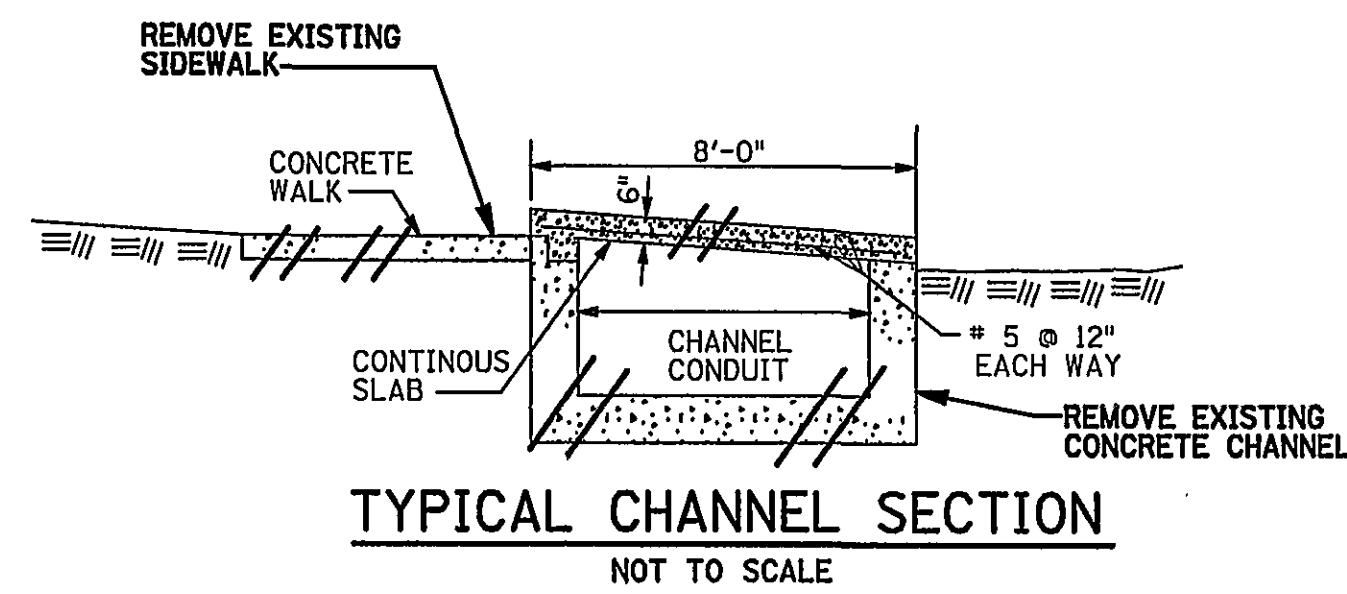

DEMOLITION NOTES:

1. REMOVE CONCRETE BASE AT LAMP POLE. STORE LAMP POLES AND FIXTURES ON SITE AND REINSTALL ON SITE PER ELECTRICAL DRAWINGS.
2. REMOVE CONCRETE CHANNEL BETWEEN EXISTING RESERVOIR AND SPRING BOX
3. REMOVE CONCRETE CHANNEL AND 16" BYPASS OUTLET PIPE.
4. REMOVE ALL UNDER GROUND WATER, ELECTRIC SIGNAL OR DRAIN LINES LOCATED WITHIN A 10 FOOT PERIMETER AROUND PROPOSED BUILDING. PLUG ALL PIPES THAT ARE CUT AND LEFT ABANDONED IN PLACE.

LEGEND

--- (TBR) --- DENOTES EXISTING TO BE REMOVED

20' 0 20'

REV.	DATE	BY	APP.	DESCRIPTION
5-01-03	JLW	MKJ		RECORD DRAWING

RECORD DRAWING

DATE: MAY 1, 2003

Wiley & Wilson
ARCHITECTS ENGINEERS PLANNERS
An Employee-Owned Company

2310 LANGHORNE ROAD
LYNCHBURG, VIRGINIA 24501
(804) 947-1901

P.O. BOX 877
LYNCHBURG, VIRGINIA 24505-0877

IN ASSOCIATION WITH

HDR
HDR Engineering, Inc.

5700 LAKE WRIGHT DRIVE
NORFOLK, VIRGINIA 23502
757-222-1500

DESIGNED JLW	DRAWN JLW	PROJECT CRYSTAL SPRING WATER TREATMENT PLANT FOR THE CITY OF ROANOKE, VIRGINIA
CHECKED CWB	REVIEWED MKJ	REFERENCE CIVIL
COMM. NO. 200171.01		TITLE SITE DEMOLITION PLAN
CADD NO. 200171C05.DGN		DWG. NO. D-1
DATE AUG 26, 2001		SHEET NO. 2 OF 72
		REV. 0