
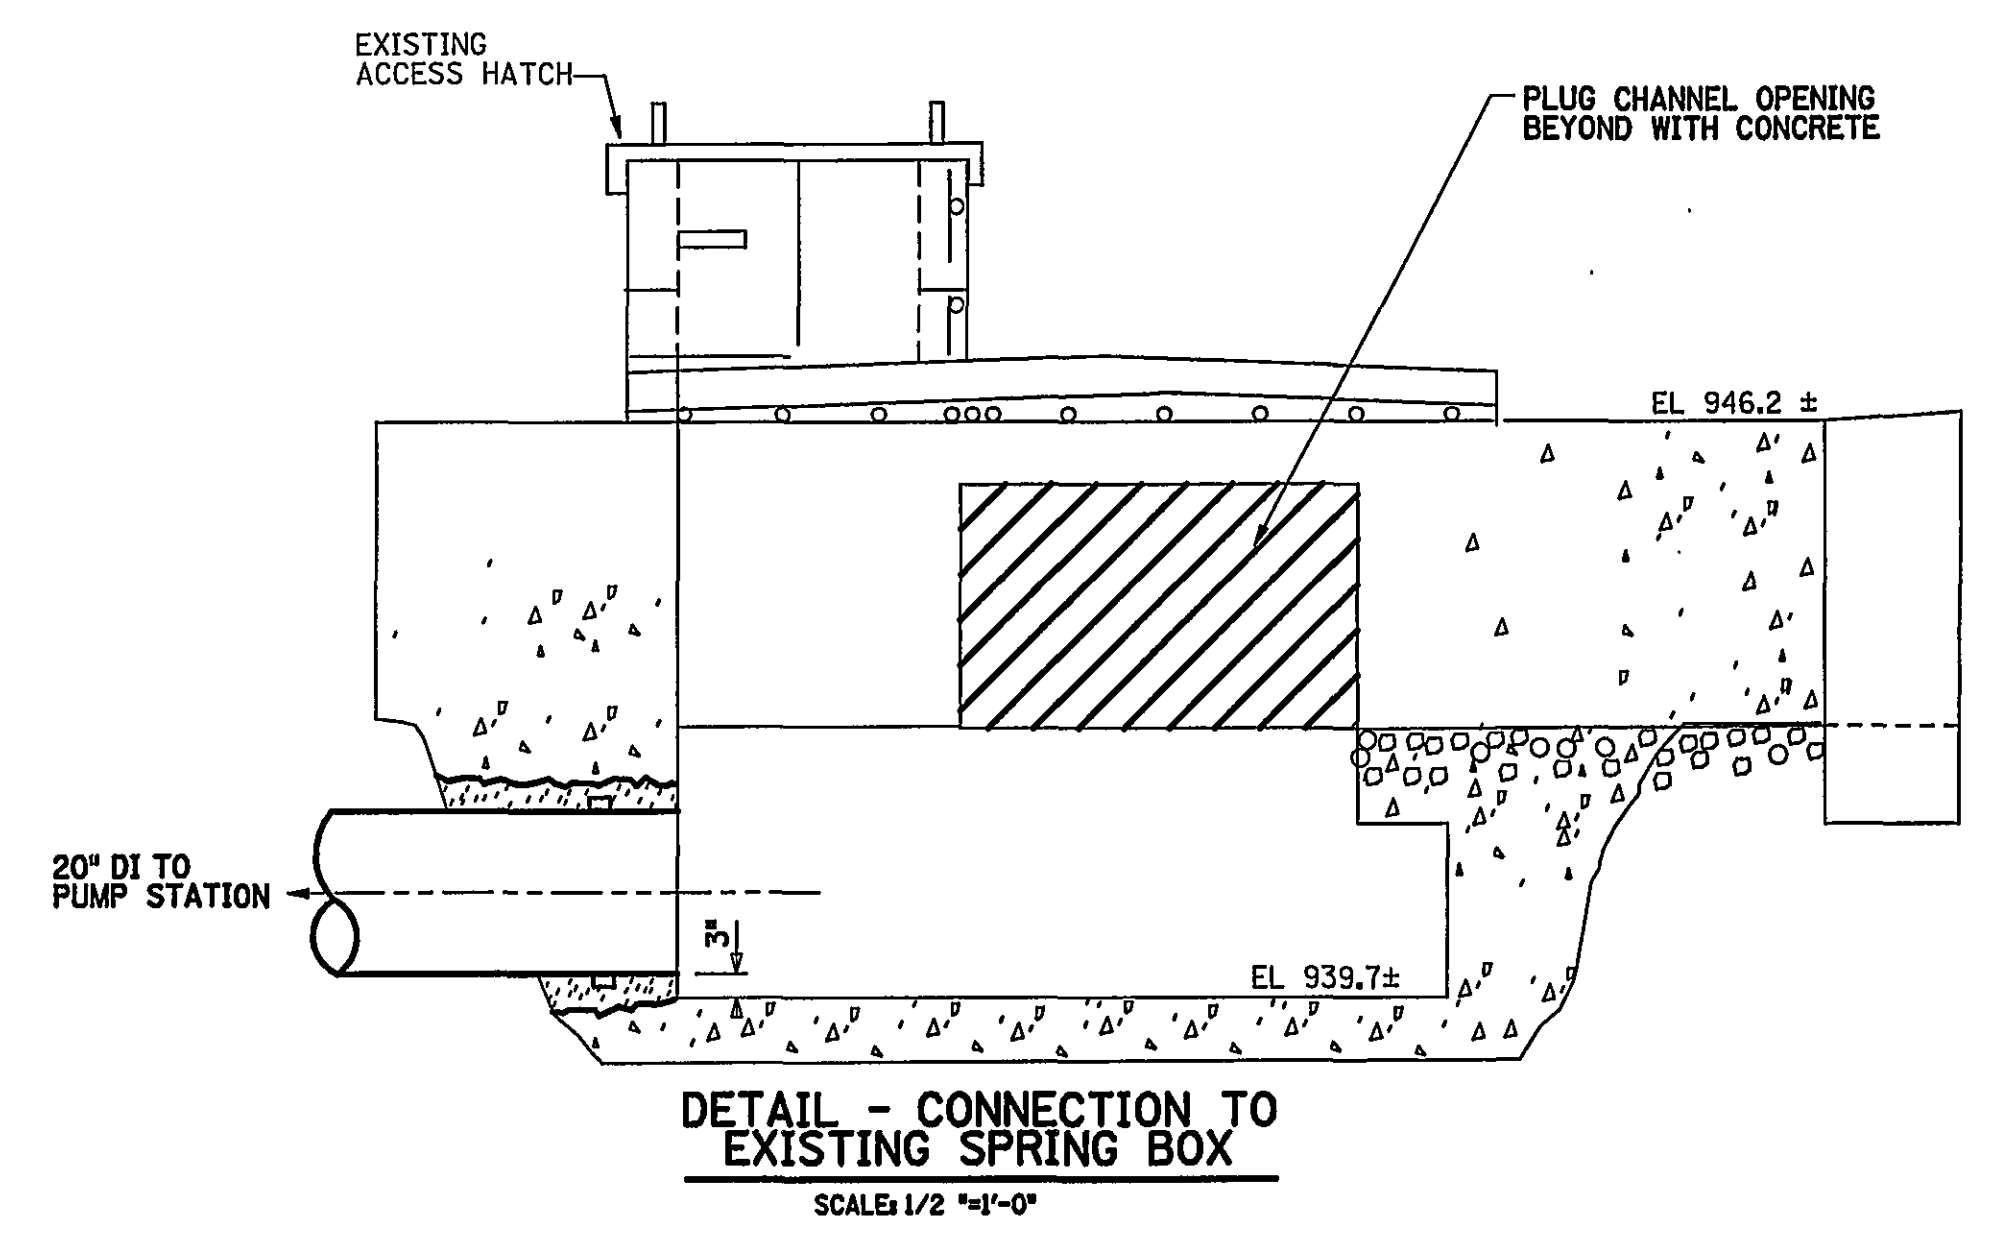
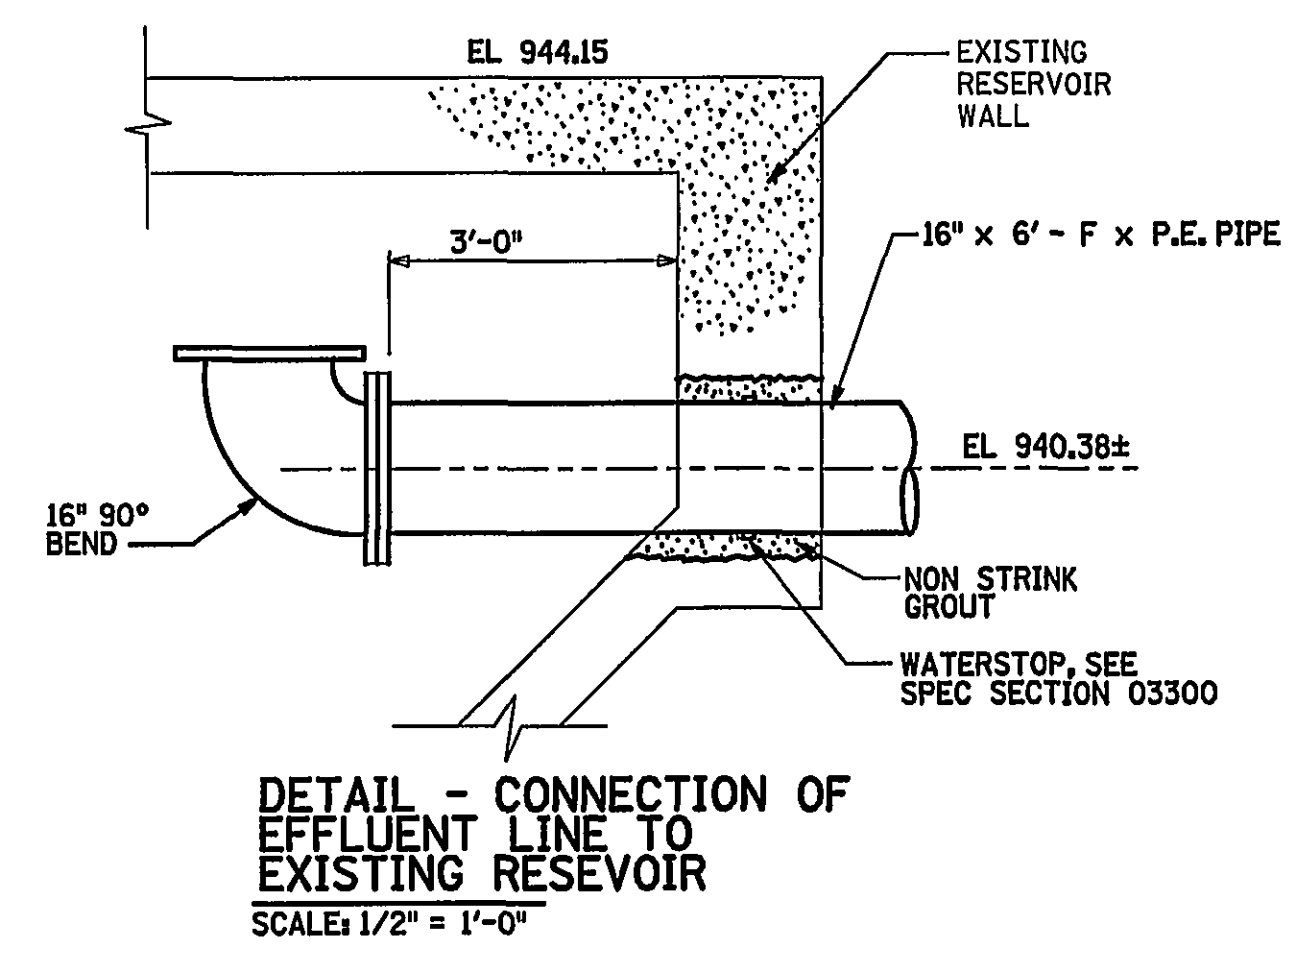
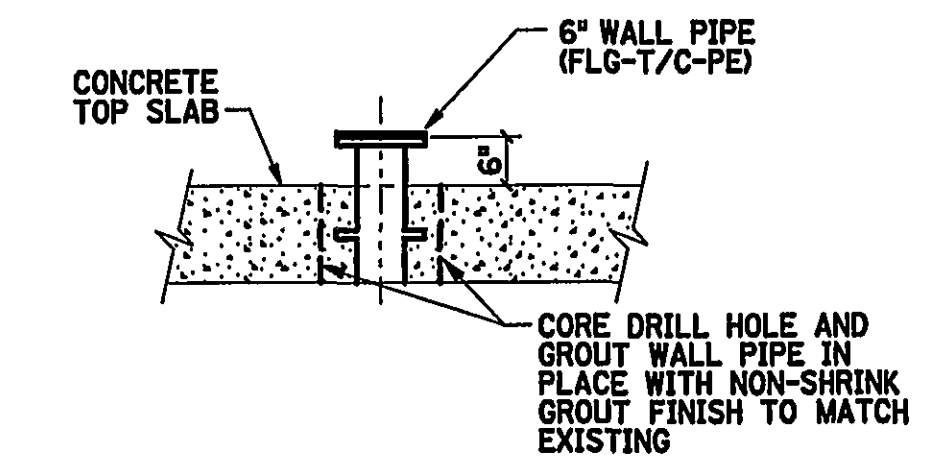
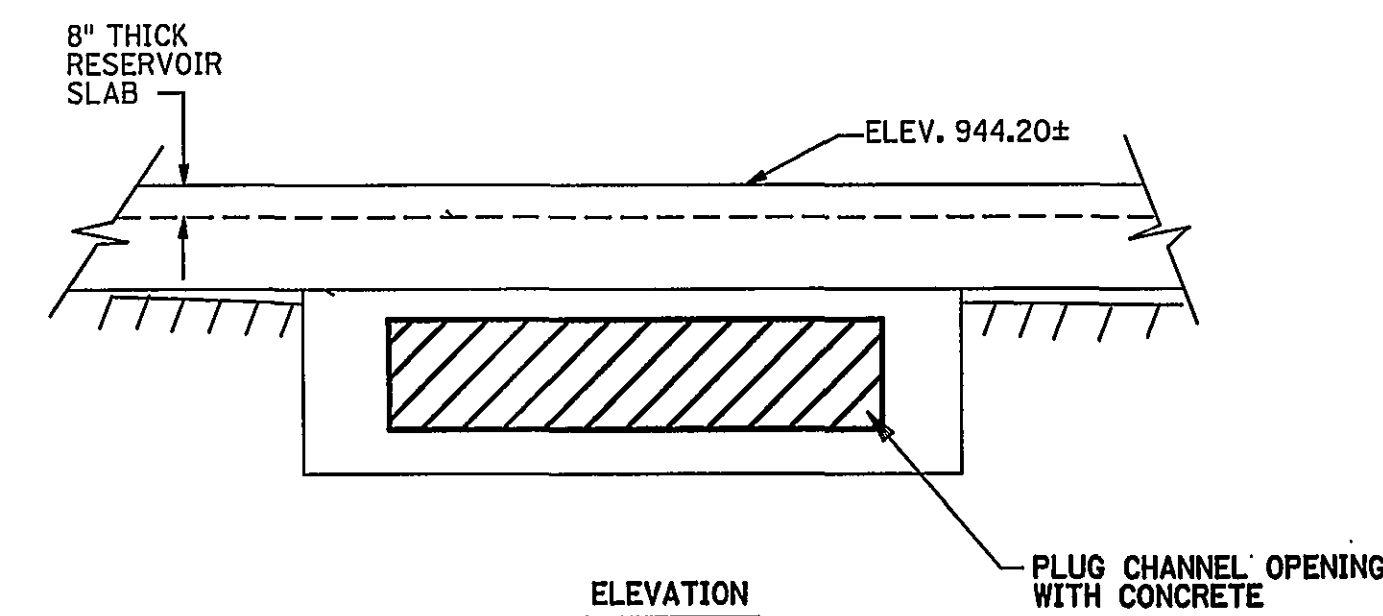
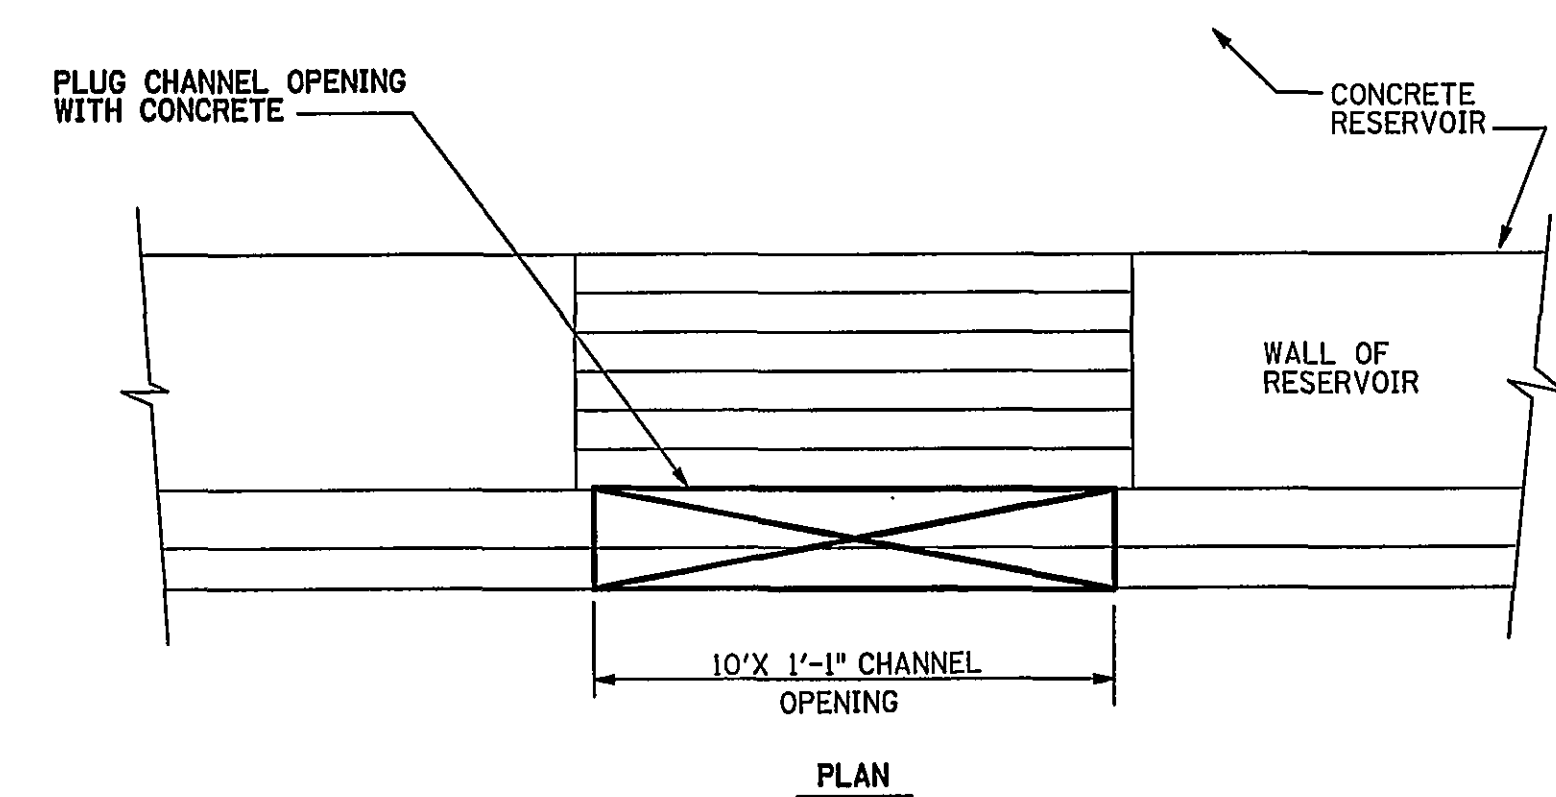


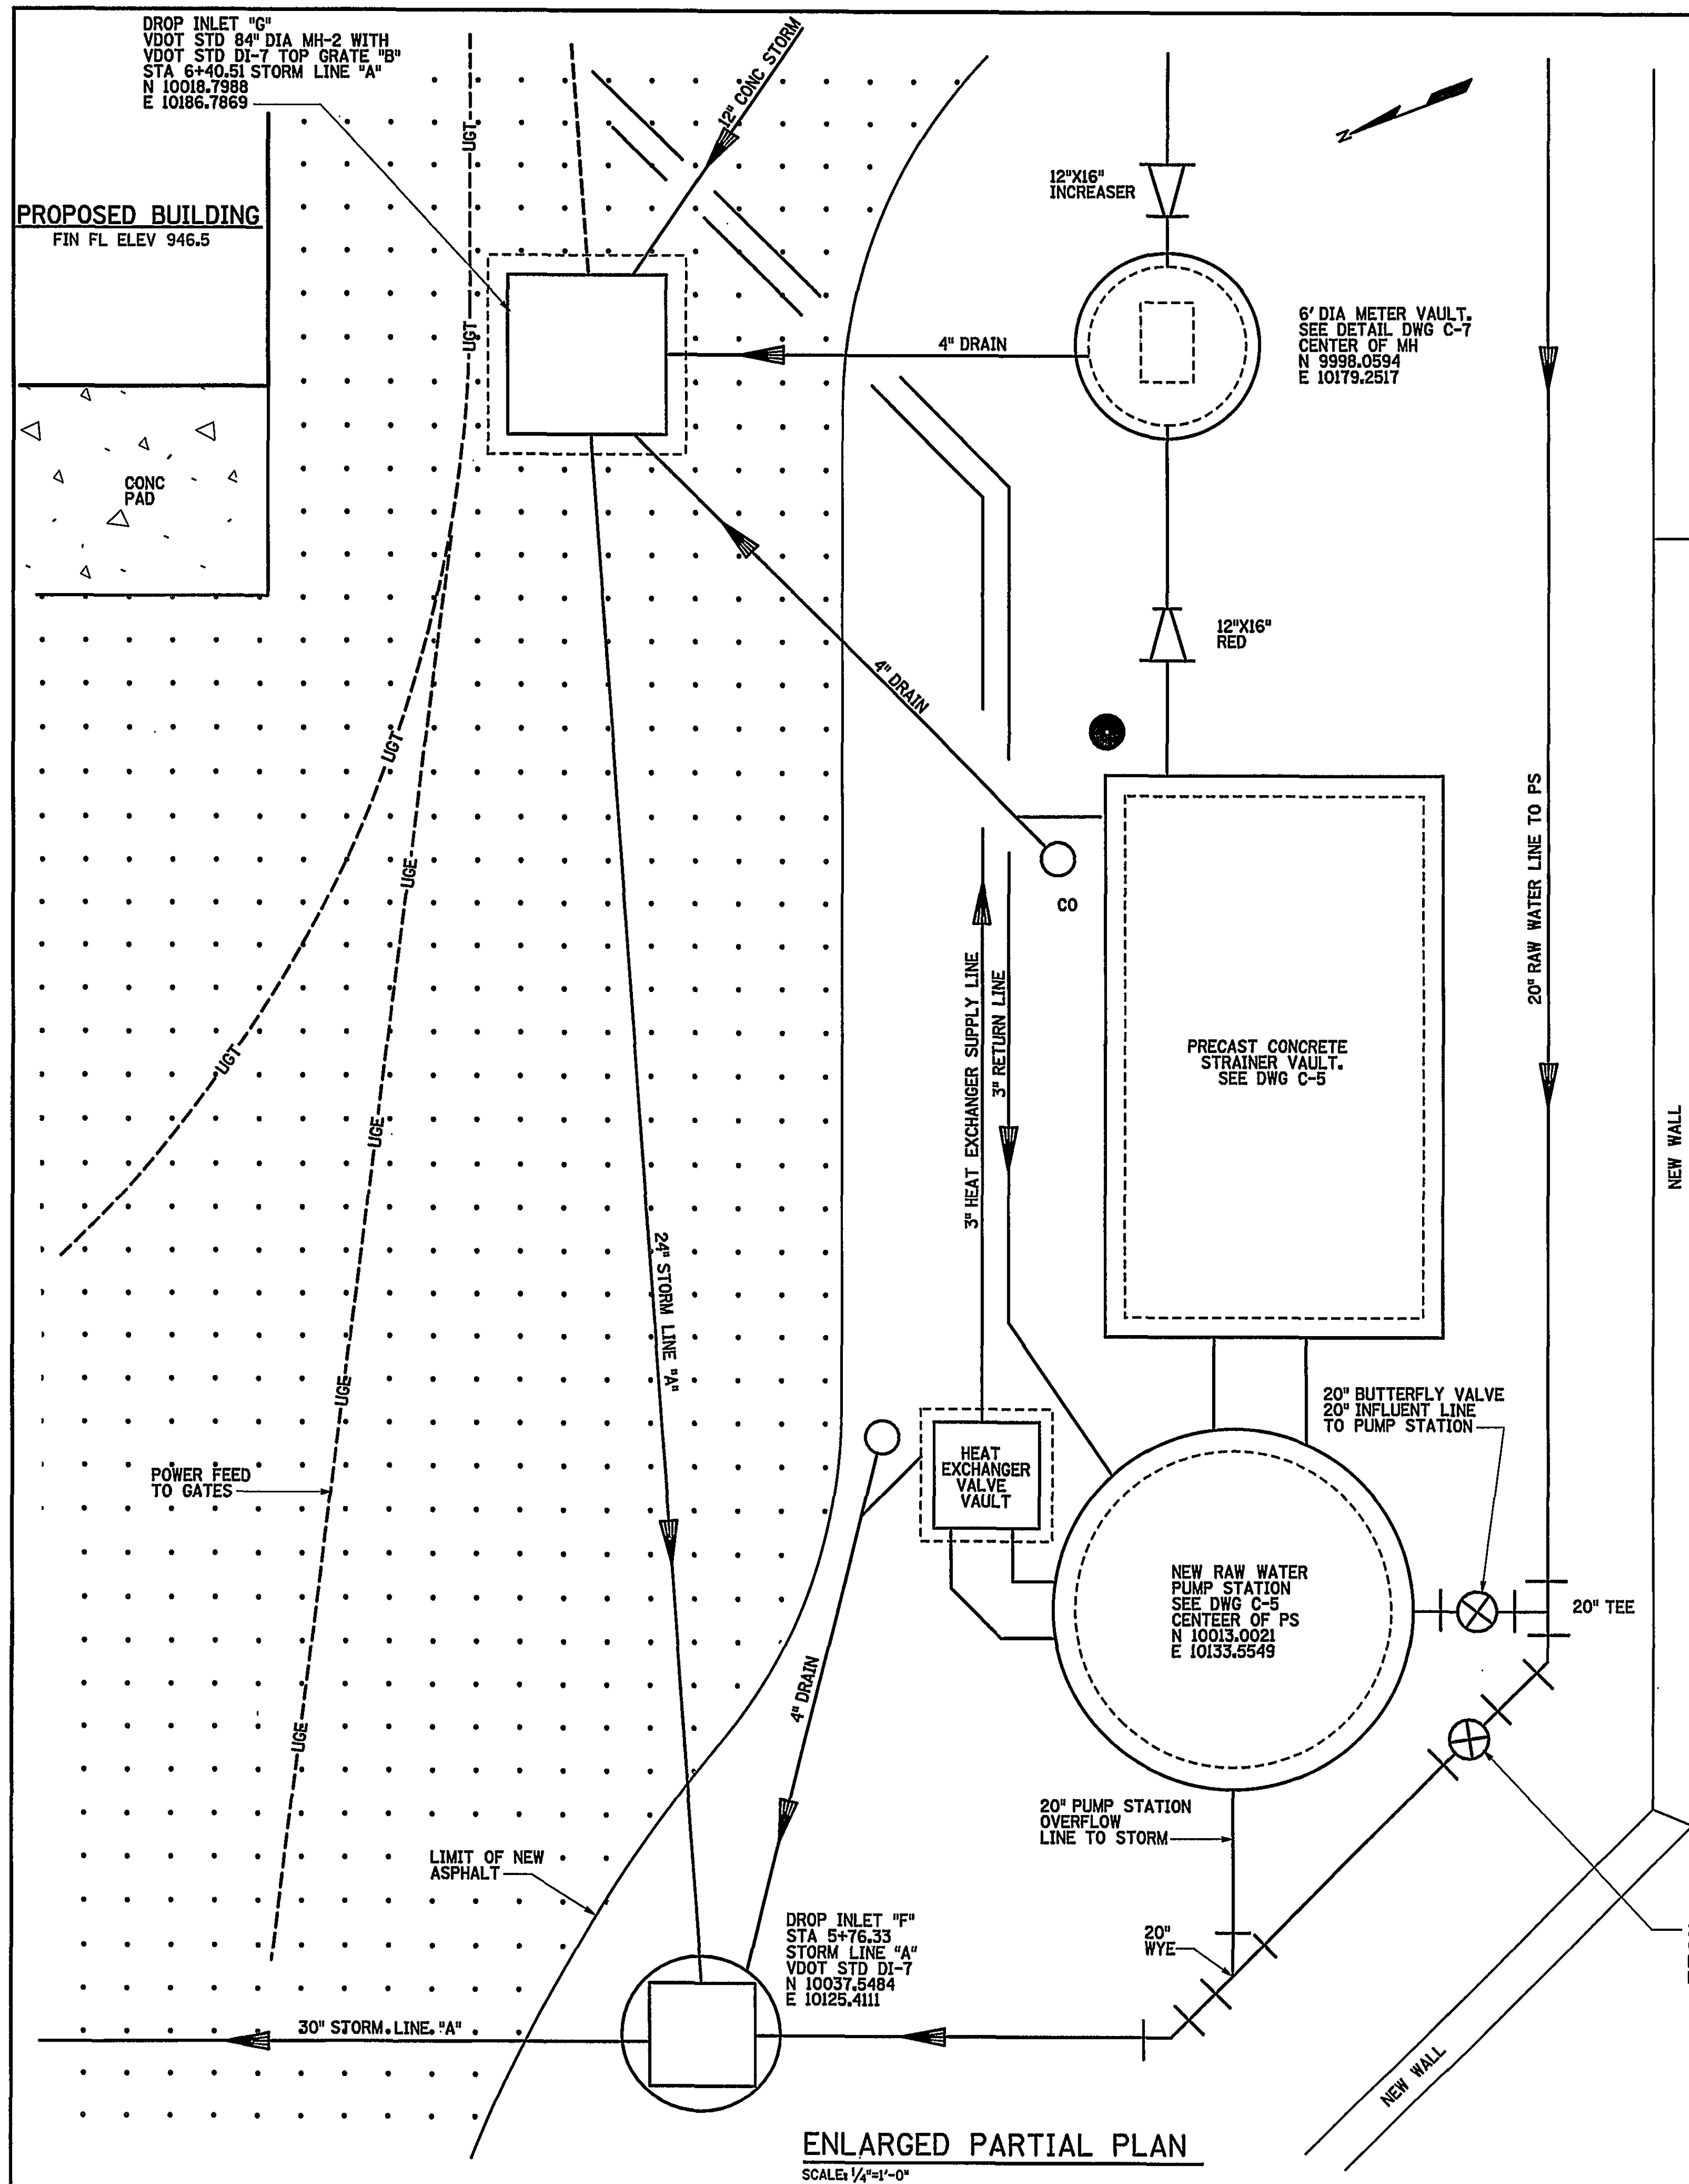

REV.	DATE	BY	APP.	DESCRIPTION
5-01-03	JLW	MKJ		RECORD DRAWING

RECORD DRAWING
DATE: MAY 1, 2003

Wiley & Wilson
ARCHITECTS ENGINEERS PLANNERS
An Employee-Owned Company
2310 LANGHORNE ROAD
LYNCHBURG, VIRGINIA 24501
(804) 947-1901

IN ASSOCIATION WITH
HDR
HDR Engineering, Inc.
5700 LAKE WRIGHT DRIVE
NORFOLK, VIRGINIA 23502
757-222-1500

DESIGNED	DRAWN	PROJECT
JLW	FTA	CRYSTAL SPRING WATER TREATMENT PLANT FOR THE CITY OF ROANOKE, VIRGINIA
CHECKED	REVIEWED	REFERENCE
MKJ		CIVIL
COMM. NO.	CADD NO.	TITLE
200171.01	200171C20.DGN	SPRING BOX AND RESERVOIR MODIFICATIONS
DATE	DWG. NO.	SHEET NO.
AUG 26, 2001	C-6	8 OF 72