



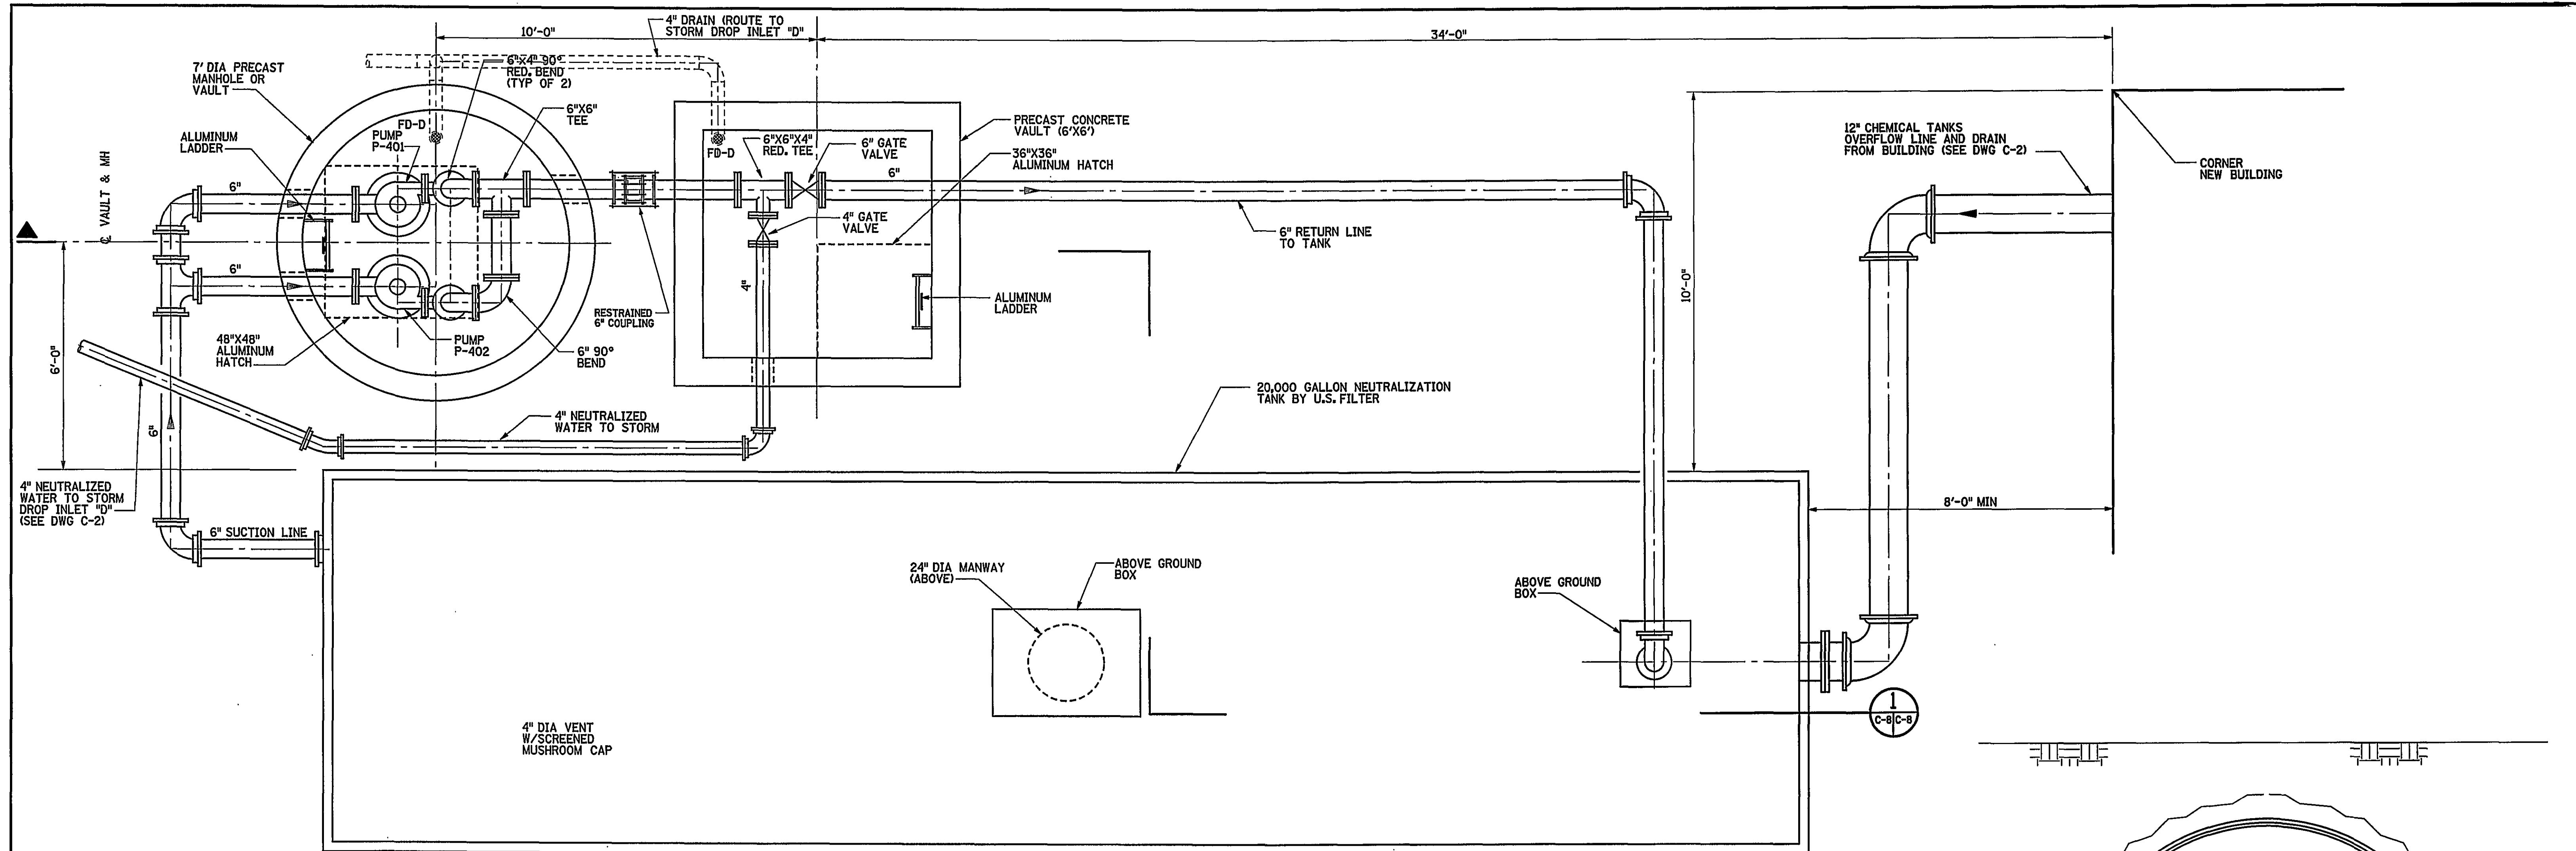

PLAN-NEUTRALIZATION TANK PUMP STATION AND VALVE VAULT

SCALE: 1/2" = 1'-0"

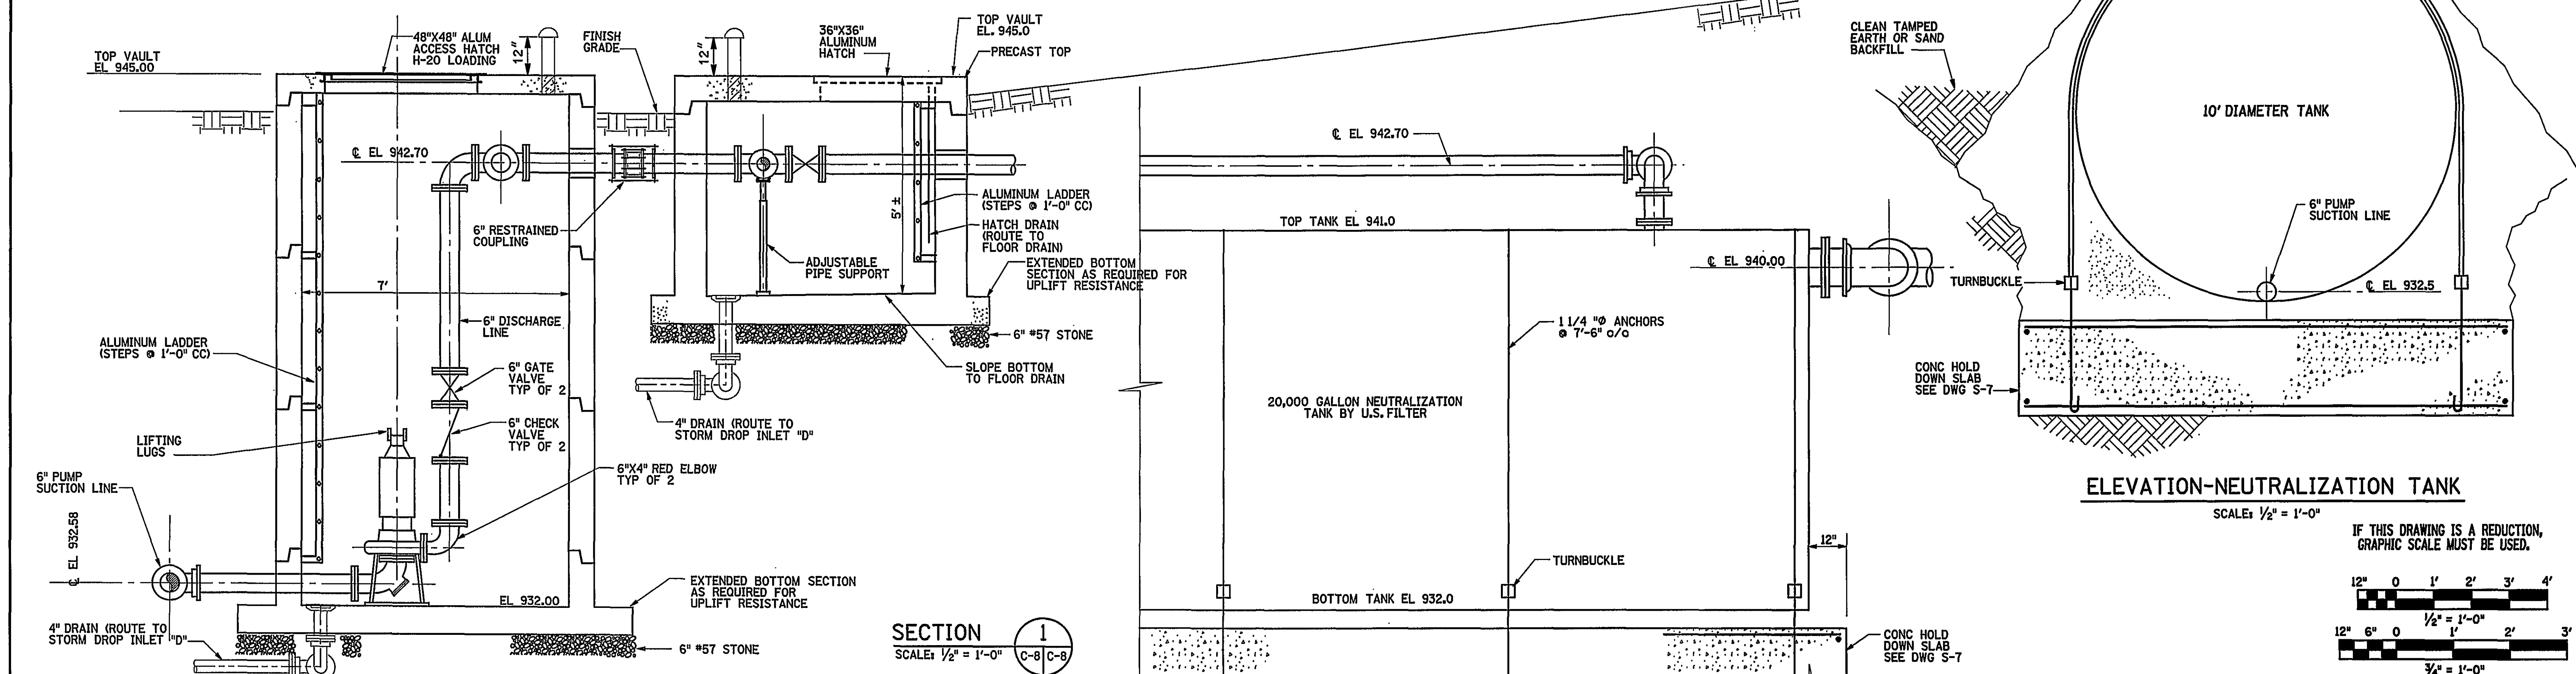


SECTION 1
SCALE: 1/2" = 1'-0"

ELEVATION-NEUTRALIZATION TANK

SCALE: 1/2" = 1'-0"

IF THIS DRAWING IS A REDUCTION,
GRAPHIC SCALE MUST BE USED.

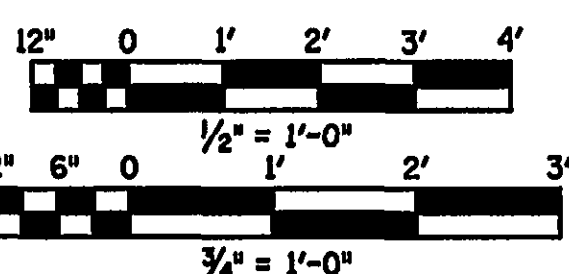

REV.	DATE	BY	APP.	DESCRIPTION
5-01-03	JLW	MKJ		RECORD DRAWING

RECORD DRAWING

DATE: MAY 1, 2003

Wiley & Wilson
ARCHITECTS ENGINEERS PLANNERS
An Employee-Owned Company

2310 LANGHORNE ROAD
LYNCHBURG, VIRGINIA 24501
(804) 947-1901

P.O. BOX 877
LYNCHBURG, VIRGINIA 24505-0877

HDR

HDR Engineering, Inc.
5700 LAKE WRIGHT DRIVE
NORFOLK, VIRGINIA 23502
757-222-1500

IN ASSOCIATION WITH

DESIGNED	DRAWN	PROJECT
MKJ	JLW	CRYSTAL SPRING WATER TREATMENT PLANT FOR THE CITY OF ROANOKE, VIRGINIA
CHECKED	REVIEWED	REFERENCE
MKJ		CIVIL
CONC. NO.	CADD NO.	TITLE
200171.01	200171C10.DGN	NEUTRALIZATION TANK AND PUMP STATION
DATE	DWG. NO.	SHEET NO.
AUG 26, 2001	C-8	10 OF 72
		REV. 0