




		ROOM FINISH SCHEDULE																REMARKS								
		FLOOR				BASE		WALLS		CEILING				MISCELLANEOUS												
SPACE NO.	SPACE TITLE	CONCRETE	VINYL COMPOSITION TILE	CARPET	CERAMIC TILE	RUBBER TREAD AND NOSING	WOOD	RUBBER	CERAMIC TILE	NONE	CMU PAINTED	GYPSUM WALLBOARD PAINTED	CERAMIC TILE WAINSCOT 4'-0" H.	METAL DECK PAINTED	PRECAST CONCRETE PLANKS	2" X 4" ACOUSTICAL TILE	GWB UNDER TREADS AND LANDINGS		HEIGHT	PAINT CMU	PAINT GYPSUM BOARD	PAINT W/L DECK AND STRUC STL	PAINT STAIRS	PAINT DOORS AND FRAMES	STAIN WOOD BASE	PAINT PRECAST CONCRETE PLANKS
101	EQUIPMENT ROOM	●									●			●					VARIES	●	●	●	●			
102	AIR COMPRESSOR ROOM	●									●				●				11'-4"	●		●	●	●	●	
103	FLOR	●									●				●				11'-4"	●		●	●	●	●	
104	CHLOR	●									●				●				11'-4"	●		●	●	●	●	
105	CONTROL ROOM	●		●				●			●				●				9'-4"	●		●	●	●	●	●
106	SECRETARY			●				●			●				●				9'-4"	●	●	●	●	●	●	
107	DIRECTOR			●				●			●				●				9'-4"	●	●	●	●	●	●	
108	OPEN AREA			●				●			●				●				9'-4"	●	●	●	●	●	●	
109	TOILET			●		●		●			●				●				9'-4"	●	●	●	●	●	●	
110	TOILET			●		●		●			●				●				9'-4"	●	●	●	●	●	●	
111	KITCHEN		●					●			●				●				9'-4"	●		●	●	●	●	
112	CONFERENCE ROOM			●				●			●				●				9'-4"	●		●	●	●	●	
113	ASSISTANT			●				●			●				●				9'-4"	●		●	●	●	●	
114	CORRIDOR		●					●			●				●				9'-4"	●		●	●	●	●	
115	STORAGE		●					●			●				●				VARIES	●	●	●	●	●	●	
116	TOILET	●						●			●				●				11'-4"	●		●	●	●	●	●
117	CLOSET			●				●			●				●				9'-4"	●	●	●	●	●	●	
118	BREAK ROOM		●					●			●				●				9'-4"	●		●	●	●	●	
119	STAIR		●			●		●			●				●				9'-4"	●		●	●	●	●	
120	OFFICE			●				●			●				●				9'-4"	●		●	●	●	●	
121	OFFICE			●				●			●				●				9'-4"	●		●	●	●	●	
122	CORRIDOR		●					●			●				●				9'-4"	●		●	●	●	●	
201	FILES/SUPPLIES		●					●			●				●				8'-0"	●		●	●	●	●	
202	DIRECTOR			●				●			●				●				8'-8"	●		●	●	●	●	
203	SECRETARY			●				●			●				●				8'-8"	●		●	●	●	●	
204	OFFICE			●				●			●				●				8'-8"	●		●	●	●	●	
205	CORRIDOR			●				●			●				●				8'-8"	●		●	●	●	●	
206	COPY			●				●			●				●				8'-8"	●		●	●	●	●	
207	TOILET			●				●			●				●				8'-8"	●		●	●	●	●	
208	TOILET			●				●			●				●				8'-8"	●		●	●	●	●	
209	CLOSET			●				●			●				●				8'-8"	●		●	●	●	●	
210	OFFICE			●				●			●				●				8'-8"	●		●	●	●	●	
211	OFFICE			●				●			●				●				8'-8"	●		●	●	●	●	
212	STAIR			●				●			●				●				8'-0"	●		●	●	●	●	

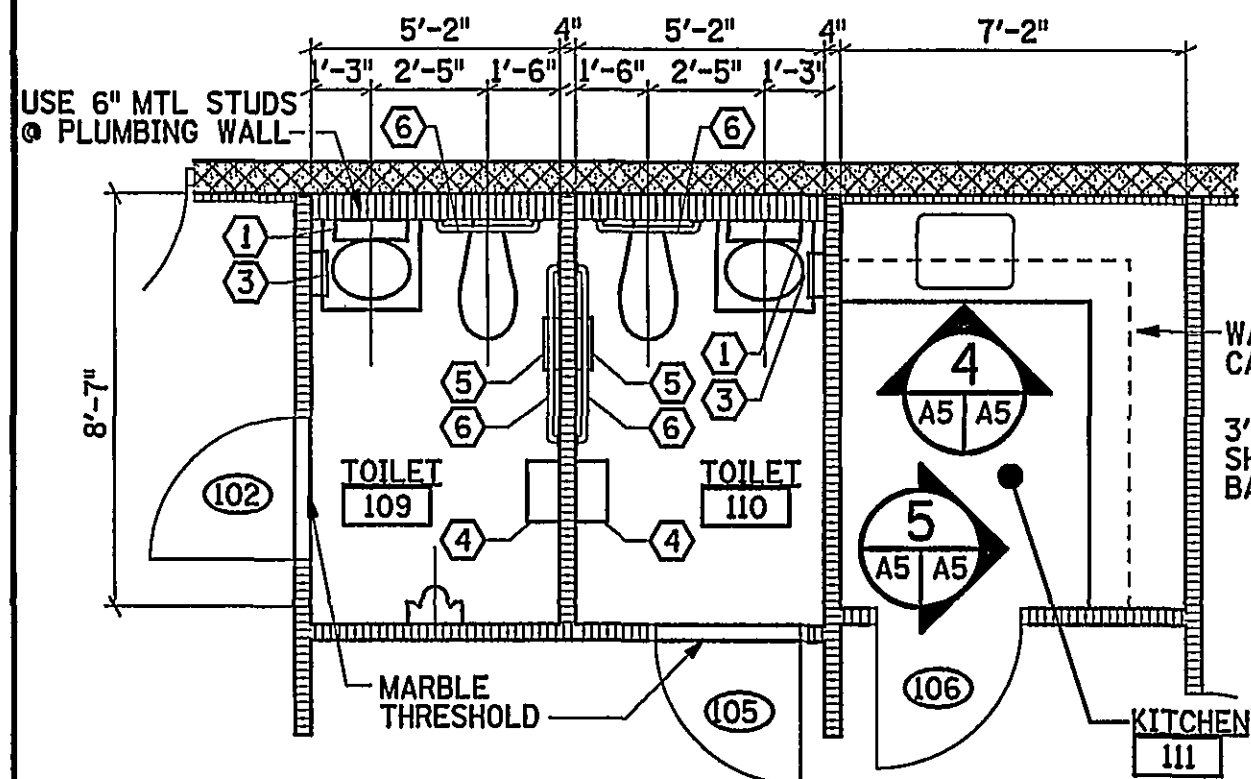

TOILET ROOM LAYOUTS 109, 110
SCALE: 1/4" = 1'-0"

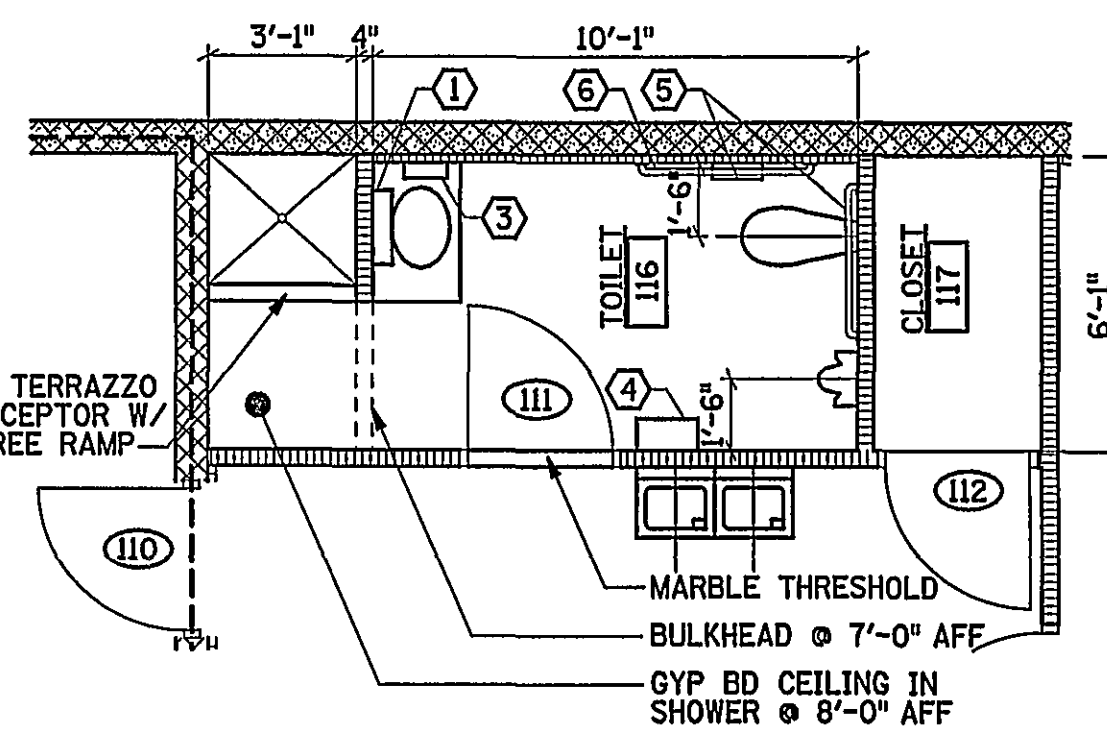





TOILET ROOM LAYOUT 116
SCALE: 1/4" = 1'-0"

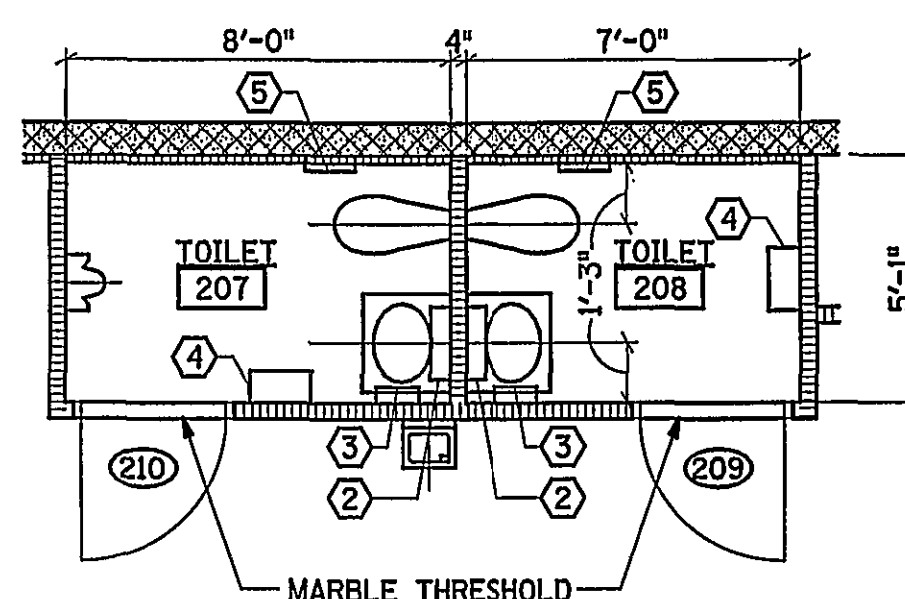

TOILET ROOM LAYOUTS 207, 208
SCALE: 1/4" = 1'-0"


TOILET ACCESSORIES SCHEDULE

- H/C 18" X 36" MIRROR
MOUNTING HEIGHT= 3'-4" TO BOTTOM
- 18" X 36" MIRROR
MOUNTING HEIGHT= 3'-4" TO BOTTOM
- PAPER TOWEL DISPENSER
MOUNTING HEIGHT= 44" TO BOTTOM OF UNIT
- WASTE RECEPTOR
MOUNTING HEIGHT= 16" FROM BOTTOM SURFACE TO F.F.
- TOILET TISSUE DISPENSER
MOUNTING HEIGHT= 19"
- GRAB BAR
MOUNTING HEIGHT= 36"

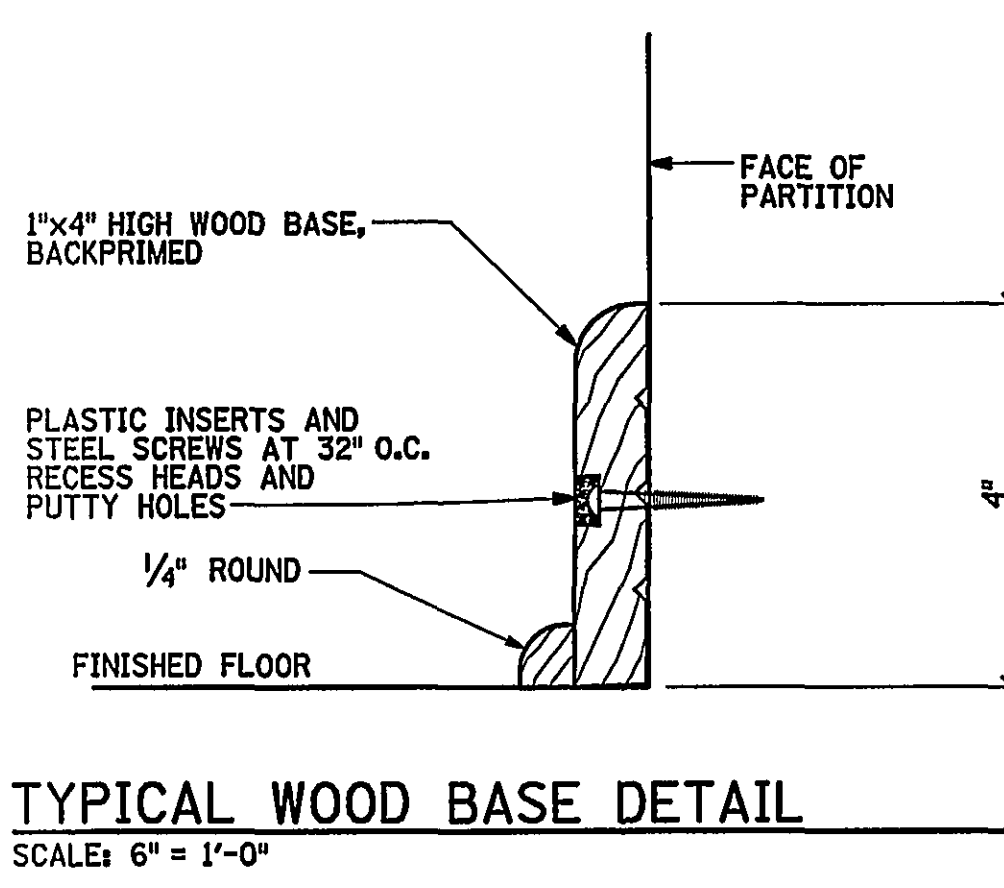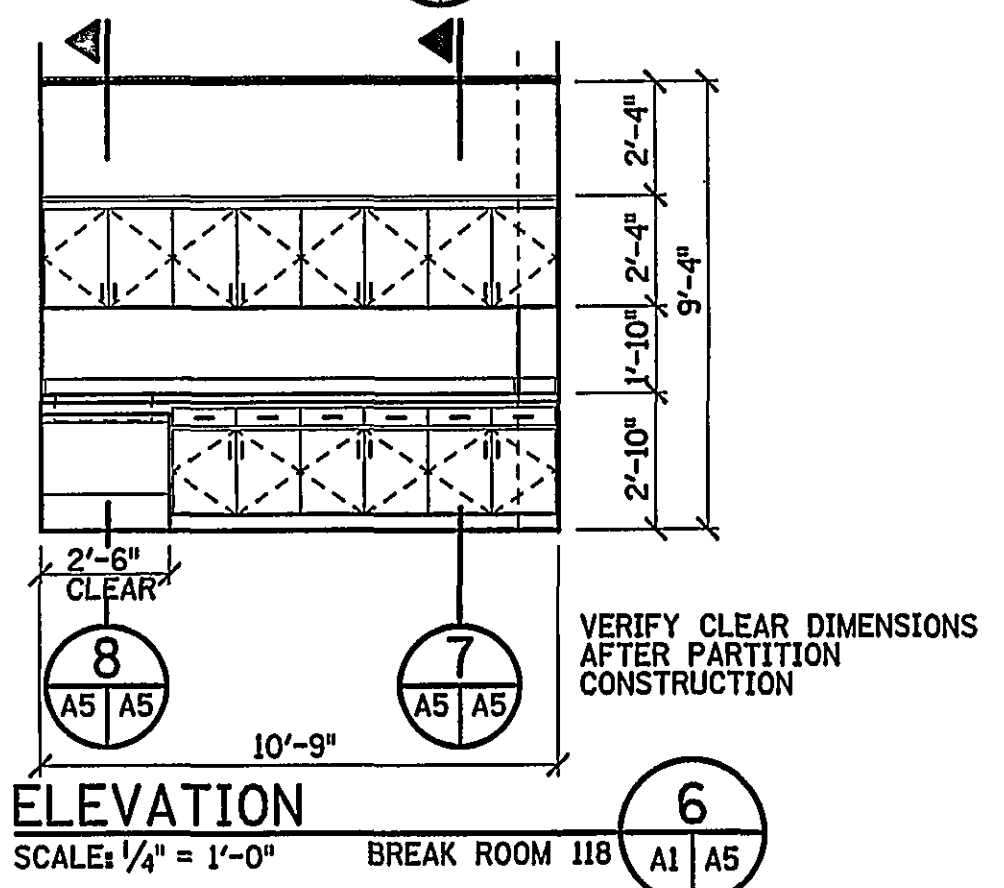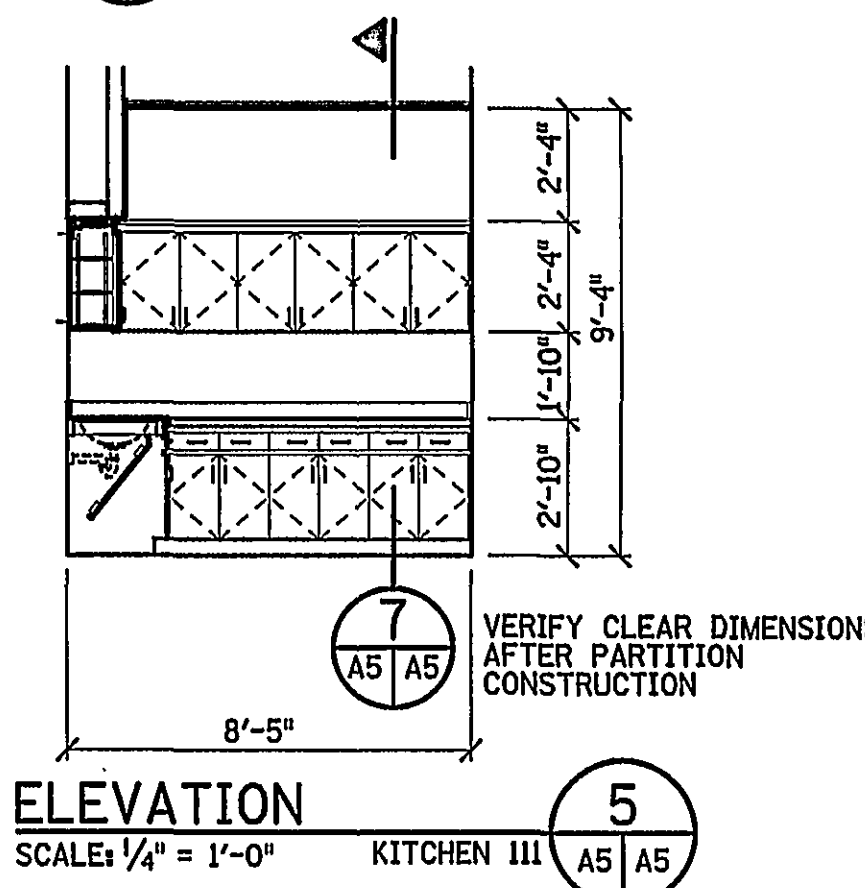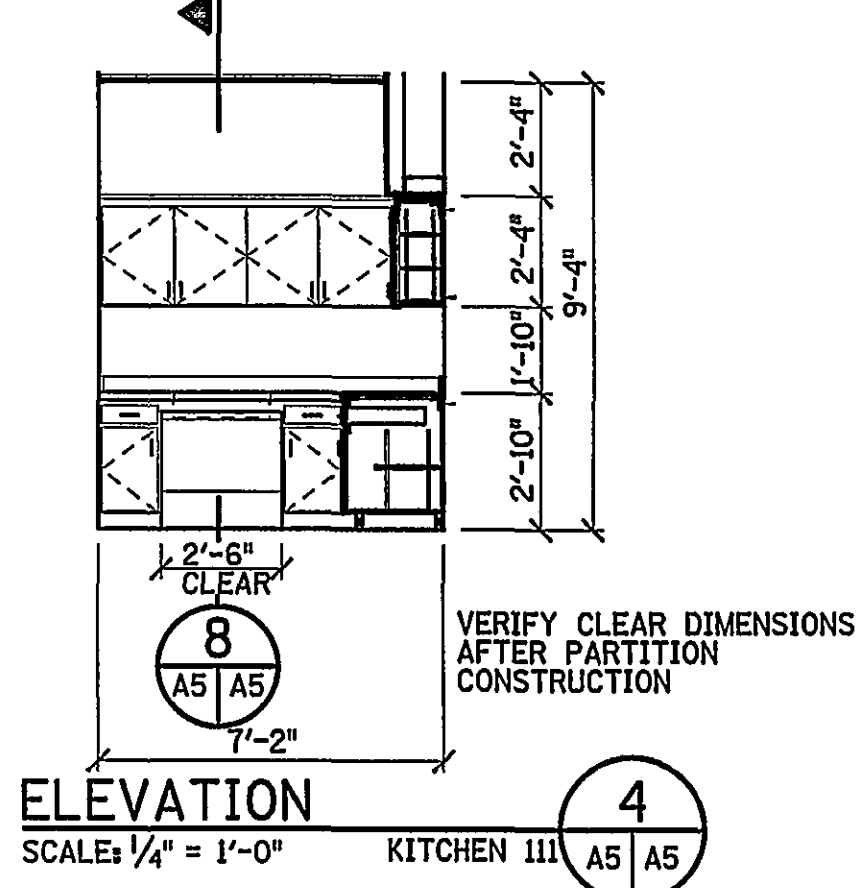

SECTION 7
SCALE: 1/2" = 1'-0"

SECTION 8
SCALE: 1/2" = 1'-0"

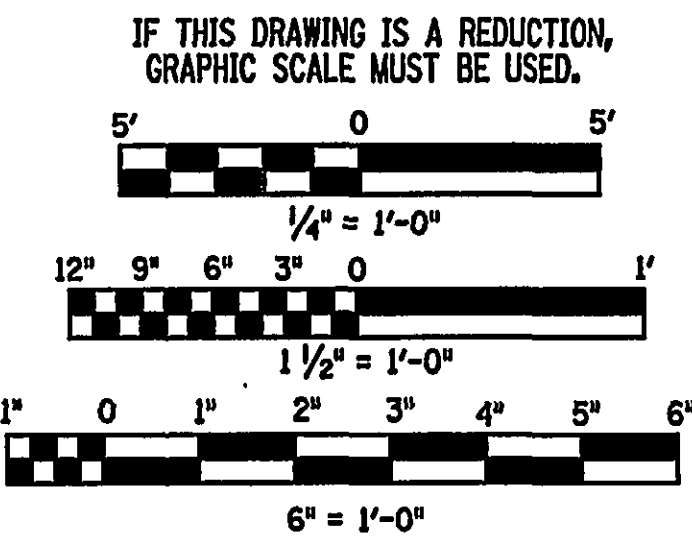

REV.	DATE	BY	APP.	DESCRIPTION
5-01-03	JLW	MKJ		RECORD DRAWING

RECORD DRAWING
DATE: MAY 1, 2003

Wiley & Wilson
ARCHITECTS ENGINEERS PLANNERS
An Employee-Owned Company
2310 LANGHORNE ROAD
LYNCHBURG, VIRGINIA 24501
(804) 947-1901
P.O. BOX 877
LYNCHBURG, VIRGINIA 24505-0877

IN ASSOCIATION WITH
HDR
HDR Engineering, Inc.
5700 LAKE WRIGHT DRIVE
NORFOLK, VIRGINIA 23502
757-222-1500

DESIGNED JRM	DRAWN E.JLB	PROJECT CRYSTAL SPRING WATER TREATMENT PLANT FOR THE CITY OF ROANOKE, VIRGINIA
CHECKED MKJ	REVIEWED	REFERENCE ARCHITECTURAL
COMM. NO. 200171.01		TITLE FINISH SCHEDULE
CADD NO. 200171AT.DGN		DWG. NO. A-5
DATE AUG 26, 2001		SHEET NO. 16 OF 72
		REV. 0