



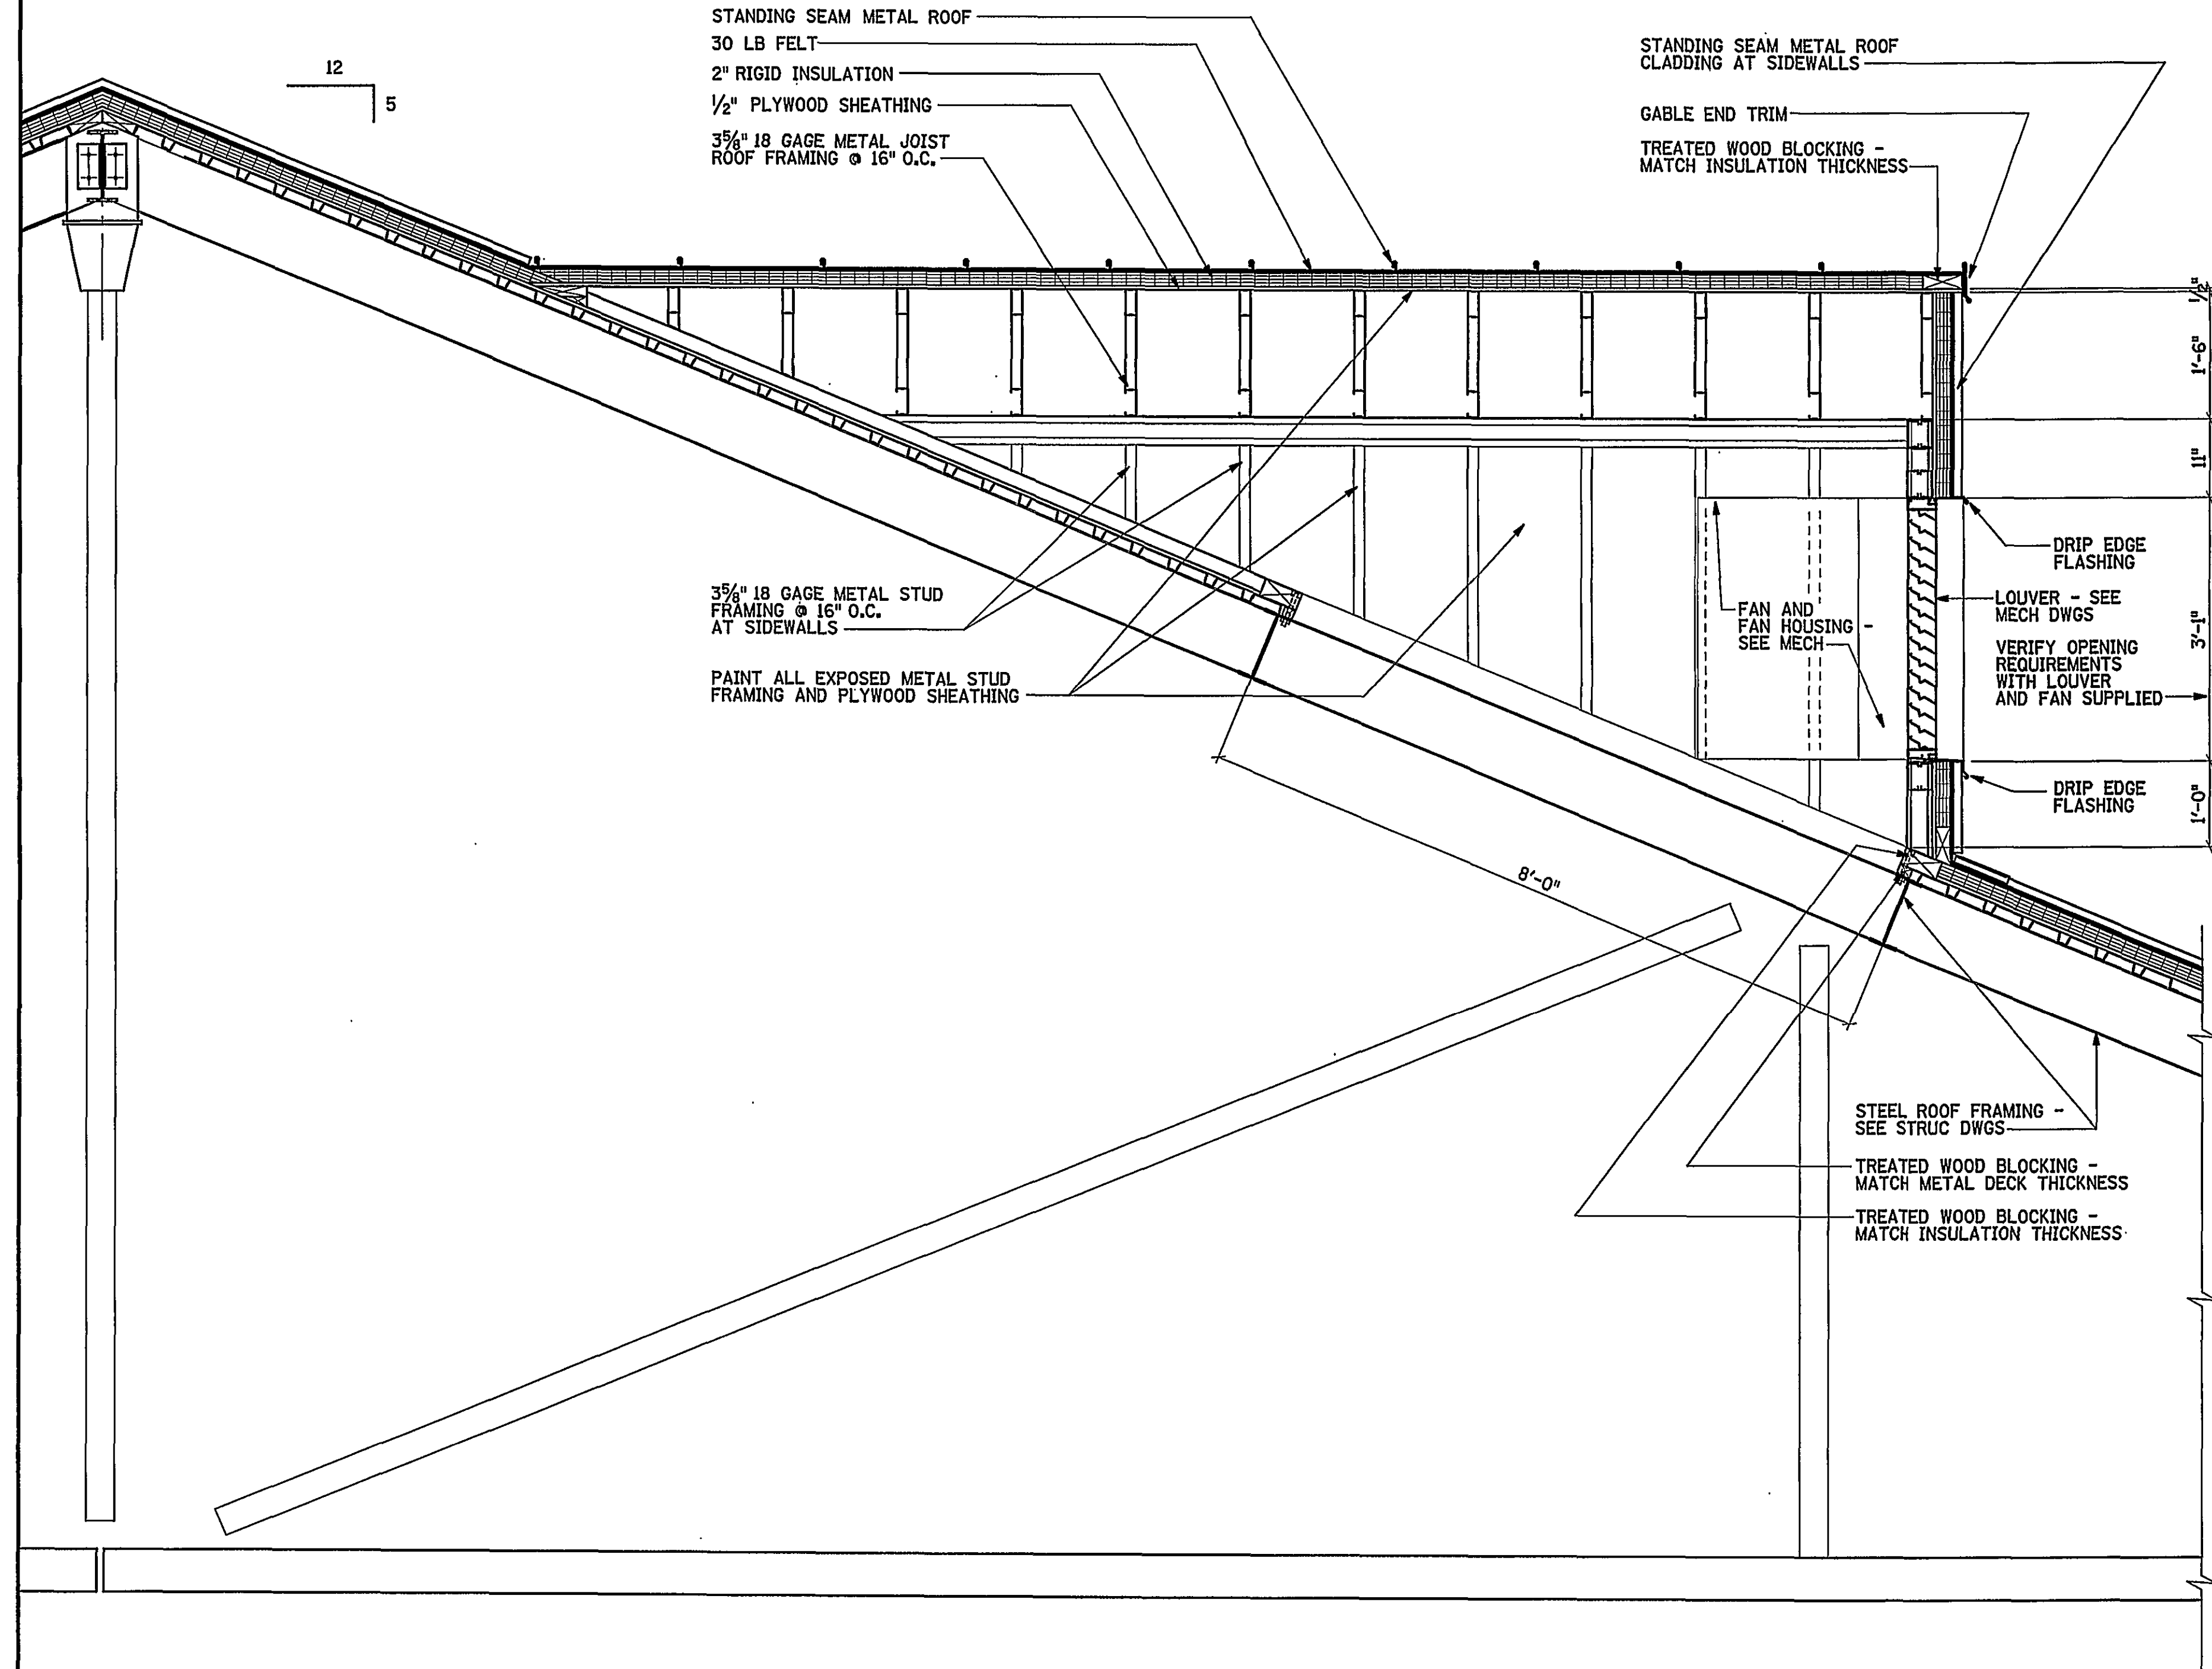


ROOF DORMER/LOUVER SECTION
SCALE: 3/4" = 1'-0"

5
A1, A3

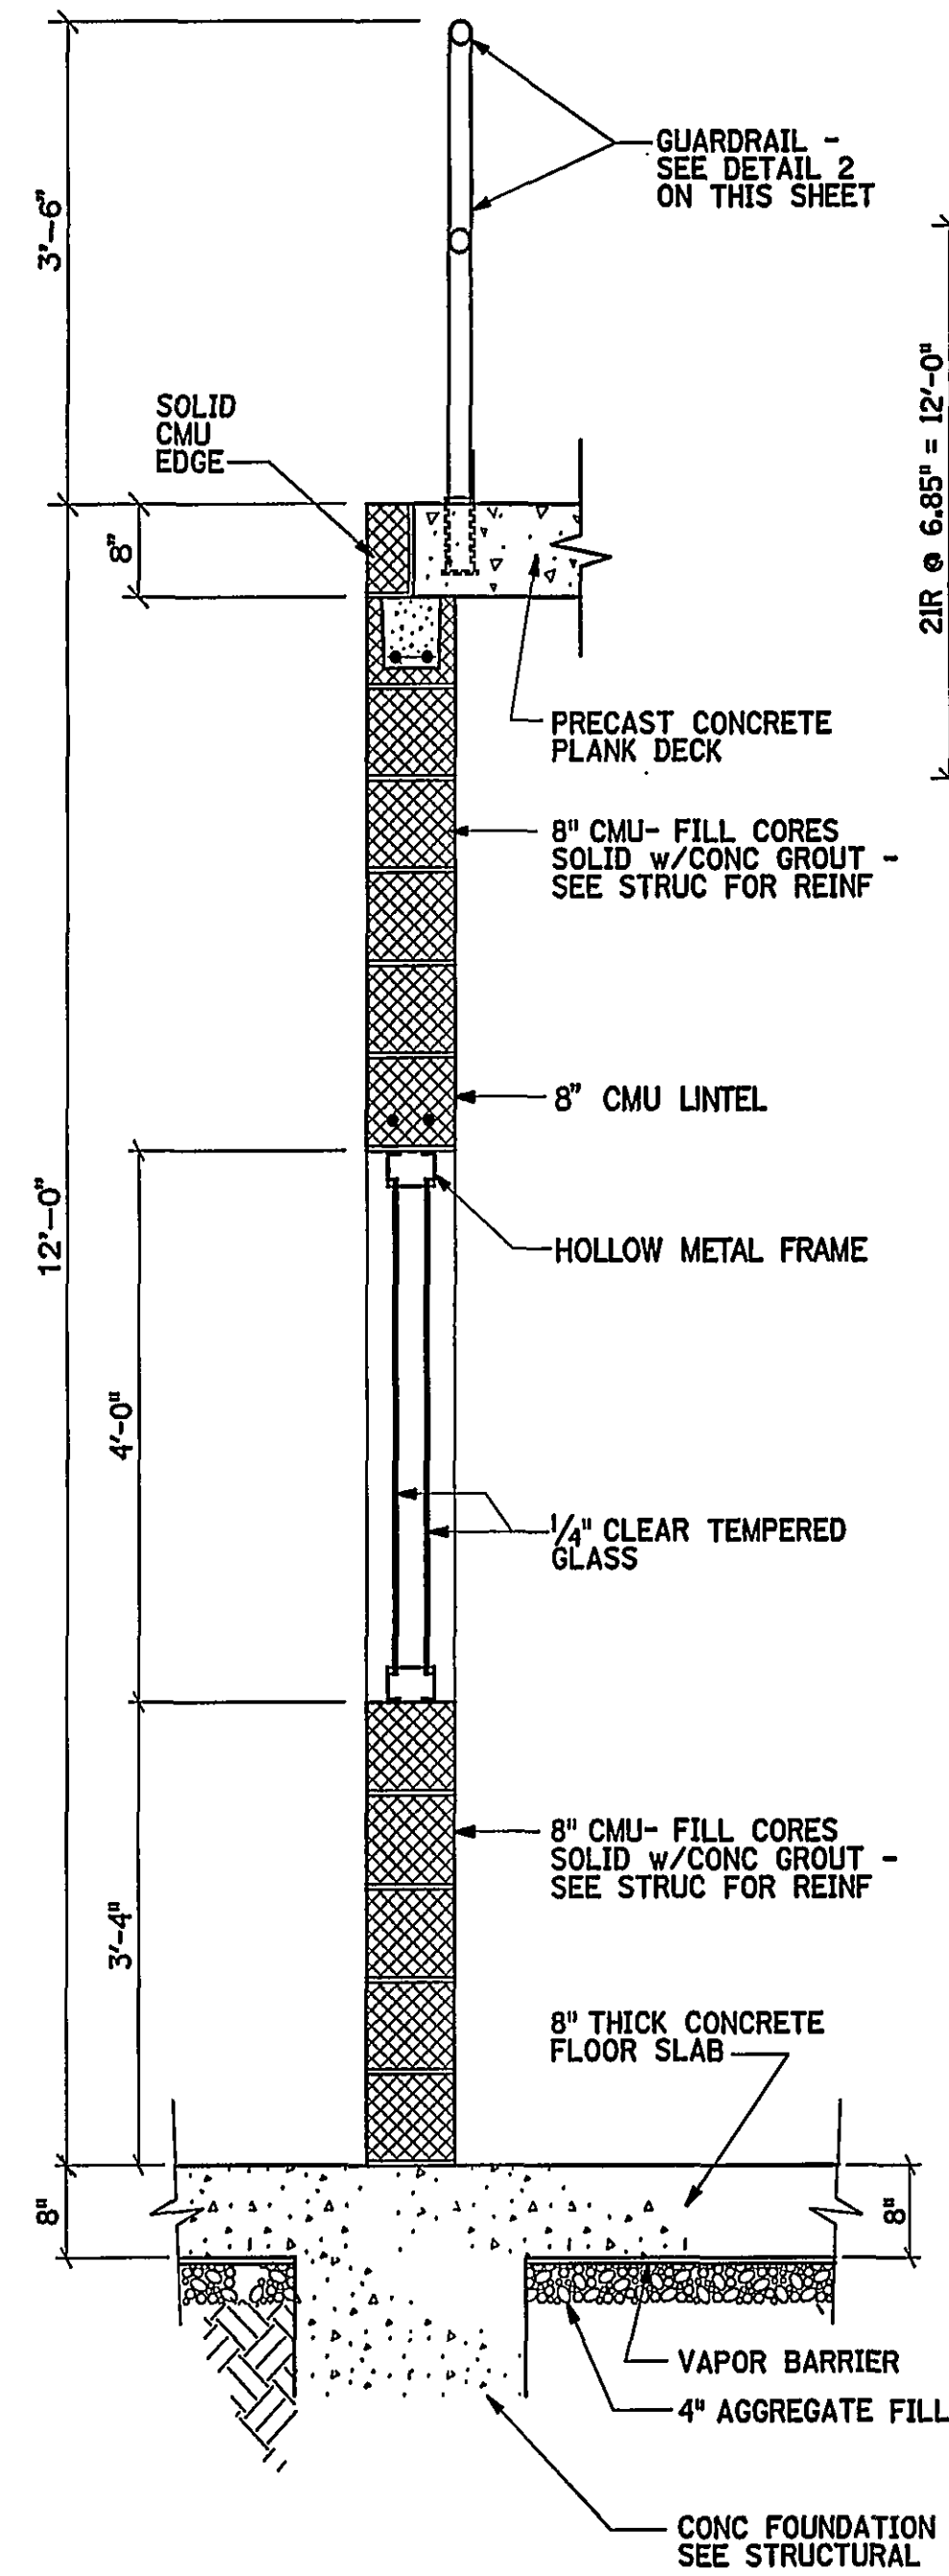


SECTION
SCALE: 3/4" = 1'-0"

1
A1, A9

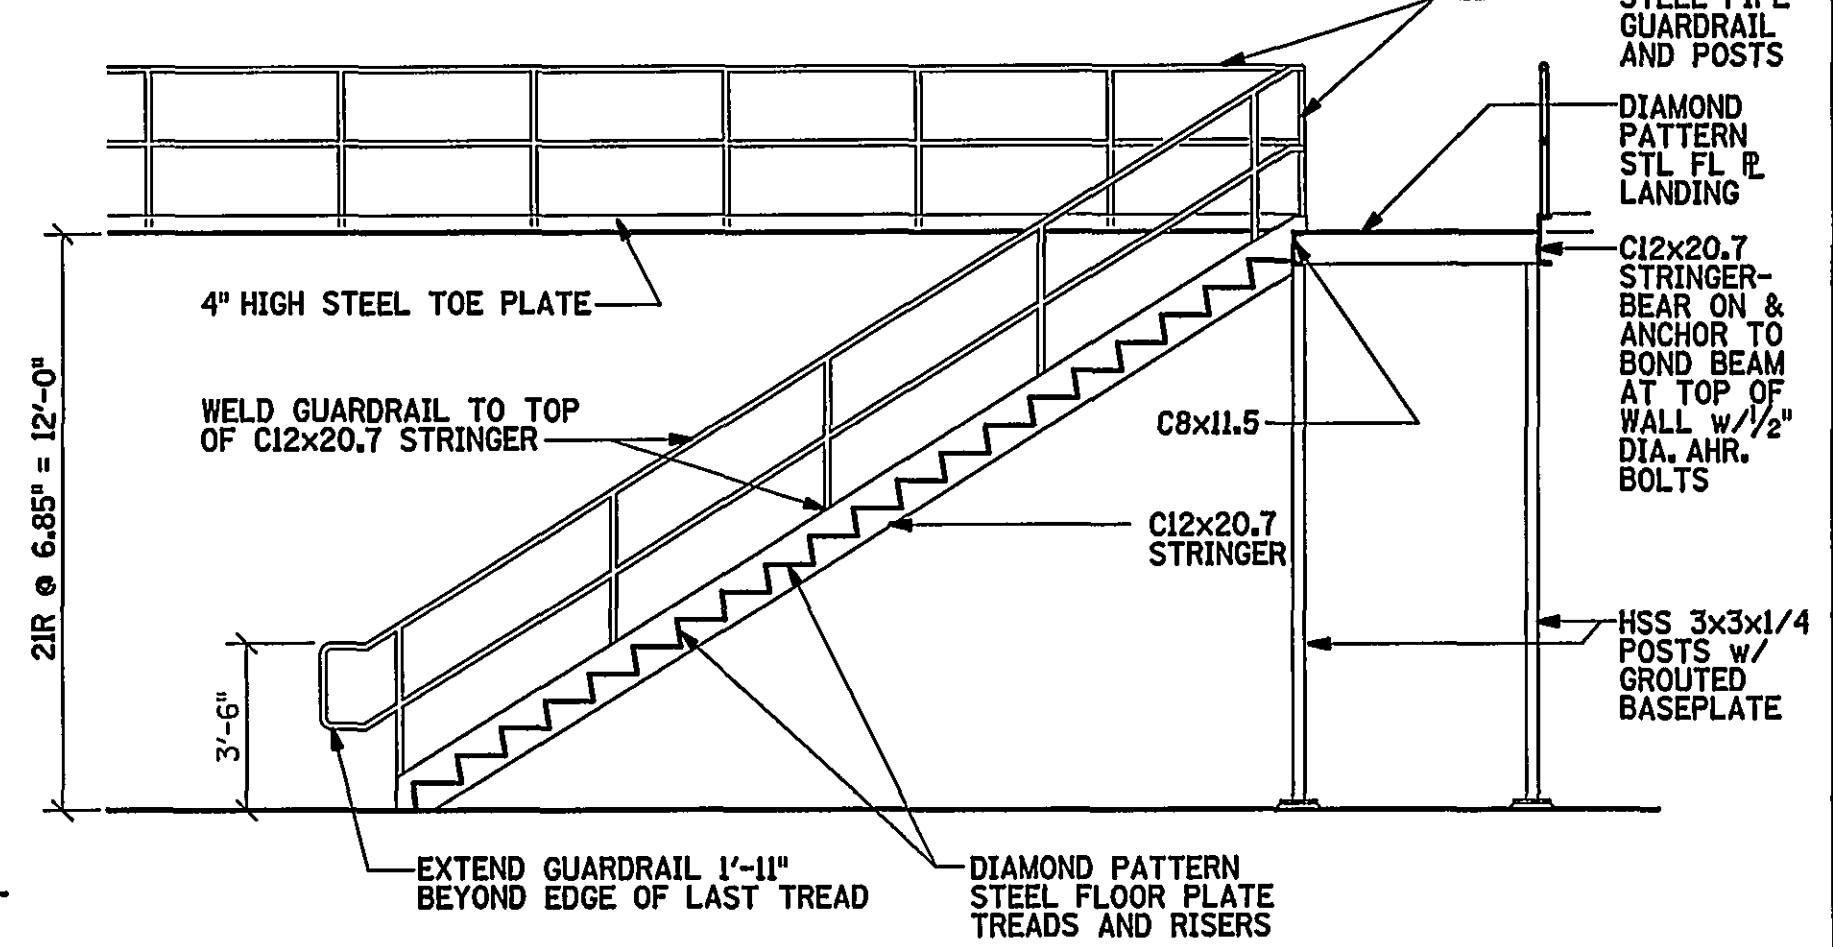

STAIR PLAN (PLAN DRAWN FOR STAIR No. 1)
SCALE: 1/4" = 1'-0" STAIR No. 2 IS MIRROR IMAGE

4
A2, A9

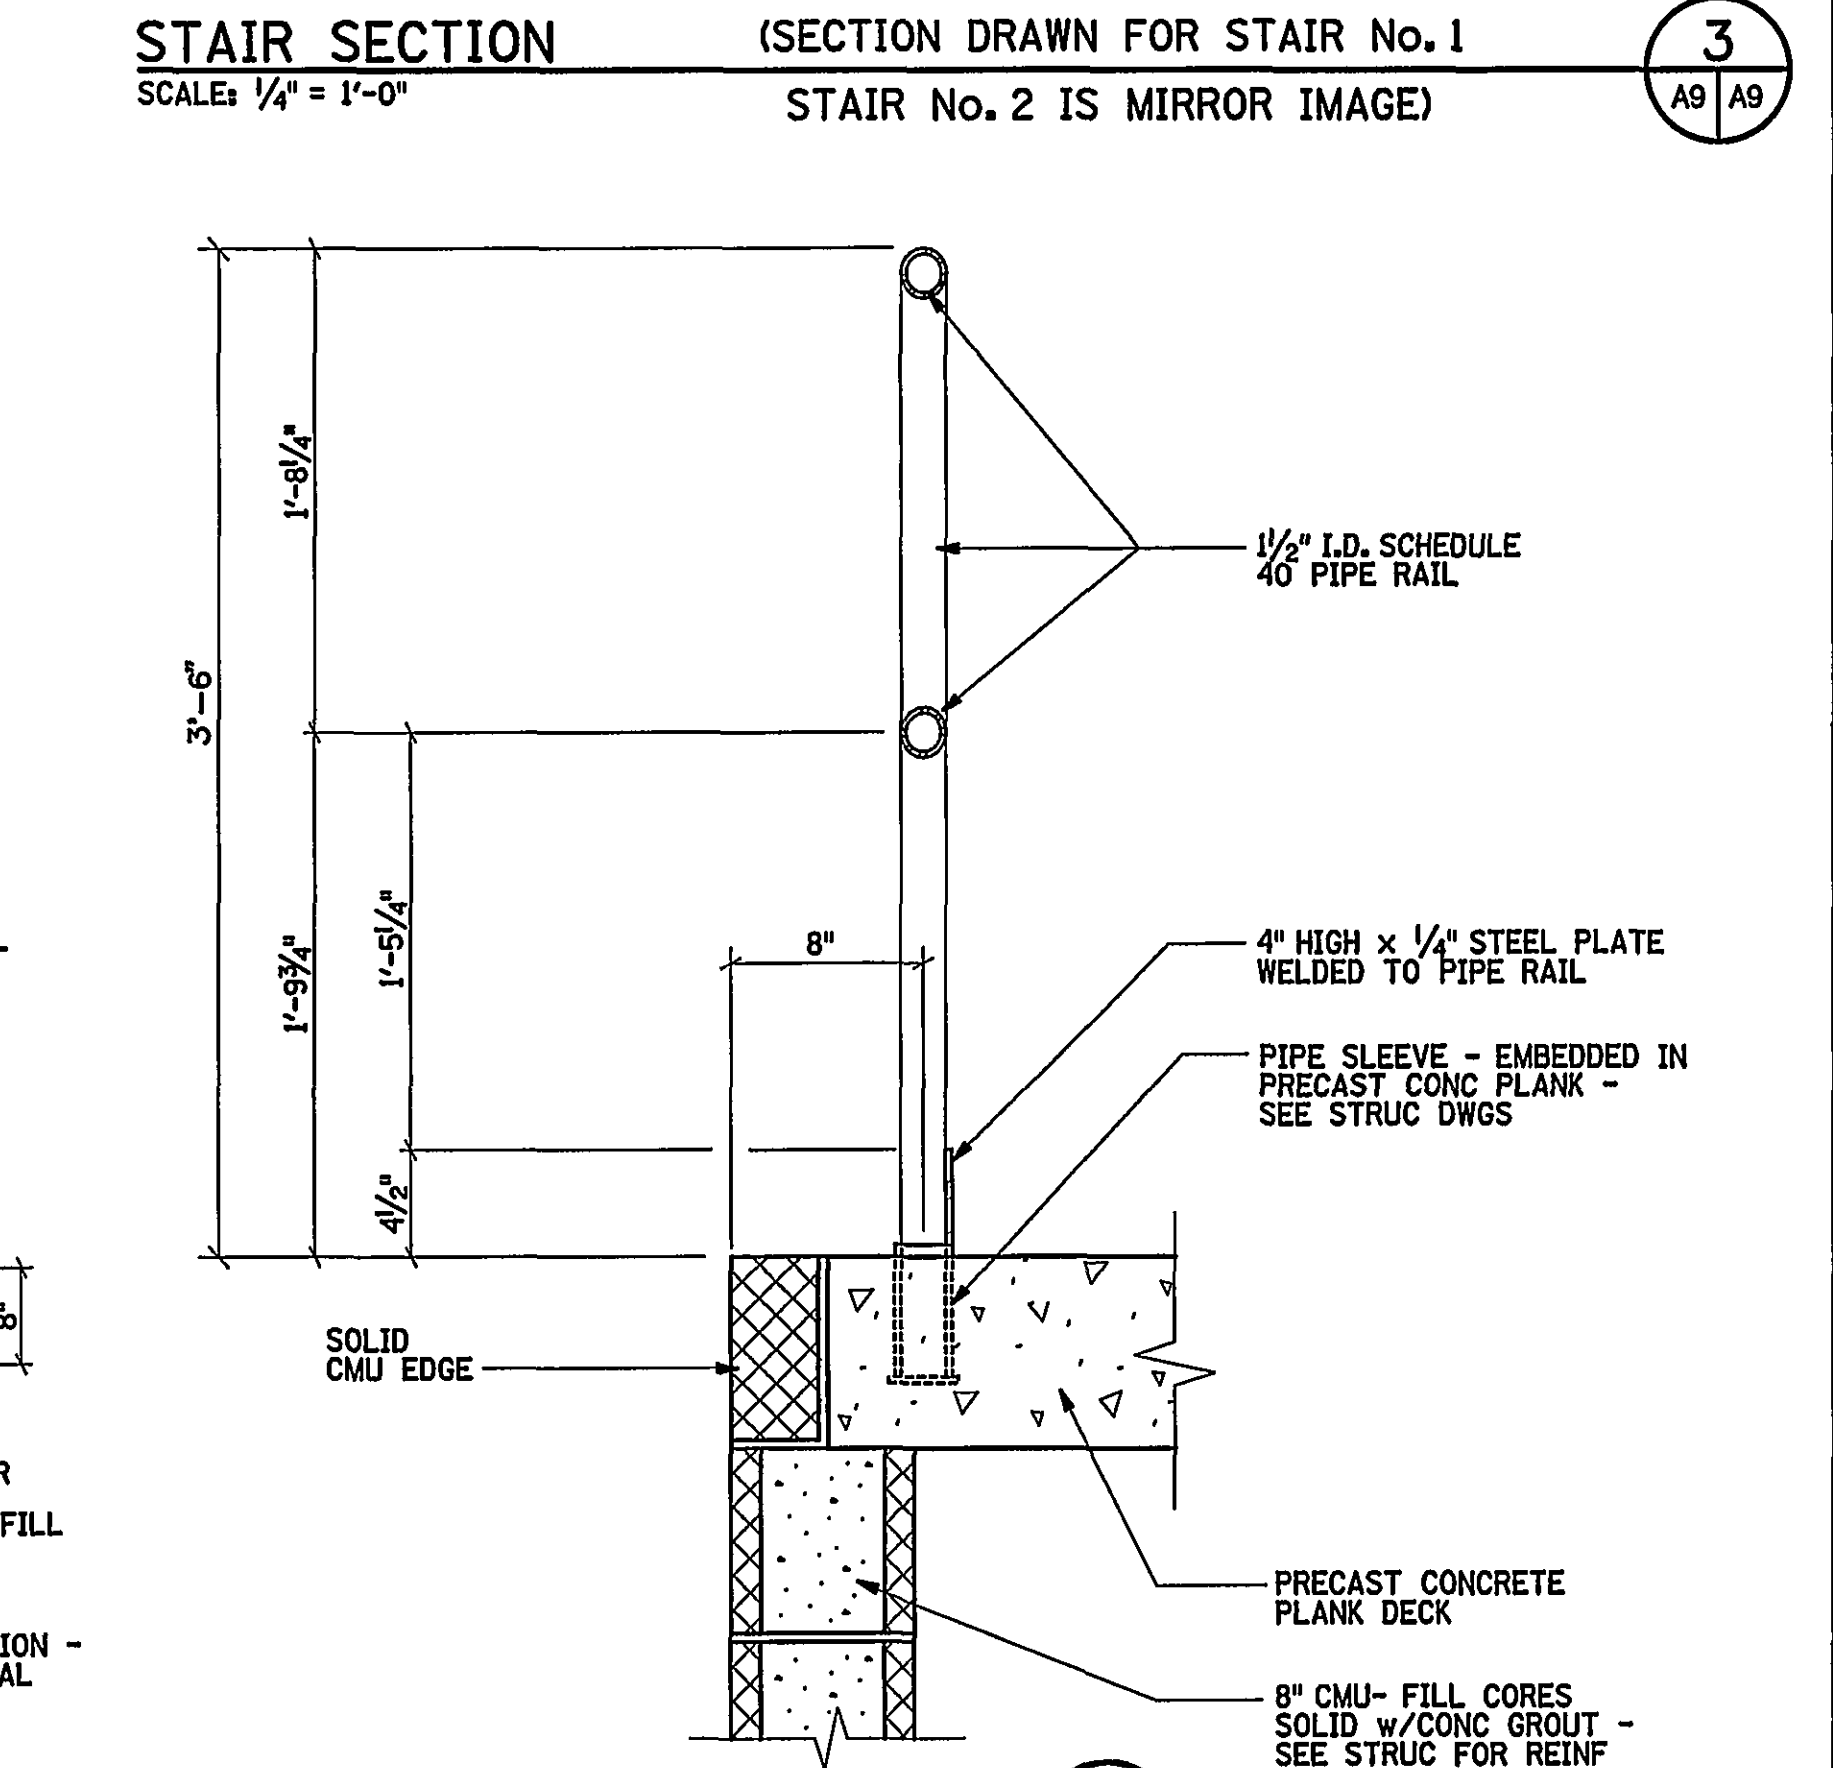


STAIR SECTION (SECTION DRAWN FOR STAIR No. 1)
SCALE: 1/4" = 1'-0" STAIR No. 2 IS MIRROR IMAGE

3
A9, A9

DETAIL
SCALE: 1 1/2" = 1'-0"

2
A9, A9

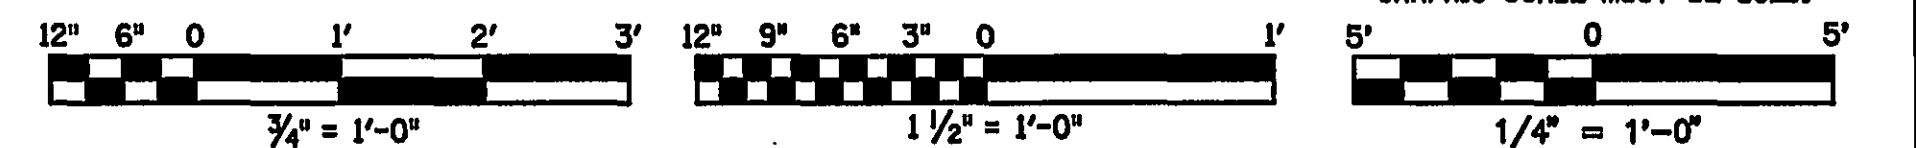

IF THIS DRAWING IS A REDUCTION,
GRAPHIC SCALE MUST BE USED.

REV.	DATE	BY	APP.	DESCRIPTION
5-01-03	JLW	MKJ		RECORD DRAWING

RECORD DRAWING

DATE: MAY 1, 2003

Wiley & Wilson
ARCHITECTS ENGINEERS PLANNERS
An Employee-Owned Company

2310 LANGHORNE ROAD
LYNCHBURG, VIRGINIA 24501
(804) 947-1901

P.O. BOX 877
LYNCHBURG, VIRGINIA 24505-0877

HDR

HDR Engineering, Inc.
5700 LAKE WRIGHT DRIVE
NORFOLK, VIRGINIA 23502
757-222-1500

DESIGNED JRM	DRAWN AEL	PROJECT CRYSTAL SPRING WATER TREATMENT PLANT FOR THE CITY OF ROANOKE, VIRGINIA ARCHITECTURAL
CHECKED MKJ	REVIEWED	REFERENCE
COMM. NO. 200171.01		
CADD NO. 200171A9.DGN		
DATE AUG 26, 2001	TITLE ENLARGED STAIR PLANS & DETAILS	DWG. NO. A-9
		SHEET NO. 20 OF 72
		REV. 0