



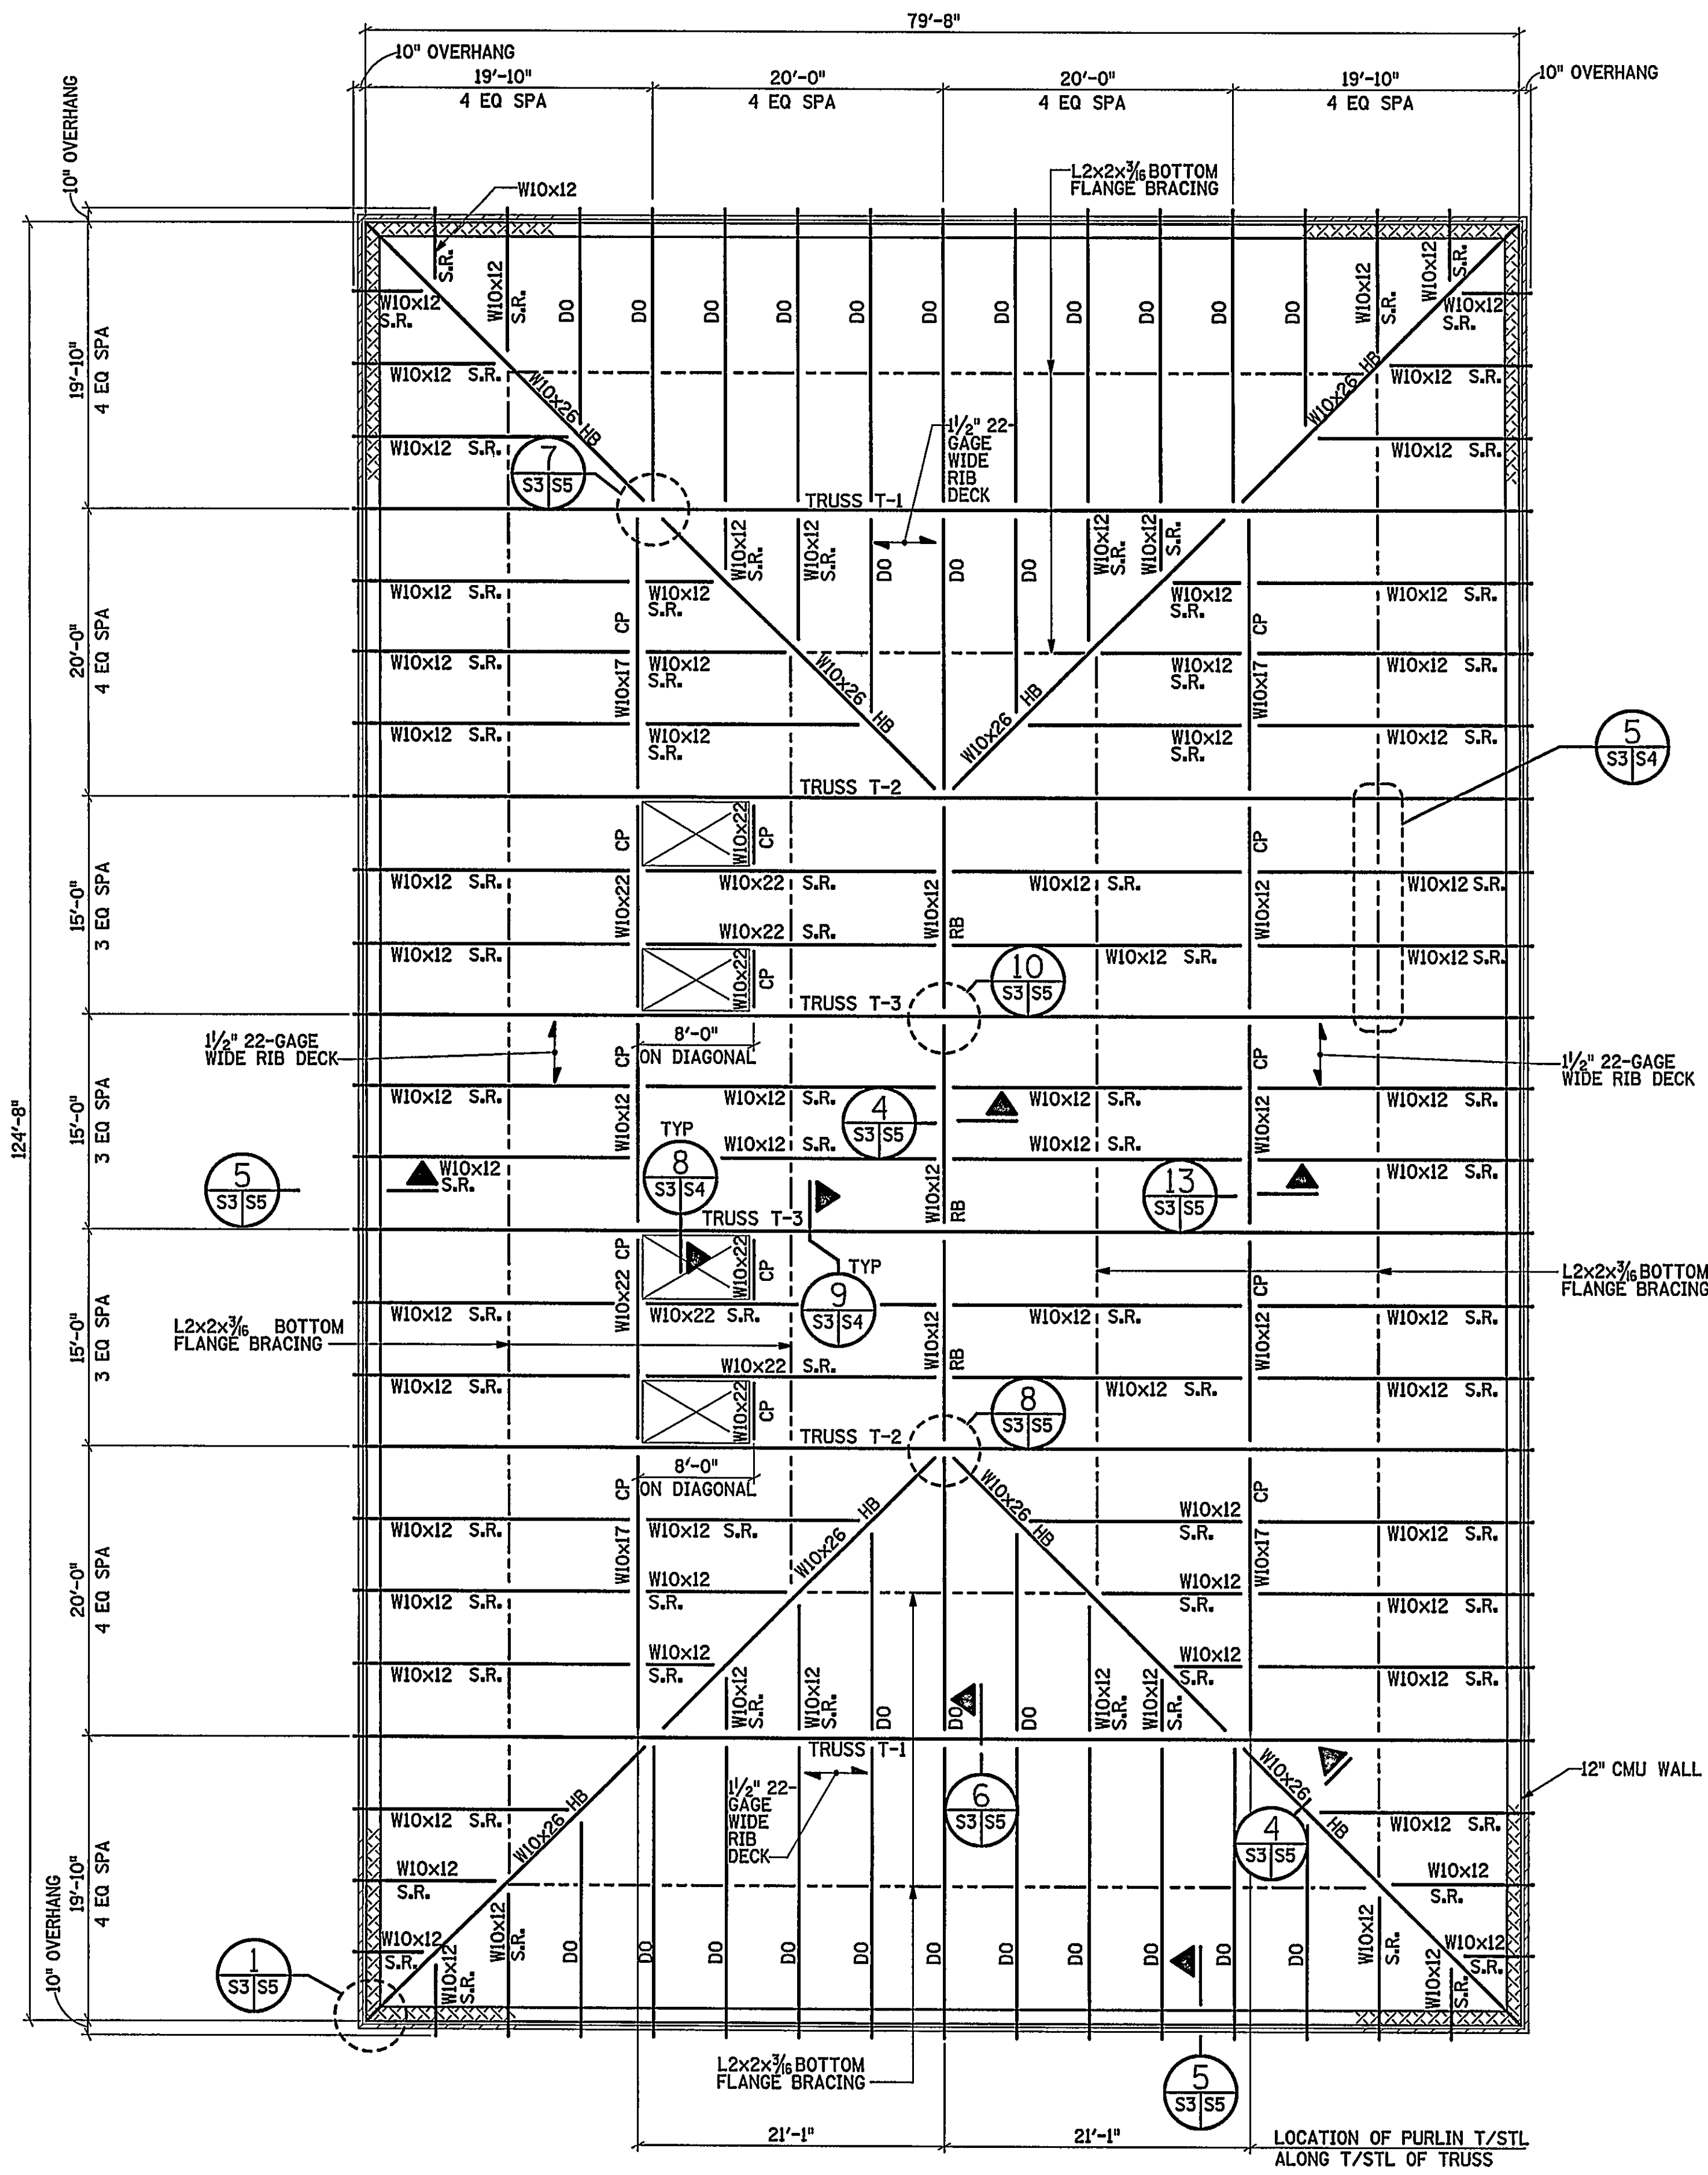

ROOF TOP CHORD FRAMING PLAN

SCALE: 1/8"=1'-0"

- NOTES:
1. FOR T/STL ELEVATIONS SEE TRUSS VIEWS AND STEEL DETAILS ON S-4 AND S-5.
 2. S.R. = SLOPED RAFTER
 3. CP = CANTED PURLIN
 4. HB = HIP BEAM
 5. RB = RIDGE BEAM

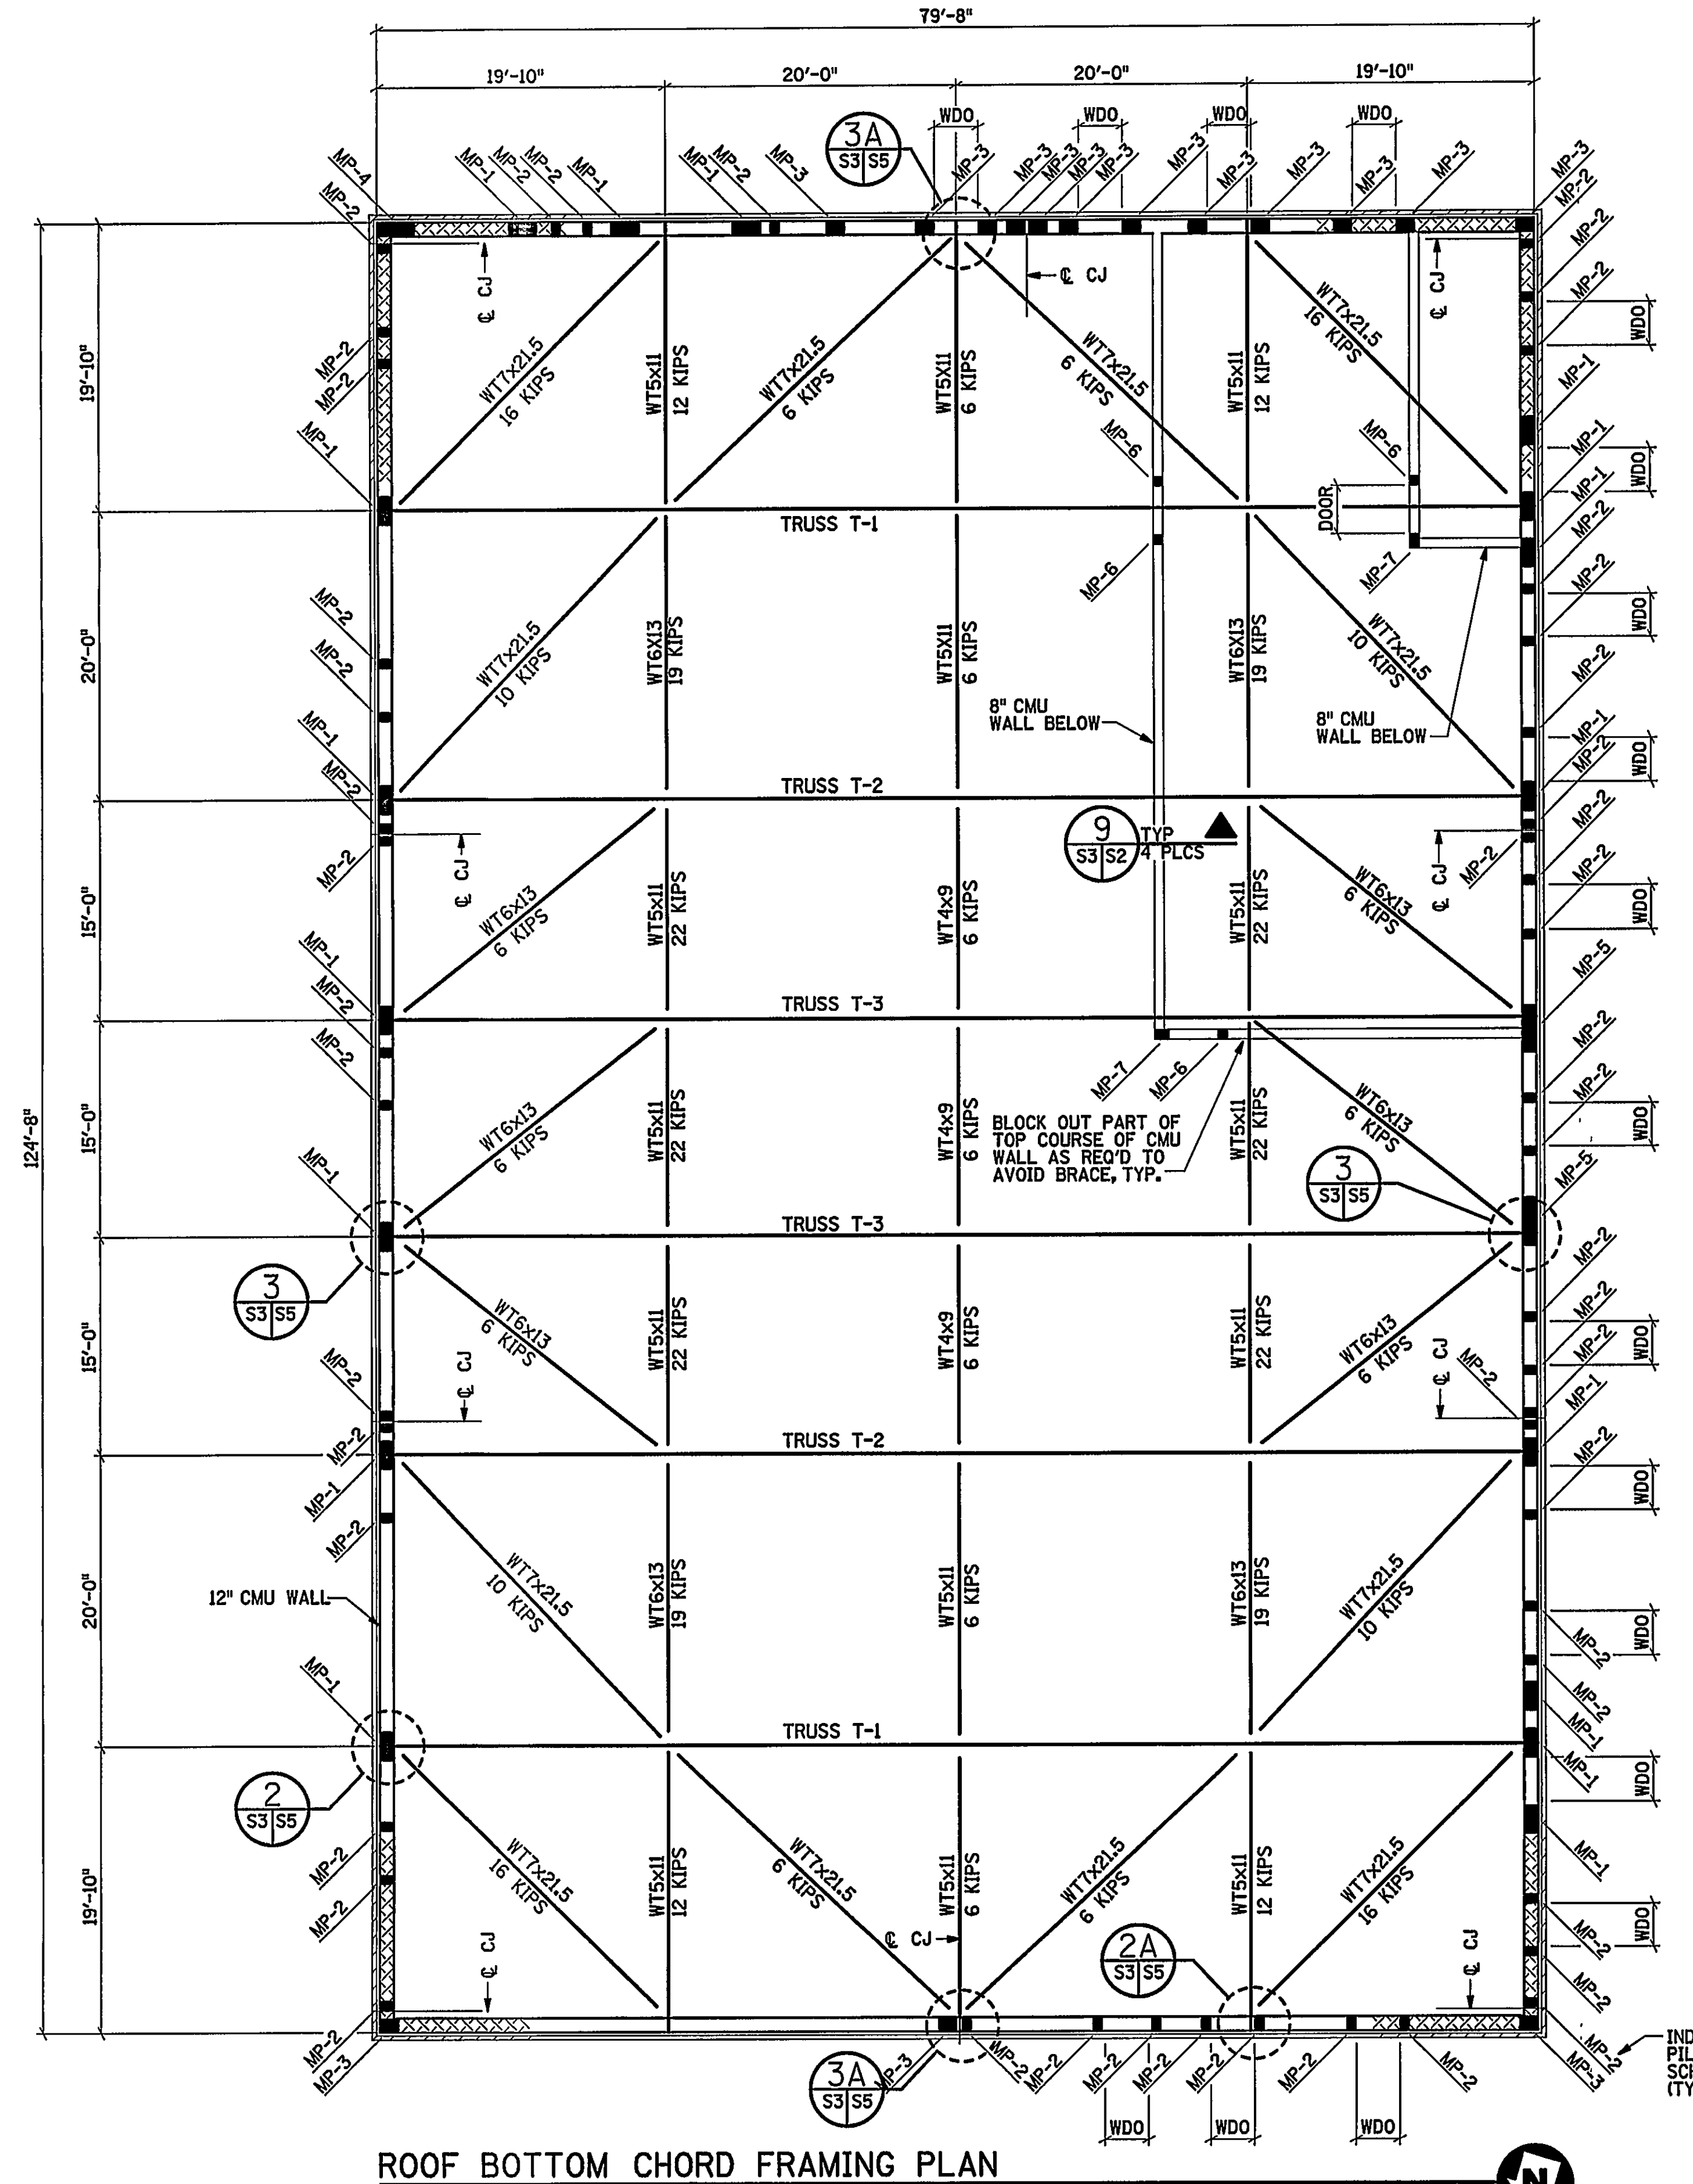

ROOF BOTTOM CHORD FRAMING PLAN

SCALE: 1/8"=1'-0"

NOTES: BOTTOM OF TRUSS +22'-10" AFF
TOP OF WT BRACES +22'-9" AFF

IF THIS DRAWING IS A REDUCTION,
GRAPHIC SCALE MUST BE USED.

5' 0 5' 10' 15'

1/8" = 1'-0"

REV.	DATE	BY	APP.	DESCRIPTION
5-01-03	JLW	MKJ		RECORD DRAWING

RECORD DRAWING

DATE: MAY 1, 2003

Wiley & Wilson
ARCHITECTS ENGINEERS PLANNERS
An Employee-Owned Company

2310 LANGHORNE ROAD
LYNCHBURG, VIRGINIA 24501
(804) 947-1901

P.O. BOX 877
LYNCHBURG, VIRGINIA 24505-0877

IN ASSOCIATION WITH

HDR
HDR Engineering, Inc.
5700 LAKE WRIGHT DRIVE
NORFOLK, VIRGINIA 23502
757-222-1500

DESIGNED JEH	DRAWN JDI	PROJECT CRYSTAL SPRING WATER TREATMENT PLANT FOR THE CITY OF ROANOKE, VIRGINIA
CHECKED NST	REVIEWED VKA	REFERENCE
COMM. NO. 200171.01		
CADD NO. 200171S03.DGN	TITLE ROOF FRAMING PLANS	
DATE AUG 26, 2001	DWG. NO. S-3	SHEET NO. 24 OF 72
		REV. 0