



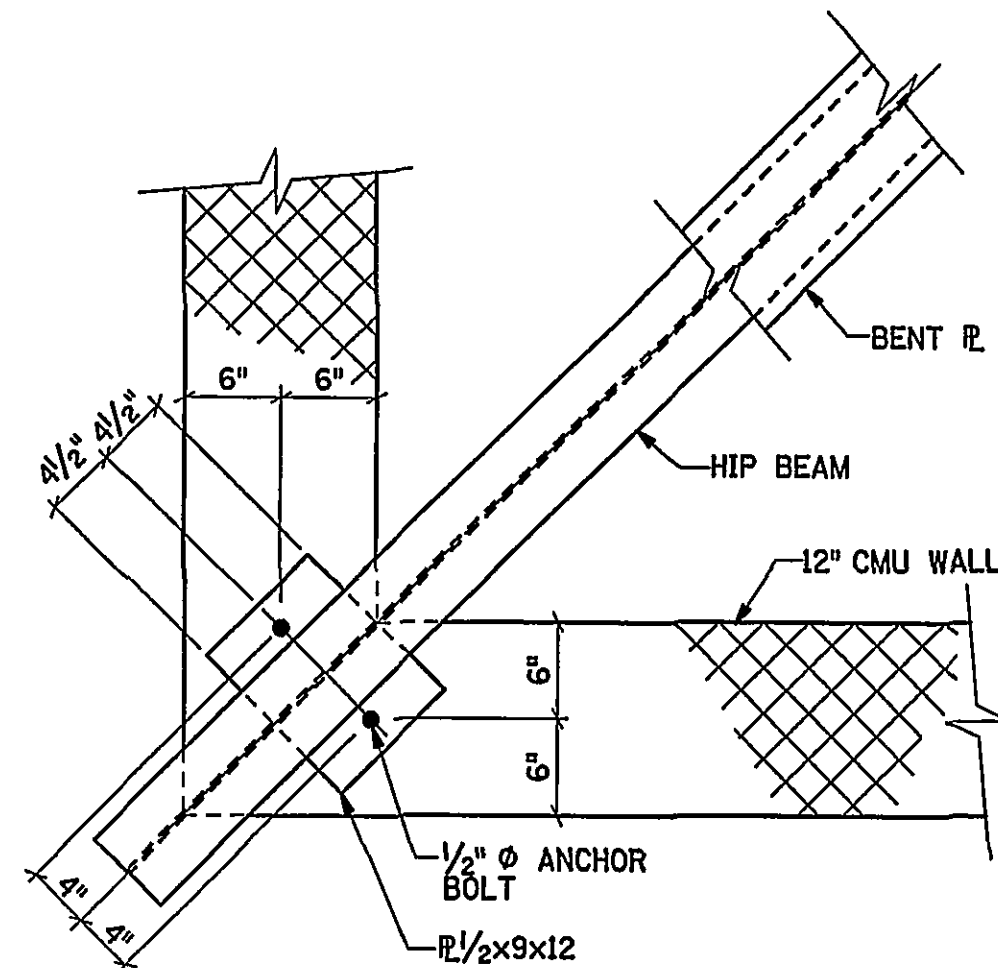

PLAN DETAIL

SCALE: 1"=1'-0"


1
S3 S5

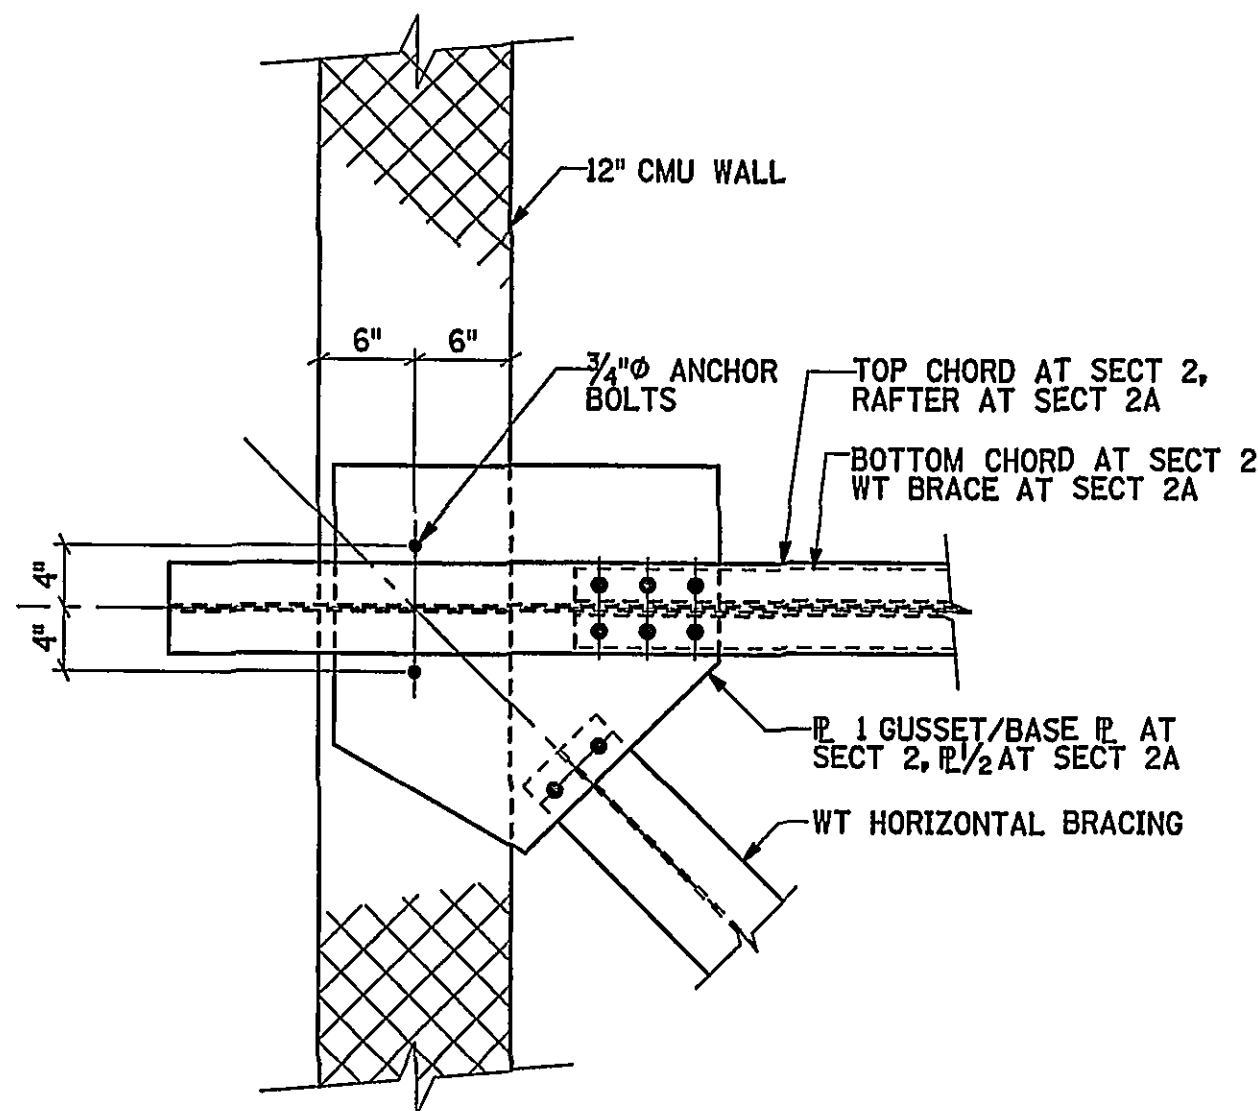

PLAN DETAIL

SCALE: 1"=1'-0"


2 2A
S3 S5 S3 S5

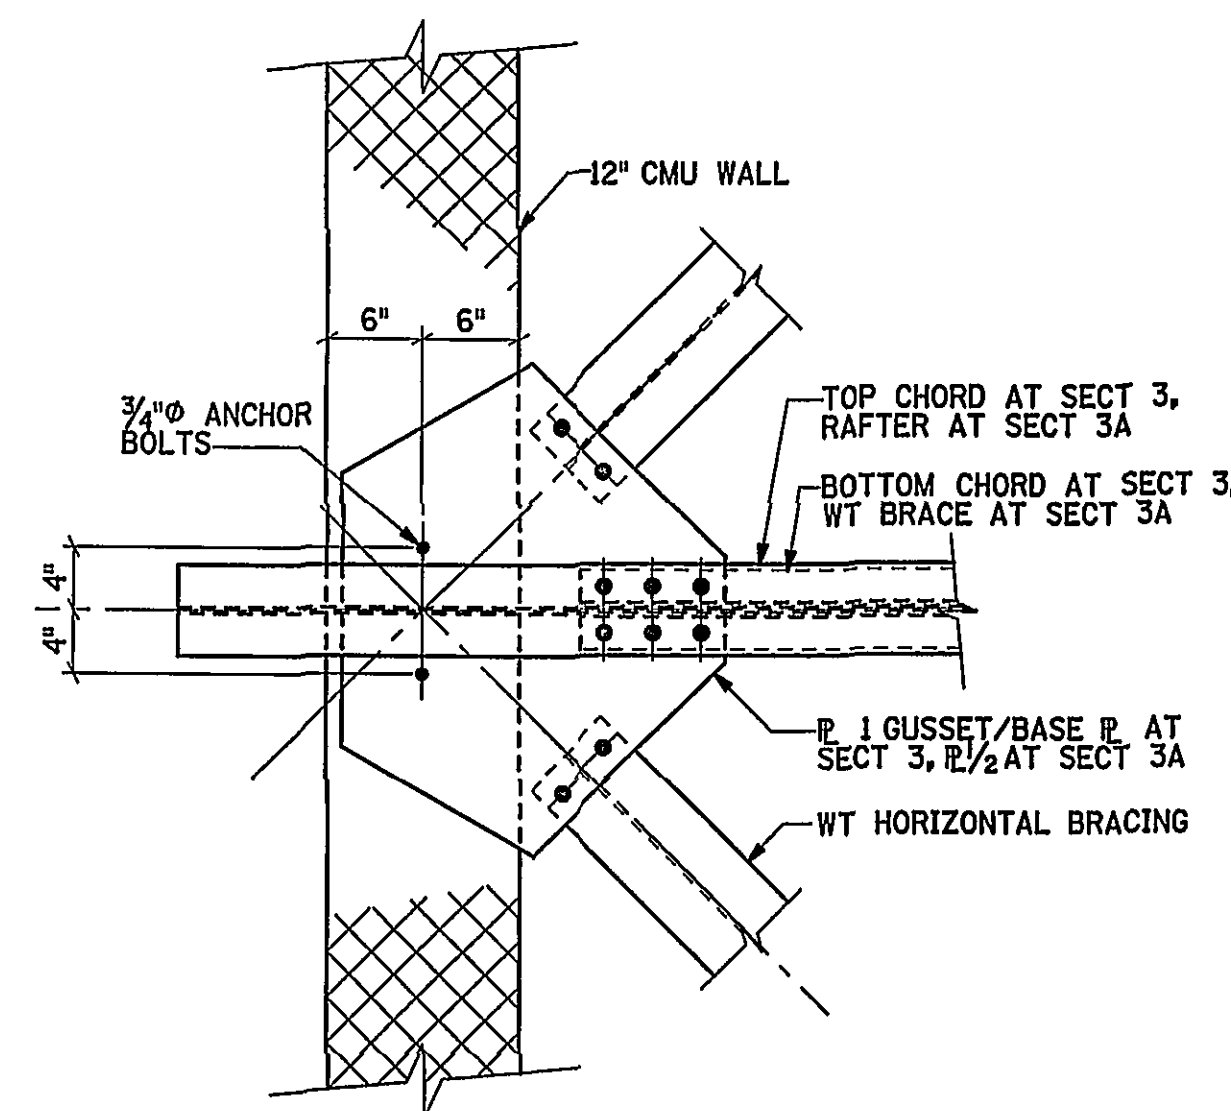

PLAN DETAIL

SCALE: 1"=1'-0"


3 3A
S3 S5 S3 S5

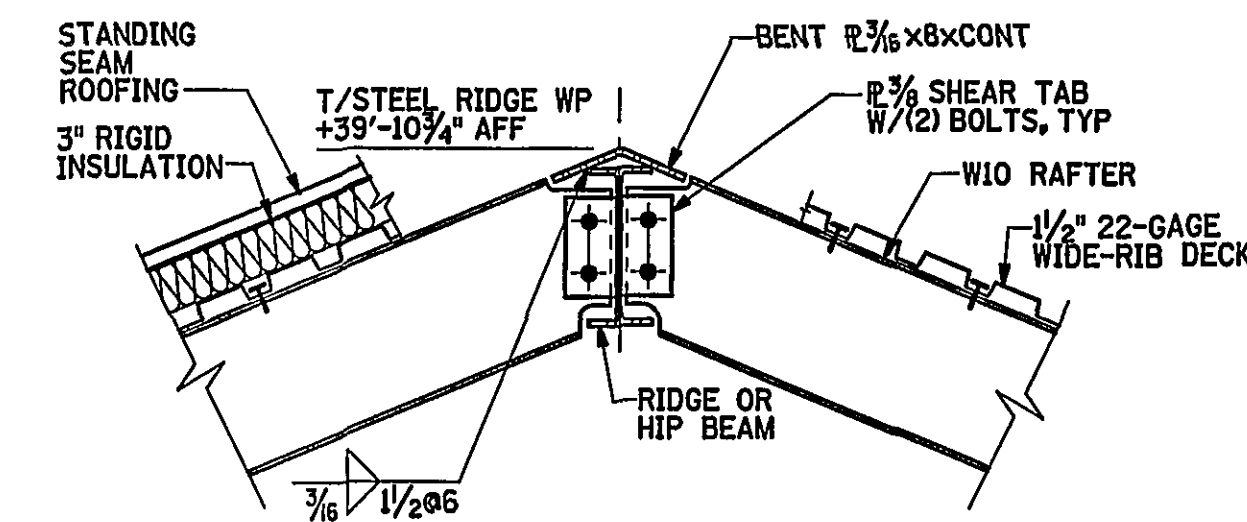

SECTION

SCALE: 1"=1'-0"


4
S3 S5

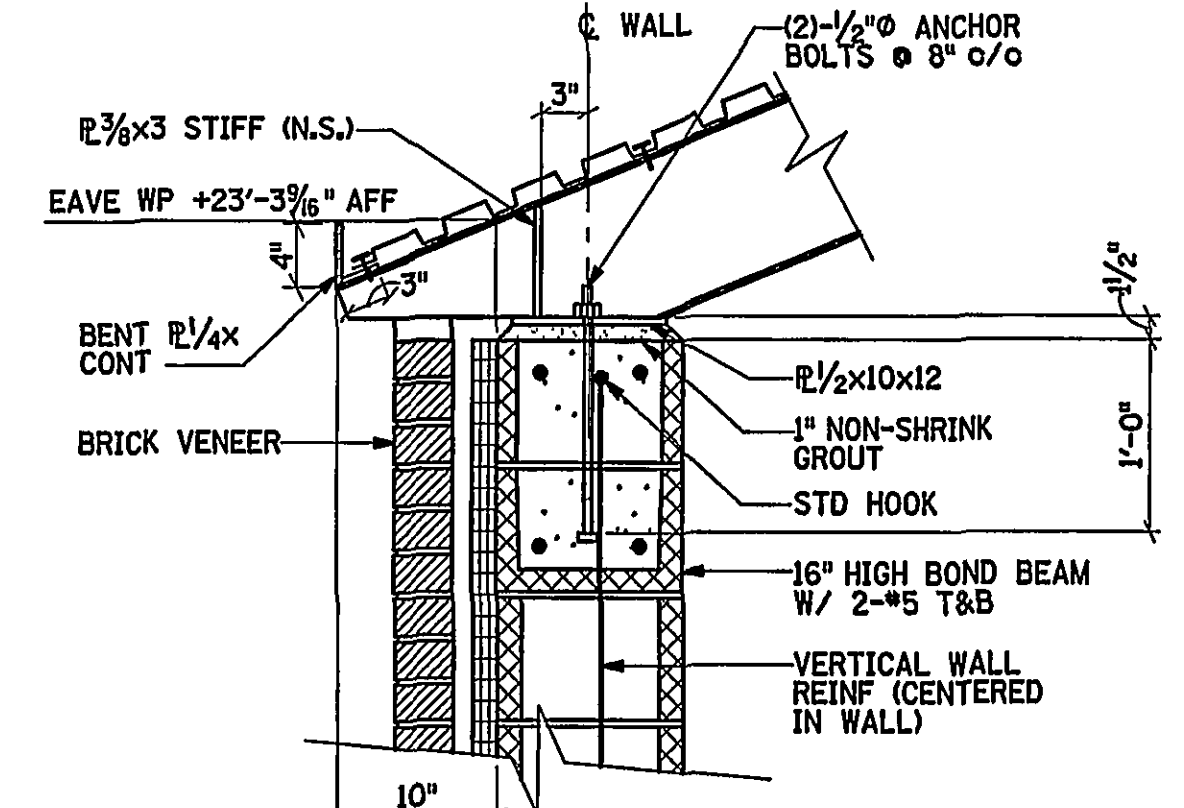

SECTION

SCALE: 1"=1'-0"


5
S3 S5

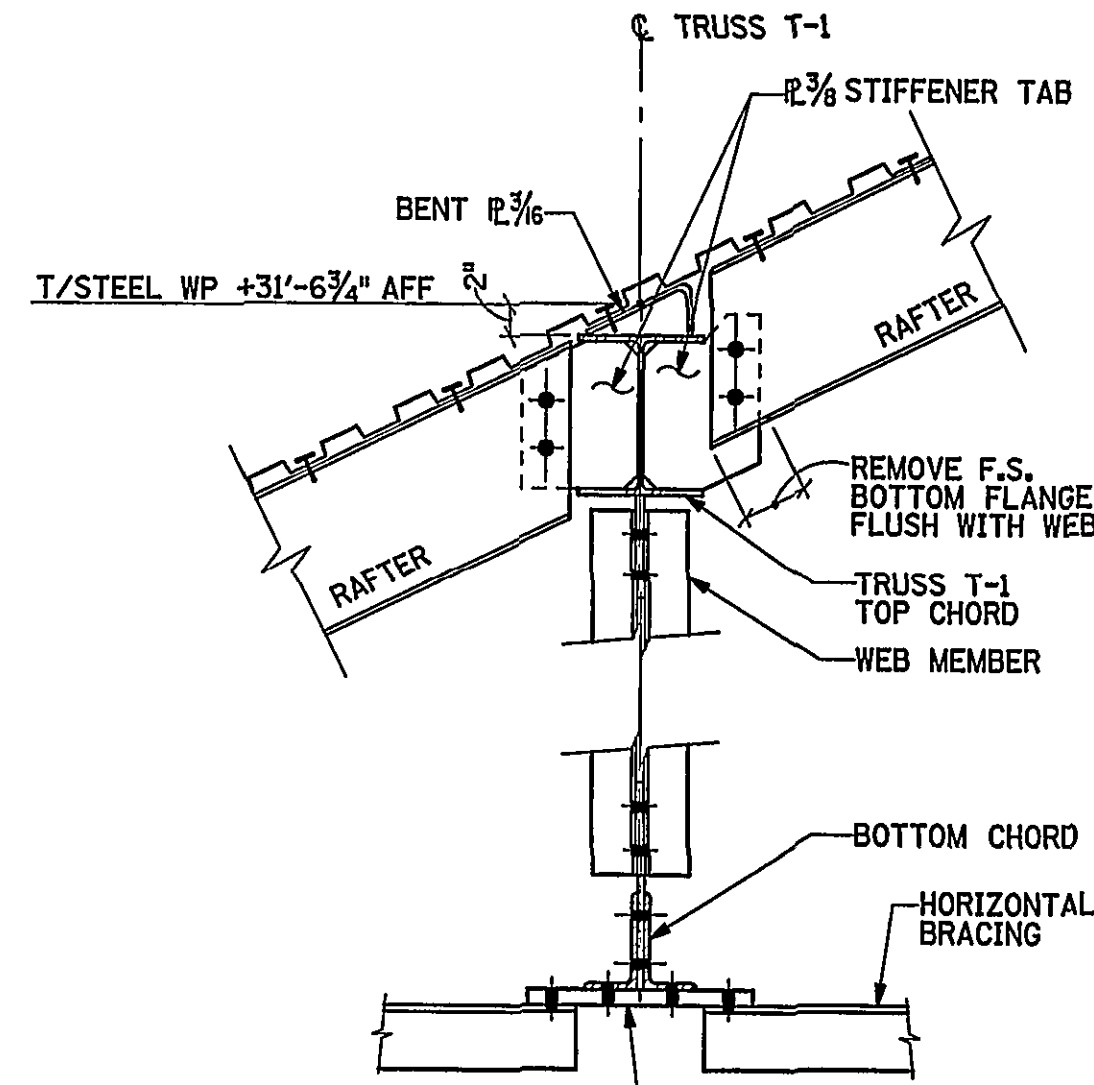

SECTION

SCALE: 1"=1'-0"


6
S3 S5

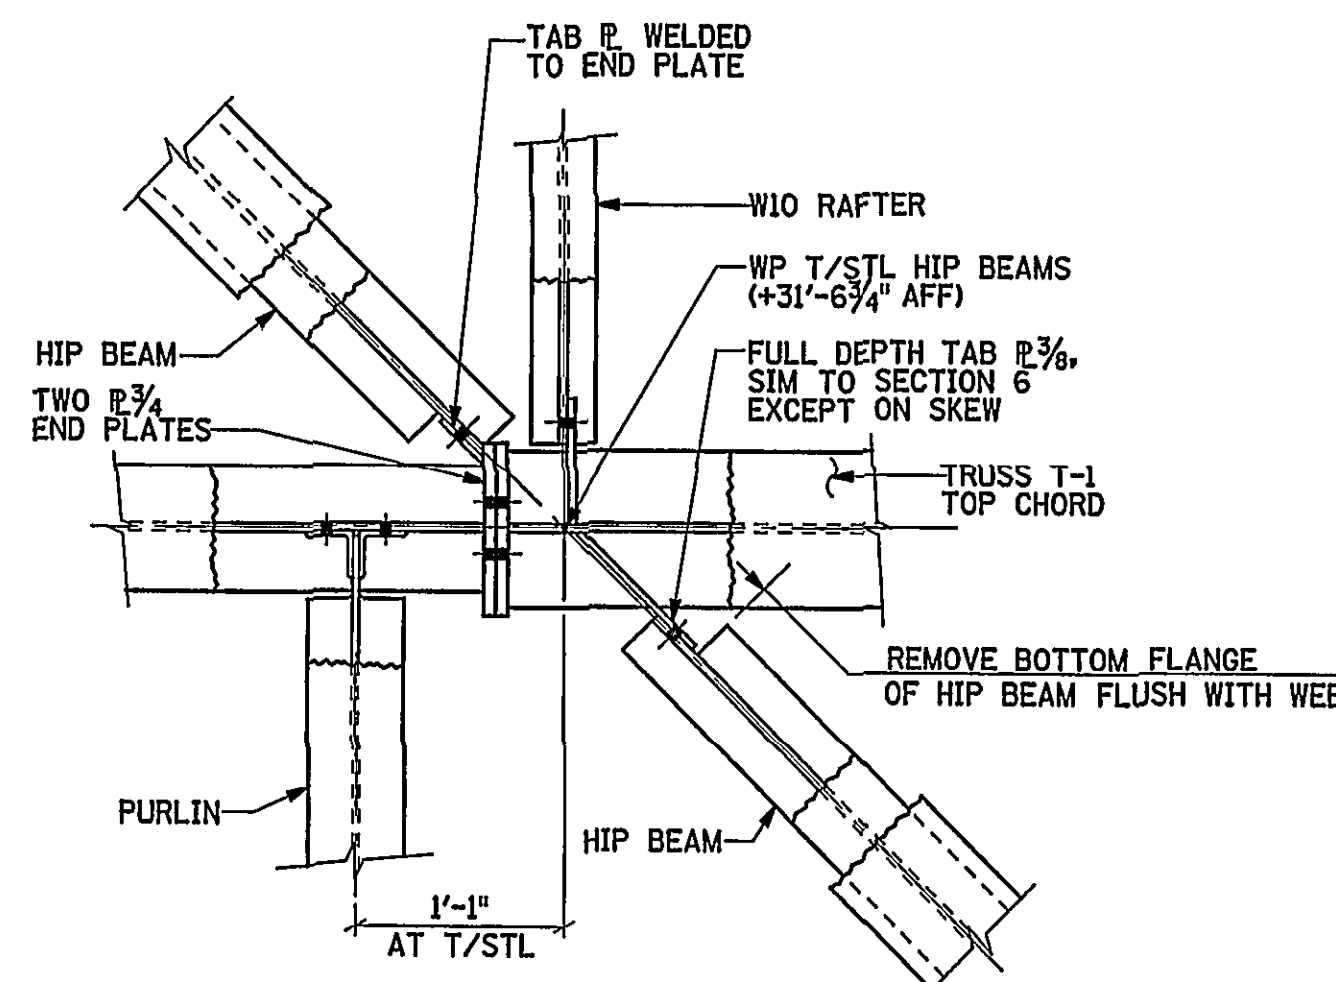

PLAN DETAIL

SCALE: 1"=1'-0"


7
S3 S5

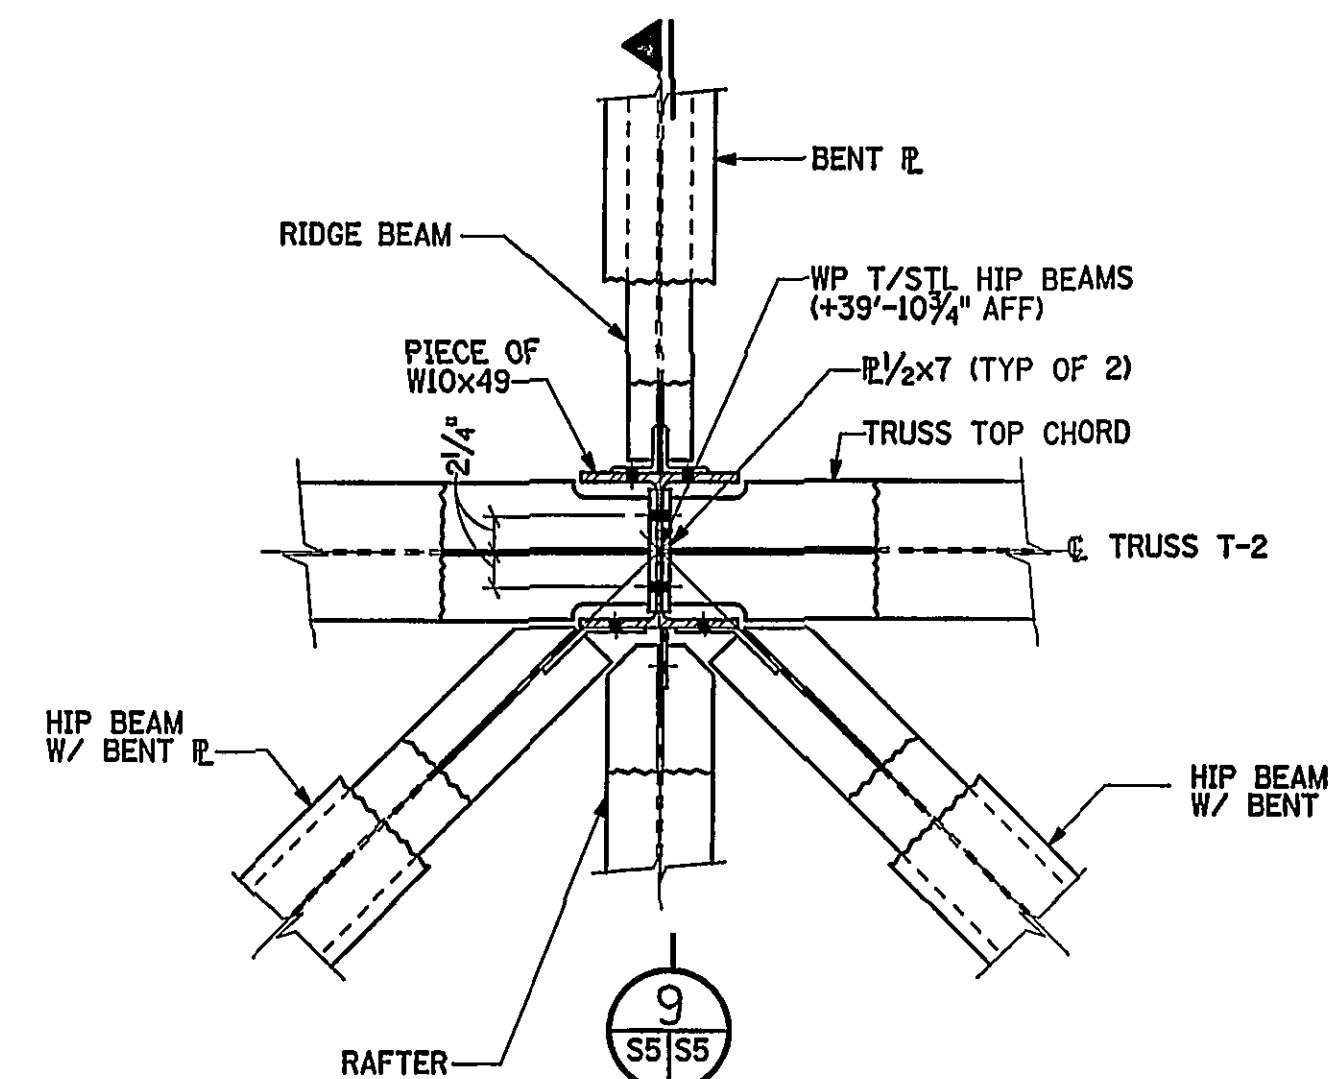

PLAN DETAIL

SCALE: 1"=1'-0"


8
S3 S5

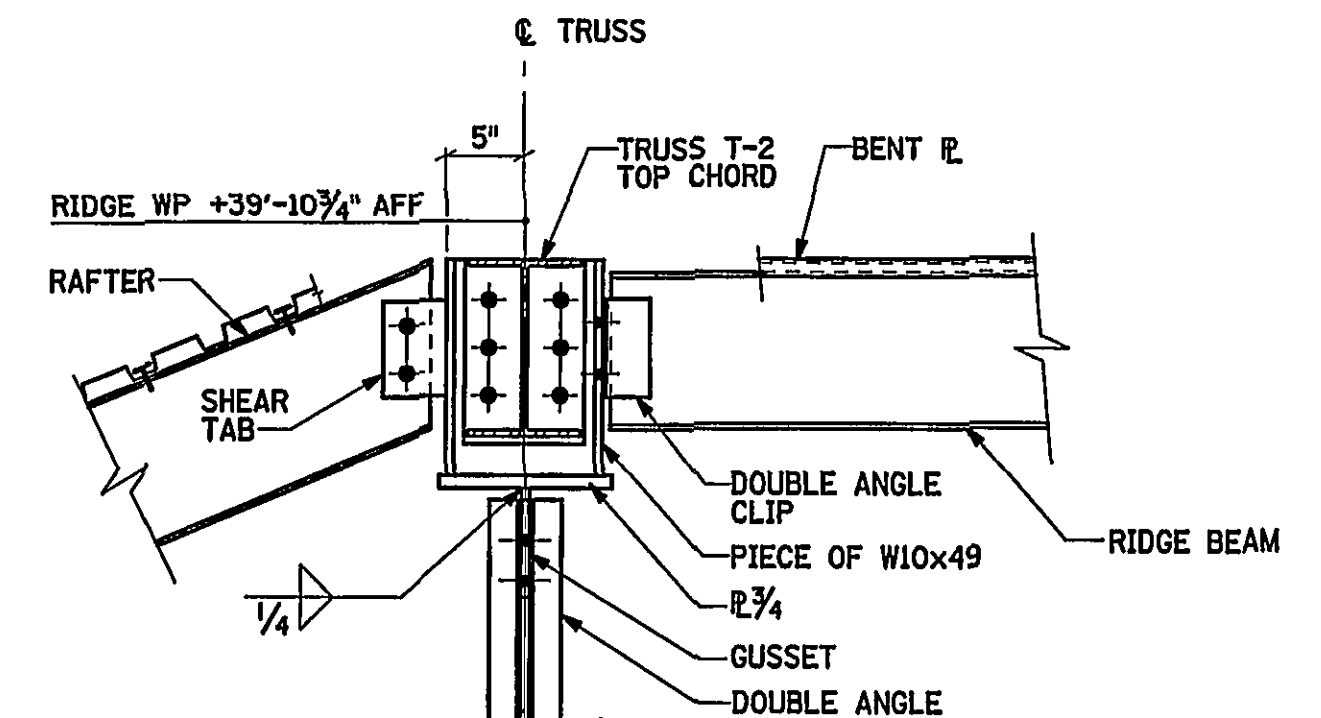

SECTION

SCALE: 1"=1'-0"


9
S3 S5

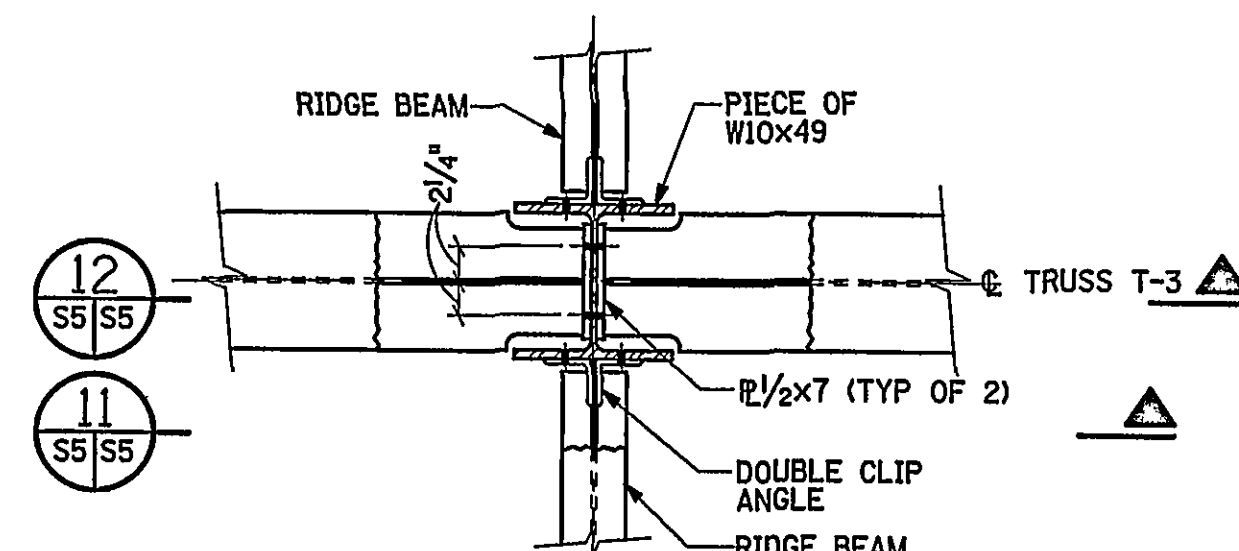

PLAN DETAIL

SCALE: 1"=1'-0"


10
S3 S5

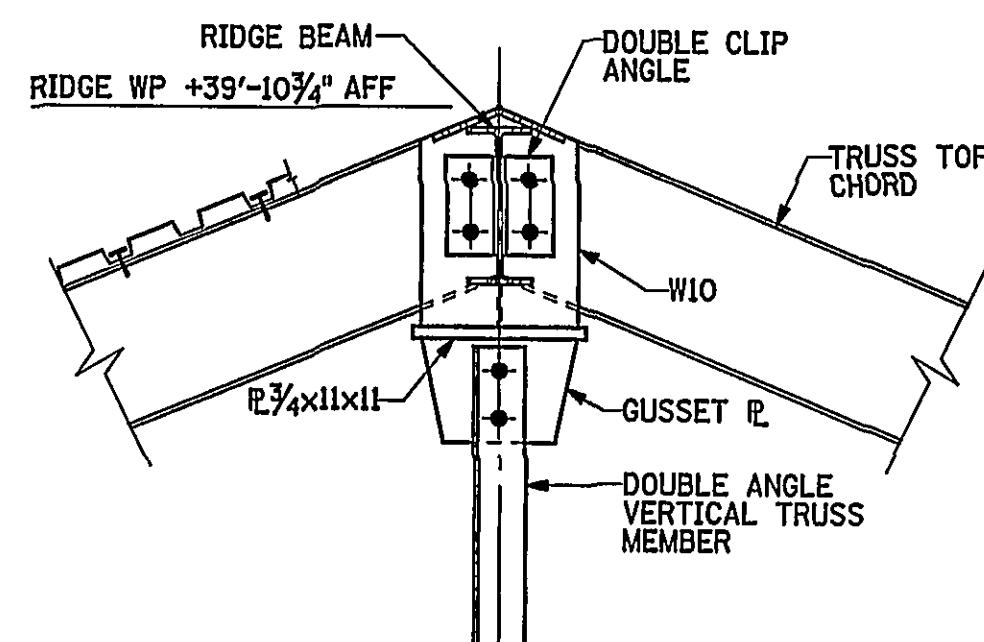

SECTION

SCALE: 1"=1'-0"


11
S3 S5

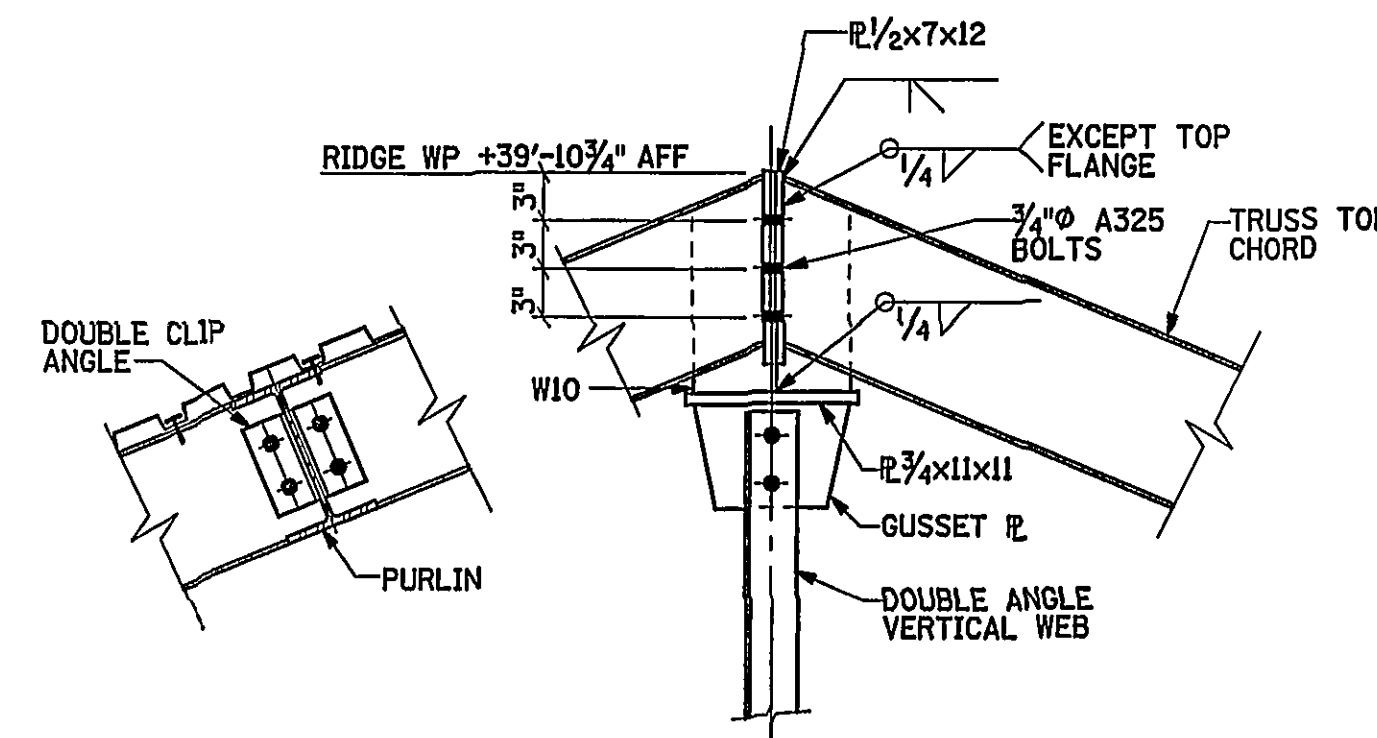

SECTION

SCALE: 1"=1'-0"

12
S3 S5

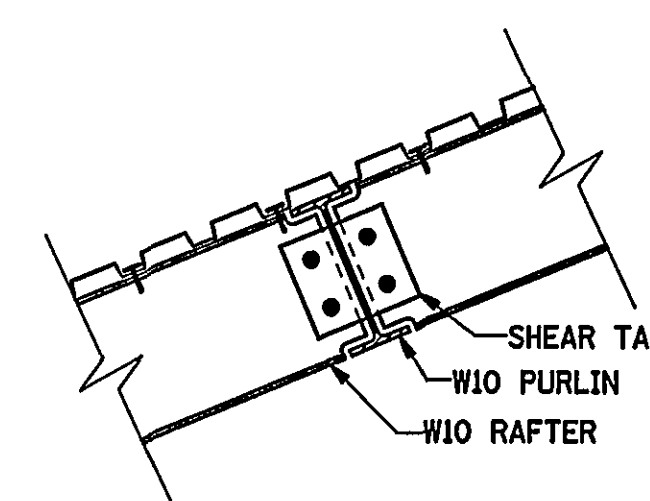


SECTION

SCALE: 1"=1'-0"

13
S3 S5

IF THIS DRAWING IS A REDUCTION,
GRAPHIC SCALE MUST BE USED.

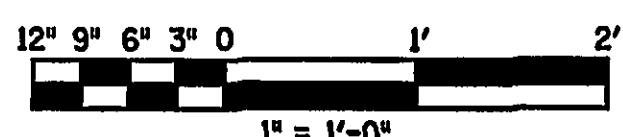

NOTE: FOR GENERAL NOTES, SEE DWG. S-7

REV.	DATE	BY	APP.	DESCRIPTION
5-01-03	JLW	MKJ		RECORD DRAWING

RECORD DRAWING

DATE: MAY 1, 2003

Wiley & Wilson
ARCHITECTS ENGINEERS PLANNERS
An Employee-Owned Company

2310 LANGHORNE ROAD
LYNCHBURG, VIRGINIA 24501
(804) 947-1901

P.O. BOX 877
LYNCHBURG, VIRGINIA 24505-0877

HDR

HDR Engineering, Inc.
5700 LAKE WRIGHT DRIVE
NORFOLK, VIRGINIA 23502
757-222-1500

IN ASSOCIATION WITH

DESIGNED JEH	DRAWN JDI	PROJECT CRYSTAL SPRING WATER TREATMENT PLANT FOR THE CITY OF ROANOKE, VIRGINIA
CHECKED NST	REVIEWED VKA	REFERENCE STRUCTURAL
COMM. NO. 200171.01	CADD NO. 200171S05.DGN	TITLE STEEL ROOF SECTIONS AND DETAILS
DATE AUG 26, 2001	DWG. NO. S-5	SHEET NO. 26 OF 72

REV. 0