


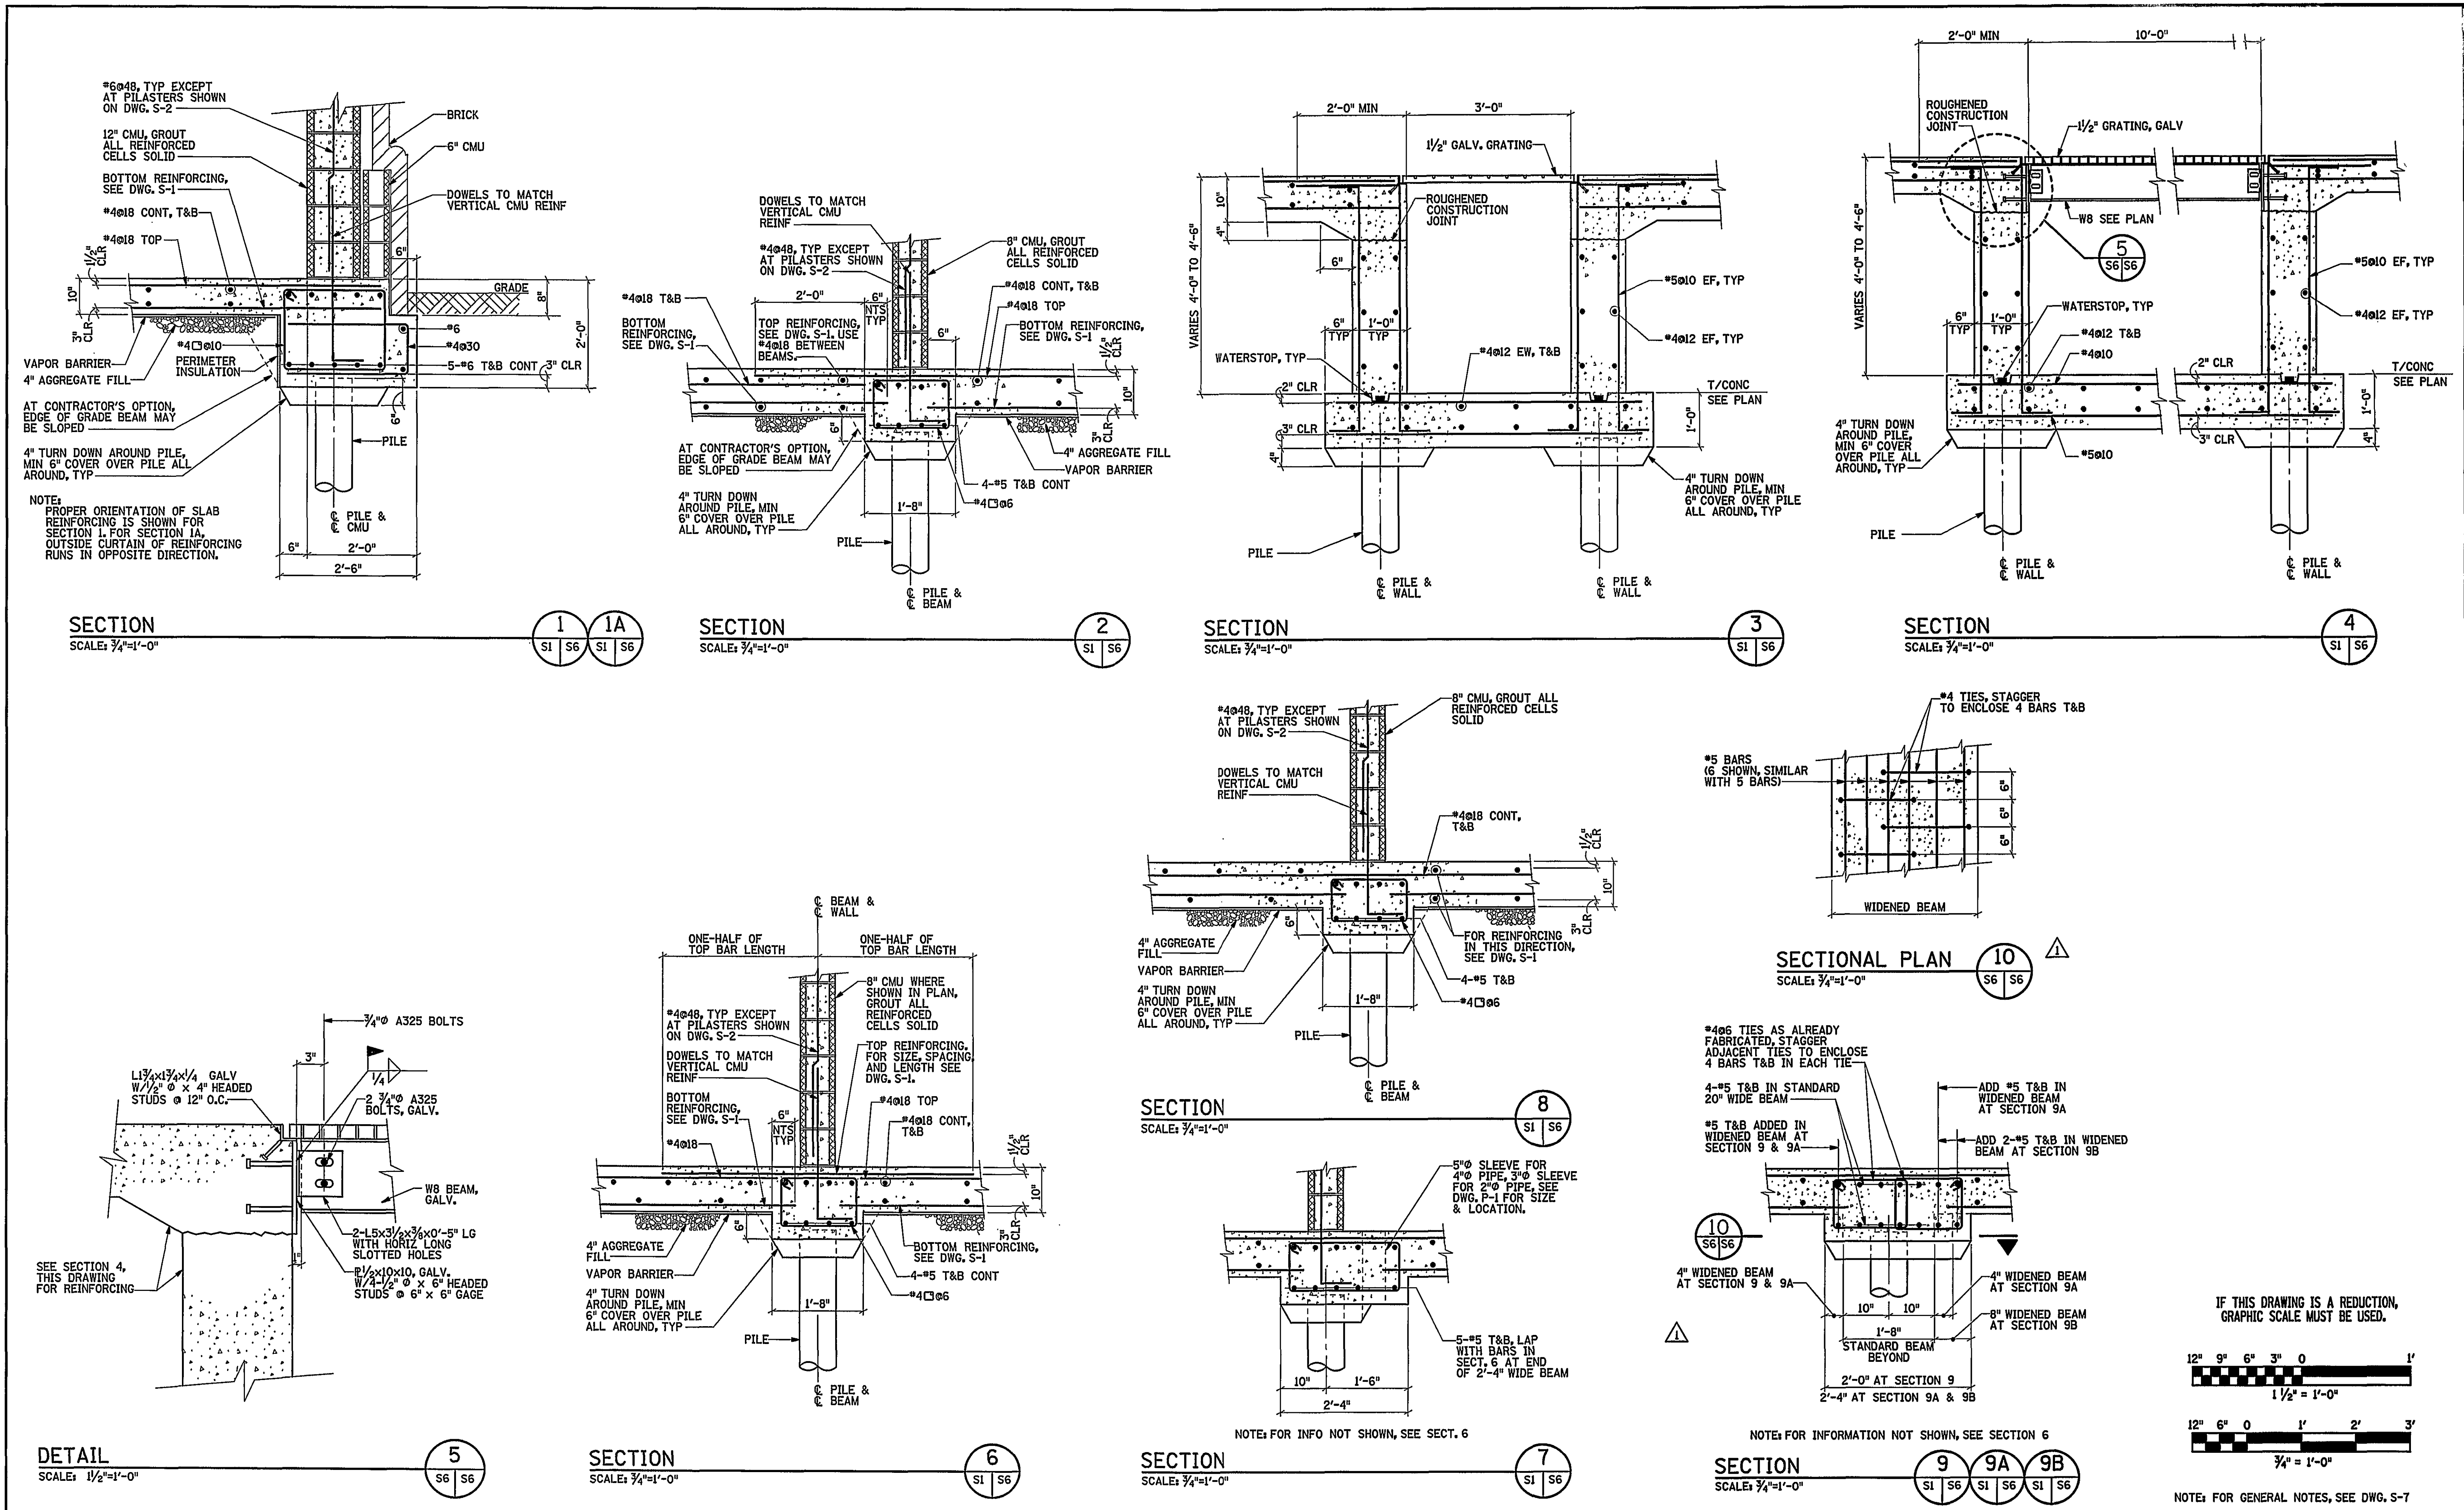

REV.	DATE	BY	APP.	DESCRIPTION
5-01-03	JLW	MKJ		RECORD DRAWING
2-13-02	JDI	NTS		ADDED SECTIONS 9 & 10

RECORD DRAWING
 DATE: MAY 1, 2003

Wiley & Wilson
ARCHITECTS ENGINEERS PLANNERS
An Employee-Owned Company
 2310 LANGHORNE ROAD
 LYNCHBURG, VIRGINIA 24501
 (804) 947-1901

IN ASSOCIATION WITH
HDR
HDR Engineering, Inc.
 5700 LAKE WRIGHT DRIVE
 NORFOLK, VIRGINIA 23502
 757-222-1500

DESIGNED JEH	DRAWN JDI	PROJECT CRYSTAL SPRING WATER TREATMENT PLANT FOR THE CITY OF ROANOKE, VIRGINIA
CHECKED NST	REVIEWED VKA	REFERENCE STRUCTURAL
COMM. NO. 200171.01	CADD NO. 200171S07.DGN	TITLE FOUNDATION SECTIONS & DETAILS
DATE AUG 26, 2001	DWG. NO. S-6	SHEET NO. 27 OF 72