


GENERAL NOTES:

A. SEE SHEET P-21 FOR VALVE SCHEDULE OF ALL VALVES GREATER THAN 4" DIA.

SPECIFIC NOTES:

1 EQUIPMENT TO BE SUPPLIED BY US FILTER-MEMCOR
AND INSTALLED BY GENERAL CONTRACTOR

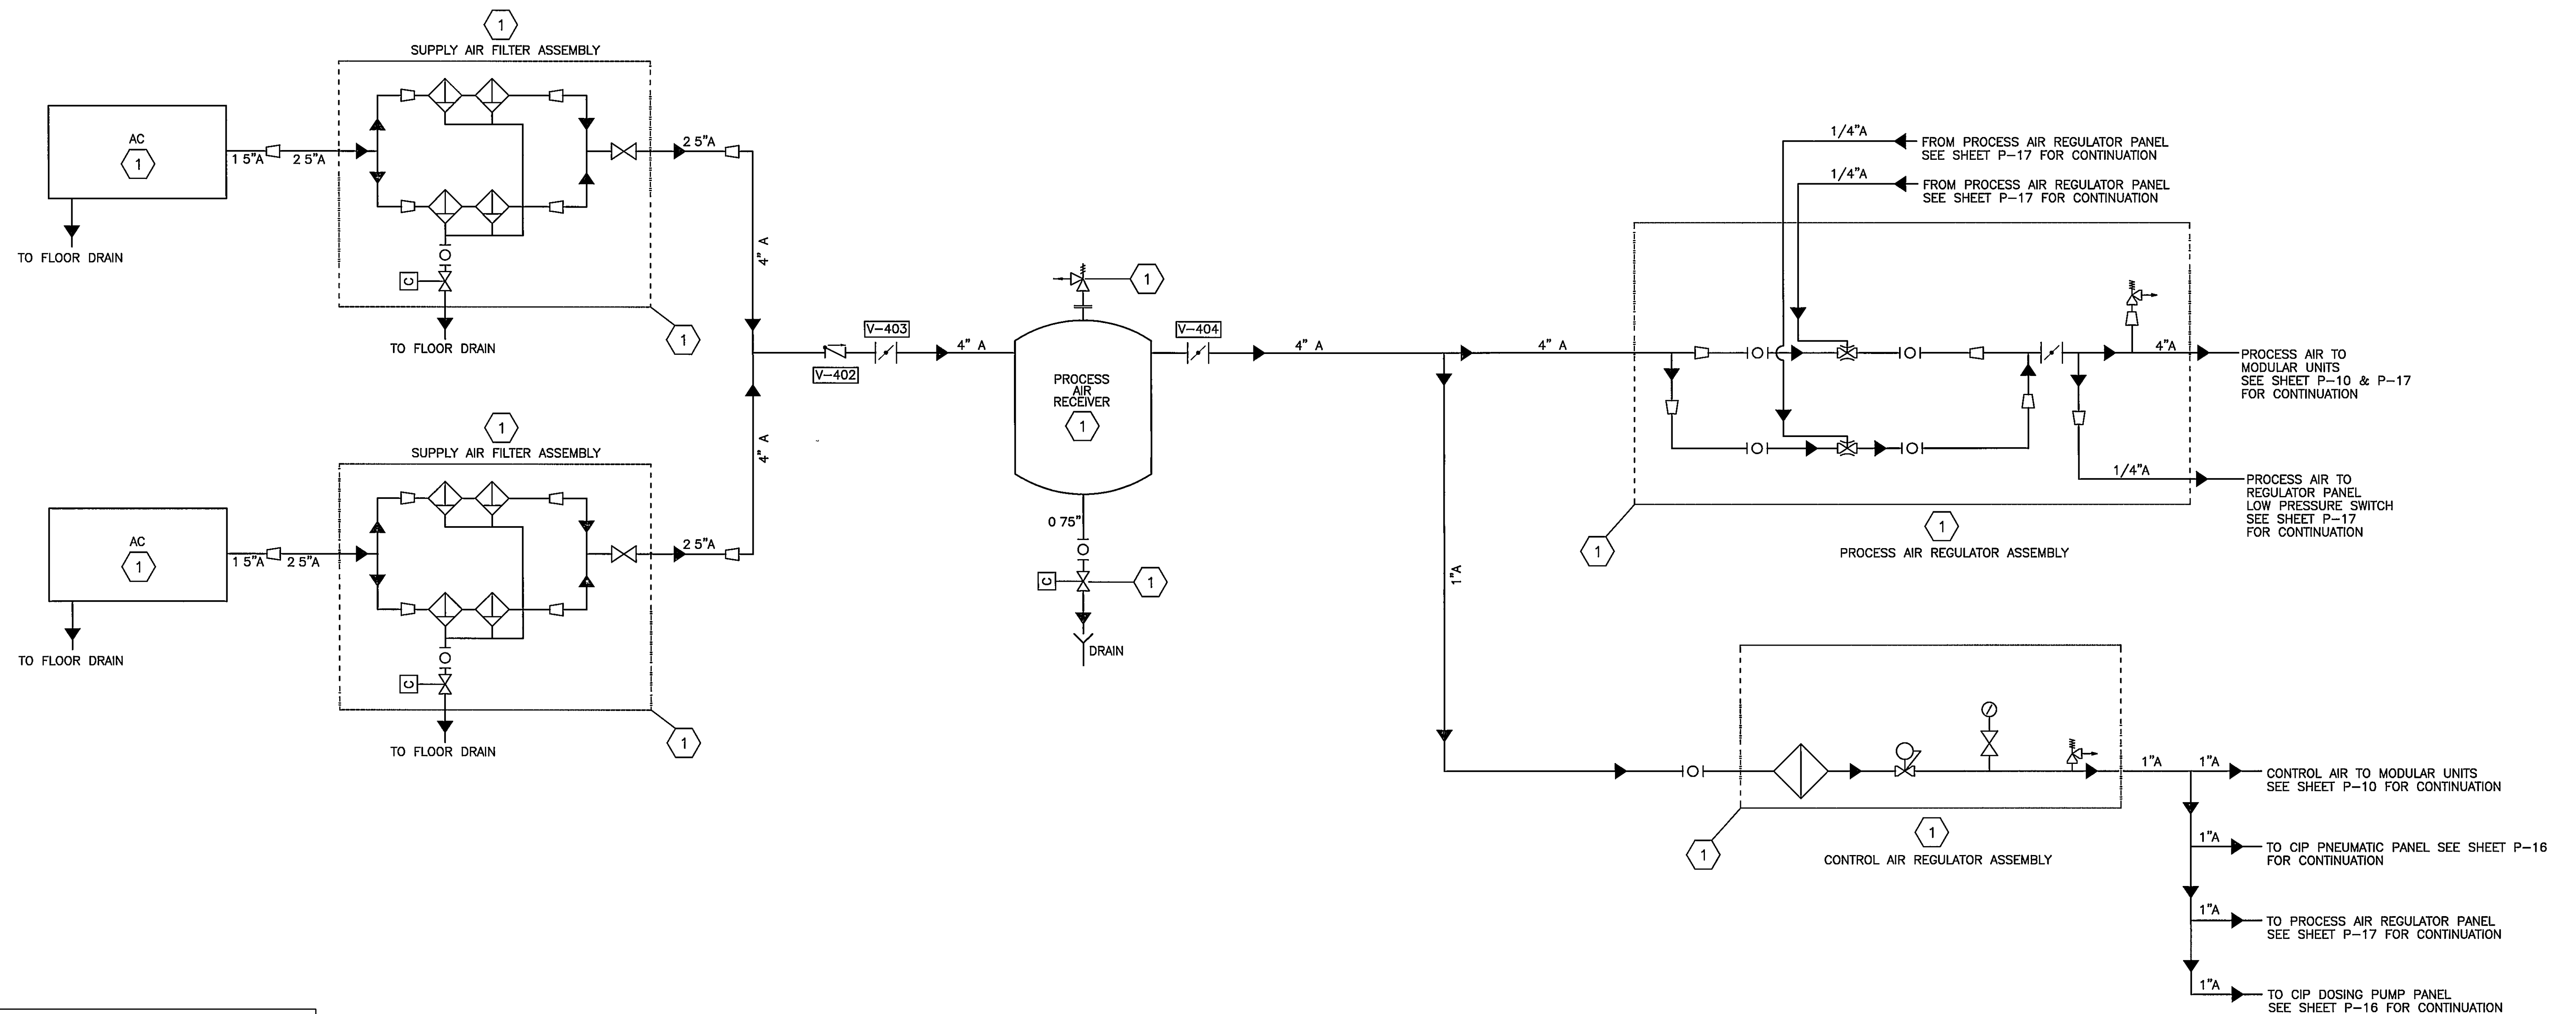

RECORD DRAWING

This record drawing has been prepared, in part, based upon information furnished by others. While this information is believed to be reliable, HDR Engineering, Inc. cannot assure its accuracy, and thus is not responsible for the accuracy of this record drawing or for any errors or omissions which may have been incorporated into it as a result. Those relying on this record document are advised to obtain independent verification of its accuracy before applying it for any purpose.

[illegible]