


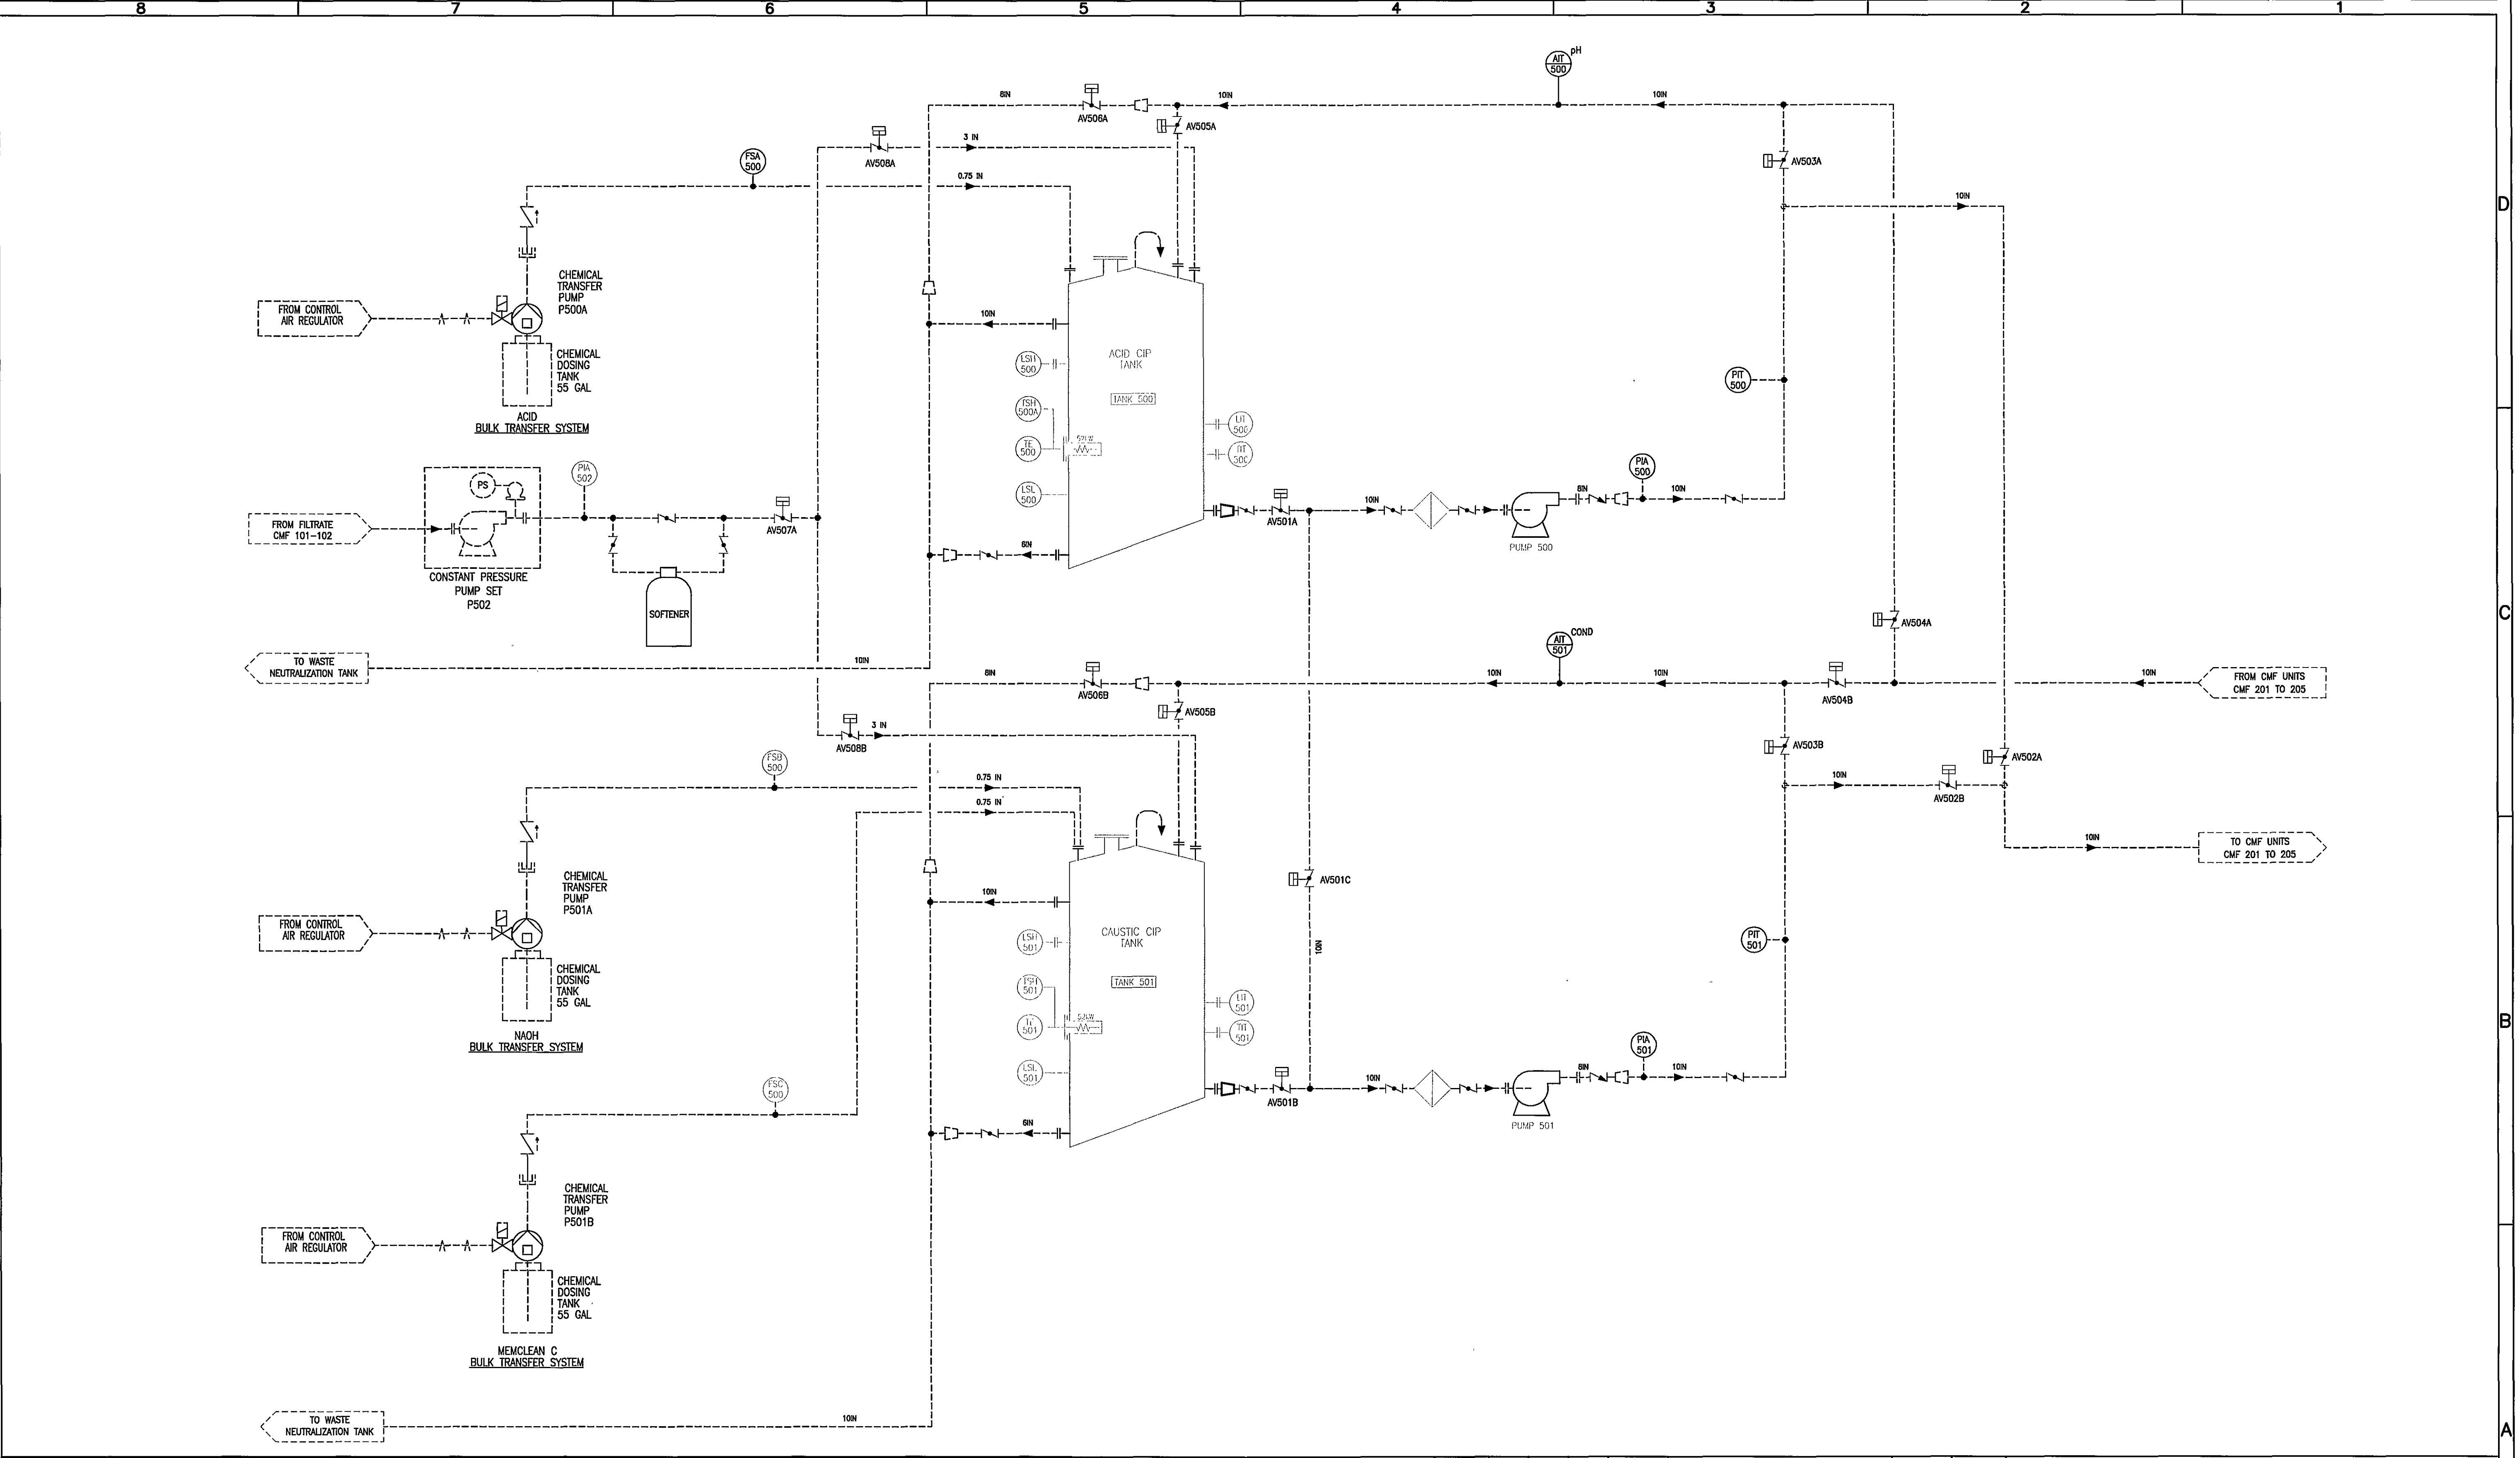

NOTES: 1. ALL MAIN HEADERS, EXCEPT CIP, TO HAVE FLUSHING POINTS 2. DRAIN POINTS TO BE INCLUDED AT APPROPRIATE POINTS, TO BE FINALIZED UPON COMPLETION OF GA's. 3. VENT POINTS TO BE INCLUDED AT APPROPRIATE POINTS, TO BE FINALIZED UPON COMPLETION OF GA's.		ITEMS DASHED ARE BY OTHERS.	RECORD DRAWING APRIL 28, 2003		BAR = 1" AT PLOT SCALE		0 PRLIMINARY ISSUE		8/10/01	MOC	---	---	---	---	THIS DOCUMENT AND ALL INFORMATION CONTAINED HEREIN ARE THE PROPERTY OF THE USER AND/OR ITS APPLICABLE "UNIT". THE DESIGN CONCEPTS AND INFORMATION CONTAINED HEREIN ARE PROPRIETARY TO USF AND ARE SUBMITTED IN CONFIDENCE. THEY ARE NOT TRANSFERABLE AND MUST BE USED ONLY FOR THE PURPOSE FOR WHICH THE DOCUMENT IS SPECIFICALLY ISSUED. THEY MUST NOT BE DISCLOSED, REPRODUCED, LOANED OR USED IN ANY OTHER MANNER WITHOUT THE EXPRESS WRITTEN CONSENT OF USF. IN NO EVENT SHALL THEY BE USED IN ANY MANNER DESTROYING TO THE INTEREST OF USF. ALL PATENT RIGHTS ARE RESERVED. UPON THE DEMAND OF USF, THIS DOCUMENT, ALONG WITH ALL COPIES AND EXTRACTS, AND ALL RELATED NOTES AND ANALYSES, MUST BE RETURNED TO USF OR DESTROYED, AS INSTRUCTED BY USF. ACCEPTANCE OF THE DELIVERY OF THIS DOCUMENT CONSTITUTES AGREEMENT TO THESE TERMS AND CONDITIONS.		DESIGNER KFOX CHECKER DATE 07/27/2000 ENGINEER DATE MANAGER DATE	FILE: 260056-0003-3 SCALE: NOT TO SCALE	TITLE P & ID CLEAN IN PLACE AND CHEMICAL HANDLING SYSTEM CLIENT CRYSTAL SPRINGS WATER TREATMENT PLANT ROANOKE, VIRGINIA USFilter 2118 GREENSPRING DRIVE TIMONIUM, MD 21093 USA TEL: 1-800-MEMCOR4	PROJECT 260056	CODE	DRAWING P-27	SHEET OF	REV 0
--	--	-----------------------------	--	--	------------------------	--	-----------------------	--	---------	-----	-----	-----	-----	-----	--	--	--	--	--	-------------------	------	-----------------	-------------	----------