


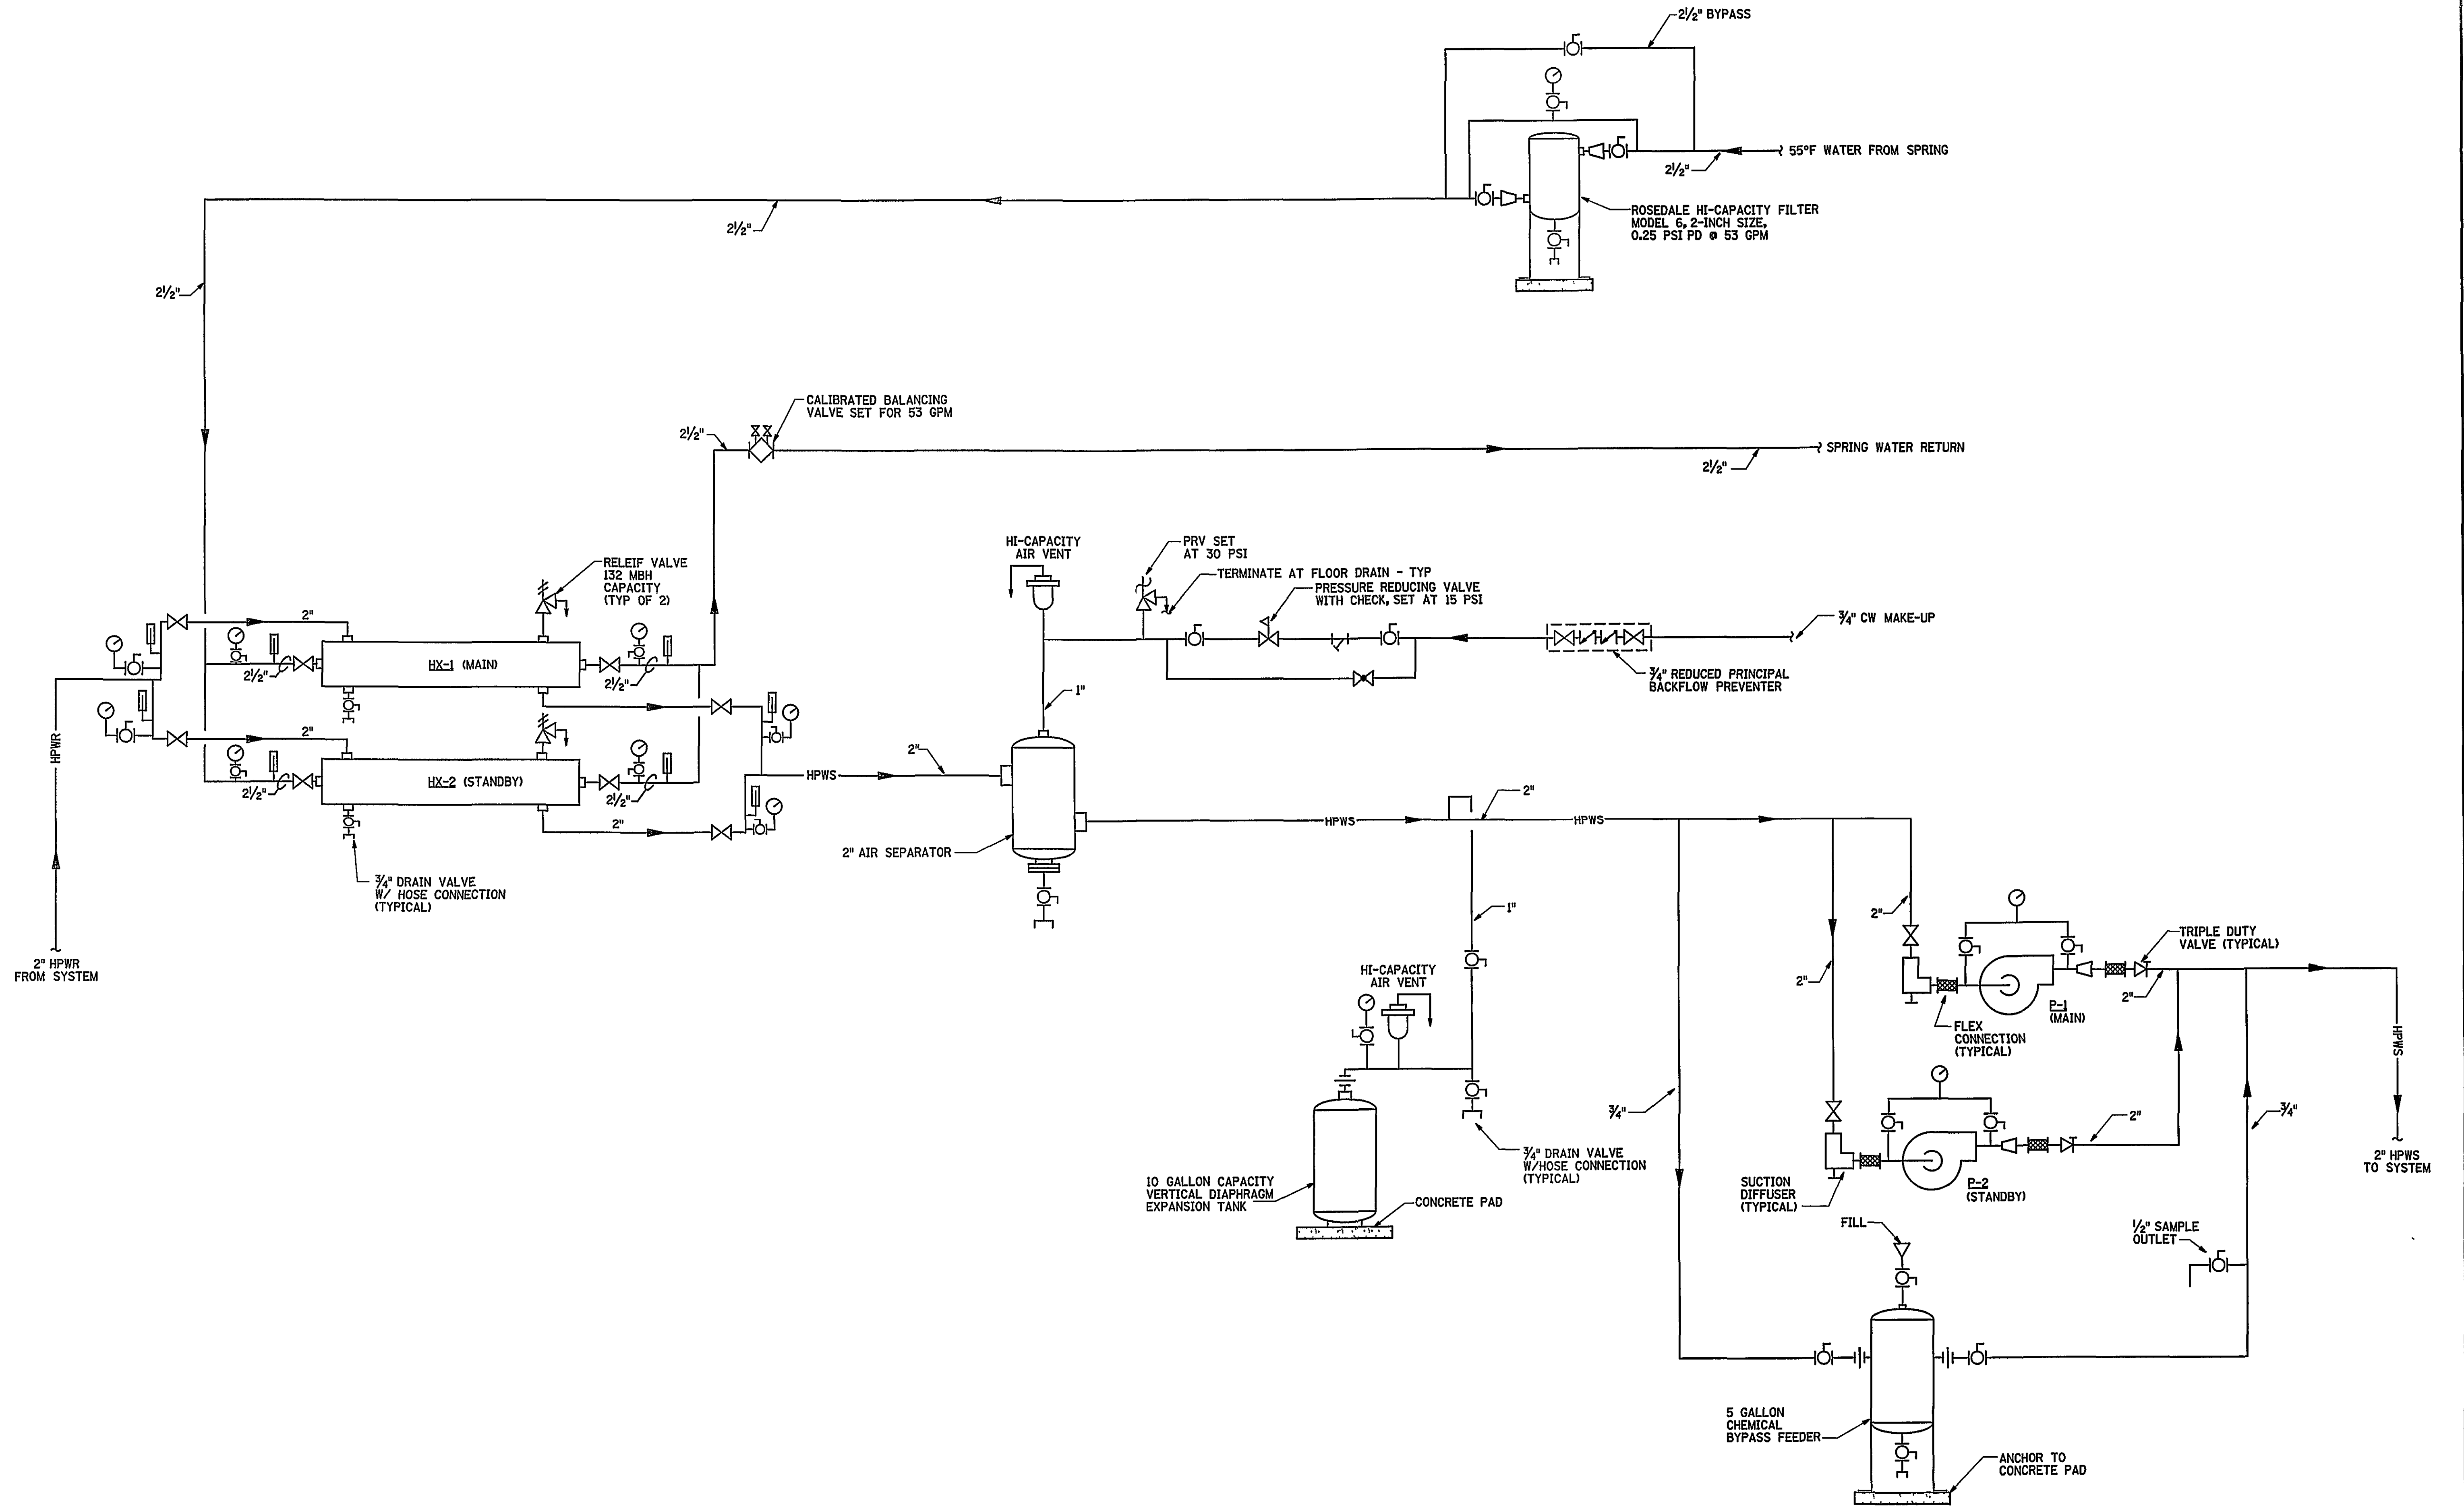

REV.	DATE	BY	APP.	DESCRIPTION
5-01-03	JLW	MKJ		RECORD DRAWING

RECORD DRAWING

DATE: MAY 1, 2003

Wiley & Wilson
ARCHITECTS ENGINEERS PLANNERS
An Employee-Owned Company

2310 LANGHORNE ROAD
LYNCHBURG, VIRGINIA 24501
(804) 947-1901

P.O. BOX 877
LYNCHBURG, VIRGINIA 24505-0877

IN ASSOCIATION WITH

HDR

HDR Engineering, Inc.
5700 LAKE WRIGHT DRIVE
NORFOLK, VIRGINIA 23502
757-222-1500

DESIGNED DAN	DRAWN DAN/WHC	PROJECT CRYSTAL SPRING WATER TREATMENT PLANT FOR THE CITY OF ROANOKE, VIRGINIA
CHECKED MUG	REVIEWED	REFERENCE MECHANICAL
COMM. NO. 200171.01		
CADD NO. 200171M3.DGN		TITLE HEAT PUMP WATER PIPING SCHEMATIC
DATE AUG 26, 2001	DWG. NO. M-2	SHEET NO. 58 OF 72
		REV. 0