


NOTES

- 1. PENDANT MOUNT TYPE 'H' LIGHT FIXTURES 20'-0" AFF TO BOTTOM OF FIXTURES. COORDINATE EXACT LOCATIONS WITH CEILING STRUCTURE, MECHANICAL EQUIPMENT, AND MAKE MINOR ADJUSTMENTS AS REQUIRED.
- 2. PROVIDE 2-#12 & 1-#12 EGC - 3/4" C DOWN TO TYPE 'EMI' FIXTURE. SEE DRAWING E-5 FOR CONTINUATION.
- 3. PROVIDE 9-#12 & 1-#12 EGC - 3/4" C IN THIS LOCATION.

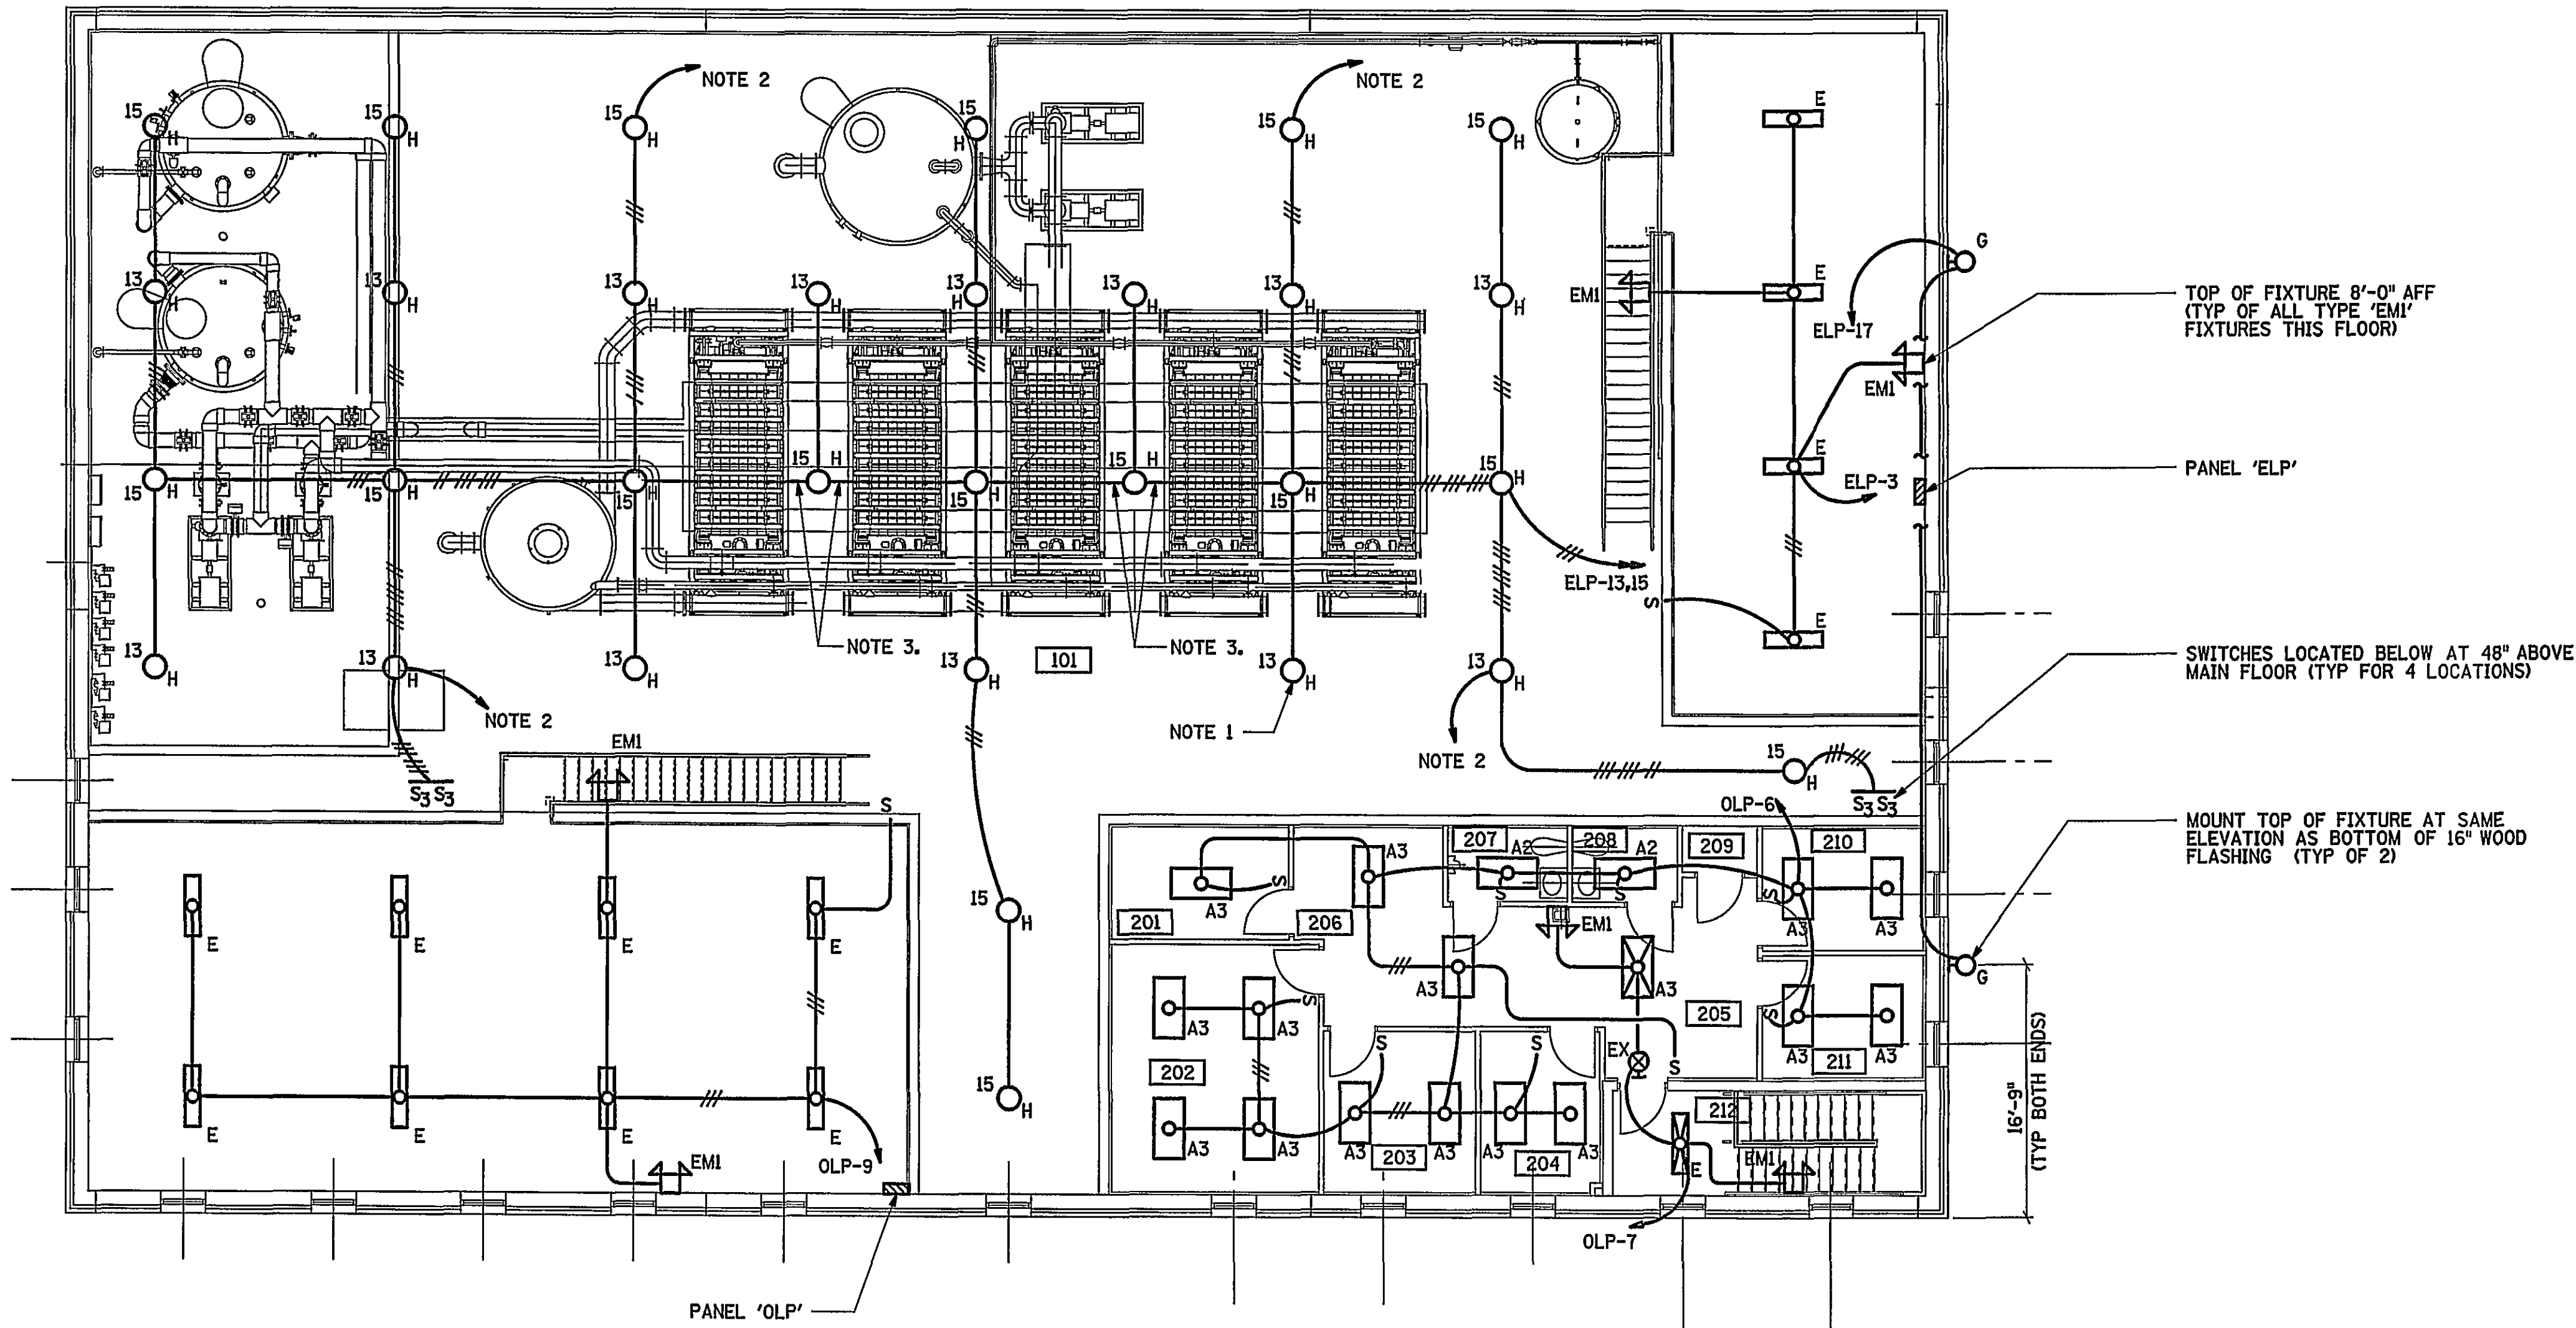

SECOND FLOOR AND MEZZANINE PLAN - LIGHTING  
SCALE: 1/8" = 1' - 0"



IF THIS DRAWING IS A REDUCTION,  
GRAPHIC SCALE MUST BE USED.

5' 0 5' 10' 15'

1/8" = 1'-0"

REV.	DATE	BY	APP.	DESCRIPTION
5-01-03	JLW	MKJ		RECORD DRAWING

RECORD DRAWING

DATE: MAY 1, 2003

**Wiley & Wilson**  
ARCHITECTS ENGINEERS PLANNERS  
An Employee-Owned Company

2310 LANGHORNE ROAD  
LYNCHBURG, VIRGINIA 24501  
(804) 947-1901

P.O. BOX 877  
LYNCHBURG, VIRGINIA 24505-0877

IN ASSOCIATION WITH

**HDR**

HDR Engineering, Inc.  
5700 LAKE WRIGHT DRIVE  
NORFOLK, VIRGINIA 23502  
757-222-1500

DESIGNED	DRAWN	PROJECT
SAB	HDB	CRYSTAL SPRING WATER TREATMENT PLANT FOR THE CITY OF ROANOKE, VIRGINIA
CHECKED	REVIEWED	REFERENCE
PLG	MKJ	ELECTRICAL
COMM. NO.	CADD NO.	TITLE
200171.01	200171e21.dgn	SECOND FLOOR AND MEZZANINE PLAN - LIGHTING
DATE	DWG. NO.	SHEET NO.
AUG 26, 2001	E-6	67 OF 72
		REV. 0