


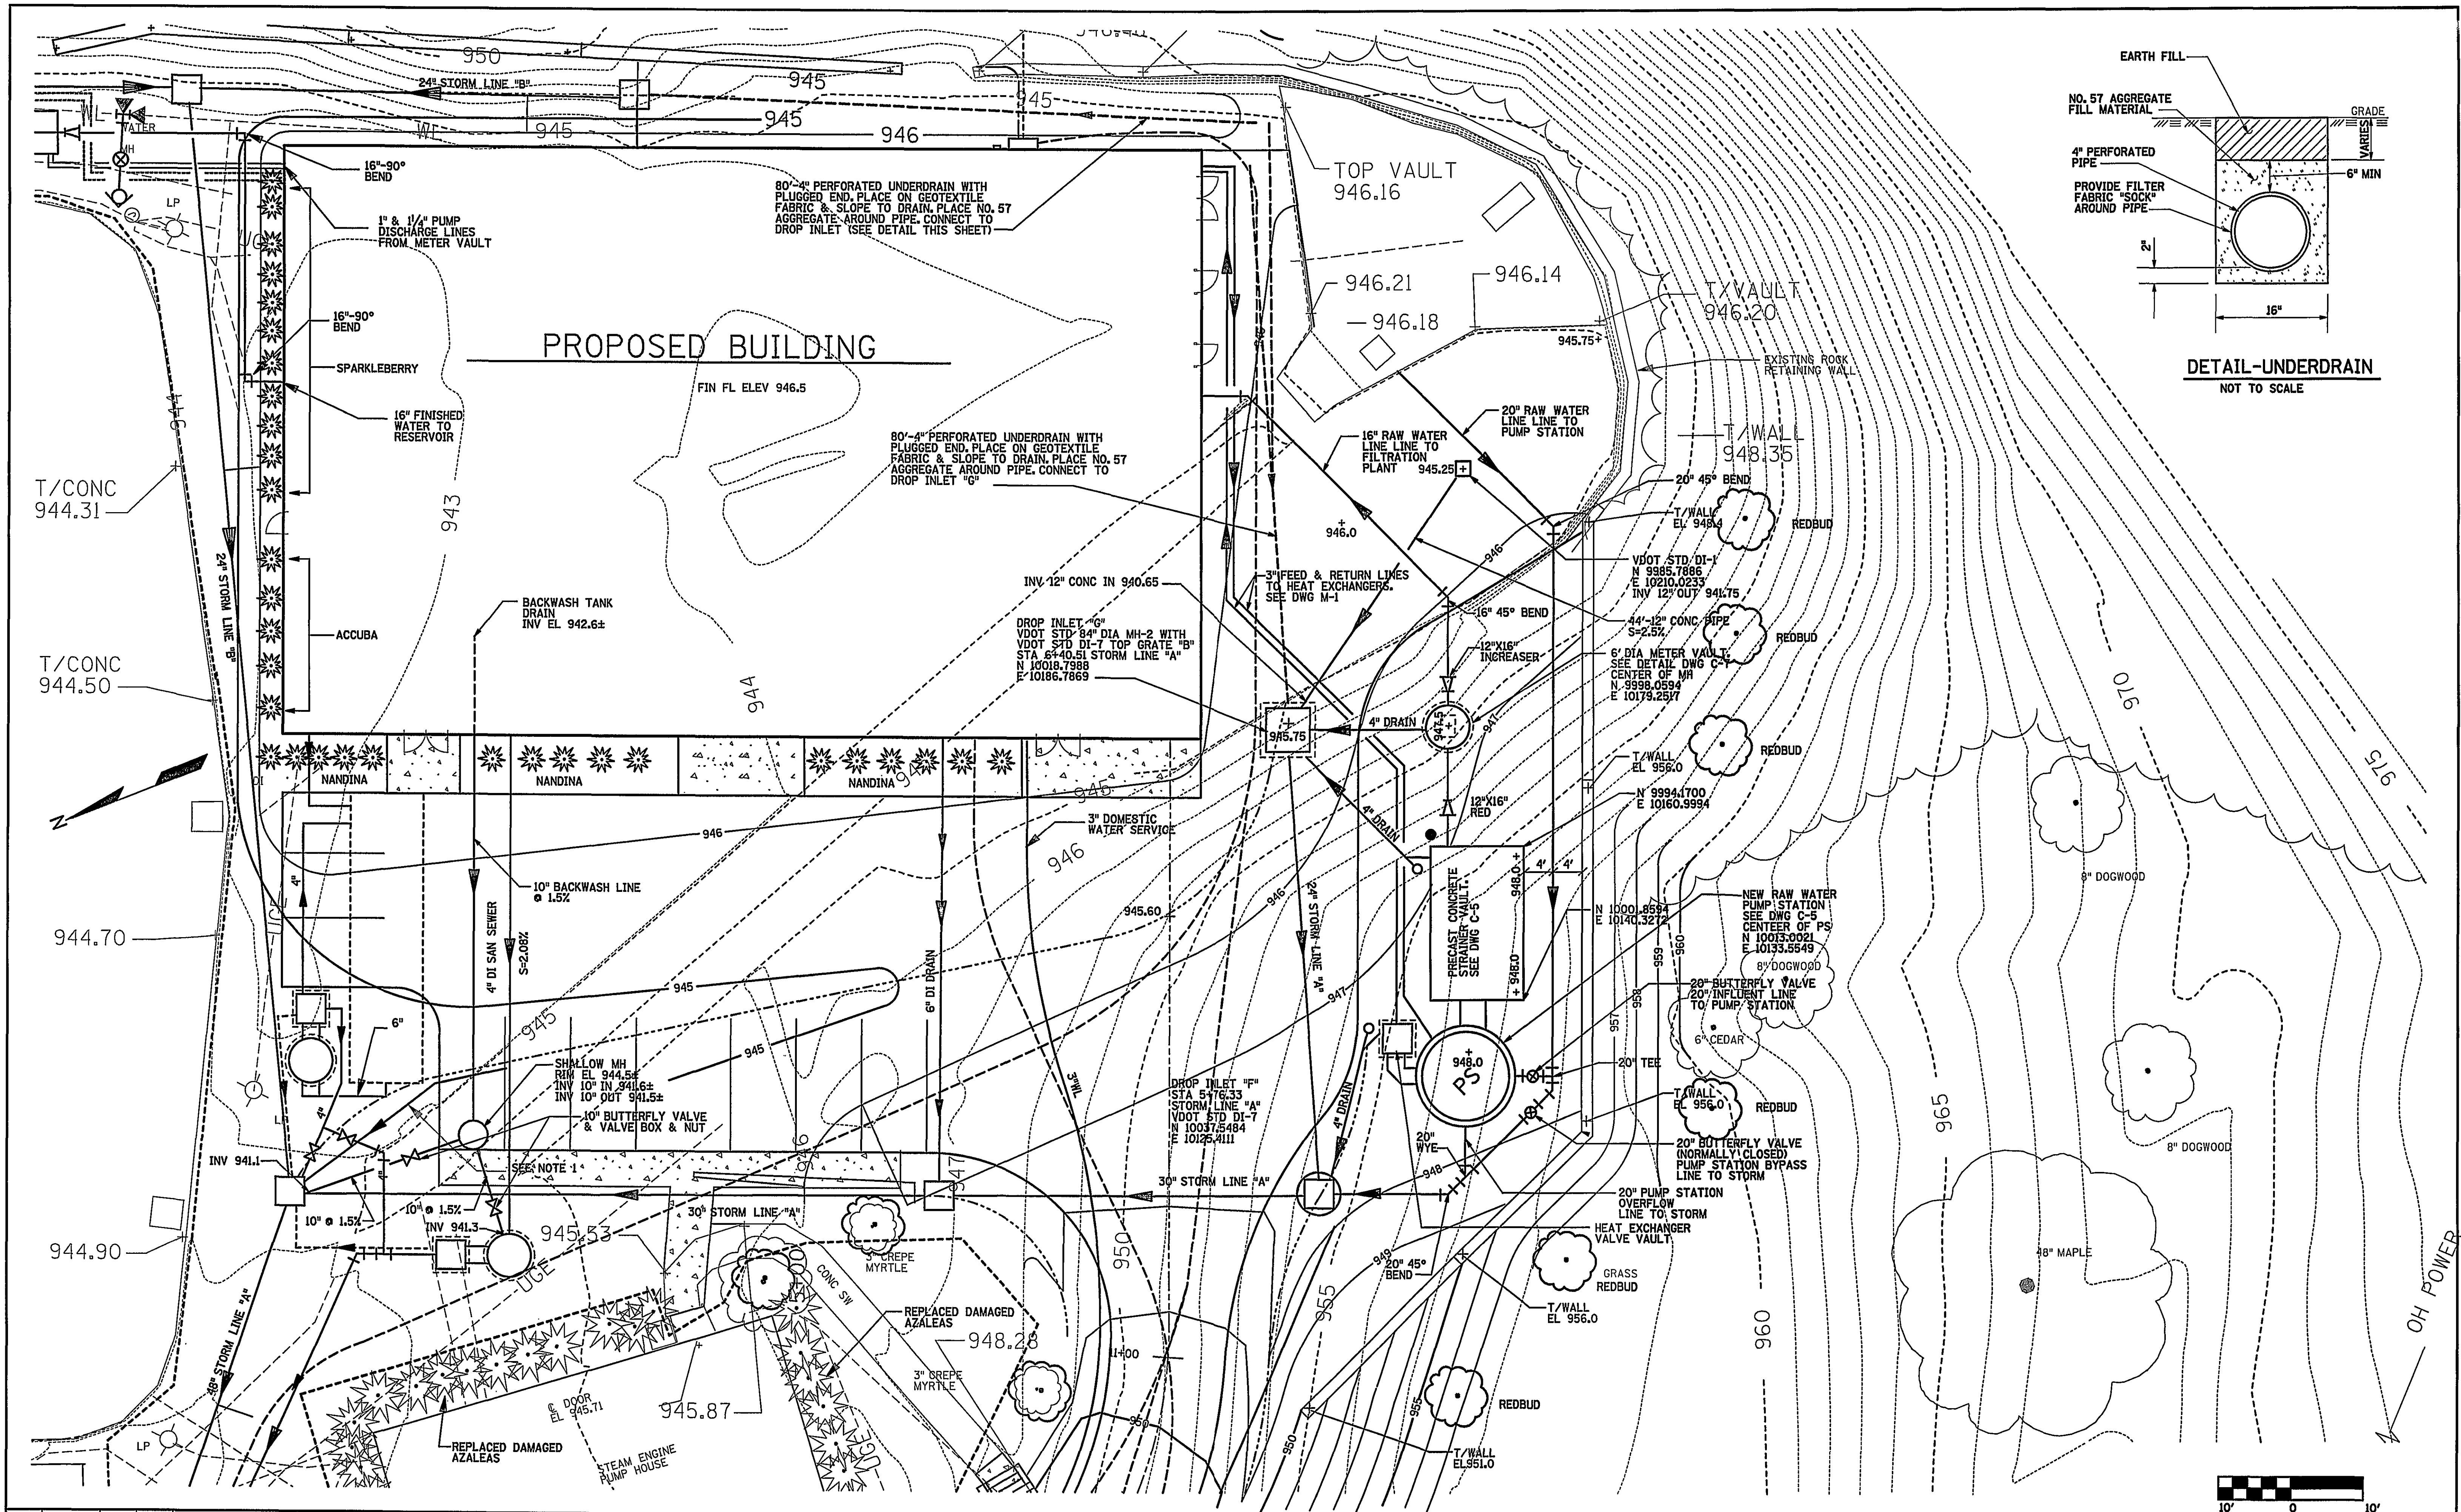

REV.	DATE	BY	APP.	DESCRIPTION
	5-01-03	JLW	MKJ	RECORD DRAWING
1	2-19-02	JLW	MKJ	ADDED UNDERDRAINS
1	2-18-02	JLW	MKJ	REVISED RAW WATER PUMP STATION, STRAINER VAULT, METER VAULT & ADDED BACKWASH DRAIN

RECORD DRAWING

DATE: MAY 1, 2003

Wiley & Wilson
ARCHITECTS ENGINEERS PLANNERS
An Employee-Owned Company

2310 LANGHORNE ROAD
LYNCHBURG, VIRGINIA 24501
(804) 947-1901

P.O. BOX 877
LYNCHBURG, VIRGINIA 24505-0877

HDR

HDR Engineering, Inc.
5700 LAKE WRIGHT DRIVE
NORFOLK, VIRGINIA 23502
757-222-1500

DESIGNED MKJ	DRAWN JLW	PROJECT CRYSTAL SPRING WATER TREATMENT PLANT FOR THE CITY OF ROANOKE, VIRGINIA
CHECKED	REVIEWED	REFERENCE LANDSCAPE
COMM. NO. 200171.01		TITLE REVISED PUMP STATION SITE AND LANDSCAPE PLAN
CADD NO. 200171C70.DGN		DWG. NO. L-1
DATE FEB 18, 2002		SHEET NO. REV.