




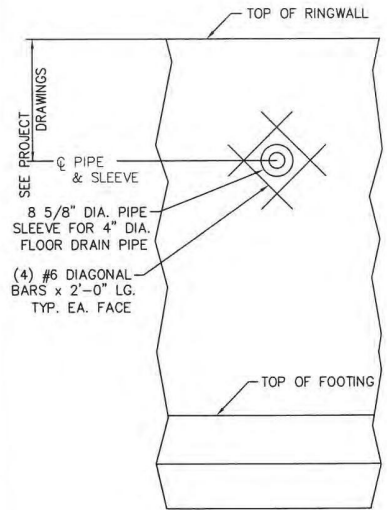


WALL PENETRATION DETAIL
FOR FLOOR DRAIN

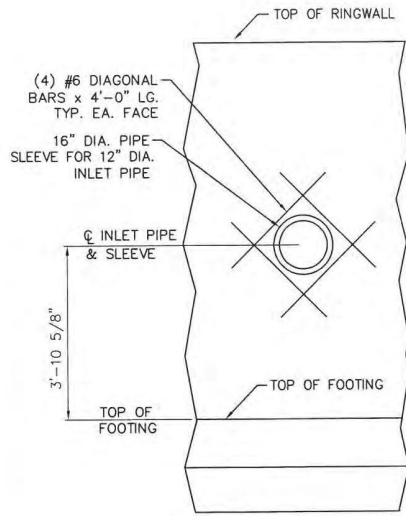

WALL PENETRATION DETAIL
FOR INLET

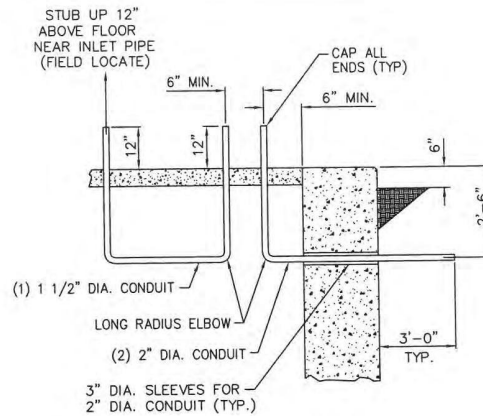


CONDUIT DETAIL
REQUIRED @ LOCATIONS SHOWN IN PLAN VIEW.

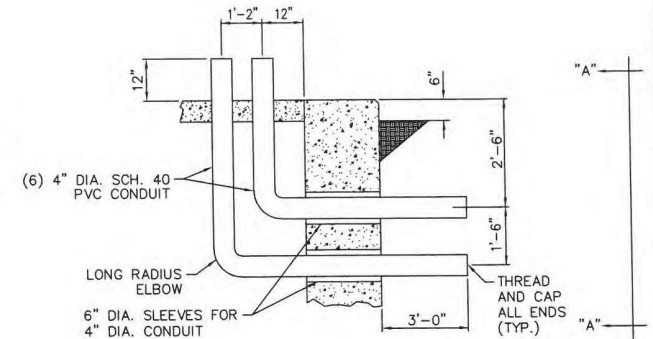


ANTENNA CONDUIT DETAIL
REQUIRED @ LOCATION SHOWN IN PLAN VIEW.

AS-BUILT

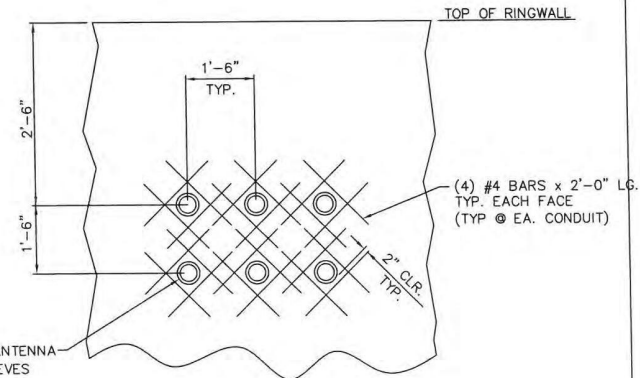


SECTION "A-A"


NOTE: DO NOT CUT TYPICAL RINGWALL REINFORCING TO INSTALL CONDUIT.
ADJUST CONDUIT AS REQ'D TO MAINTAIN MINIMUM SPACING SHOWN.

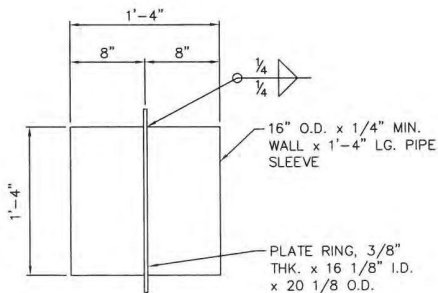

PIPE SLEEVE
FOR 12" DIA. INLET @ RINGWALL

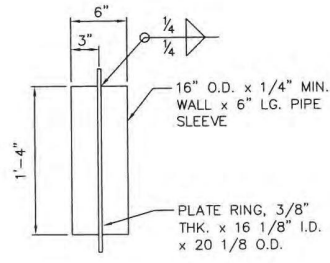

PIPE SLEEVE
FOR 12" DIA. INLET @ BASE CONE FLOOR

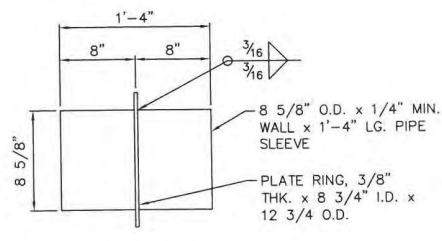

PIPE SLEEVE
FOR 4" DIA. FLOOR DRAIN @ RINGWALL

COMMONWEALTH OF VIRGINIA GERALD A. BURKE Lic. No. 034863 PROFESSIONAL ENGINEER			
REV.	BY:	DATE	REMARKS
CALDWELL Since 1887 Water - Energy - Industrial			
FRANKLIN COUNTY, VIRGINIA			
500,000 GALLON PEDESHERE			
BY:	TSY/4AB	TITLE:	RING FOUNDATION
DATE:	11/15/19	TITLE:	ANTENNA/CONDUIT DETAILS
DRAWING NO.:	E-8884	F4 OF 4	